SECURITY SYMBOLS									
ABBREVIATIONS AC ALTERNATING CURRENT ACR ACCESS CONTROL PANEL	SECURITY SYMBOLS	GENERAL NOTES 1 CONTRACTOR SHALL SUPPORT ALL CABLE WITH APPROVED PATHWAY.							
ACP ACCESS CONTROL PANEL ADA AMERICANS WITH DISABILITIES ACT	DOOR POSITION SWITCH ONLY	2 ALL CABLES SHALL BE ROUTED PARALLEL AND PERPENDICULAR TO THE BUILDING STRUCTURE, UNLESS OTHERWISE NOTED.							
AFC ABOVE FINISHED CEILING AFF ABOVE FINISHED FLOOR	SEE ARCHITECTURAL DOOR HARDWARE SCHEDULE	3 DC	OR HARDWARE	AND OPENING CONDITIONS SHALL BE EVALUAT	TED PRIOR TO C	ONDUIT AND CA	ABLING INSTALLAT	FION AND COORDINATED WITH DIVISION 08.	
AFG ABOVE FINISHED GRADE AWG AMERICAN WIRE GAUGE	ELECTRIFIED LOCKING DEVICE, REQUEST TO EXIT, DOOR POSITION SWITCH, AND LATCH BOLT MONITOR SEE ARCHITECTURAL DOOR HARDWARE SCHEDULE	4 PR	OVIDE CONDUIT	SLEEVE WITH NYLON BUSHINGS FOR NON-RAT	ΓED WALL PENE	NTRATIONS FOR	R COMMUNICATIO	NS CABLES. PATHWAYS SHALL BE SIZED FOR NO MOI	RE THAN FOURTY (40) PERCENT FILL.
BAS BUILDING AUTOMATION SYSTEM BFC BELOW FINISHED CEILING	IC INTERCOM		OVIDE CONDUIT AN FOURTY (40)		S WHICH OBSTR	UCT ACCESS FO	OR MOVE/ADD/CH	ANGES TO CABLE PATHWAY SUCH AS HARD GYPSUM	CEILING. PATHWAYS SHALL BE SIZED FOR NO MORE
BR BIOMETRIC READER C CONDUIT	KP KEYPAD - INTRUSION DETECTION SYSTEM	6 PR	OVIDE UL LISTE	O FIRESTOP ASSEMBLY AT FIRE WALL PENETRA	ATIONS FOR CO	MMUNICATIONS	CABLES. MATER	IAL AND INSTALLATION SHALL MAINTAIN THE RATED CA	APACITY OF WALL AND MEET ALL APPLICABLE CODES.
CMP COMMUNICATIONS PLENUM JACKET	MD MOTION DETECTOR	7 CC	NTRACTOR SHA	LL COORDINATE ALL COMMUNICATIONS AND CA	ABLING PATHWA	AYS WITH OTHE	R DIVISIONS PRIC	OR TO INSTALLATION OF THEIR WORK.	
CMR COMMUNICATIONS RISER DEMO DEMOLITION	PB PANIC/DURESS BUTTON	8 FULLY COORDINATE ALL CONDUIT ROUTING WITH STRUCTURAL ELEMENTS. COORDINATE CONDUIT INSTALLATIONS WITH ARCHITECT, STRUCTURAL ENGINEER, STRUCTURAL CONTRACTOR, AND GENERAL CONTRACTOR PRIOR TO INSTALLATION. ROUTING IN OR UNDER A SLAB IN CONTACT WITH GRADE REQUIRES THE USE OF CABLE RATED FOR A WET ENVIRONMENT.							
DC DIRECT CURRENT DVR DIGITAL VIDEO RECORDER (E) EXISTING DEVICE	REMOTE UNLOCK/OPEN BUTTON			RA LOCATIONS PRIOR TO ROUGH-IN. FIELD OF V	IEW SHALL NOT	BE OBSTRUCTI	ED BY OTHER ELE	EMENTS INCLUDING, BUT NOT LIMITED TO, EXIT SIGNS,	, LIGHT FIXTURES, MILLWORK, SPRINKLERS, CURTAINS,
EC ELECTRICAL CONTRACTOR (ETR) EXISTING TO REMAIN		AND SIGNAGE. 10 ALL WIRING SHALL BE INSTALLED COMPLETE AND UNSPLICED FROM THE SERVING EQUIPMENT PANEL TO DEVICE.							
FC FLEXIBLE CONDUIT GC GENERAL CONTRACTOR		10 ALL WIRING SHALL BE INSTALLED COMPLETE AND UNSPLICED FROM THE SERVING EQUIPMENT PANEL TO DEVICE. 11 REFER TO TN0.1 FOR TECHNOLOGY GENERAL NOTES WHICH ADDRESS SECURITY COMPONENTS.							
IP INTERNET PROTOCOL ISP INSIDE PLANT CABLE	SECURITY CAMERA SENSOR SYMBOLS	\sim		~~~~~~~~~~~~~~~~~~~~~~~~~~~~~~~~~~~~~~~				~~~~~~~~~~~~~~~~~~~~~~~~~~~~~~~~~~~~~~~	·····
KVM KEYBOARD VIDEO MOUSE SWITCH LAN LOCAL AREA NETWORK	SECURITY CAMERA SENSOR STIMBOLS □ SINGLE SENSOR (□) CORRIDOR CAMERA	L	FORM				MOUNTING		
LED LIGHT-EMITTING DIODE LF LINEAR FEET	SINGLE SENSOR	TYPE	FACTOR	DESCRIPTION	BACK BOX	CABLE	HEIGHT UNO	MODEL	COMMENTS
MDF MAIN DISTRIBUTION FRAME MFR MANUFACTURER	180° □ PAN, TILT, ZOOM	L 01		SURFACE MOUNT DOME CAMERA	REFER TO MFR	A	9' AFF / CLG	AXIS M4216-LV	
MNT MOUNT N/A NOT APPLICABLE	270° / 360° — AXIS FA SENSOR MAIN UNIT	,		DOINE ON WEIGH	IVII IX				
NVR NETWORK VIDEO RECORDER OC ON CENTER	SECURITY CAMERA MOUNTING TYPE SYMBOLS (APPLIES TO	02		DISCREET ELEVATOR CEILING MOUNT CAMERA	REFER TO MFR	A	ELEVATOR CEILING	AXIS FA1105	COORDINATE WITH ELEVATOR MANUFACTURER ON EXACT TRAVEL CABLE REQUIREMENTS
OSP OUTSIDE PLANT POE POWER OVER ETHERNET	ANY SECURITY DEVICE SYMBOL)	L						AXIS Q6100-E WITH AXIS Q6135LE PTZ	PROVIDE PENDANT MOUNT AS REQURIED FOR POLE
QTY QUANTITY (R) RELOCATED EXISTING	☐ CEILING MOUNT	03		POLE MOUNTED MULTI-IMAGER CAMERA WITH PTZ CAMERA	REFER TO MFR	A	12' AFG POLE	ANIO QUIOU-E WITH ANIO QUIOSEET 12	MOUTED APPLICATIONS
DEVICE (RE) REMOVE EXISTING DEVICE	H⊡4 WALL MOUNT			SURFACE MOUNT	REFER TO	A	9' AFF / CLG	AXIS P4707-PLVE	
AND INSTALL AT ANOTHER LOCATION, SEE (R) RMC RIGID METAL CONDUIT	POLE / BOLLARD MOUNT CORNER MOUNT	04		DUAL IMAGER CAMERA	MFR		0 7 11 7 020		
RU RACK UNIT SF SQUARE FEET	CORNER MOUNT PENDANT MOUNT	0.5		360 DEGREE	REFER TO	А	9' AFF / CLG	AXIS M3508-PLE	
TGB TELECOMMUNICATIONS GROUND BUS BAR	WALL MOUNT PENDANT ARM	05		FISHEYE CAMERA	MFR				
TMGB TELECOMMUNICATIONS MAIN OPENING BAR		06		REMOTE SENSOR SURFACE MOUNT CAMERA	REFER TO MFR	А	9' AFF / CLG	AXIS FA3105-L	
GROUND BUS BAR TR TELECOMMUNICATIONS ROOM		,							WHERE SHOWN IN DATA ROOMS, MOUNT WITHIN 2-POST
TYP TYPICAL UNO UNLESS NOTED OTHERWISE		N/A		FA SENSOR CAMERA MAIN UNIT	N/A	A	9' AFF / CLG	AXIS FA454 MAIN UNIT	RACK. IN MECHANICAL, ELECTRICAL, STORAGE ROOMS MOUNT ON WALL. IN CLASSROOMS MOUNT ABOVE CEILING
UPS UNINTERRUPTIBLE POWER SUPPLY		ACCE							
V VOLT(S) VMS VIDEO MANAGEMENT		TYPE		FORM FACTOR DESCRIPTION	BACK BOX	CONDUIT	CABLE	MOUNTING HEIGHT UNO MODEL	COMMENTS
SYSTEM			(CR)	STANDARD CARD READER	4 SQUARE W/ MUD	(1) 1/2" EMT	YYY	46" AFF KANTECH MULTI-TECHNOLOGY	
		01		STANDARD CARD READER	RING				
			(CR)	MULLION CARD READER	N/A	(1) 1/2" FC	В	46" AFF KANTECH MULTI-TECHNOLOGY	
	$\frac{\sqrt{2}}{2}$	⁰²		~~~~~~~~~~~~~~~~~~~~~~~~~~~~~~~~~~~~~	******	•		~~~~~~~~~~~~~~~~~~~~~~~~~~~~~~~~~~~~~~	· · · · · · · · · · · · · · · · · · ·
	\	0.3	⟨CR⟩ _P	PEDESTAL MOUNTED STANDARD CARD READER	N/A	(1) 1/2" EMT	В	ON KANTECH MULTI-TECHNOLOGY PEDESTAL	
	•	ست			——	(1) 1/2"	······		
			PB	UNDER DESK PANIC BUTTON	N/A	ARMORED PATHWAY	С	UNDER HONEYWELL 269R DESK	DUAL LEAF DOORS SHALL BE WIRED IN SERIES
			(EL)	ELECTRIFIED LOCK	N/A	(1) 1/2" EMT	SHARED WITH CARD	NVA PEEED TO DIVIDION OF DOOD	
ANNOTATION				ELECTRIFIED LOCK	19//4	(1) 1/2 EIVI1	READER	N/A REFER TO DIVISION 08 DOOR HARDWARE	
SECURITY PLAN CALLOUT	_		(DM)	DOOR MONITOR ONLY	N/A	(1) 1/2" EMT	С	WITHIN DOOR REFER TO DIVISION 08 DOOR	DUAL LEAF DOORS SHALL BE WIRED IN SERIES
								FRAME HARDWARE	DUAL LEAF DOORS SHALL BE WIRED IN SERIES
CONNECTION POINT OF NEW WORK TO EXISTING									
DETAIL REFERENCE UPPER NUMBER INDICATES DETAIL NUMBER. LOWER NUMBER INDICATES SHEET NUMBER									
SECTION CUT DESIGNATION									
DEDICATED EQUIPMENT ACCESS TILE									
ACCESS PANEL									
\\\\\\\\\\\\\\\\\\\\\\\\\\\\\\\\\\\\\\									
LINETYPE LEGEND	LABELING SCHEME								
DIRECT WIRE GROUPED	SECURITY DEVICES (TYPICAL)								
CONNECTION GROUPED FUNCTIONALITY									
	A XX XX: MODIFIER FOR SPECIAL OPERATION IF APPLICABLE								
HATCHING LEGEND	S. E. WITCH II ALL LIOADEL								
	SEE MATCHING SCHEDULES ON THIS SHEET (IF APPLICABLE)							
UEADEND DOOM	SECURITY CAMERAS (TYPICAL)		E TYPES (TY	,			_		
HEADEND ROOM		`) CATEGORY 6 (ABLE WHITE- COORDINATE WITH DIVISION 27					
	□□□□□□□□□□□□□□□□□□□□□□□□□□□□□□□□□□□□□	,	,	ISHIELDED WHITE					
NOT IN COORT (NIC)	FOR WALL MOUNTED CAMERAS, NON- TYPICAL HEIGHT ABOVE FINISHED FLOOR	· ·	<u>*</u>	SHIELDED WHITE					
NOT IN SCOPE (NIS)	OR FINISHED GRADE	CABLE	TYPES SHOWN	ABOVE ARE TYPICAL FOR CABLE DISTANCES LE	SS THAN 500 FE	ET. REFER TO D	DEVICE MANUFAC	TUERER'S	
	SEE MATCHING SCHEDULES ON THIS SHEET (IF APPLICABLE			EMENTS FOR LONGER DISTANCES. COORDINATI TS FOR LOCK POWER.	E WITH DOOR H	IARUWAKE PRO	VIDEK 10 CONFIF	NIVI	

POLK STANLEY WILCOX

801 South Spring Street Little Rock, AR 72201 501.378.0878 office 509 W. Spring St. | Suite 150 Fayetteville, AR 72701 479.444.0473 office polkstanleywilcox.com

CIVIL
McClelland Consulting Engineers, Inc.
1580 E STEARNS ST
FAYETTEVILLE, AR 72703
P: 479.443.2377

LANDSCAPE OSD 115 ST. JOHNS PLACE BROOKLYN, NY 11217 P: 917.553.5586

STRUCTURAL

Martin/Martin Consulting Engineers

900B SOUTH WALTON BLVD, STE 27 BENTONVILLE, AR 72712 P: 479.407.0945

MEPF + LOW VOLTAGE **Henderson Engineers** 8345 LENEXA DRIVE, STE 300 LENEXA, KS 66214 P: 913.660.6187

SUSTAINABILITY 224 SOUTH MICHIGAN AVENUE CHICAGO, IL 60604 P: 312.360.4121 SIGNAGE + WAYFINDING **TWO TWELVE** 236 W. 27th ST., SUITE 802

P: 212.254.6670 FOOD SERVICE JME HOSPITALITY 9595 SIX PINES DR., SUITE 8210 THE WOODLANDS, TX 77380

NEW YORK, NY 10001

P: 609.641.2222

WATER FEATURES OTL 2150 S. TOWNE CENTER, SUITE 100 IRRIGATION
WC3 DESIGN
11A ROBINSON MANOR BLVD.
MCKEES ROCK, PA 14136
P: 844.231.7042

PSW Job Number:

Henderson Job Number: 2150002607




AWSOM
Bentonville, AR

Issue Date: 02.24.2023

NUMBERDATEDESCRIPTION206.09.23Addendum 2

SECURITY
GENERAL NOTES
AND LEGEND



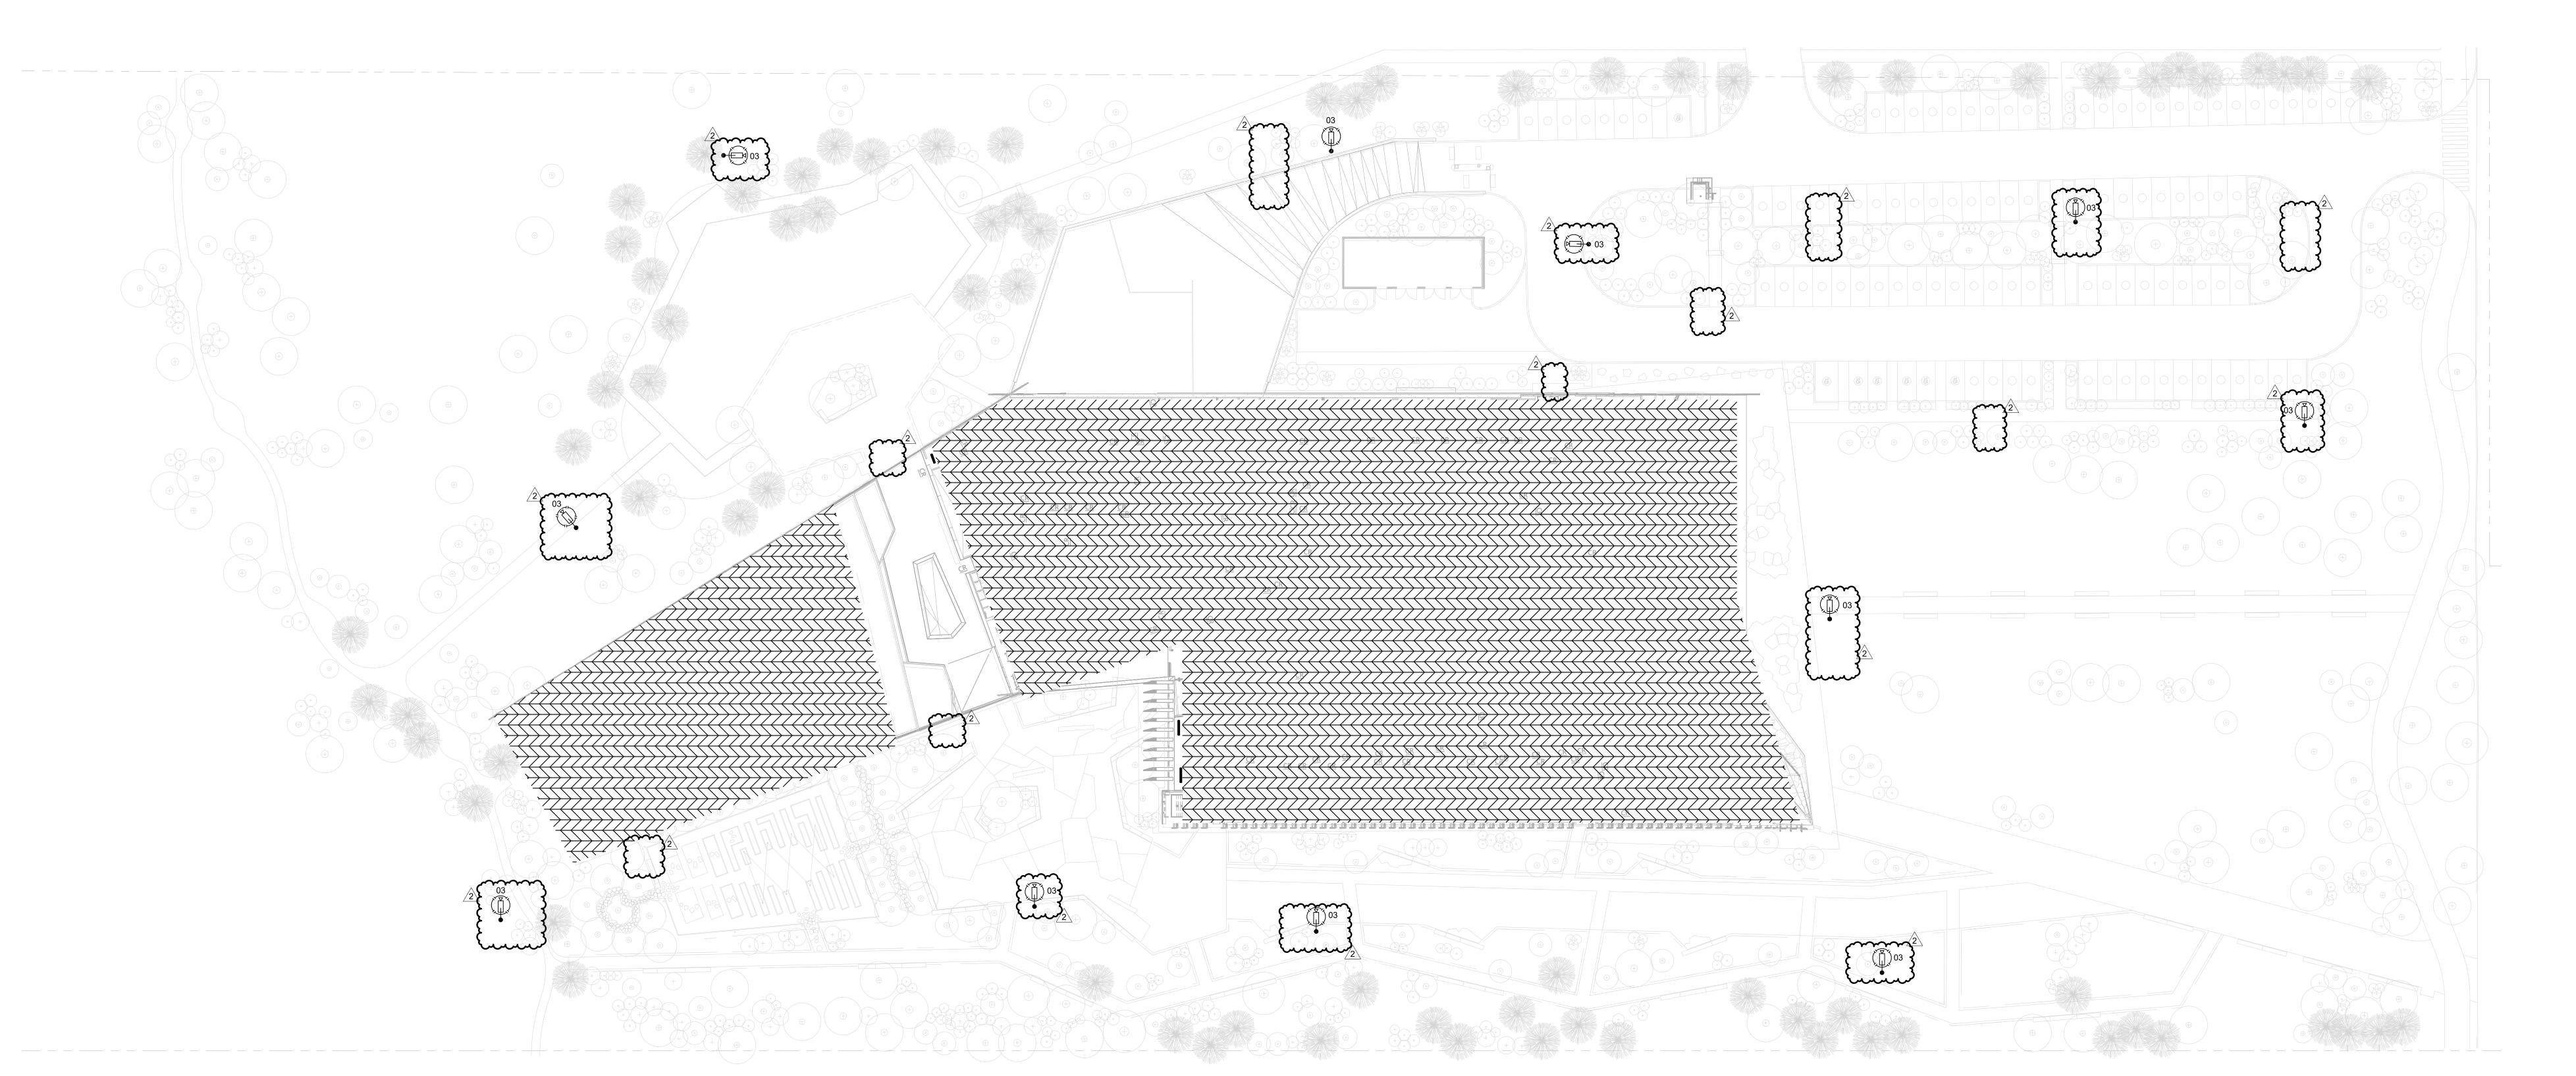

1" = 30'-0"

801 South Spring Street Little Rock, AR 72201 501.378.0878 office 509 W. Spring St. | Suite 150 Fayetteville, AR 72701 479.444.0473 office

polkstanleywilcox.com

•

LANDSCAPE

McClelland Consulting Engineers, Inc. 1580 E STEARNS ST FAYETTEVILLE, AR 72703 P: 479.443.2377

BROOKLYN, NY 11217 P: 917.553.5586 STRUCTURAL Martin/Martin Consulting Engineers 900B SOUTH WALTON BLVD, STE 27

BENTONVILLE, AR 72712

P: 479.407.0945

OSD 115 ST. JOHNS PLACE

MEPF + LOW VOLTAGE Henderson Engineers 8345 LENEXA DRIVE, STE 300 LENEXA, KS 66214 P: 913.660.6187 SUSTAINABILITY 224 SOUTH MICHIGAN AVENUE

CHICAGO, IL 60604 P: 312.360.4121 SIGNAGE + WAYFINDING TWO TWELVE 236 W. 27th ST., SUITE 802 NEW YORK, NY 10001

FOOD SERVICE JME HOSPITALITY 9595 SIX PINES DR., SUITE 8210 THE WOODLANDS, TX 77380 P: 609.641.2222

P: 212.254.6670

WATER FEATURES 2150 S. TOWNE CENTER, SUITE 100 ANAHEIM, CA 92806 P: 714.637.4747

IRRIGATION WC3 DESIGN 11A ROBINSON MANOR BLVD. MCKEES ROCK, PA 14136 P: 844.231.7042

> PSW Job Number: Henderson Job Number:

> 2150002607

PROFESSIONAL ENGINEER No. 18598

Issue Date: 02.24.2023

SECURITY SITE



509 W. Spring St. | Suite 150 polkstanleywilcox.com

McClelland Consulting Engineers, Inc.

STRUCTURAL

Martin/Martin Consulting Engineers


900B SOUTH WALTON BLVD, STE 27 BENTONVILLE, AR 72712

Henderson Engineers 8345 LENEXA DRIVE, STE 300 224 SOUTH MICHIGAN AVENUE

JME HOSPITALITY 9595 SIX PINES DR., SUITE 8210 THE WOODLANDS, TX 77380

OTL 2150 S. TOWNE CENTER, SUITE 100

MCKEES ROCK, PA 14136

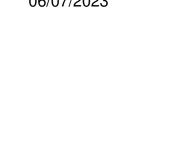

SECURITY PLAN NOTES: TY3 SECURITY PANEL. CONTRACTOR TO PROVIDE EXACT
QUANTITY OF PANELS IN SHOP DRAWINGS FOR REVIEW.
REFER TO TN DRAWINGS ON EXACT LOCATION WHERE DATA IS SHOWN. REFER TO TN SERIES PLANS FOR SERVING ZONE INFROMATION. maniment **BIO HAZ** Junean Marie munique promise TELECOM/ DEMARC **MECHANICAL** 0124 STORAGE 0126 ALL STRUCTURED AND LOW VOLTAGE CABLING ON THIS SIDE OF LINE IS TO BE FED FROM TELECOM/DEMARC #0120. **KEY PLAN**

POLK
STANLEY
EVIEW.
HERE DATA
WILCOX

801 South Spring Street Little Rock, AR 72201 501.378.0878 office 509 W. Spring St. | Suite 150 Fayetteville, AR 72701 479.444.0473 office

Fayetteville, AR 72701
479.444.0473 office

polkstanleywilcox.com

McClelland Consulting Engineers, Inc.
1580 E STEARNS ST
FAYETTEVILLE, AR 72703
P: 479.443.2377

LANDSCAPE
OSD
115 ST. JOHNS PLACE
BROOKLYN, NY 11217
P: 917.553.5586

STRUCTURAL

Martin/Martin Consulting Engineers

900B SOUTH WALTON BLVD, STE 27

BENTONVILLE, AR 72712

P: 479.407.0945

MEPF + LOW VOLTAGE
Henderson Engineers
8345 LENEXA DRIVE, STE 300
LENEXA, KS 66214
P: 913.660.6187

SUSTAINABILITY
SOM
224 SOUTH MICHIGAN AVENUE
CHICAGO, IL 60604
P: 312.360.4121

SIGNAGE + WAYFINDING
TWO TWELVE
236 W. 27th ST., SUITE 802
NEW YORK, NY 10001
P: 212.254.6670

FOOD SERVICE

JME HOSPITALITY
9595 SIX PINES DR., SUITE 8210
THE WOODLANDS, TX 77380
P: 609.641.2222

WATER FEATURES
OTL
2150 S. TOWNE CENTER, SUITE 100

P: 714.637.4747

IRRIGATION

WC3 DESIGN

11A ROBINSON MANOR BLVD.
MCKEES ROCK, PA 14136

ANAHEIM, CA 92806

P: 844.231.7042

PSW Job Number:
993A
Henderson Job Number:
2150002607



AWSOM
Bentonville, AR

Issue Date: 02.24.2023

 NUMBER
 DATE
 DESCRIPTION

 1
 03.10.23
 Addendum 1

 2
 06.09.23
 Addendum 2

SECURITY -LEVEL 0 PLAN -AREA B



POLK STANLEY

801 South Spring Street Little Rock, AR 72201 501.378.0878 office 509 W. Spring St. | Suite 150 Fayetteville, AR 72701 479.444.0473 office

polkstanleywilcox.com

McClelland Consulting Engineers, Inc. 1580 E STEARNS ST FAYETTEVILLE, AR 72703 P: 479.443.2377 LANDSCAPE **OSD** 115 ST. JOHNS PLACE

BROOKLYN, NY 11217 P: 917.553.5586 STRUCTURAL

Martin/Martin Consulting Engineers

900B SOUTH WALTON BLVD, STE 27 BENTONVILLE, AR 72712

P: 479.407.0945 MEPF + LOW VOLTAGE **Henderson Engineers** 8345 LENEXA DRIVE, STE 300 LENEXA, KS 66214 P: 913.660.6187 SUSTAINABILITY

224 SOUTH MICHIGAN AVENUE CHICAGO, IL 60604 P: 312.360.4121 SIGNAGE + WAYFINDING TWO TWELVE 236 W. 27th ST., SUITE 802 NEW YORK, NY 10001

P: 212.254.6670 FOOD SERVICE JME HOSPITALITY 9595 SIX PINES DR., SUITE 8210 THE WOODLANDS, TX 77380 P: 609.641.2222

WATER FEATURES OTL 2150 S. TOWNE CENTER, SUITE 100 ANAHEIM, CA 92806 P: 714.637.4747

IRRIGATION **WC3 DESIGN** 11A ROBINSON MANOR BLVD. MCKEES ROCK, PA 14136 P: 844.231.7042


993A 2150002607



AWSOM
Bentonville, AR

Issue Date: 02.24.2023

SECURITY -LEVEL 1 PLAN -AREA A

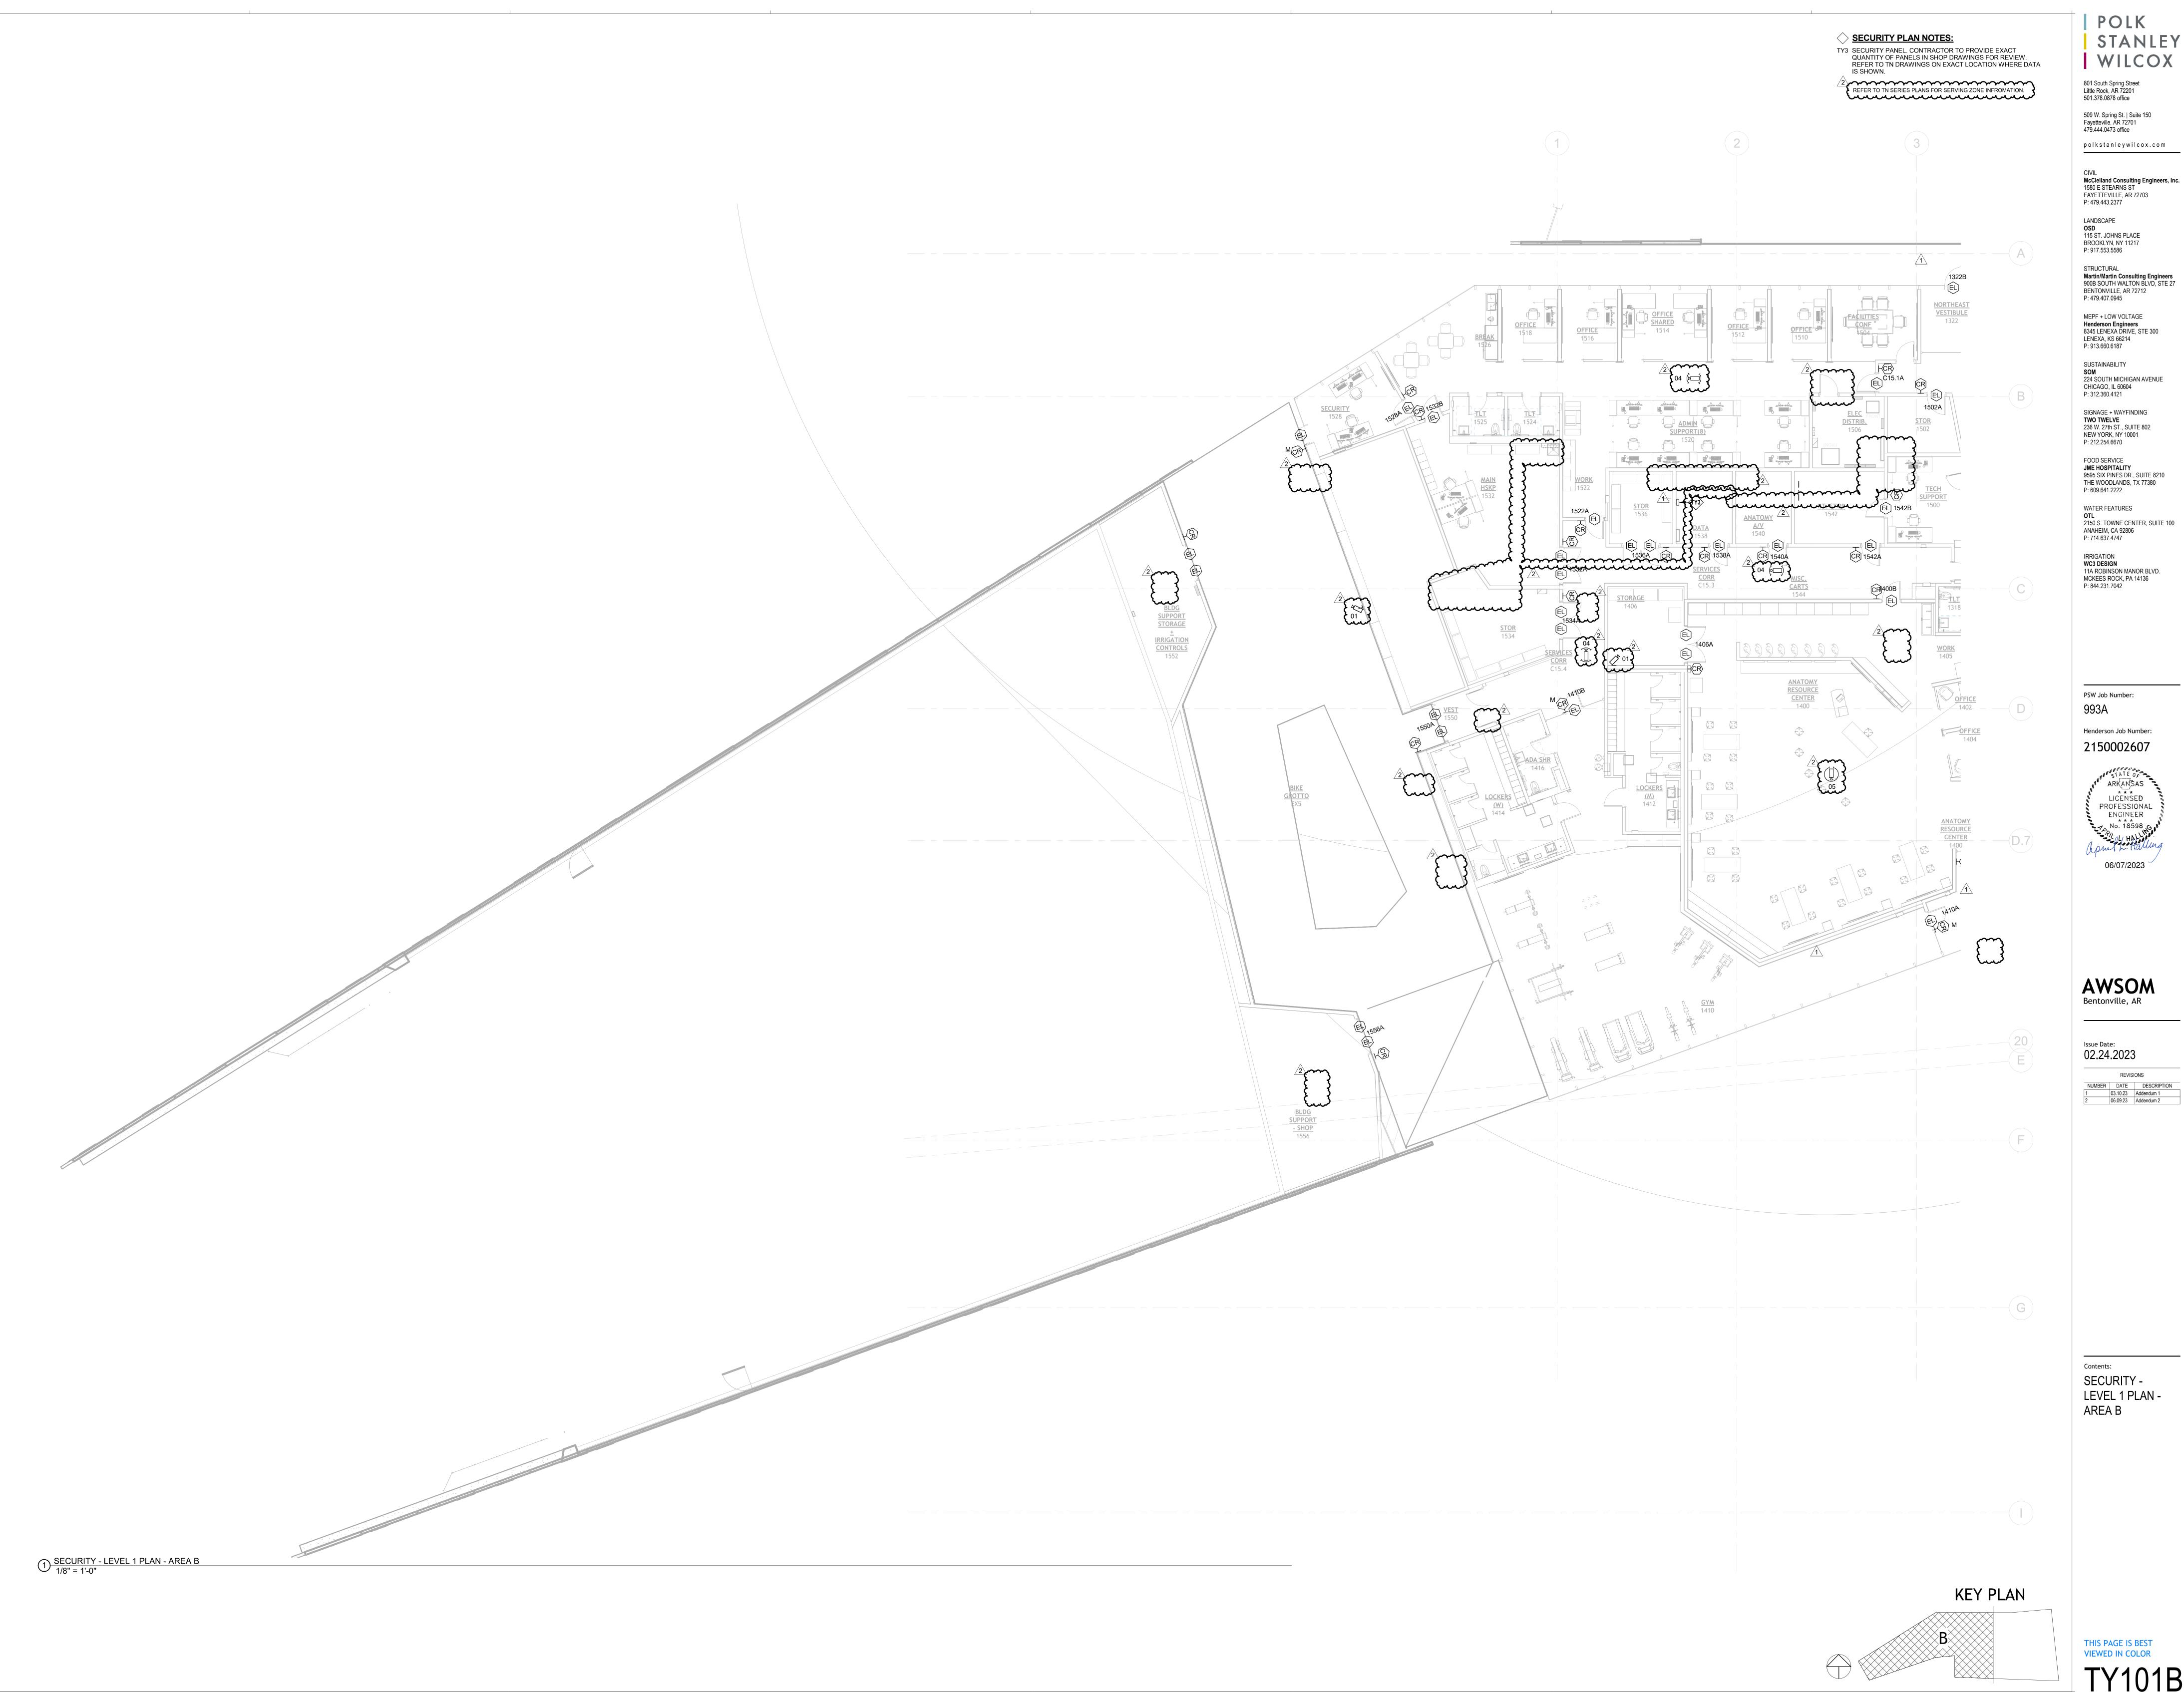

POLK

801 South Spring Street Little Rock, AR 72201 501.378.0878 office 509 W. Spring St. | Suite 150 Fayetteville, AR 72701 479.444.0473 office

polkstanleywilcox.com

McClelland Consulting Engineers, Inc. 1580 E STEARNS ST FAYETTEVILLE, AR 72703 P: 479.443.2377 LANDSCAPE OSD 115 ST. JOHNS PLACE

BROOKLYN, NY 11217 P: 917.553.5586 STRUCTURAL
Martin/Martin Consulting Engineers
900B SOUTH WALTON BLVD, STE 27 BENTONVILLE, AR 72712 P: 479.407.0945

MEPF + LOW VOLTAGE **Henderson Engineers** 8345 LENEXA DRIVE, STE 300 LENEXA, KS 66214 P: 913.660.6187 SUSTAINABILITY 224 SOUTH MICHIGAN AVENUE CHICAGO, IL 60604 P: 312.360.4121 SIGNAGE + WAYFINDING

TWO TWELVE 236 W. 27th ST., SUITE 802 NEW YORK, NY 10001 P: 212.254.6670 FOOD SERVICE JME HOSPITALITY 9595 SIX PINES DR., SUITE 8210 THE WOODLANDS, TX 77380 P: 609.641.2222

WATER FEATURES OTL 2150 S. TOWNE CENTER, SUITE 100 ANAHEIM, CA 92806 P: 714.637.4747

IRRIGATION **WC3 DESIGN** 11A ROBINSON MANOR BLVD. MCKEES ROCK, PA 14136 P: 844.231.7042


> Henderson Job Number: 2150002607



AWSOM
Bentonville, AR

Issue Date: 02.24.2023

SECURITY -LEVEL 1 PLAN -AREA B

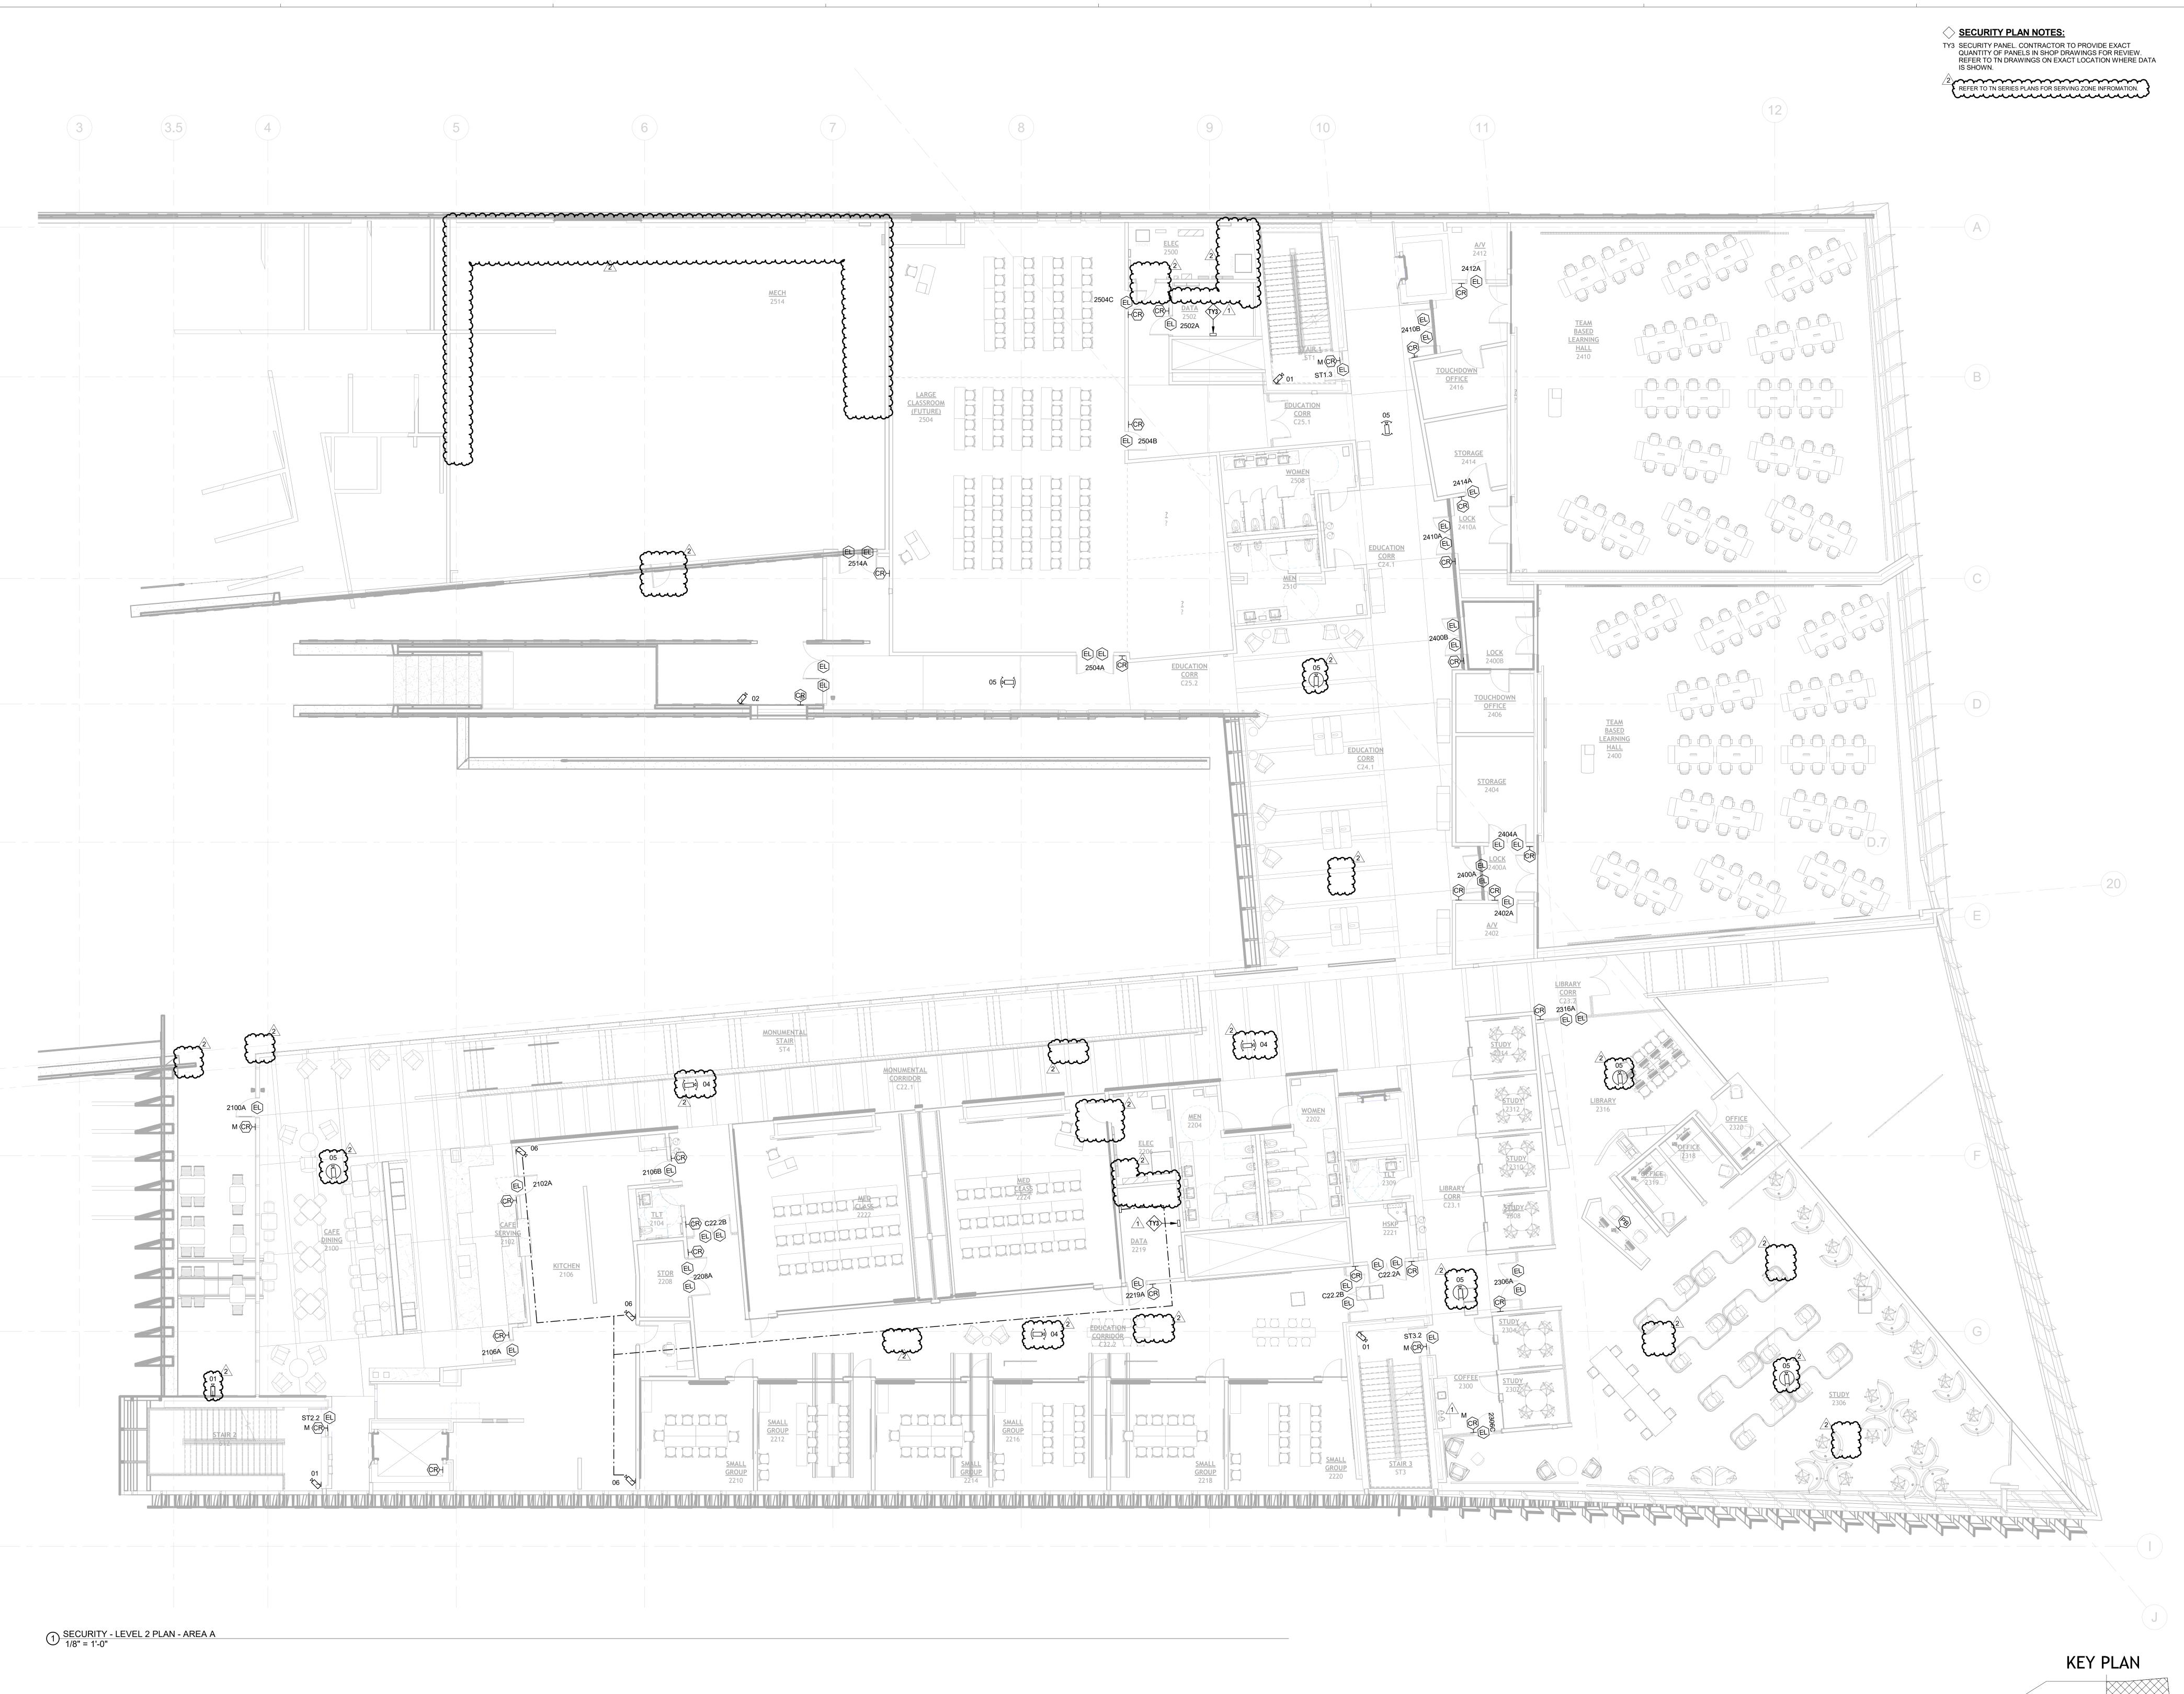

SECURITY -LEVEL 2 PLAN -AREA A

POLK

801 South Spring Street Little Rock, AR 72201 501.378.0878 office

509 W. Spring St. | Suite 150 Fayetteville, AR 72701 479.444.0473 office

FAYETTEVILLE, AR 72703

OSD 115 ST. JOHNS PLACE BROOKLYN, NY 11217 P: 917.553.5586

P: 479.443.2377

LANDSCAPE

polkstanleywilcox.com

McClelland Consulting Engineers, Inc. 1580 E STEARNS ST

STRUCTURAL
Martin/Martin Consulting Engineers
900B SOUTH WALTON BLVD, STE 27

BENTONVILLE, AR 72712

MEPF + LOW VOLTAGE

LENEXA, KS 66214 P: 913.660.6187

SUSTAINABILITY

CHICAGO, IL 60604

SIGNAGE + WAYFINDING

236 W. 27th ST., SUITE 802 NEW YORK, NY 10001

JME HOSPITALITY 9595 SIX PINES DR., SUITE 8210 THE WOODLANDS, TX 77380

OTL 2150 S. TOWNE CENTER, SUITE 100

P: 312.360.4121

TWO TWELVE

P: 212.254.6670

FOOD SERVICE

P: 609.641.2222

WATER FEATURES

ANAHEIM, CA 92806 P: 714.637.4747

IRRIGATION **WC3 DESIGN** 11A ROBINSON MANOR BLVD.

MCKEES ROCK, PA 14136

P: 844.231.7042

PSW Job Number:

Henderson Job Number:

2150002607

ARKANSAS LICENSED

PROFESSIONAL ENGINEER No. 18598

AWSOM
Bentonville, AR

Issue Date: 02.24.2023

 NUMBER
 DATE
 DESCRIPTION

 1
 03.10.23
 Addendum 1

 2
 06.09.23
 Addendum 2

Henderson Engineers 8345 LENEXA DRIVE, STE 300

224 SOUTH MICHIGAN AVENUE

P: 479.407.0945

STANLEY

WILCOX



801 South Spring Street Little Rock, AR 72201 501.378.0878 office 509 W. Spring St. | Suite 150 Fayetteville, AR 72701 479.444.0473 office

polkstanleywilcox.com

McClelland Consulting Engineers, Inc. 1580 E STEARNS ST FAYETTEVILLE, AR 72703 P: 479.443.2377 LANDSCAPE **OSD** 115 ST. JOHNS PLACE

BROOKLYN, NY 11217 P: 917.553.5586 STRUCTURAL Martin/Martin Consulting Engineers 900B SOUTH WALTON BLVD, STE 27 BENTONVILLE, AR 72712 P: 479.407.0945

MEPF + LOW VOLTAGE Henderson Engineers 8345 LENEXA DRIVE, STE 300 LENEXA, KS 66214 P: 913.660.6187 SUSTAINABILITY 224 SOUTH MICHIGAN AVENUE CHICAGO, IL 60604 P: 312.360.4121 SIGNAGE + WAYFINDING TWO TWELVE

NEW YORK, NY 10001 P: 212.254.6670 FOOD SERVICE JME HOSPITALITY 9595 SIX PINES DR., SUITE 8210 THE WOODLANDS, TX 77380 P: 609.641.2222 WATER FEATURES 2150 S. TOWNE CENTER, SUITE 100

P: 714.637.4747 IRRIGATION WC3 DESIGN 11A ROBINSON MANOR BLVD. MCKEES ROCK, PA 14136 P: 844.231.7042

PSW Job Number: 993A Henderson Job Number: 2150002607



AWSOM
Bentonville, AR


Issue Date: 02.24.2023
 NUMBER
 DATE
 DESCRIPTION

 1
 03.10.23
 Addendum 1

 2
 06.09.23
 Addendum 2

 3
 02.27.25
 ASI 035

SECURITY -LEVEL 3 PLAN -AREA A

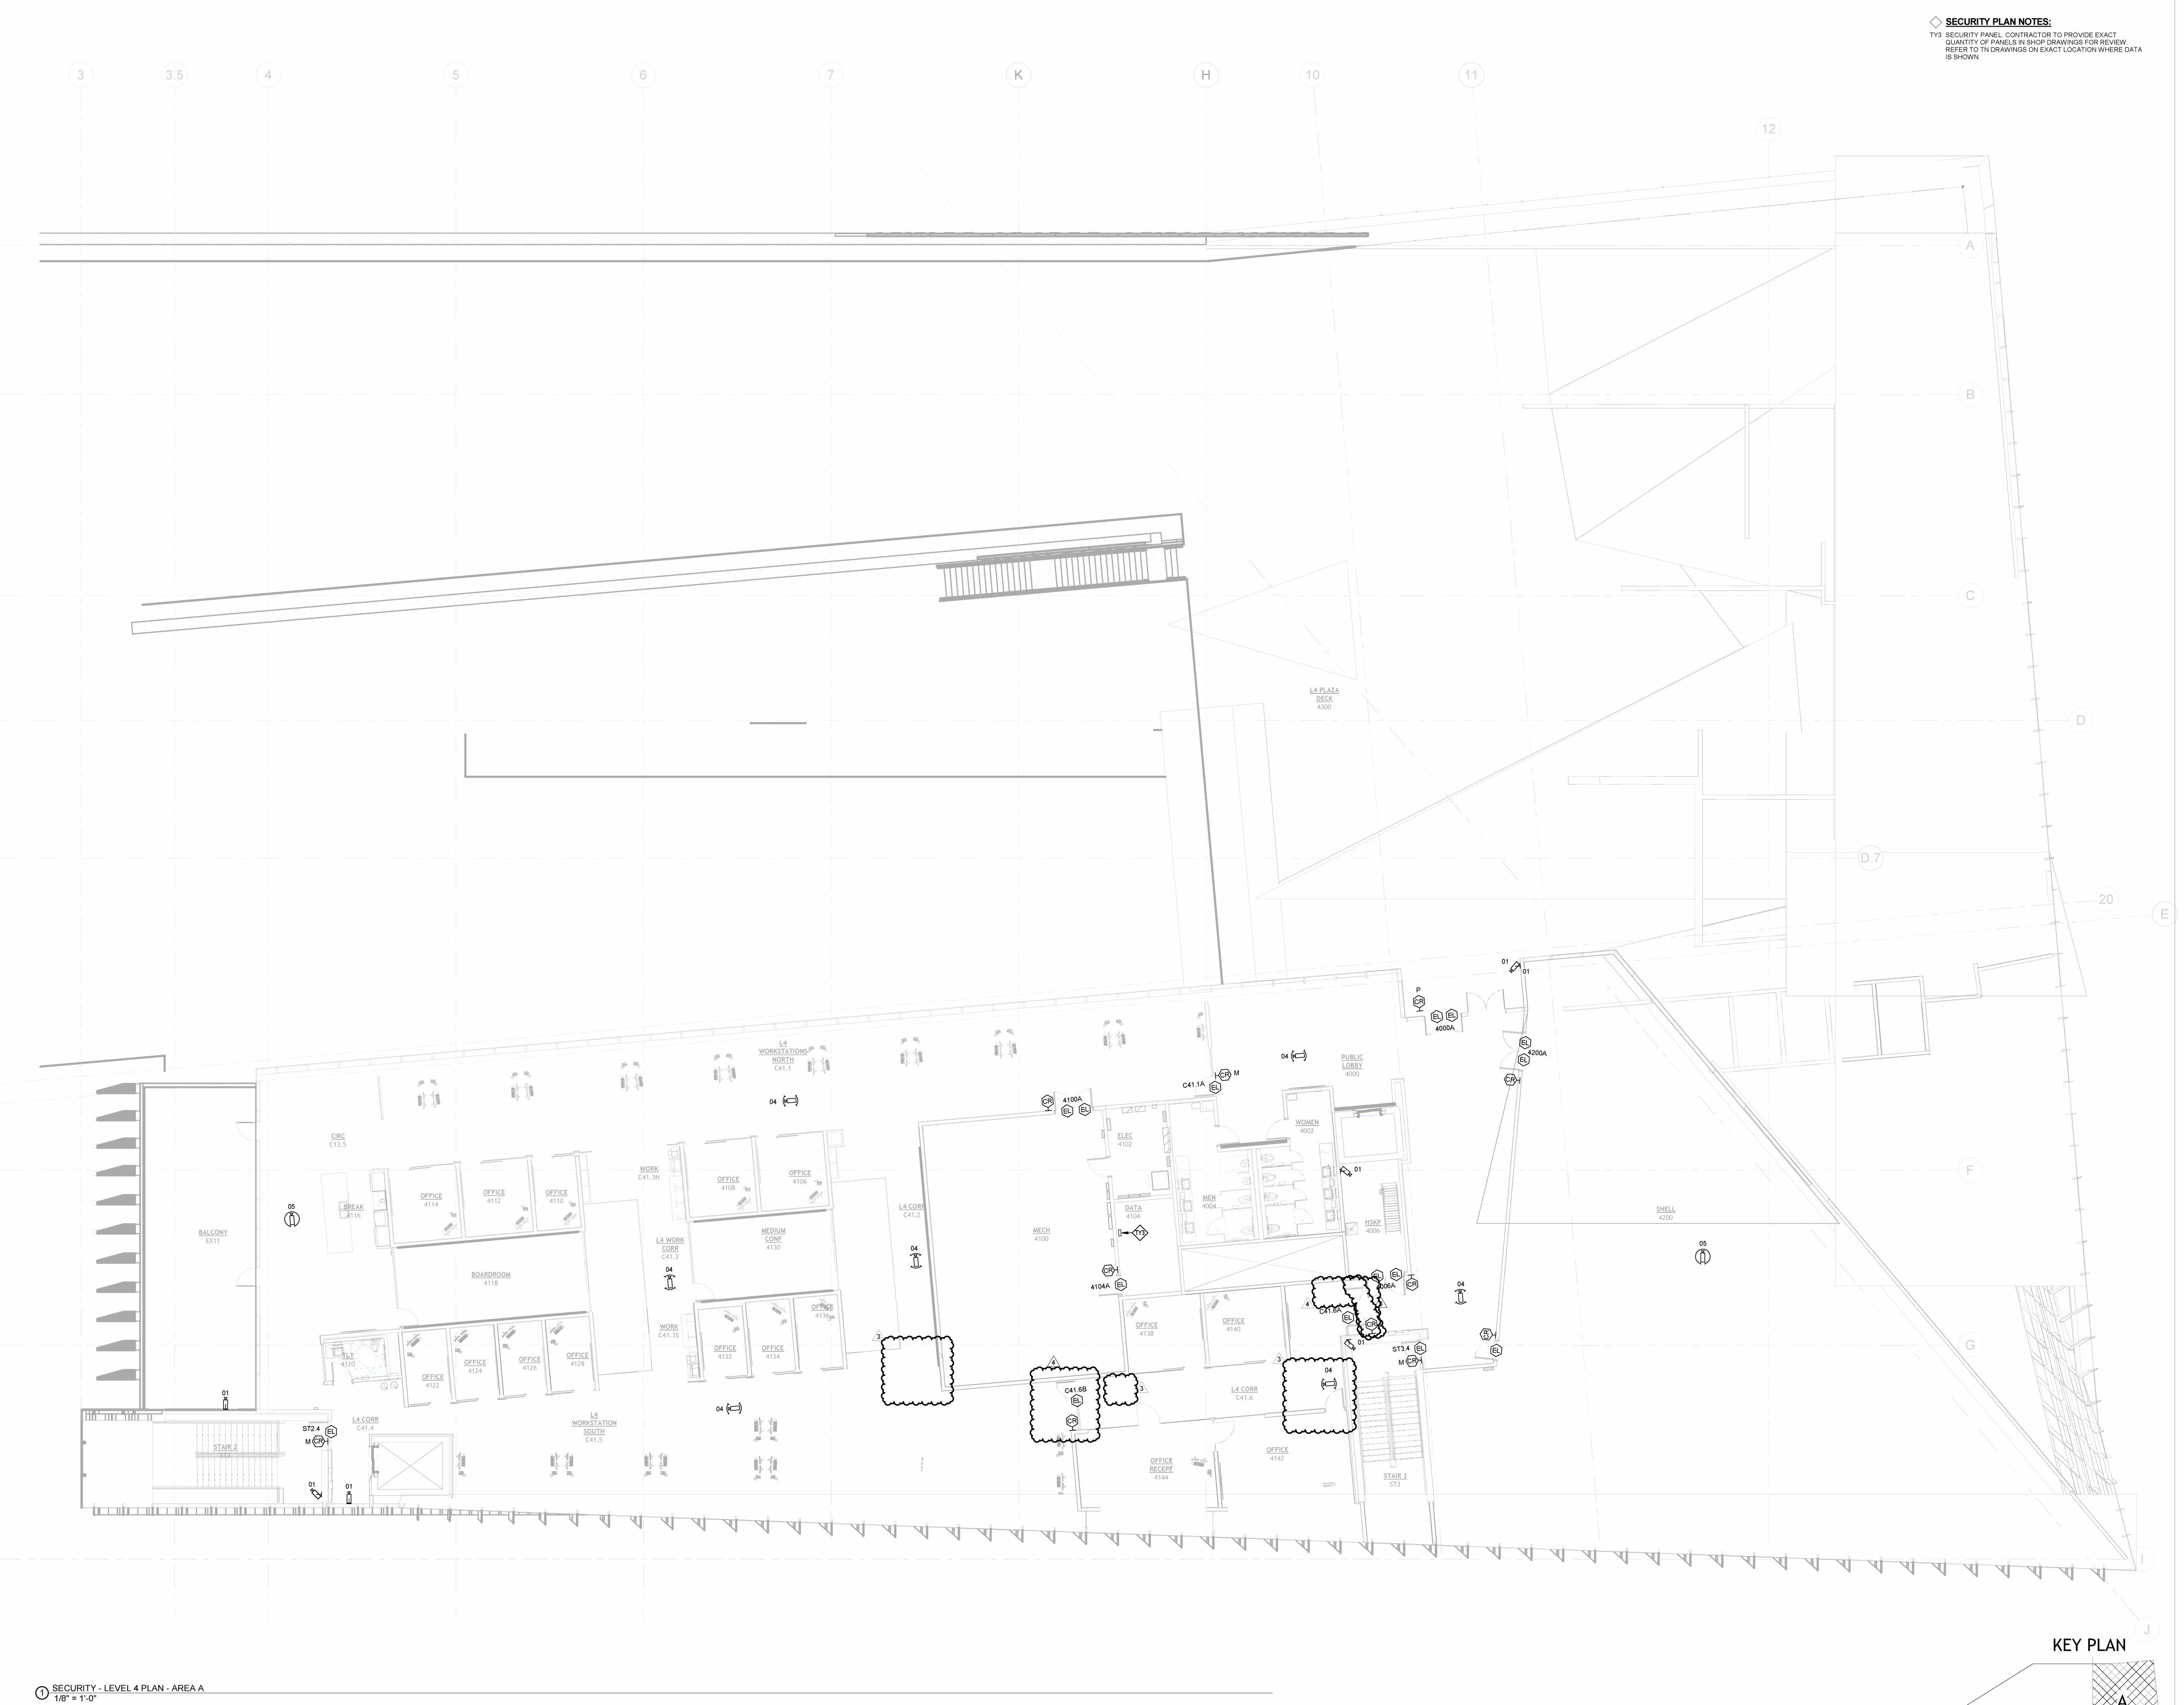

| POLK | STANLEY | WILCOX

801 South Spring Street
Little Rock, AR 72201
501.378.0878 office

509 W. Spring St. | Suite 150
Fayetteville, AR 72701
479 444 0473 office

509 W. Spring St. | Suite 150
Fayetteville, AR 72701
479.444.0473 office
polkstanleywilcox.com

CIVIL
McClelland Consulting Engineers, Inc.
1580 E STEARNS ST
FAYETTEVILLE, AR 72703
P: 479.443.2377

LANDSCAPE
OSD
115 ST. JOHNS PLACE

BROOKLYN, NY 11217
P: 917.553.5586

STRUCTURAL
Martin/Martin Consulting Engineers
900B SOUTH WALTON BLVD, STE 27

900B SOUTH WALTON BLVD, STE 27 BENTONVILLE, AR 72712 P: 479.407.0945 MEPF + LOW VOLTAGE Henderson Engineers 8345 LENEXA DRIVE, STE 300 LENEXA, KS 66214 P: 913.660.6187

SUSTAINABILITY
SOM
224 SOUTH MICHIGAN AVENUE
CHICAGO, IL 60604
P: 312.360.4121

SIGNAGE + WAYFINDING
TWO TWELVE
236 W. 27th ST., SUITE 802
NEW YORK, NY 10001

P: 212.254.6670

FOOD SERVICE

JME HOSPITALITY

9595 SIX PINES DR., SUITE 8210

THE WOODLANDS, TX 77380

P: 609.641.2222

WATER FEATURES
OTL
2150 S. TOWNE CENTER, SUITE 100
ANAHEIM, CA 92806
P: 714.637.4747

IRRIGATION

IRRIGATION
WC3 DESIGN
11A ROBINSON MANOR BLVD.
MCKEES ROCK, PA 14136
P: 844.231.7042

PSW Job Number:
993A
Henderson Job Number:
2150002607



AWSOM
Bentonville, AR

Issue Date: 02.24.2023

NUMBER DATE DESCRIPTION

1 03.10.23 Addendum 1

2 06.09.23 Addendum 2

3 08.23.24 PR-074

4 10.07.24 PR-088

SECURITY -LEVEL 4 PLAN -AREA A

SECURITY PLAN NOTES: TY4 ALL CAMERAS SHALL HAVE CATEGORY CABLING
TERMINATED BACK TO 4TH FLOOR IDF, DATA 4104, WITH POE
INJECTORS SUPPLIED AS REQUIRED TO MEET
MULTISENSOR/PTZ VOLTAGE REQUIREMENTS. EACH POE
INJECTOR SHALL REQUIRE A 120V CONNECTION.
CONTRACTOR SHALL UTILIZE DUPLEXES IN DATA RACKS
FOR POWER REQUIREMENTS REFER TO TN SERIES PLANS FOR SERVING ZONE INFROMATION.

SECURITY PLAN - ROOF - AREA A Copy 1
1/8" = 1'-0"

KEY PLAN

POLK STANLEY

801 South Spring Street Little Rock, AR 72201 501.378.0878 office 509 W. Spring St. | Suite 150 Fayetteville, AR 72701 479.444.0473 office

McClelland Consulting Engineers, Inc. 1580 E STEARNS ST FAYETTEVILLE, AR 72703 P: 479.443.2377

polkstanleywilcox.com

BROOKLYN, NY 11217 P: 917.553.5586

OSD 115 ST. JOHNS PLACE

LANDSCAPE

STRUCTURAL
Martin/Martin Consulting Engineers
900B SOUTH WALTON BLVD, STE 27
BENTONVILLE, AR 72712
P: 479.407.0945 MEPF + LOW VOLTAGE

Henderson Engineers 8345 LENEXA DRIVE, STE 300 LENEXA, KS 66214 P: 913.660.6187 SUSTAINABILITY 224 SOUTH MICHIGAN AVENUE CHICAGO, IL 60604 P: 312.360.4121 SIGNAGE + WAYFINDING **TWO TWELVE** 236 W. 27th ST., SUITE 802

NEW YORK, NY 10001

P: 212.254.6670 FOOD SERVICE JME HOSPITALITY 9595 SIX PINES DR., SUITE 8210 THE WOODLANDS, TX 77380 P: 609.641.2222 WATER FEATURES

OTL 2150 S. TOWNE CENTER, SUITE 100 ANAHEIM, CA 92806 P: 714.637.4747


IRRIGATION **WC3 DESIGN** 11A ROBINSON MANOR BLVD. MCKEES ROCK, PA 14136 P: 844.231.7042


Henderson Job Number: 2150002607





Issue Date: 12.12.2024


SECURITY -LEVEL 5 PLAN -ROOF AREA A

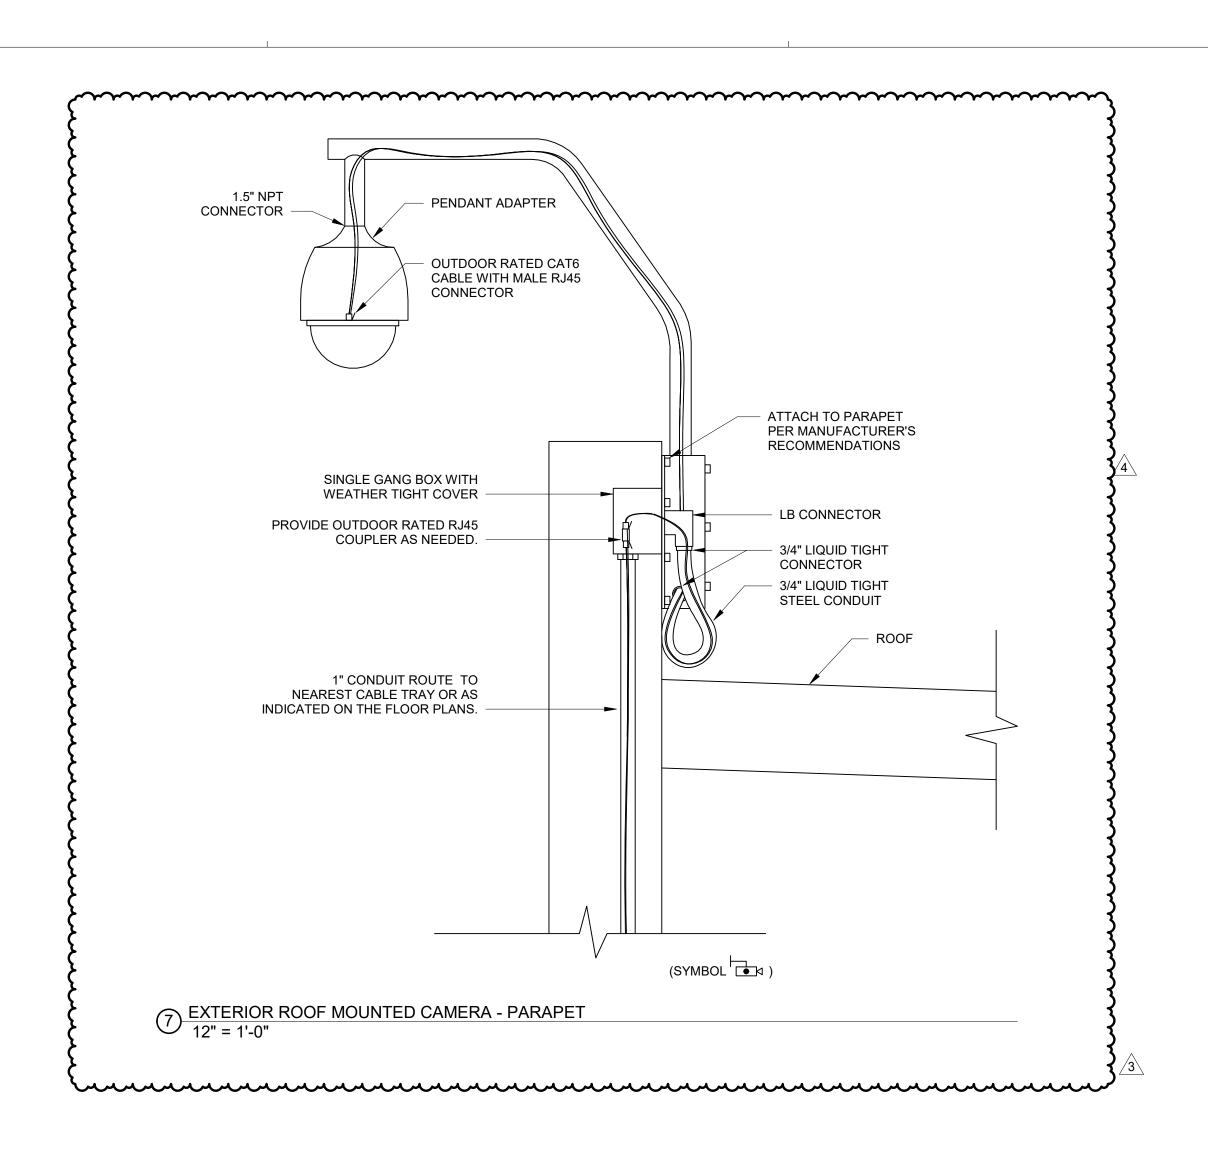


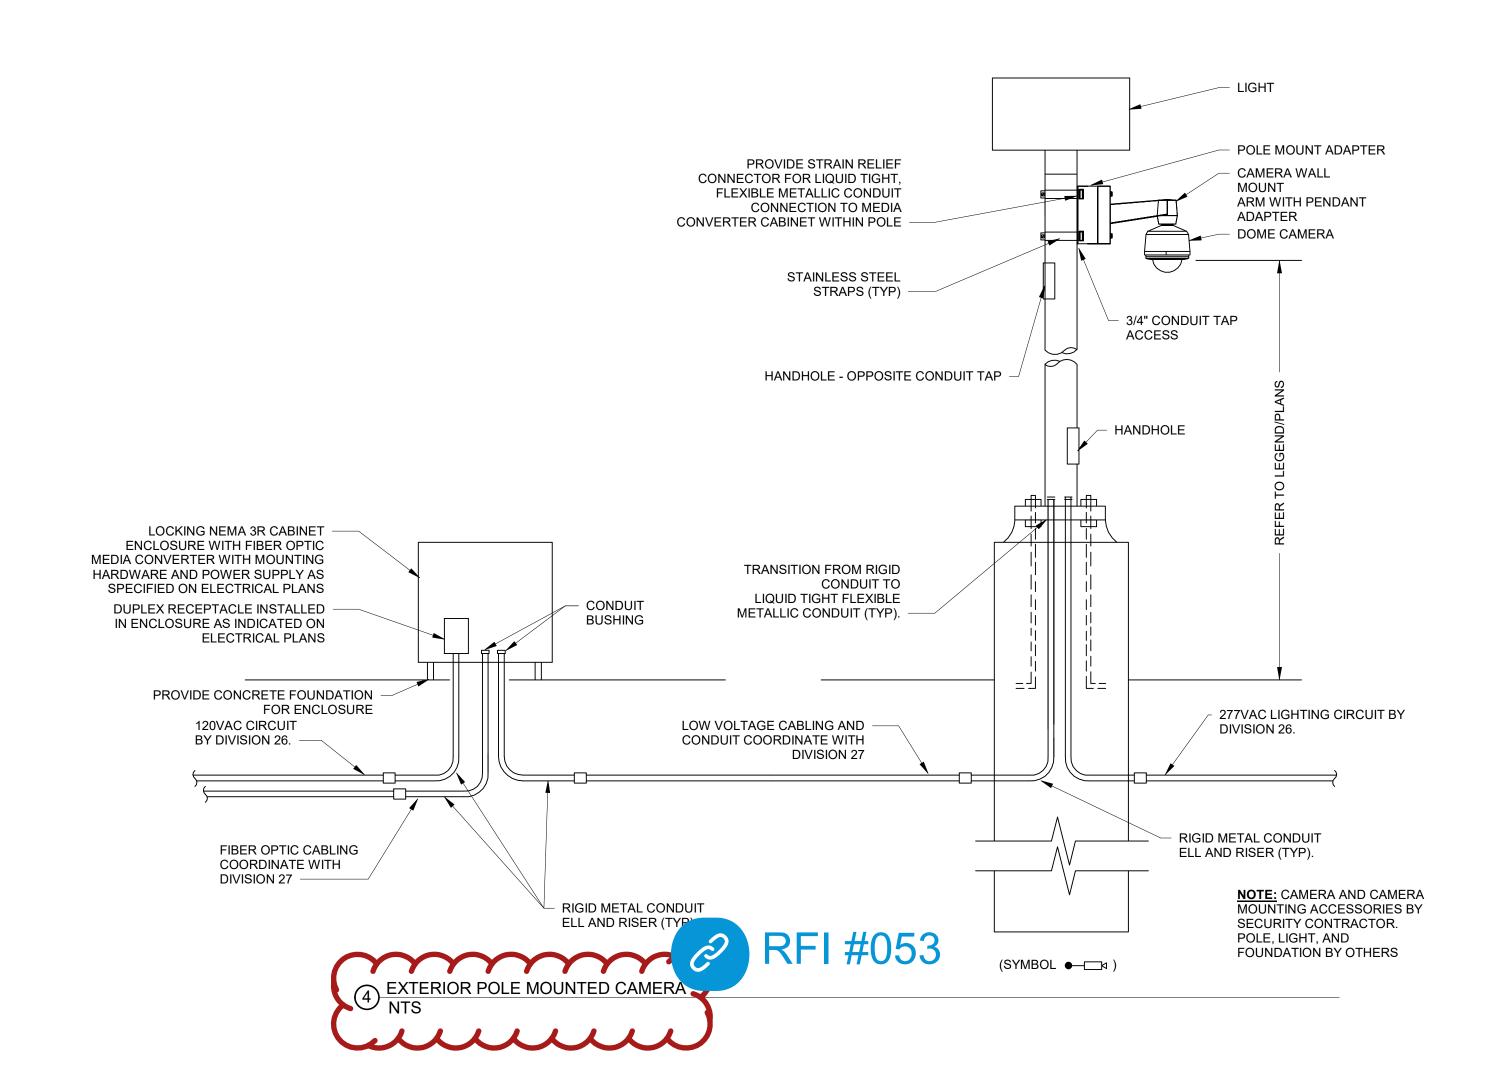


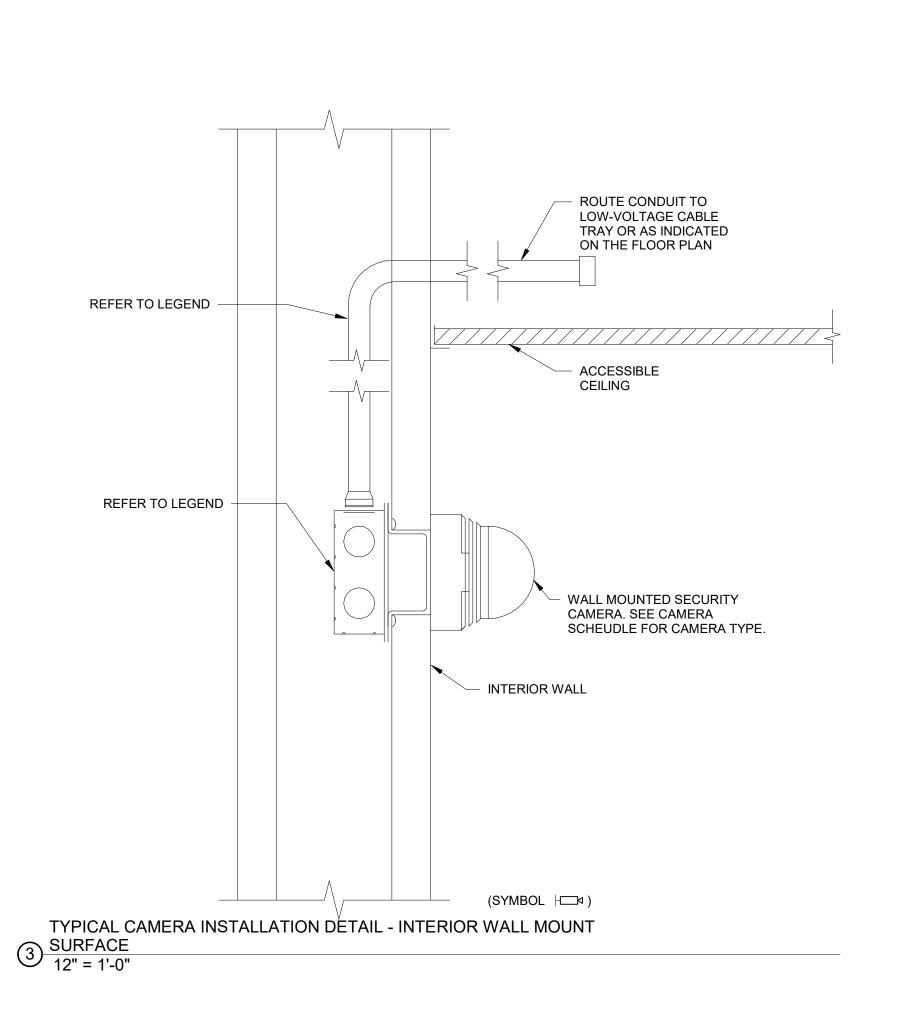

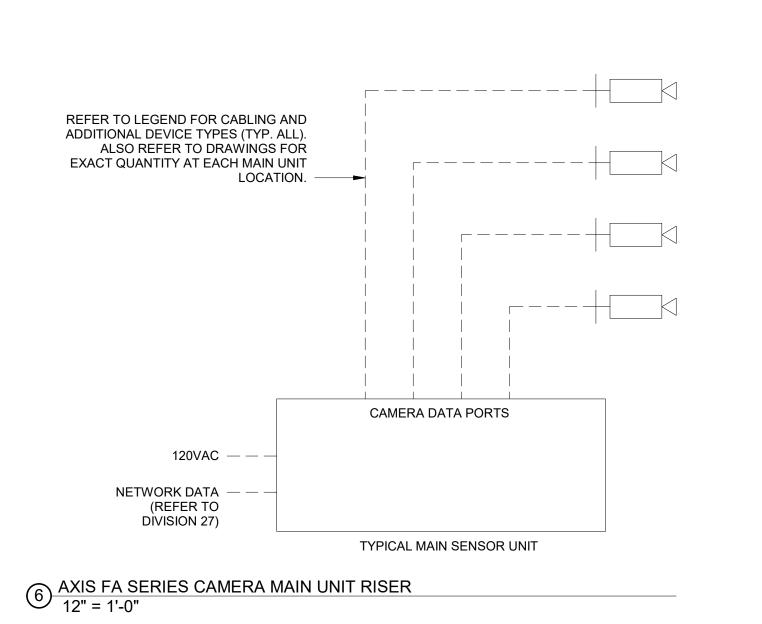

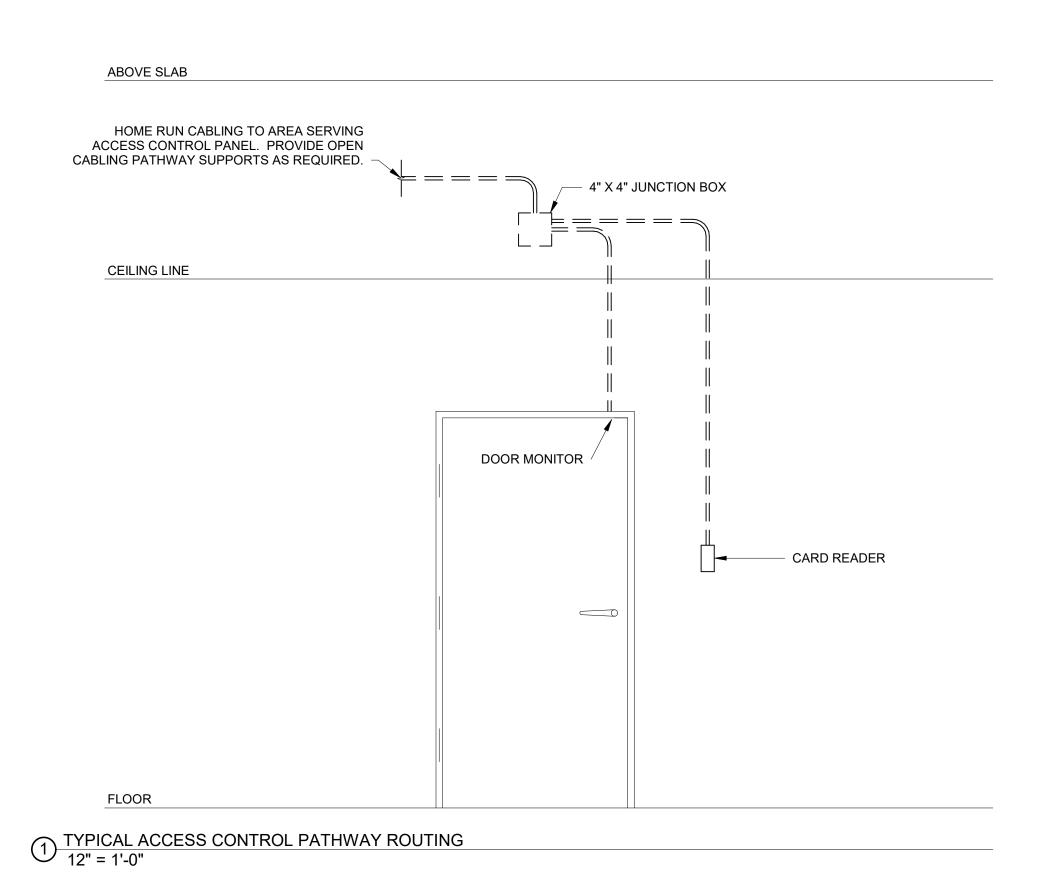

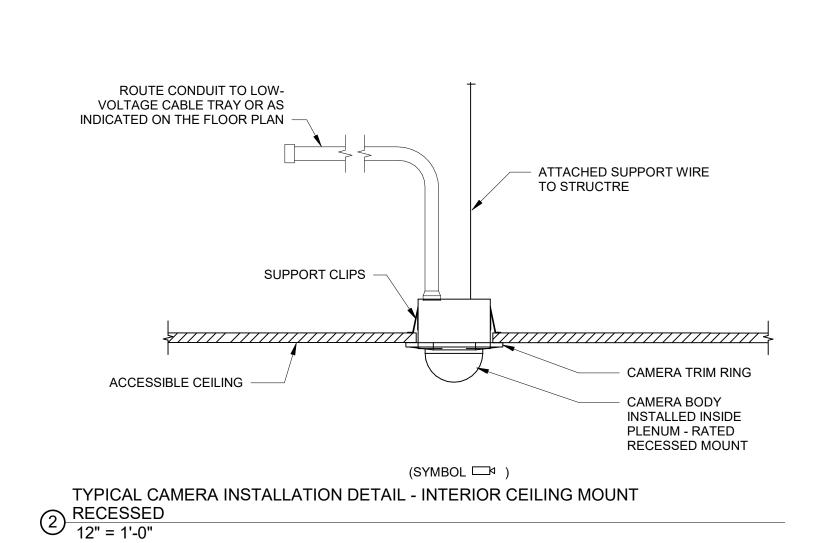

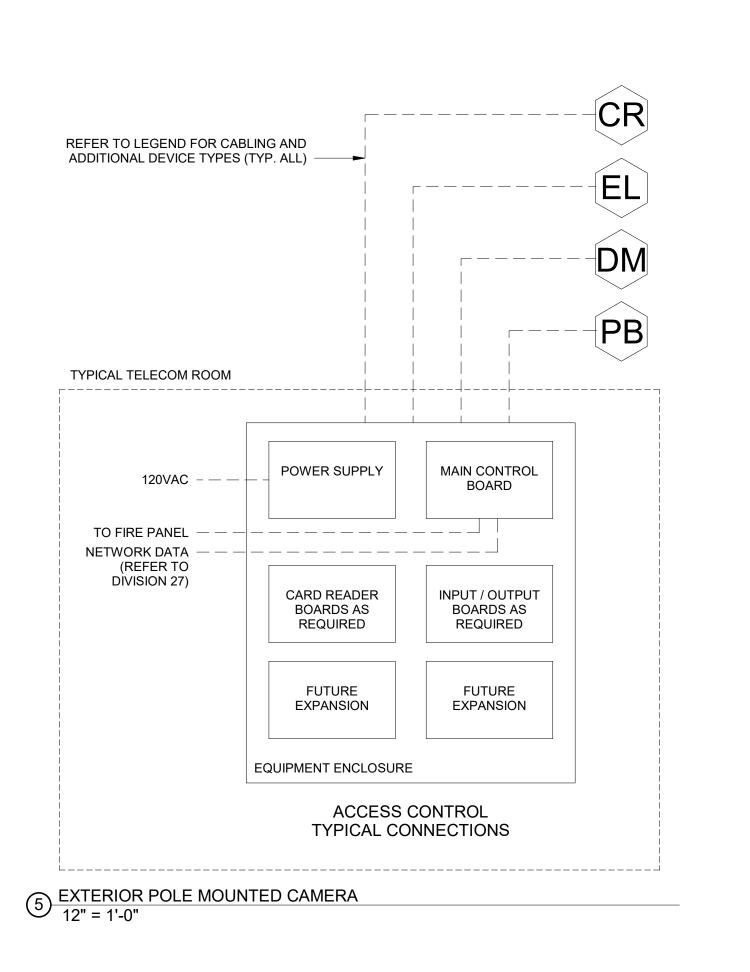

POLK
STANLEY
WILCOX

801 South Spring Street
Little Rock, AR 72201
501 378 0878 office

801 South Spring Street
Little Rock, AR 72201
501.378.0878 office

509 W. Spring St. | Suite 150
Fayetteville, AR 72701
479.444.0473 office

polkstanleywilcox.com

CIVIL
McClelland Consulting Engineers, Inc.
1580 E STEARNS ST
FAYETTEVILLE, AR 72703
P: 479.443.2377

LANDSCAPE

OSD
115 ST. JOHNS PLACE
BROOKLYN, NY 11217
P: 917.553.5586

STRUCTURAL
Martin/Martin Consulting Engineers
900B SOUTH WALTON BLVD, STE 27

900B SOUTH WALTON BLVD, STE 27
BENTONVILLE, AR 72712
P: 479.407.0945

MEPF + LOW VOLTAGE
Henderson Engineers
8345 LENEXA DRIVE, STE 300
LENEXA, KS 66214
P: 913.660.6187

SUSTAINABILITY
SOM
224 SOUTH MICHIGAN AVENUE

P: 312.360.4121

SIGNAGE + WAYFINDING
TWO TWELVE
236 W. 27th ST., SUITE 802
NEW YORK, NY 10001
P: 212.254.6670

FOOD SERVICE
JME HOSPITALITY
9595 SIX PINES DR., SUITE 8210
THE WOODLANDS, TX 77380

P: 609.641.2222

CHICAGO, IL 60604

WATER FEATURES
OTL
2150 S. TOWNE CENTER, SUITE 100
ANAHEIM, CA 92806
P: 714.637.4747

IRRIGATION
WC3 DESIGN
11A ROBINSON MANOR BLVD.
MCKEES ROCK, PA 14136
P: 844.231.7042

PSW Job Number:
993A
Henderson Job Number:
2150002607



AWSOM

Bentonville, AR

Issue Date: 02/24/23

 NUMBER
 DATE
 DESCRIPTION

 1
 03.10.23
 Addendum 1

 2
 06.09.23
 Addendum 2

 3
 12.12.24
 PR-089

 4
 03.06.25
 PR-089R

Contents:
SECURITY
DETAILS