



AIA[®] Document G709[™] – 2018

Proposal Request

PROJECT: *(name and address)*
AWSOM
Bentonville, Arkansas

CONTRACT INFORMATION:
Contract For: General Construction
Date: 11.09.2021

Architect's Project Number: 993A
Proposal Request Number: 042
Proposal Request Date: 3.21.2024

OWNER: *(name and address)*
AWSOM Lands, LLC
PO Box 2030
Bentonville, AR 72712

ARCHITECT: *(name and address)*
Polk Stanley Wilcox
509 W. Spring St., Ste 150
Fayetteville, AR 72701

CONTRACTOR: *(name and address)*
Crossland Construction Company
1800 S. 52nd Street, Suite 410
Rogers, AR 72758

The Owner requests an itemized proposal for changes to the Contract Sum and Contract Time for proposed modifications to the Contract Documents described herein. The Contractor shall submit this proposal within five (5) days or notify the Architect in writing of the anticipated date of submission.

(Insert a detailed description of the proposed modifications to the Contract Documents and, if applicable, attach or reference specific exhibits.)

Refer to the attached Proposal Request 042 Narrative listing revised drawings with brief description of changes.

THIS IS NOT A CHANGE ORDER, A CONSTRUCTION CHANGE DIRECTIVE, OR A DIRECTION TO PROCEED WITH THE WORK DESCRIBED IN THE PROPOSED MODIFICATIONS.

REQUESTED BY THE ARCHITECT:

Mark Herrmann, AIA

PRINTED NAME AND TITLE

PROPOSAL REQUEST 042

(+ RFI 298)

ISSUED: March 21, 2024

PROJECT: AWSOM
BENTONVILLE, AR

FROM ARCHITECT: POLK STANLEY WILCOX ARCHITECTS
801 SOUTH SPRING ST.
LITTLE ROCK AR 72201

TO CONTRACTOR: CROSSLAND CONSTRUCTION COMPANY, INC

PROPOSAL REQUEST 042 BRIEF

Revised drawings in PR 042 update second floor BBH 44-46 and VAV 4-07 per coordination and responses from RFI #298.

REVISED DRAWING SHEETS

1) **Mechanical:**

- a) Refer to Revised Sheet **M102A**, with original issue date 02.24.2023 and revised date 03.21.2024.
 - Revised air distribution from VAV 4-07.
 - Added note M205 to Mechanical Plan Notes.
 - Removed BBH 44-46.
- b) Refer to Revised Sheet **M202A**, with original issue date 02.24.2023 and revised date 03.21.2024.
 - Removed BBH 44-46 and associated piping.
- c) Refer to Revised Sheet **M600**, with original issue date 02.24.2023 and revised date 03.21.2024.
 - Added UP to Grilles, Registers, and Diffusers Schedule.
- d) Refer to Revised Sheet **M602**, with original issue date 02.24.2023 and revised date 03.21.2024.
 - Revised VAV 4-07.
- e) Refer to Revised Sheet **M603**, with original issue date 02.24.2023 and revised date 03.21.2024.
 - Removed BBH 44-46 from Baseboard Heater Schedule

End of PR 042

MECHANICAL PLAN NOTES:

- M10 ROUTE EXHAUST AIR DUCT DOWN TO EXHAUST HOOD CONNECTION. BALANCE TO 750 CFM FOLLOW ALL MANUFACTURER RECOMMENDATIONS AND REQUIREMENTS. SLOPE ALL HOOD EXHAUST DUCT AT 1/4" PER FOOT.
- M11 ROUTE EXHAUST AIR DUCT DOWN TO EXHAUST HOOD CONNECTION. BALANCE TO 2900 CFM. PROVIDE CONNECTION TO HOOD. REFER TO KITCHEN PLANS FOR EQUIPMENT CONNECTION SIZE AND MORE DETAILS. SLOPE ALL HOOD EXHAUST DUCT AT 1/4" PER FOOT BACK TOWARDS HOOD. FOLLOW ALL MANUFACTURER RECOMMENDATIONS AND REQUIREMENTS.
- M12 ROUTE EXHAUST AIR DUCT DOWN TO EXHAUST HOOD CONNECTION. BALANCE TO 945 CFM. PROVIDE CONNECTION TO HOOD. REFER TO KITCHEN PLANS FOR EQUIPMENT CONNECTION SIZE AND MORE DETAILS. SLOPE ALL HOOD EXHAUST DUCT AT 1/4" PER FOOT BACK TOWARDS HOOD. FOLLOW ALL MANUFACTURER RECOMMENDATIONS AND REQUIREMENTS.
- M13 LOCATE CONTROL POWER TRANSFORMERS IN THIS ROOM TO POWER LOCAL VAV BOXES. EACH CONTROL POWER TRANSFORMER SHALL SERVE UP TO FIVE VAV BOXES. DISTANCE BETWEEN TRANSFORMER AND VAV BOX SHALL NOT EXCEED 200 FEET.
- M15 PROVIDE DEFLECTOR PLATE AS SHOWN. DO NOT BLOW AIR INTO THE DIRECTION OF THE KITCHEN HOOD.

MECHANICAL PLAN NOTES:

- M22 MOUNT BOTTOM OF FAN COIL UNIT 9" AFF.
- M42 RETURN AIR THRU COVE ASSEMBLY. REFER TO ARCHITECTURAL PLANS FOR COVE LOCATION AND OPENING SIZE FOR RETURN AIR. OPENINGS SHALL BE MINIMUM 2" TALL AND FULL LENGTH OF COVE.
- M44 LINEAR SLOT DIFFUSER SUSPENDED FROM STRUCTURE. MOUNT LINEAR SLOT JUST PART EDGE OF CEILING.
- M49 LOUVERS BY ARCHITECT. REFER TO FREE AREA SCHEDULE ON M303 FOR MECHANICAL SYSTEM REQUIREMENTS. REFER TO ARCHITECTURAL PLANS FOR LOUVER DETAILS AND SPECIFICATIONS.
- M57 COORDINATE WITH ARCHITECTURAL DRAWINGS TO LEAVE WALL DOWN ABOVE CEILING FOR RETURN PATHWAY.
- M61 UP TO FLOOR GRILLE PLENUM.
- M62 MOUNT BOTTOM OF GRILLE 12" TO AFF.
- M63 MOUNT BOTTOM OF DRUM DIFFUSER 15" ABOVE FINISHED SECOND FLOOR.
- M73 LOUVER ASSEMBLY IS SLANTED TO ALIGN WITH PRECAST PANELS. ATTACHED PLENUM SHALL NOT BE SLANTED. COORDINATE WITH ARCHITECT ON FINAL REQUIRED BLANK OFF PANEL LOCATIONS FOR LOUVER SECTIONS NOT CONNECTED TO PLENUM.
- M86 PROVIDE GRILLE WITH FIRE DAMPER AT THE GRILLE FACE.

MECHANICAL PLAN NOTES:

- M91 MOUNT BOTTOM OF RETURN GRILLE 13" AFF.
- M92 ARCHITECT TO PROVIDE EXHAUST LOUVER. COORDINATE WITH ARCHITECTURAL DRAWINGS FOR SIZE AND EXACT LOCATION.
- M104 DUCTWORK SHALL BE ROUTED ABOVE CEILING ALONG EDGE OUTLINED ON DRAWING.
- M105 MOUNT THERMOSTAT ON COLUMN 4" ABOVE NEAREST STAIR TREAD ELEVATION.
- M106 ALL BASEBOARD HEATERS SHALL BE CONTINUOUS IF SERVED BY SAME PIPING. NO EXPOSED PIPING ALLOWED BETWEEN BASEBOARD HEATERS. PROVIDE 5/8" W/ BSH SECTION, IF REQUIRED (TYPICAL).
- M110 SEAL PENETRATION THROUGH ACOUSTICAL CEILING WITH ACOUSTICAL SEALANT. REFER TO SPECIFICATIONS FOR ADDITIONAL INFORMATION.
- M110 BSH 33, 34, 58 AND 59 SHALL BE CONTROLLED BY VAV 2-01 THERMOSTAT.
- M111 BSH 37 - 43 SHALL BE CONTROLLED BY VAV 4-06 THERMOSTAT.
- M112 BSH 44-48 SHALL BE CONTROLLED BY VAV 4-07 THERMOSTAT.
- M113 BSH 35 SHALL BE CONTROLLED BY VAV 4-05 THERMOSTAT.
- M114 BSH 47-48 SHALL BE CONTROLLED BY VAV 4-10 THERMOSTAT.
- M205 SUSPEND SUPPLY PLENUM ABOVE PANEL SYSTEM IN GAP SO THAT AIR DISCHARGES BETWEEN PANELS.

POLK STANLEY WILCOX
 801 South Spring Street
 Little Rock, AR 72201
 509 W. Spring St. Suite 100
 Fayetteville, AR 72701
 479.444.0100
 polkstanleywilcox.com

McCalland Consulting Engineers, Inc.
 1586 E STEARNS ST
 FAYETTEVILLE, AR 72703
 P. 479.443.2377

LANDSCAPE
 OSD
 115 ST. JOHNS PLACE
 BROOKLYN, NY 11217
 P. 917.553.5886

STRUCTURAL
McCalland Consulting Engineers
 806 SOUTH MAIN BLVD., STE. 217
 BENTONVILLE, AR 72712
 P. 479.493.9046

MEP - LOW VOLTAGE
Henderson Engineers
 830 LENEVA DRIVE, STE. 300
 LENOIRA, VA 26024
 P. 813.660.8187

SUSTAINABILITY
SOM
 224 SOUTH MICHIGAN AVENUE
 CHICAGO, IL 60604
 P. 312.360.4121

SIGNAGE + WAYFINDING
TWO TWELVE
 238 W. 21ST ST., SUITE 802
 NEW YORK, NY 10001
 P. 212.254.9870

FOOD SERVICE
JMC HOSPITALITY
 9665 SIX PINES DR., SUITE B210
 THE WOODLANDS, TX 77380
 P. 689.641.2222

WATER FEATURES
OTL
 2150 S. TOWNE CENTER, SUITE 100
 ANAHEIM, CA 92809
 P. 714.637.4141

IRRIGATION
WC3 DESIGN
 11A HOBBSMAN MANOR BLVD.
 MOORESCOPE, PA 14135
 P. 844.231.7042

PSW Job Number:
993A
 Henderson Job Number:
2150002607



03/21/2024

AWSOM
 Bentonville, AR


Issue Date:
02.24.2023

NUMBER	DATE	DESCRIPTION
1	01/20/23	As-Built
2	06/03/23	As-Built #2
3	02/23/24	PROJ. 2
4	03/21/24	PROJ. 2

Contents:
 HVAC - LEVEL 2
 PLAN - AREA A


THIS PAGE IS BEST VIEWED IN COLOR

M102A

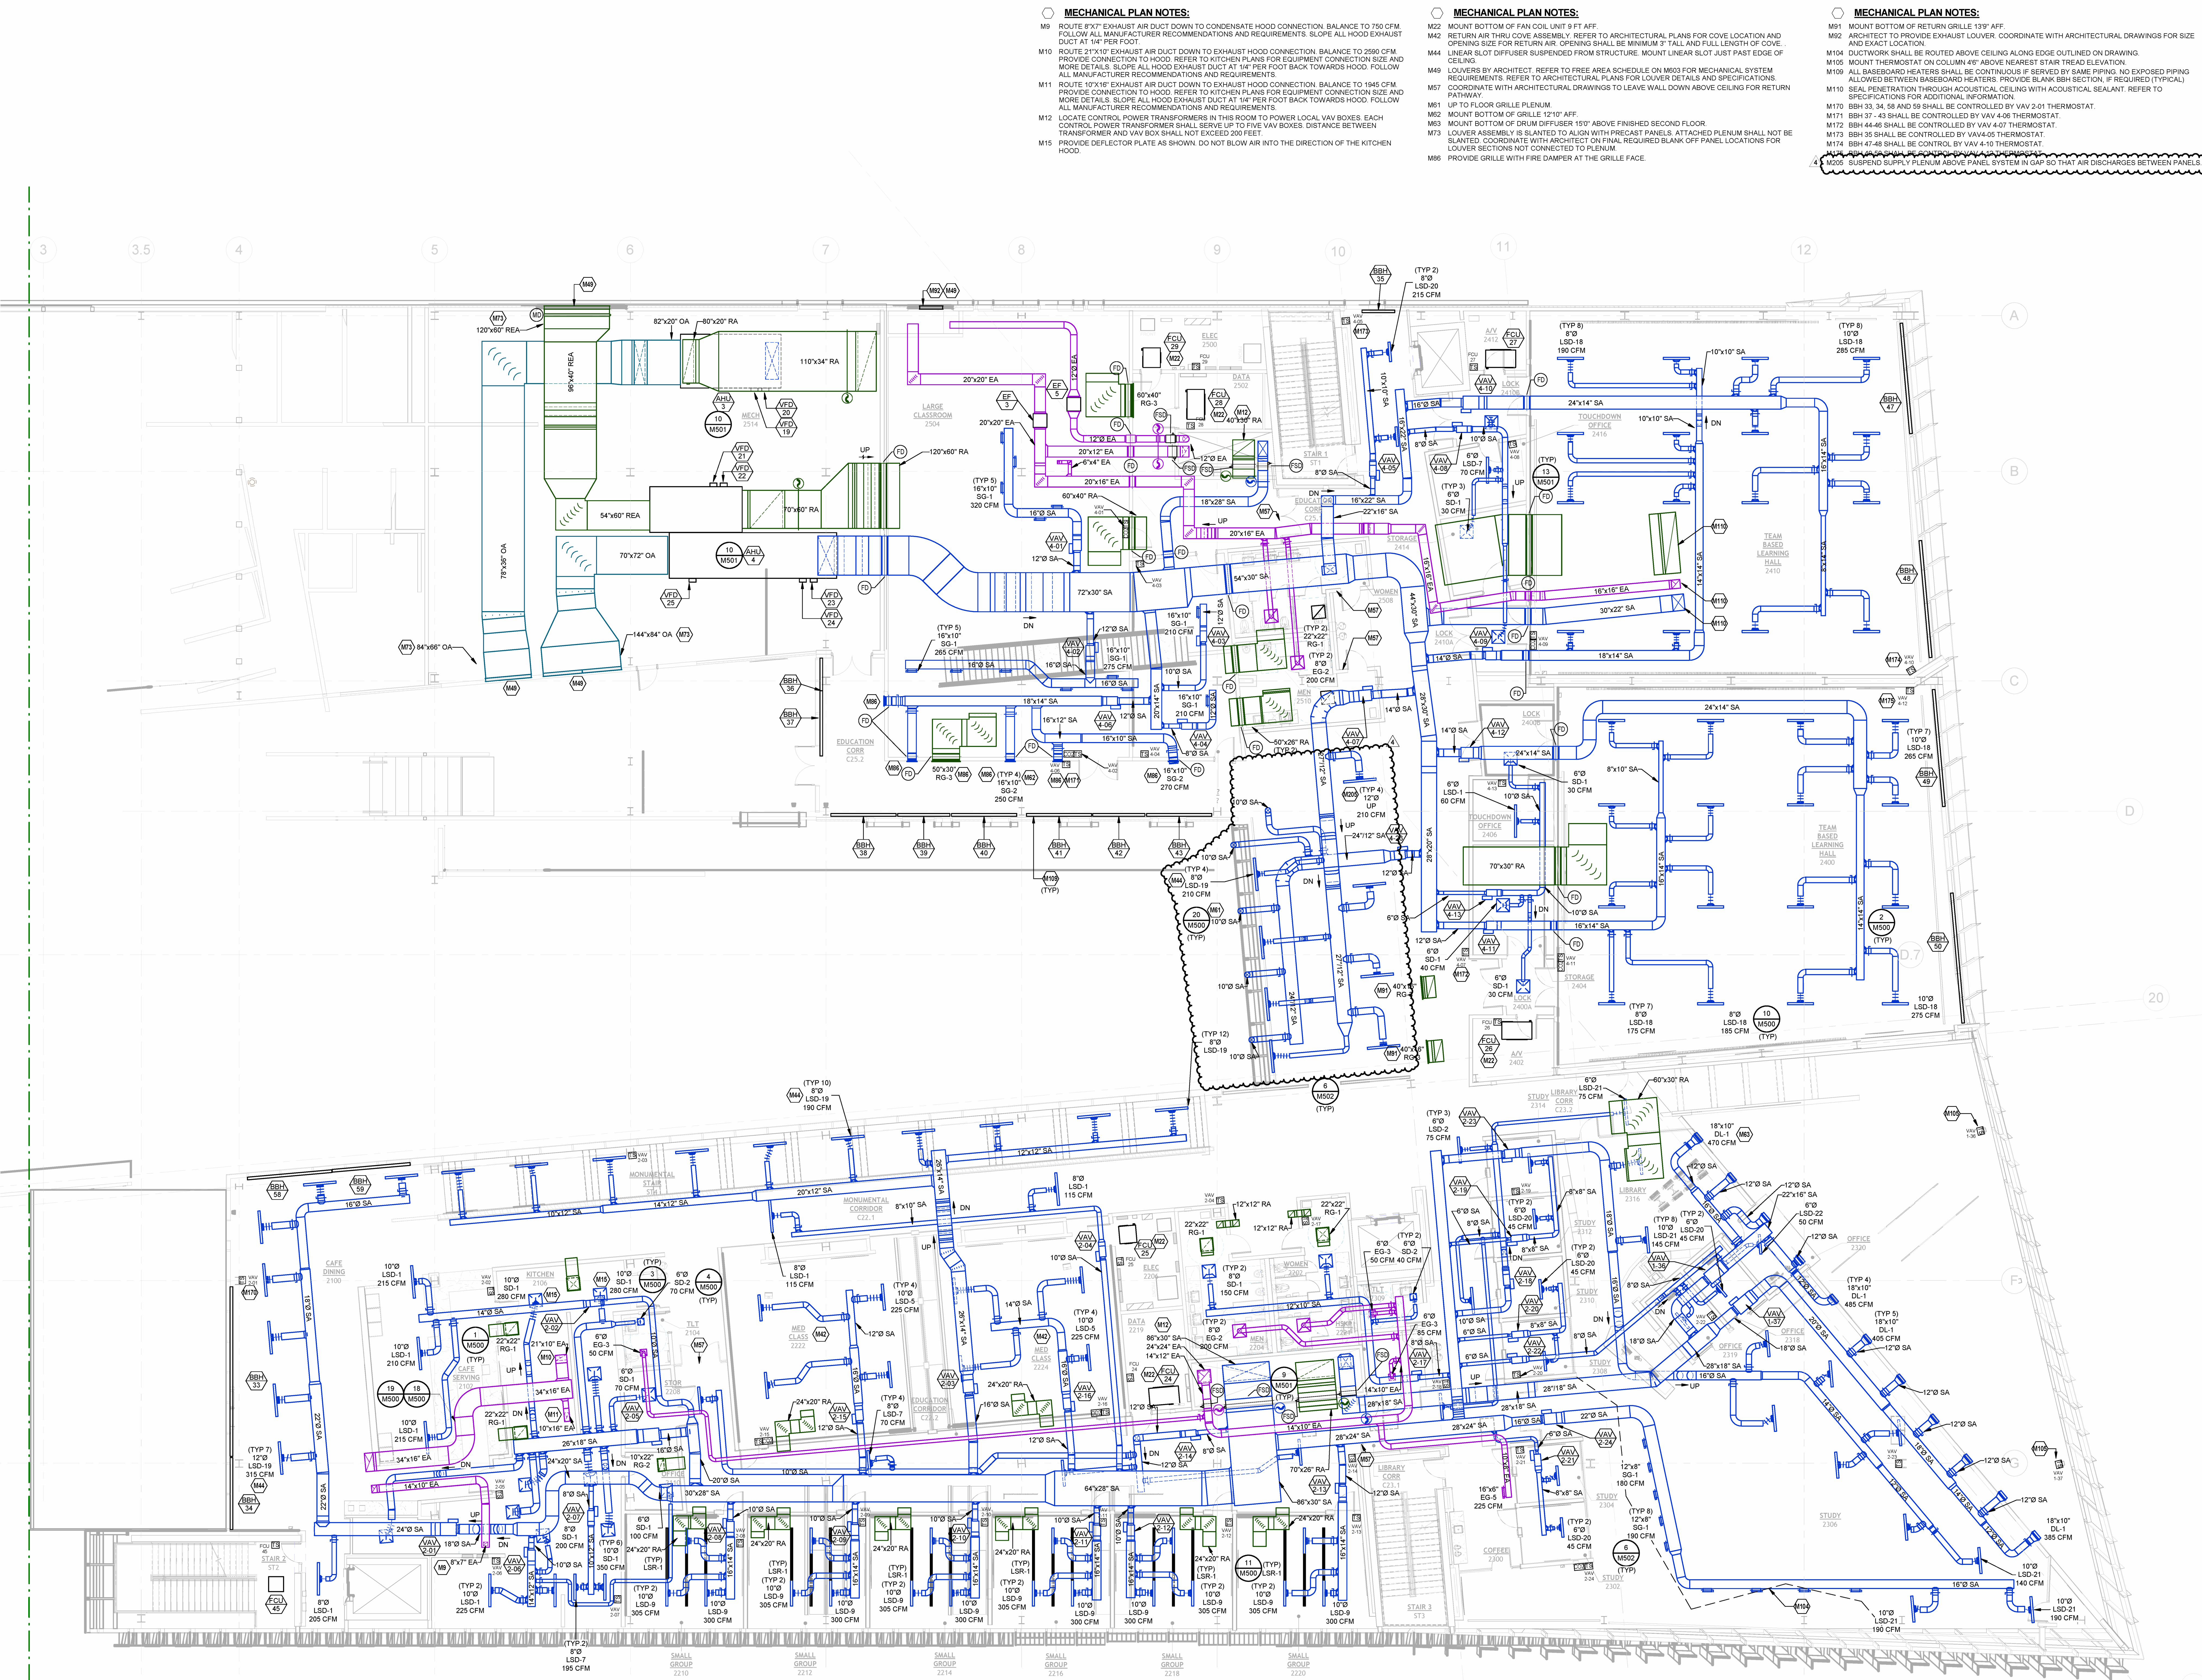

① HVAC - LEVEL 2 PLAN - AREA A
 1/8" = 1'-0"

KEY PLAN

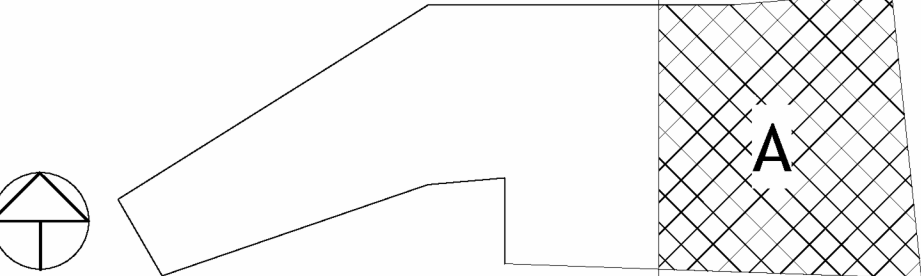



REVISIONS		
NUMBER	DATE	DESCRIPTION
1	03/20/23	As-Built
2	06/02/23	As-Built 2
3	03/24/24	Proposed


MECHANICAL PLAN NOTES:

- M6 PROVIDE 3/4" CHWCHR TAP FOR CONNECTION TO FREEZER CONDENSER BALANCE TO 3.65 GPM. PROVIDE CONNECTION TO EQUIPMENT. REFER TO KITCHEN PLANS FOR EQUIPMENT CONNECTION SIZE AND MORE DETAILS.
- M7 PROVIDE 3/4" CHWCHR TAP FOR CONNECTION TO COOLER CONDENSER BALANCE TO 1.80 GPM. PROVIDE CONNECTION TO EQUIPMENT. REFER TO KITCHEN PLANS FOR EQUIPMENT CONNECTION SIZE AND MORE DETAILS.
- M8 PROVIDE 3/4" CHWCHR TAP FOR CONNECTION TO ICE MACHINE BALANCE TO 2.90 GPM. PROVIDE CONNECTION TO EQUIPMENT. REFER TO KITCHEN PLANS FOR EQUIPMENT CONNECTION SIZE AND MORE DETAILS.
- M18 EXTEND PIPING THROUGH BELOW TO HYDRONIC BASEBOARD HEATER.
- M22 MOUNT BOTTOM OF FAN COIL UNIT 9 FT AFF.
- M24 ROUTE PIPING IN CEILING AND THEN PENETRATE HEATER FROM FLOOR BELOW. ALL PIPING SHALL BE INSTALLED INSIDE OF THE BUILDING AS B/M202 SHOWS IN SECTION VIEW OF THE SLOPED EXTERIOR WALL. TYPICAL ALL BBHS AND THIS THAT ARE SERVED FROM BELOW.
- M29 PIPING UP TO FLOOR ABOVE TO BASEBOARD HEATERS.
- M30 ROUTE HEATING HOT WATER TIGHT TO STRUCTURE.

MECHANICAL PLAN NOTES:


- M77 ROUTE PIPING UP TO BASEBOARD HEATER CONNECTION ON FLOOR ABOVE REFER TO M202A FOR PIPING CONTINUATION.
- M78 ROUTE PIPING UP THROUGH FLOOR TO PLENUM ABOVE. REFER TO M202A FOR PIPING CONTINUATION.
- M109 ALL BASEBOARD HEATERS SHALL BE CONTINUOUS IF SERVED BY SAME PIPING. NO EXPOSED PIPING ALLOWED BETWEEN BASEBOARD HEATERS. PROVIDE BLANK BBH SECTION, IF REQUIRED (TYPICAL).
- M110 SEAL PENETRATION THROUGH ACoustICAL CEILING WITH ACoustICAL SEALANT. REFER TO SPECIFICATIONS FOR ADDITIONAL INFORMATION.
- M126 EXTEND PIPING THROUGH BBH-36 AND BBH-37. CV=0.22
- M127 EXTEND PIPING THROUGH BBH-38, BBH-39, BBH-40, BBH-41, BBH-42, AND BBH-43. CV=0.89
- M129 EXTEND PIPING THROUGH BBH-47 AND BBH-48. CV=1.16
- M130 EXTEND PIPING THROUGH BBH-49 AND BBH-50. CV=0.62
- M131 EXTEND PIPING THROUGH BBH-58 AND BBH-59. CV=0.80
- M132 EXTEND PIPING THROUGH BBH-53 AND BBH-54. CV=0.76
- M164 ROUTE 2" HWS, 2" HWR, 1-1/2" CHS, AND 1-1/2" CHR UP TO LEVEL 3. REFER TO M203A FOR CONTINUATION.
- M165 ROUTE 8" CHS, 8" CHR, 4" HWS, AND 4" HWR UP TO LEVEL 3. REFER TO M203A FOR CONTINUATION.

MECHANICAL GENERAL NOTE:
 ALL BASEBOARD HEATERS SHALL BE CONTINUOUS IF SERVED BY SAME PIPING. NO EXPOSED PIPING ALLOWED BETWEEN BASEBOARD HEATERS. PROVIDE BLANK BBH SECTION, IF REQUIRED (TYPICAL).

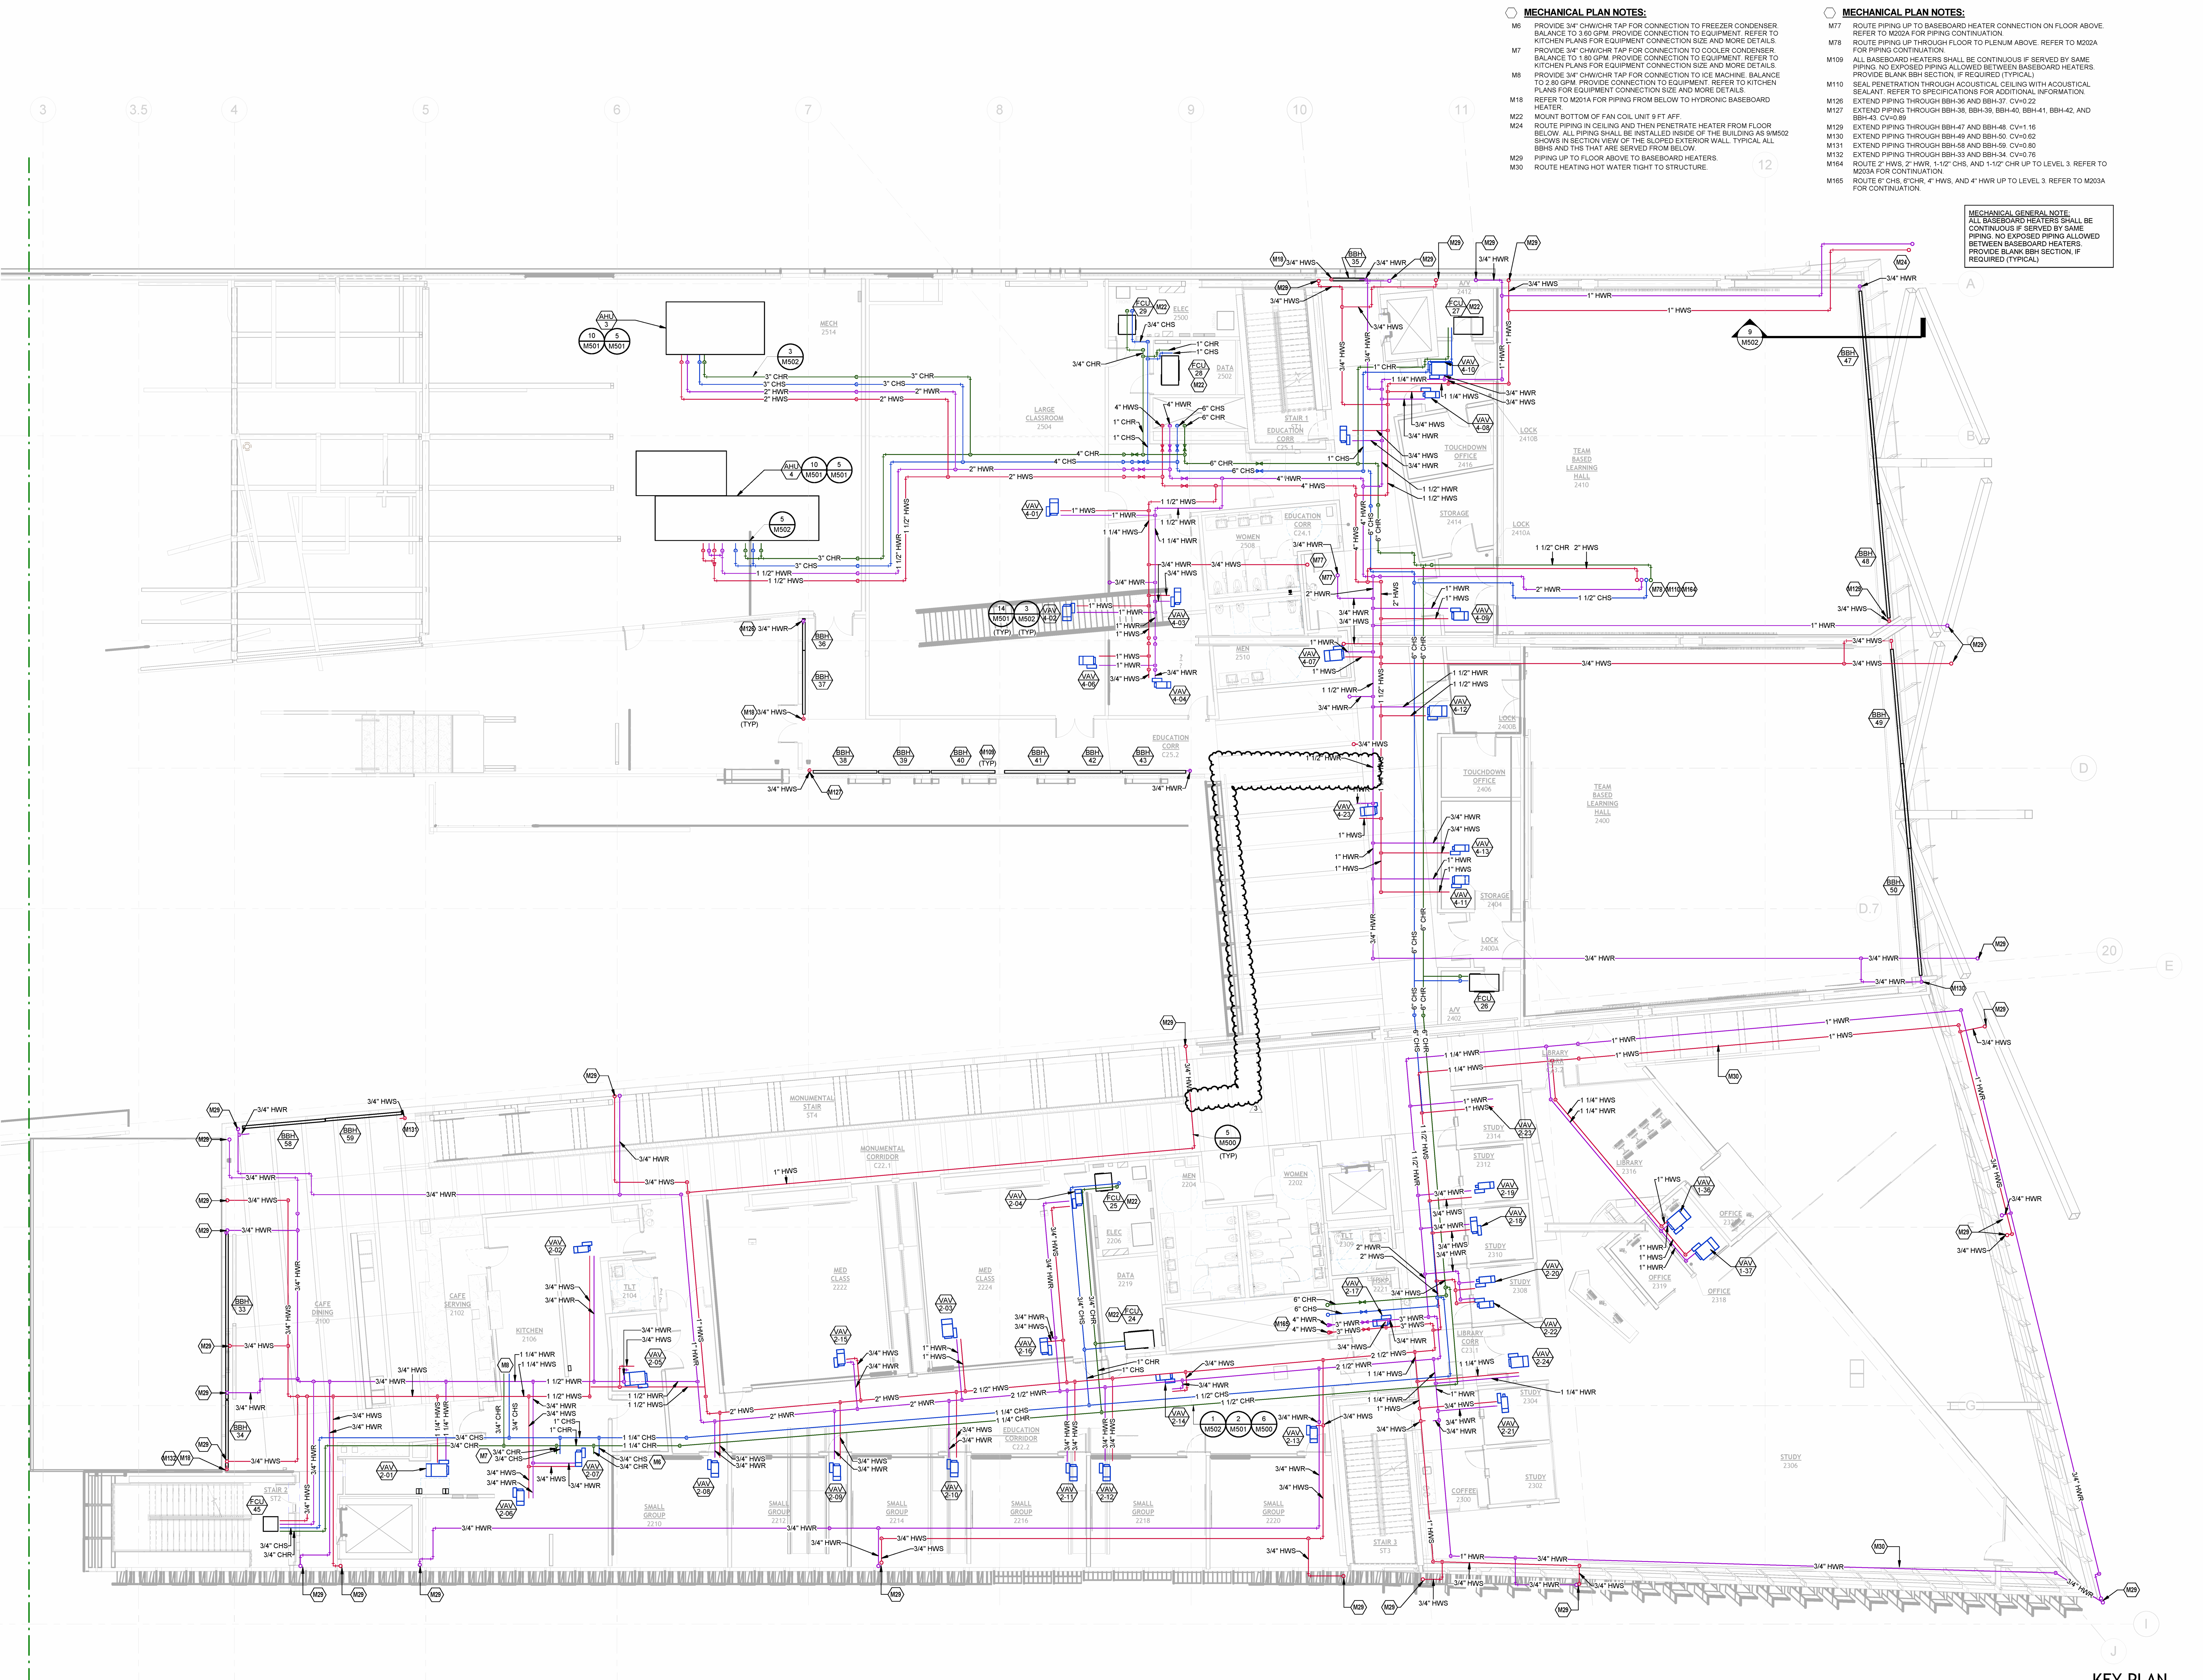

PIPING - LEVEL 2 PLAN - AREA A
 1/8" = 1'-0"

KEY PLAN

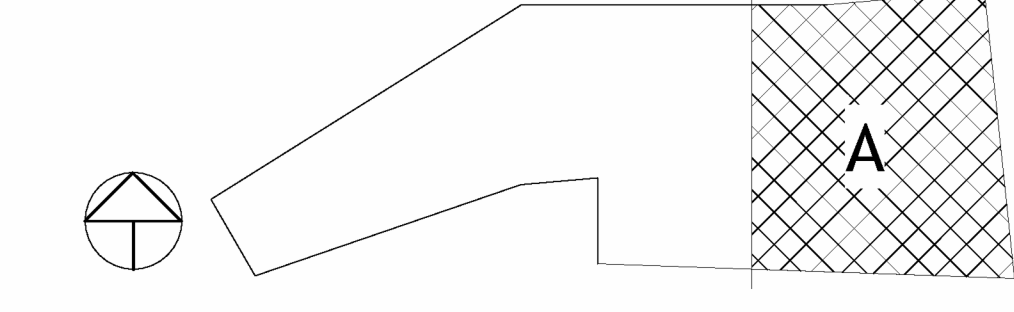



03/21/2024

AWSOM Bentonville, AR Issue Date: 02.24.2023

REVISIONS table with columns: REVISION, DATE, DESCRIPTION

Contents: MECHANICAL SCHEDULES

AIR HANDLING UNIT SCHEDULE (CHILLED WATER COOLING, HOT WATER HEATING)

Main AHU schedule table with columns: MARK, MANUFACTURER, MODEL, UNIT TYPE, ESP (IN), TSP (IN), BHP PER FAN, NOM. HP PER FAN, EXHAUST THROUGH WHEEL, SUMMER CONDITIONS, WINTER CONDITIONS, HEATING COIL, COOLING COIL, HEATING COIL, FILTERS, CONNECTIONS

MODEL NUMBERS SHALL NOT BE CONSIDERED COMPLETE AND MATERIAL SHALL NOT BE ORDERED BY MANUFACTURER AND MODEL NUMBERS ONLY. REVIEW THE COMPLETE DESCRIPTION, NOTES AND SPECIFICATIONS TO DETERMINE THE EXACT MATERIAL AND ACCESSORIES TO BE ORDERED.

- NOTES: A. PROVIDE FACTORY MOUNTED DISCONNECT SWITCH INSTALLED ON SERVICE SIDE OF UNIT. B. PROVIDE WITH 10KVA GCCR RATING. C. PROVIDE WITH MINIMUM 4 FANS PER FAN ARRAY...

OCTAVE BAND SOUND POWER LEVELS (dB)

Octave band sound power levels table with columns: SUPPLY AIR (IN), RETURN AIR (IN), RADIATED

MAXIMUM ALLOWABLE EQUIPMENT DIMENSIONS

Maximum allowable equipment dimensions table with columns: MARK, LENGTH (INCHES), WIDTH (INCHES), HEIGHT (INCHES), NOTES

- NOTES: A. SHIPPING SPLIT SHALL NOT EXCEED 6". B. HEIGHT INCLUDES 6" BASEBALL.

FAN COIL UNIT SCHEDULE (HYDRONIC COILS)

Main Fan Coil Unit schedule table with columns: MARK, MANUFACTURER, MODEL, TYPE, SUPPLY FAN, COOLING COIL, HEATING COIL, ELECTRICAL, STARTER TYPE, WEIGHT (LBS), NOTES

MODEL NUMBERS SHALL NOT BE CONSIDERED COMPLETE AND MATERIAL SHALL NOT BE ORDERED BY MANUFACTURER AND MODEL NUMBERS ONLY. REVIEW THE COMPLETE DESCRIPTION, NOTES AND SPECIFICATIONS TO DETERMINE THE EXACT MATERIAL AND ACCESSORIES TO BE ORDERED.

- NOTES: A. PROVIDE PRE-MANUFACTURED OR FIELD FABRICATED FILTER RACK ON UNIT RETURN AIR INLET WITH 2" MERV 8, PLEATED THROWAWAY FILTERS. B. PROVIDE WITH BACNET CAPABILITY. FCU WILL BE TIED INTO THE BUILDINGS BAS...

GRILLE, REGISTER AND DIFFUSER SCHEDULE

Main Grille, Register and Diffuser schedule table with columns: MARK, MANUFACTURER, MODEL, CONSTRUCTION TYPE, FACE TYPE, MOUNTING LOCATION, FACE SIZE (IN), MAX NO. DRUM (IN W'S), MAX PRESS. (IN W.S.), NOTES

MODEL NUMBERS SHALL NOT BE CONSIDERED COMPLETE AND MATERIAL SHALL NOT BE ORDERED BY MANUFACTURER AND MODEL NUMBERS ONLY. REVIEW THE COMPLETE DESCRIPTION, NOTES AND SPECIFICATIONS TO DETERMINE THE EXACT MATERIAL AND ACCESSORIES TO BE ORDERED.


- NOTES: A. 4-WAY THROW PATTERN UNLESS OTHERWISE INDICATED BY FLOW ARROWS ON DRAWINGS. B. NECK SIZE SHOWN ON DRAWINGS. PROVIDE BRANCH DUCT TO MATCH NECK SIZE UNLESS OTHERWISE SHOWN ON DRAWINGS.

ROOF HOOD SCHEDULE

Roof Hood schedule table with columns: MARK, SERVICE (INTAKE/EXHAUST), MANUFACTURER, MODEL, CFM, MAX THROAT VEL (FPM), MAX APD (IN), THROAT (L" X W"), CURB (L" X W"), WEIGHT (LBS), NOTES

MODEL NUMBERS SHALL NOT BE CONSIDERED COMPLETE AND MATERIAL SHALL NOT BE ORDERED BY MANUFACTURER AND MODEL NUMBERS ONLY. REVIEW THE COMPLETE DESCRIPTION, NOTES AND SPECIFICATIONS TO DETERMINE THE EXACT MATERIAL AND ACCESSORIES TO BE ORDERED.

- NOTES: A. PROVIDE WITH INTEGRAL BIRDSCREEN 1/4" ALUMINUM BIRDSCREEN. B. PROVIDE INSULATED ROOF CURB WITH MINIMUM HEIGHT REQUIRED TO MAINTAIN BOTTOM OF EQUIPMENT A MINIMUM OF 8" INCHES ABOVE FINISHED ROOF SURFACE...

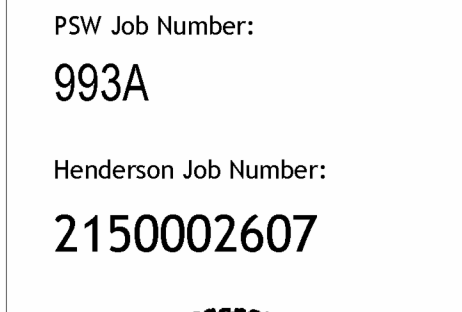

REVISIONS table with columns: NUMBER, DATE, DESCRIPTION.

Contents: MECHANICAL SCHEDULES

VARIABLE AIR VOLUME TERMINAL SCHEDULE (HYDRONIC HEAT) AHU 5

Table for AHU 5 with columns: MARK, SERVED FROM, MANUFACTURER, MODEL, INLET SIZE (IN), PRIMARY CFM, MIN PRIM CFM, MIN HEAT CFM, MAX HEAT CFM, HEATING COIL (HTO, HGT, EAT, LAT, MBH, GPM, ROW, WPD (FT)), CV, VPH, SOUND POWER (RADIATED, DISCHARGE), CONTROL TYPE, NOTES.

MODEL NUMBERS SHALL NOT BE CONSIDERED COMPLETE AND MATERIAL SHALL NOT BE ORDERED BY MANUFACTURER AND MODEL NUMBERS ONLY. REVIEW THE COMPLETE DESCRIPTION, NOTES AND SPECIFICATIONS TO DETERMINE THE EXACT MATERIAL AND ACCESSORIES TO BE ORDERED. THE MANUFACTURERS LISTED ARE THE BASIS FOR THE DESIGN.

- Notes A: HEATING COIL CAPACITY BASED ON SCHEDULED ENTERING WATER TEMPERATURE. GPM IS BASED ON A DESIRED COIL DELTA T OF 20 F. ADJUST GPM TO REFLECT ACTUAL COIL SELECTION AND PERFORMANCE. B: INSTALL FLEXIBLE DUCT CONNECTOR AT INLET CONNECTION. C: PROVIDE INTERNAL DISCONNECT SWITCH. D: REMOVE CONTROL POWER (C/P) TRANSFORMER BY DIVISION 23. REFER TO ELECTRICAL DRAWINGS FOR TRANSFORMER LOCATIONS. COORDINATE PRIMARY W/ ELECTRICAL DRAWINGS. E: BOX NOT TO EXCEED SCHEDULED DISCHARGE OR RADIATED SOUND NC LEVEL USING 5 INCH PRESSURE DROP. PROVIDE FACTORY INSTALLED, PRESSURE INDEPENDENT, DOC CONTROL PACKAGE. G: PROVIDE VAV BOXES WITH HIGH CAPACITY OPTION FOR 2 ROW COILS. IF STANDARD 2 ROW COILS DO NOT MEET CAPACITY, IF CAPACITY IS NOT MET ON A VAV BOX WITH 2 ROW HIGH CAPACITY COILS, INCREASE NUMBER OF ROWS OF COILS. H: PROVIDE BOX WITH EITHER RIGHT HAND OR LEFT HAND CONFIGURATION AS SHOWN ON DRAWINGS. J: BOX SELECTED AT 130 FEET ABOVE LEVEL. K: INLET SIZE SHOWS IS THE MINIMUM ALLOWABLE INLET SIZE. NO SMALLER SIZES SHALL BE ACCEPTED. L: VAV BOXES SHALL BE SIZED TO MEET THE SCHEDULED VALUES BASED ON THE FOLLOWING PRIORITIES: 1 - HEATING COIL CAPACITY, 2 - LEAVING AIR TEMPERATURE, 3 - WATER PRESSURE DROP. M: INTERLOCK SYSTEM FOR WATER WITH 50% PRESSURE CONTROL SOLUTION. N: CONSTANT VOLUME VAV BOX. O: INTERLOCK VAV CONTROLLER WITH KITCHEN EXHAUST HOOD. REFER TO MECHANICAL CONTROLS. Q: COOLING ONLY VAV.

VARIABLE AIR VOLUME TERMINAL SCHEDULE (HYDRONIC HEAT) AHU 1

Table for AHU 1 with columns: MARK, SERVED FROM, MANUFACTURER, MODEL, INLET SIZE (IN), PRIMARY CFM, MIN PRIM CFM, MIN HEAT CFM, MAX HEAT CFM, HEATING COIL (HTO, HGT, EAT, LAT, MBH, GPM, ROW, WPD (FT)), CV, VPH, SOUND POWER (RADIATED, DISCHARGE), CONTROL TYPE, NOTES.

VARIABLE AIR VOLUME TERMINAL SCHEDULE (HYDRONIC HEAT) AHU 2

Table for AHU 2 with columns: MARK, SERVED FROM, MANUFACTURER, MODEL, INLET SIZE (IN), PRIMARY CFM, MIN PRIM CFM, MIN HEAT CFM, MAX HEAT CFM, HEATING COIL (HTO, HGT, EAT, LAT, MBH, GPM, ROW, WPD (FT)), CV, VPH, SOUND POWER (RADIATED, DISCHARGE), CONTROL TYPE, NOTES.

VARIABLE AIR VOLUME TERMINAL SCHEDULE (HYDRONIC HEAT) AHU 3

Table for AHU 3 with columns: MARK, SERVED FROM, MANUFACTURER, MODEL, INLET SIZE (IN), PRIMARY CFM, MIN PRIM CFM, MIN HEAT CFM, MAX HEAT CFM, HEATING COIL (HTO, HGT, EAT, LAT, MBH, GPM, ROW, WPD (FT)), CV, VPH, SOUND POWER (RADIATED, DISCHARGE), CONTROL TYPE, NOTES.

VARIABLE AIR VOLUME TERMINAL SCHEDULE (HYDRONIC HEAT) AHU 4

Table for AHU 4 with columns: MARK, SERVED FROM, MANUFACTURER, MODEL, INLET SIZE (IN), PRIMARY CFM, MIN PRIM CFM, MIN HEAT CFM, MAX HEAT CFM, HEATING COIL (HTO, HGT, EAT, LAT, MBH, GPM, ROW, WPD (FT)), CV, VPH, SOUND POWER (RADIATED, DISCHARGE), CONTROL TYPE, NOTES.



REVISIONS table with columns: NUMBER, DATE, DESCRIPTION.

BASEBOARD HEATER SCHEDULE (HOT WATER)

Table with columns: MARK, MANUFACTURER, MODEL, LENGTH (IN), MIN OUTPUT (MBH), EWT (°F), LWT (°F), GPM, CV, EAT (°F), MOUNTING TYPE, NOTES. Rows range from BBH 1 to BBH 180.

MODEL NUMBERS SHALL NOT BE CONSIDERED COMPLETE AND MATERIAL SHALL NOT BE ORDERED BY MANUFACTURER AND MODEL NUMBERS ONLY. REVIEW THE COMPLETE DESCRIPTION, NOTES AND SPECIFICATIONS TO DETERMINE THE EXACT MATERIAL AND ACCESSORIES TO BE ORDERED. THE MANUFACTURERS LISTED ARE THE BASIS FOR THE DESIGN.

- NOTES: A. PROVIDE NECESSARY MOUNTING BRACKETS AND ACCESSORIES (UNIT SHALL BE APPROVED FOR ZERO CLEARANCE). B. TYPICAL CONTROL BY VAV THERMOSTAT. REFER TO DRAWINGS FOR UNIT WITH INDEPENDENT THERMOSTAT. CONTROLS CONTRACTOR SHALL PROVIDE INDEPENDENT THERMOSTAT. C. ENCLOSURE SHALL BE STEEL WITH FIN NICKEL BRAD FINISH. AIR GRILLES SHALL BE EXTRUDED ALUMINUM WITH CLEAR ANODIZED ALUMINUM FINISH. D. PROVIDE A HIGH-SPEED W/FRISKY FOR FLOOR-MOUNTED UNITS. E. BLANK-OFF SECTION. F. REFER TO PIPING DRAWINGS FOR CV VALUES IN SITUATIONS WHERE PIPING IS EXTENDED THROUGH MORE THAN ONE BASEBOARD HEATER.

VARIABLE FREQUENCY DRIVES (VFD'S)

Table with columns: MARK, SERVICE/EQUIPMENT, NUMBER OF MOTORS, HP OF EACH MOTOR ON THE DRIVE, MANUFACTURER, VOLT/PHASE, ENCLOSURE, MOUNTING LOCATION, NOTES. Rows range from VFD 1 to VFD 29.

MODEL NUMBERS SHALL NOT BE CONSIDERED COMPLETE AND MATERIAL SHALL NOT BE ORDERED BY MANUFACTURER AND MODEL NUMBERS ONLY. REVIEW THE COMPLETE DESCRIPTION, NOTES AND SPECIFICATIONS TO DETERMINE THE EXACT MATERIAL AND ACCESSORIES TO BE ORDERED. THE MANUFACTURERS LISTED ARE THE BASIS FOR THE DESIGN.

GENERAL NOTES APPLICABLE TO ALL ITEMS:
1. DRIVE AMPS SHALL BE RATED PER NATIONAL ELECTRICAL CODE TABLE 430.50

- SCHEDULE NOTES:
A. PROVIDE 'EARLY BREAK' AUXILIARY CONTACTS IN MOTOR DISCONNECT THAT DEACTIVATES THE VFD WHEN MOTOR DISCONNECT SWITCH IS OPEN.
B. PROVIDE OUTPUT REACTOR.
C. PROVIDE BACKUP M5TP INTEGRATION CARD.
D. INTERLOCK WITH SMOKE DETECTOR OR FREEZE/STAT TO SHUT DOWN FAN ON ALARM.
E. PROVIDE SURGE SUPPRESSION ON THE INPUT OF THE DRIVE.
F. PROVIDE ANTI-SINGLE PHASING PROTECTION.
G. EQUIPMENT SIZED FOR 100° AMBIENT TEMPERATURE.
H. PROVIDE WITH LOCKABLE COVER.

FREE AREA SCHEDULE

Table with columns: MARK, SERVICE, CFM, MIN FREE AREA (SF), FPM, MAX APD (IN W.C.), NOTES. Rows range from LVR 1 to LVR 9.

MODEL NUMBERS SHALL NOT BE CONSIDERED COMPLETE AND MATERIAL SHALL NOT BE ORDERED BY MANUFACTURER AND MODEL NUMBERS ONLY. REVIEW THE COMPLETE DESCRIPTION, NOTES AND SPECIFICATIONS TO DETERMINE THE EXACT MATERIAL AND ACCESSORIES TO BE ORDERED. THE MANUFACTURERS LISTED ARE THE BASIS FOR THE DESIGN.

- NOTES:
A. LOUVER MARK CORRESPONDS WITH ARCHITECTURAL PLAN TAG. IF MULTIPLE PLENUMS ARE CONNECTED TO SAME LOUVER, THEY ARE DENOTED BY A LETTER AFTER THE NUMBER.
B. REFER TO ARCHITECTURAL PLANS AND SPECIFICATIONS FOR LOUVER SIZE, FINISH AND MANUFACTURER.
C. SCHEDULED FREE AREA REPRESENTS REQUIRED ACTIVE SECTION OF LOUVER FOR CONNECTION TO BY MECHANICAL CONTRACTOR.
D. MECHANICAL CONTRACTOR SHALL CONNECT PLENUM SHOWN ON DRAWINGS TO LOUVER ASSEMBLY.

DUCT SILENCER SCHEDULE

Table with columns: MARK, SERVICE, MANUFACTURER, MODEL, LENGTH (IN), CFM, MAX APD (IN), DYNAMIC INSERTION LOSS (at 63, 125, 250, 500, 1000, 2000, 4000, 8000), NOTES. Rows range from DS 1 to DS 12.

MODEL NUMBERS SHALL NOT BE CONSIDERED COMPLETE AND MATERIAL SHALL NOT BE ORDERED BY MANUFACTURER AND MODEL NUMBERS ONLY. REVIEW THE COMPLETE DESCRIPTION, NOTES AND SPECIFICATIONS TO DETERMINE THE EXACT MATERIAL AND ACCESSORIES TO BE ORDERED. THE MANUFACTURERS LISTED ARE THE BASIS FOR THE DESIGN.

- NOTES:
A. STATIC PRESSURE DROP SHALL NOT EXCEED SCHEDULED AMOUNT AT SPECIFIED AIRFLOW.