




1 DOOR TYPES
A601 1/2" = 1'-0"

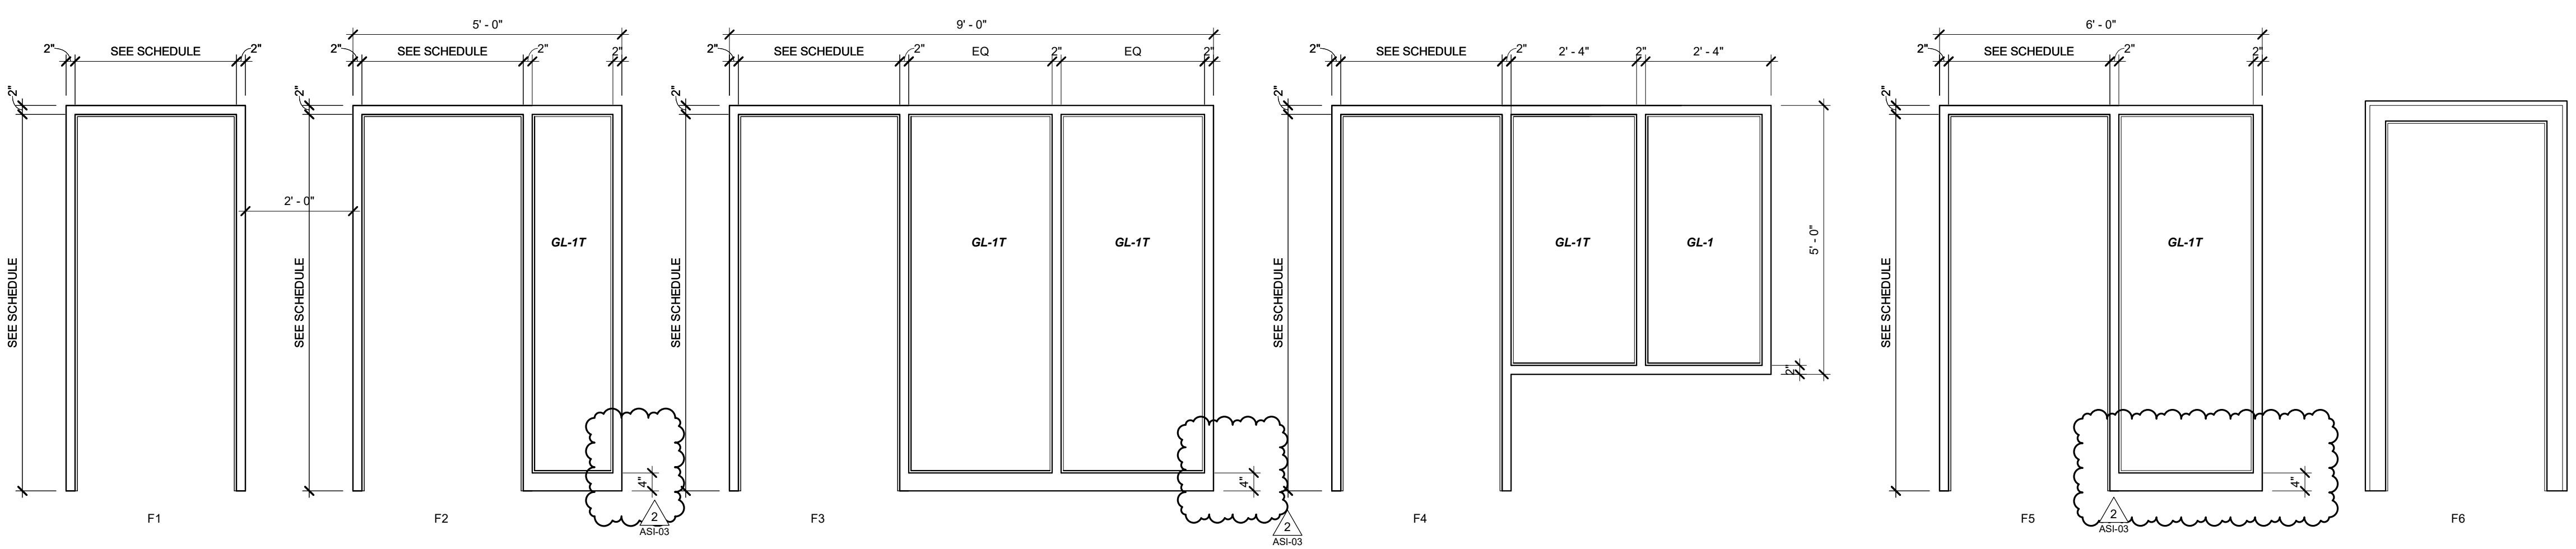


2 FRAME TYPES
A601 1/2" = 1'-0"

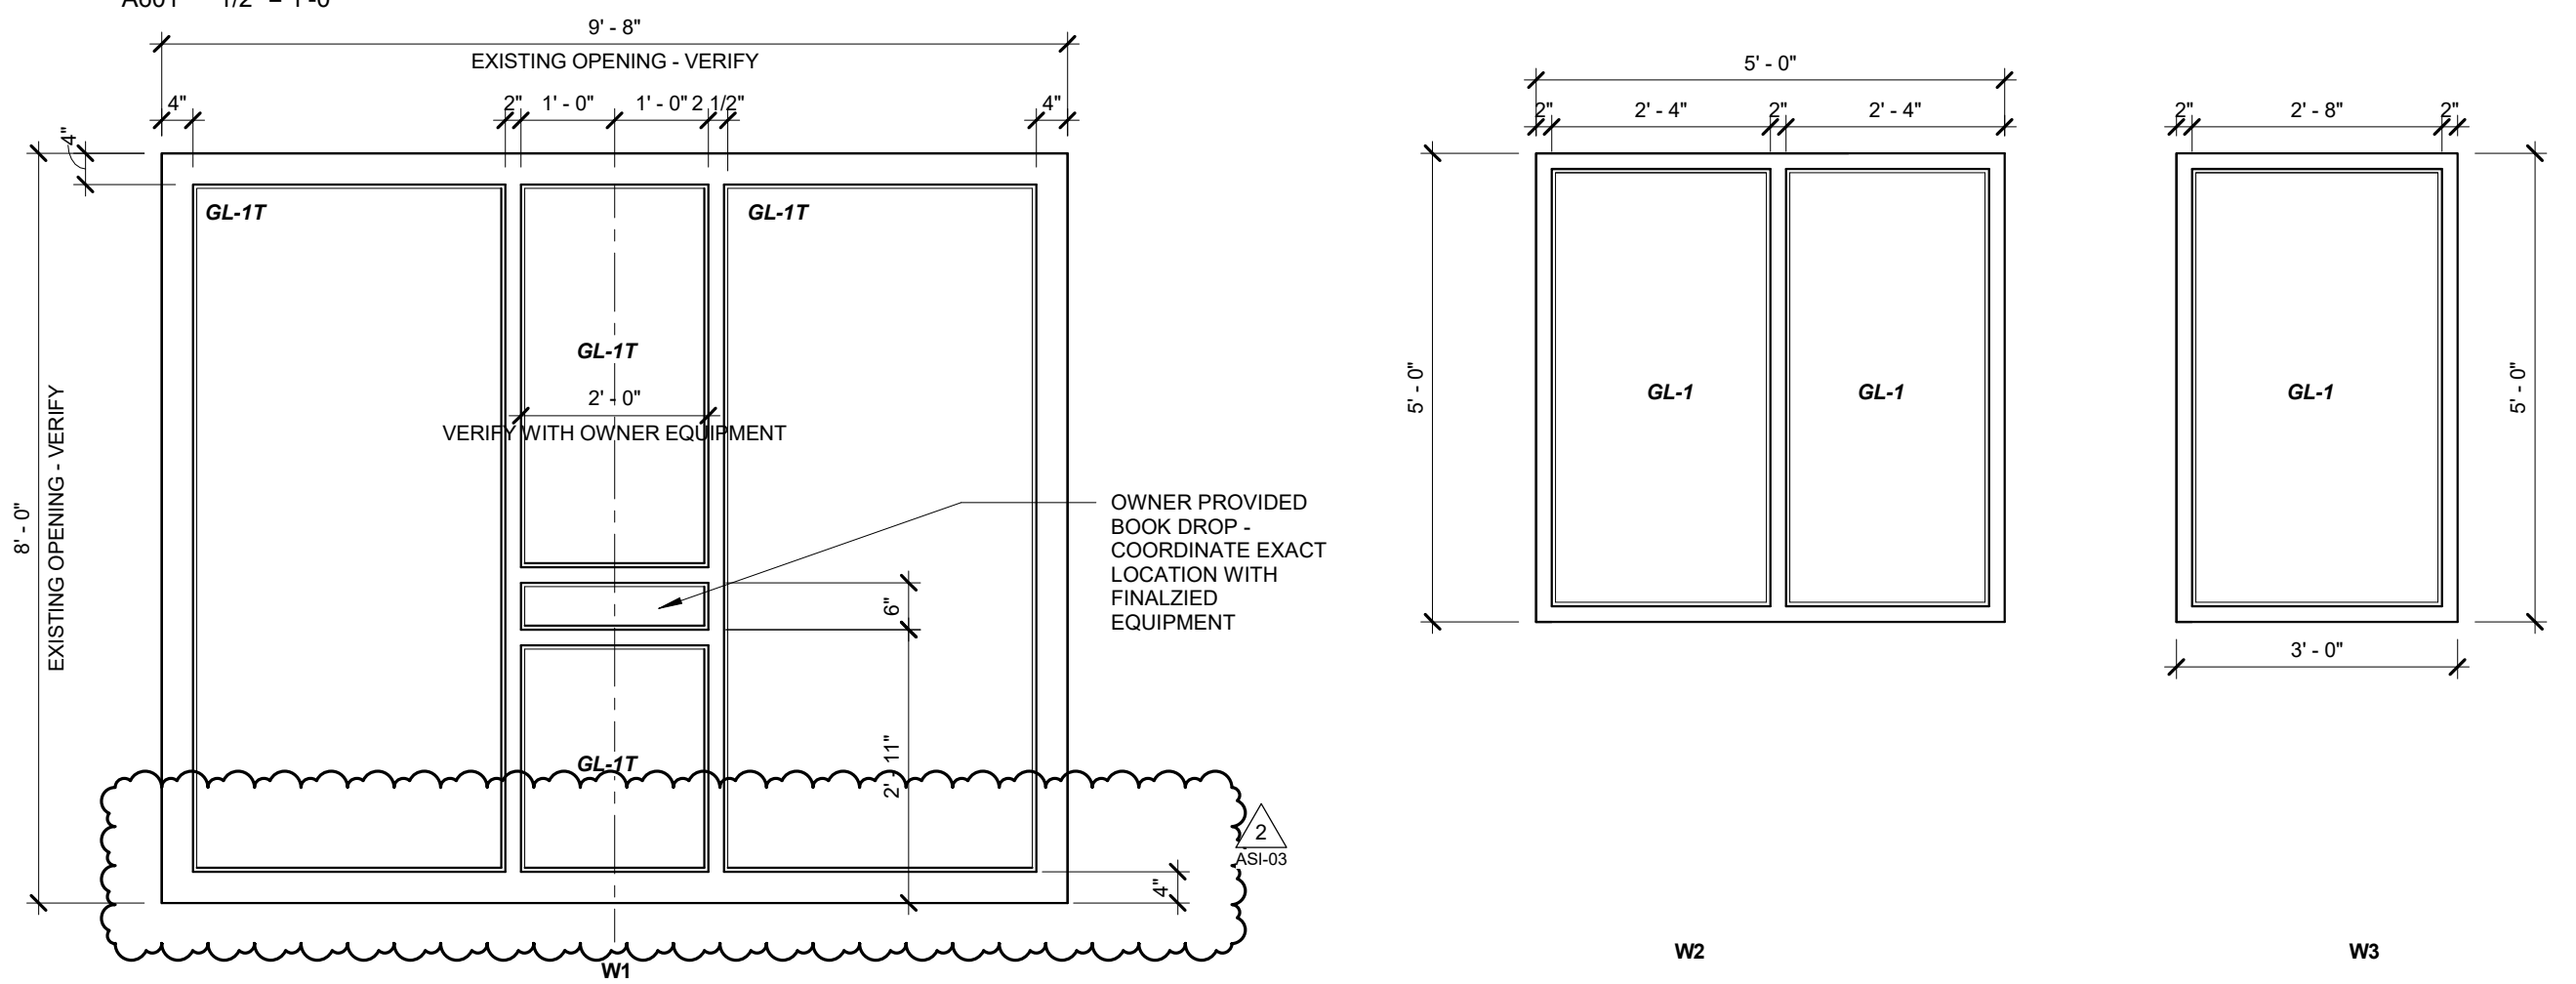


3 WINDOW TYPES
A601 1/2" = 1'-0"

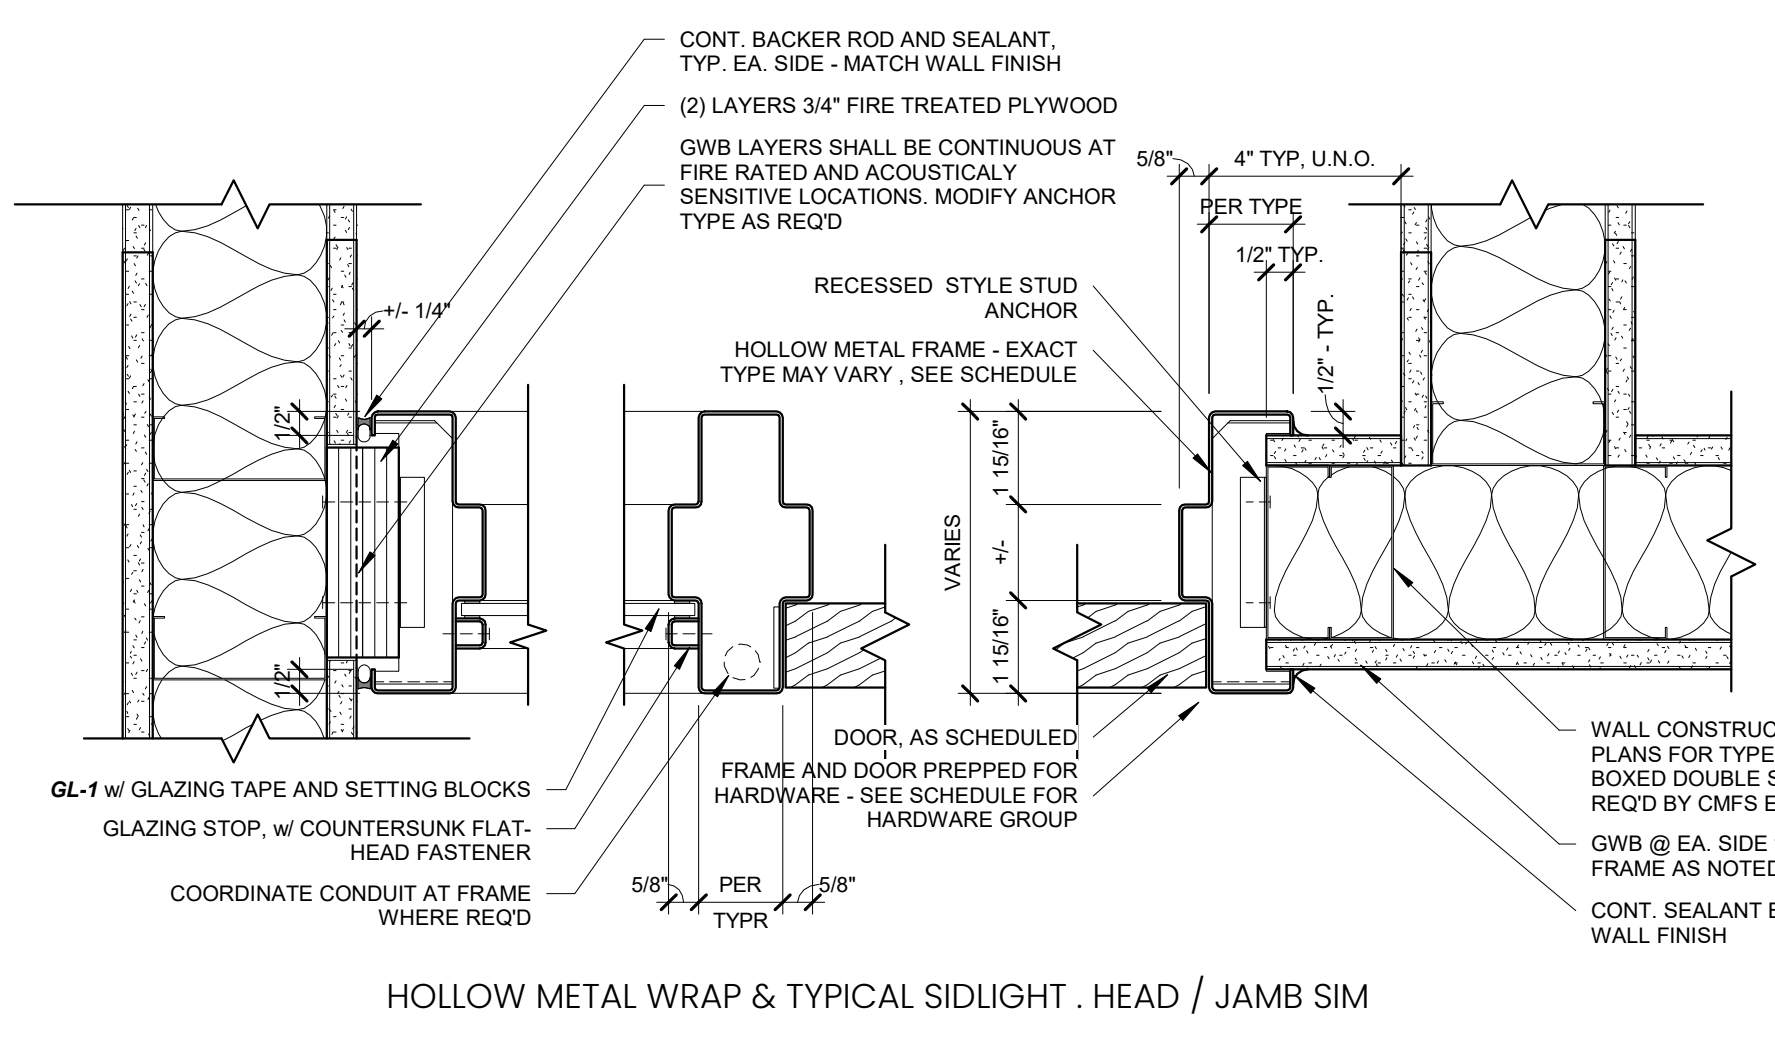


4 HM DOOR / WINDOW DETAILS
A601 3" = 1'-0"

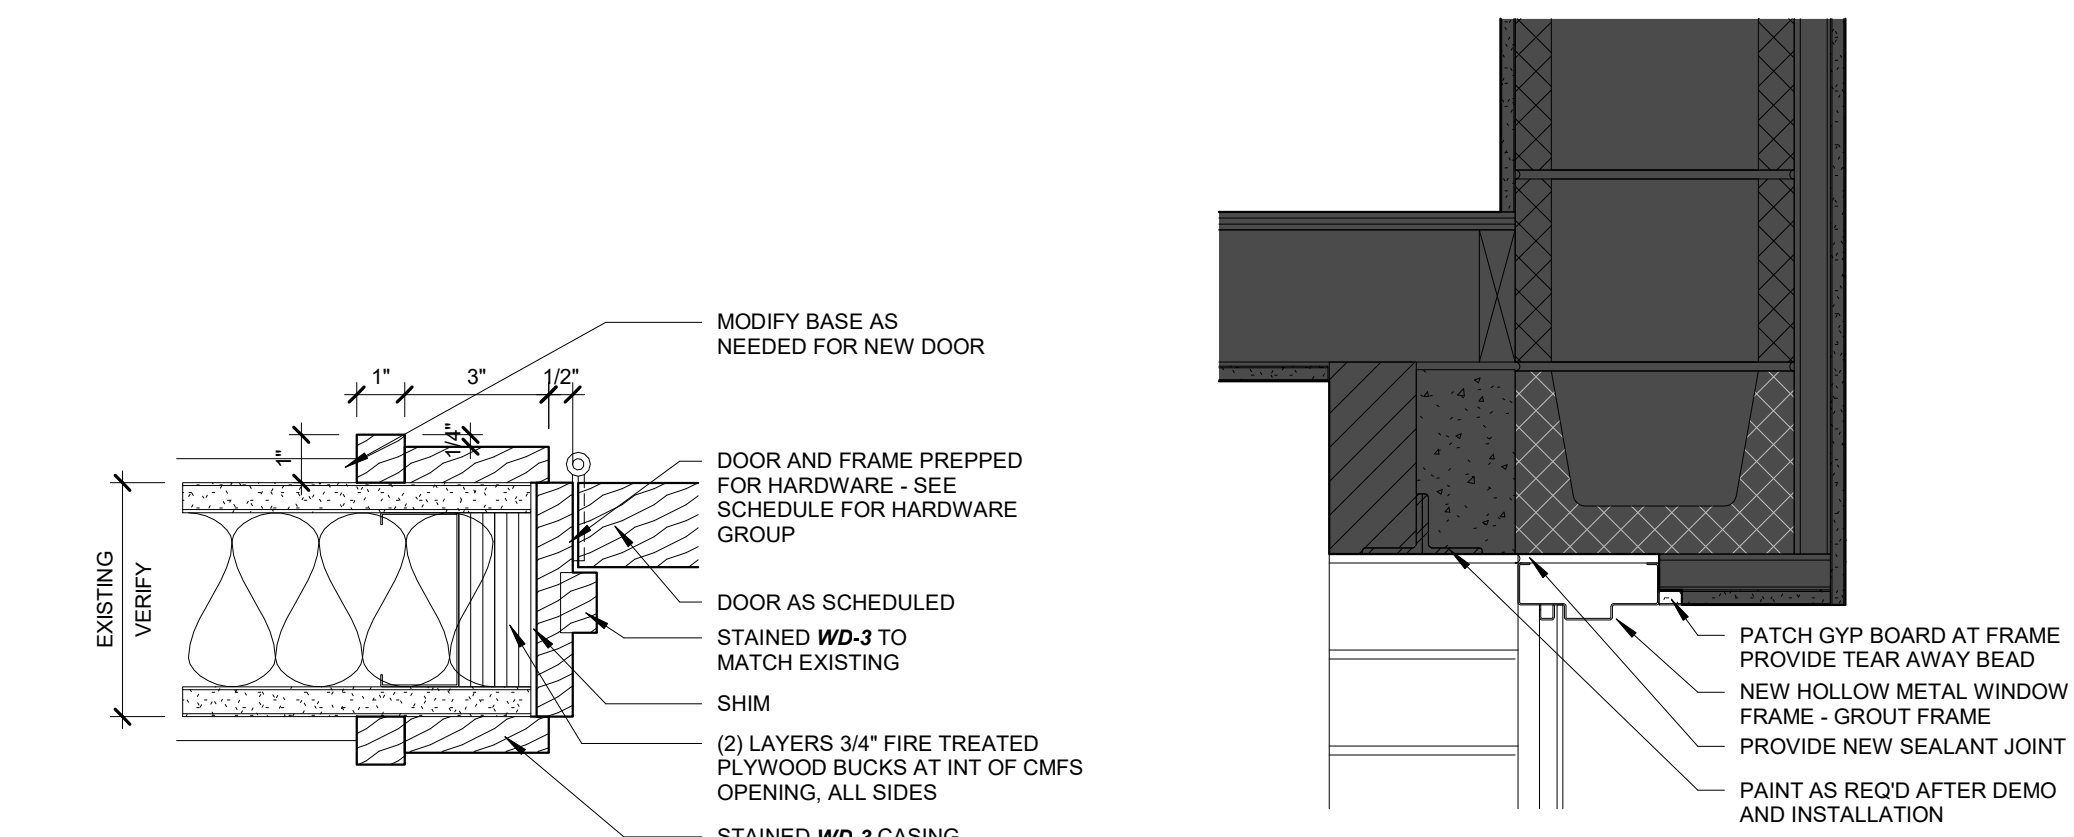


5 F6 JAMB - HEADER SIM
A601 3" = 1'-0"

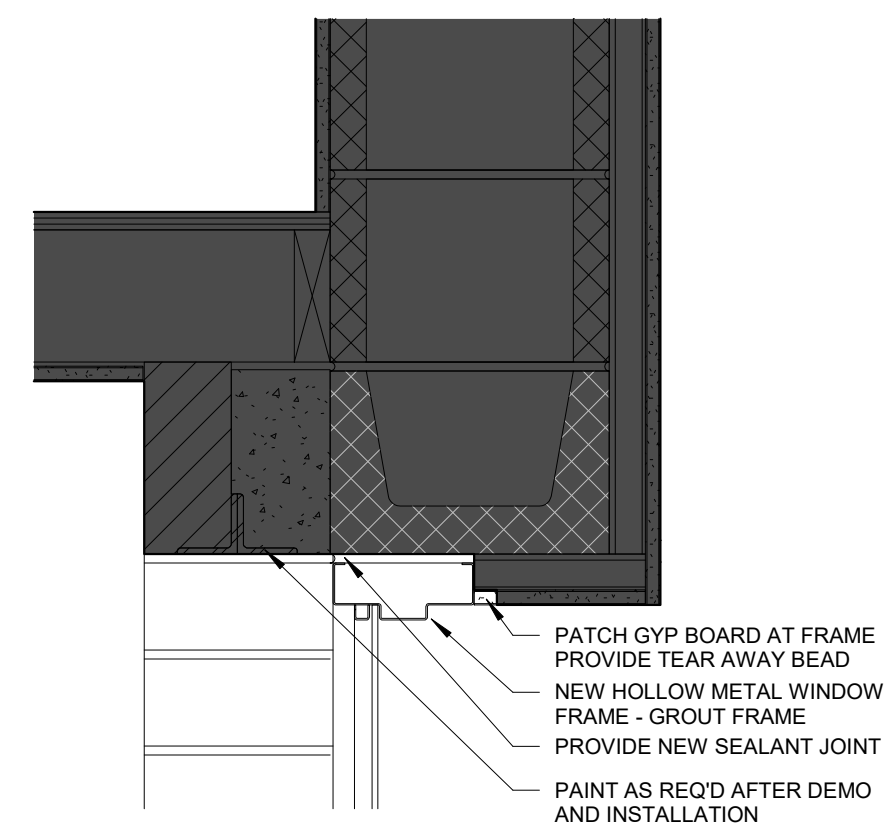


6 W1 HEADER
A601 1 1/2" = 1'-0"

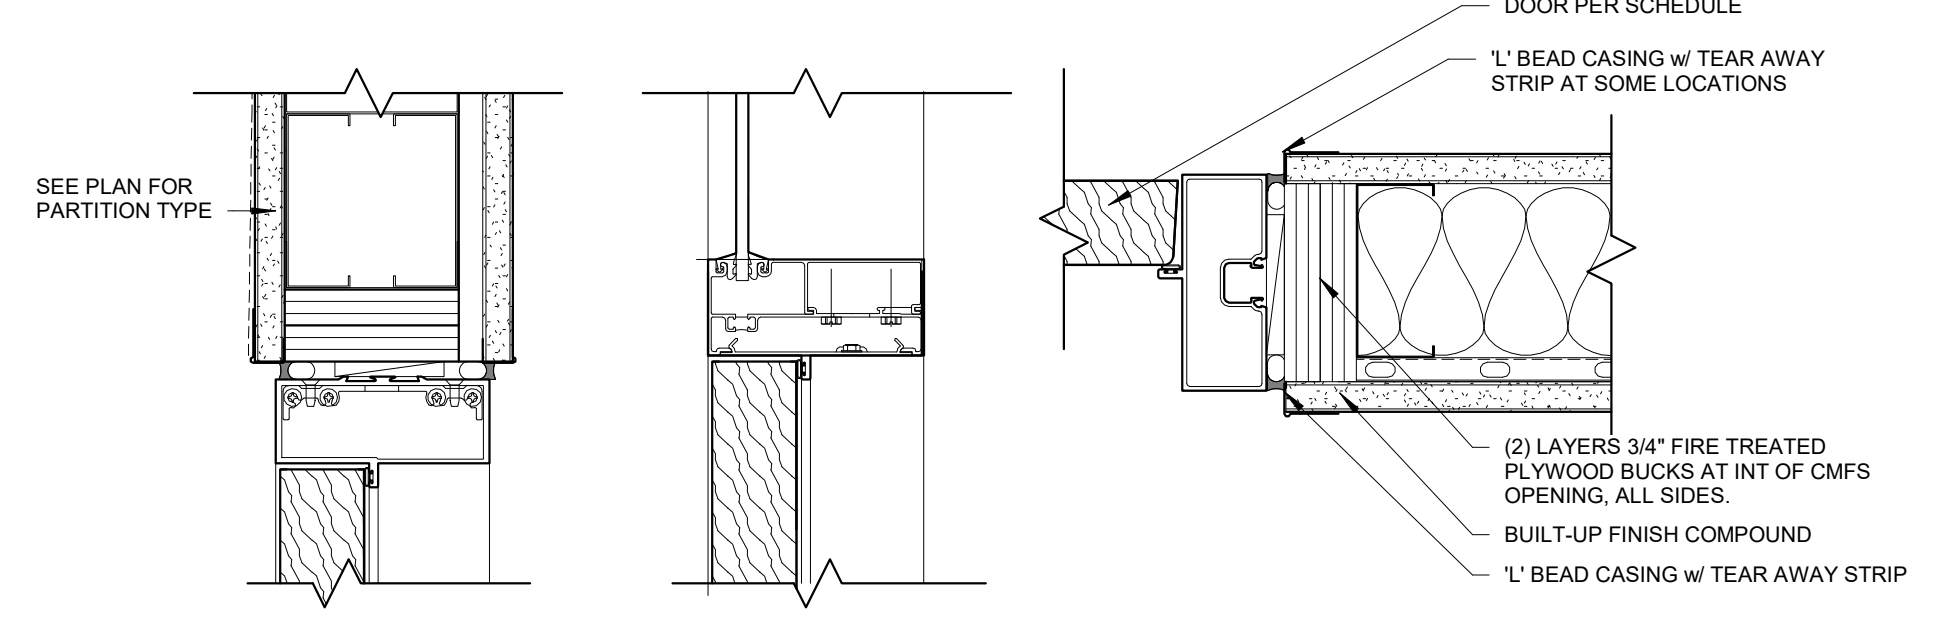

7 ALSF DETAILS
A601 3" = 1'-0"

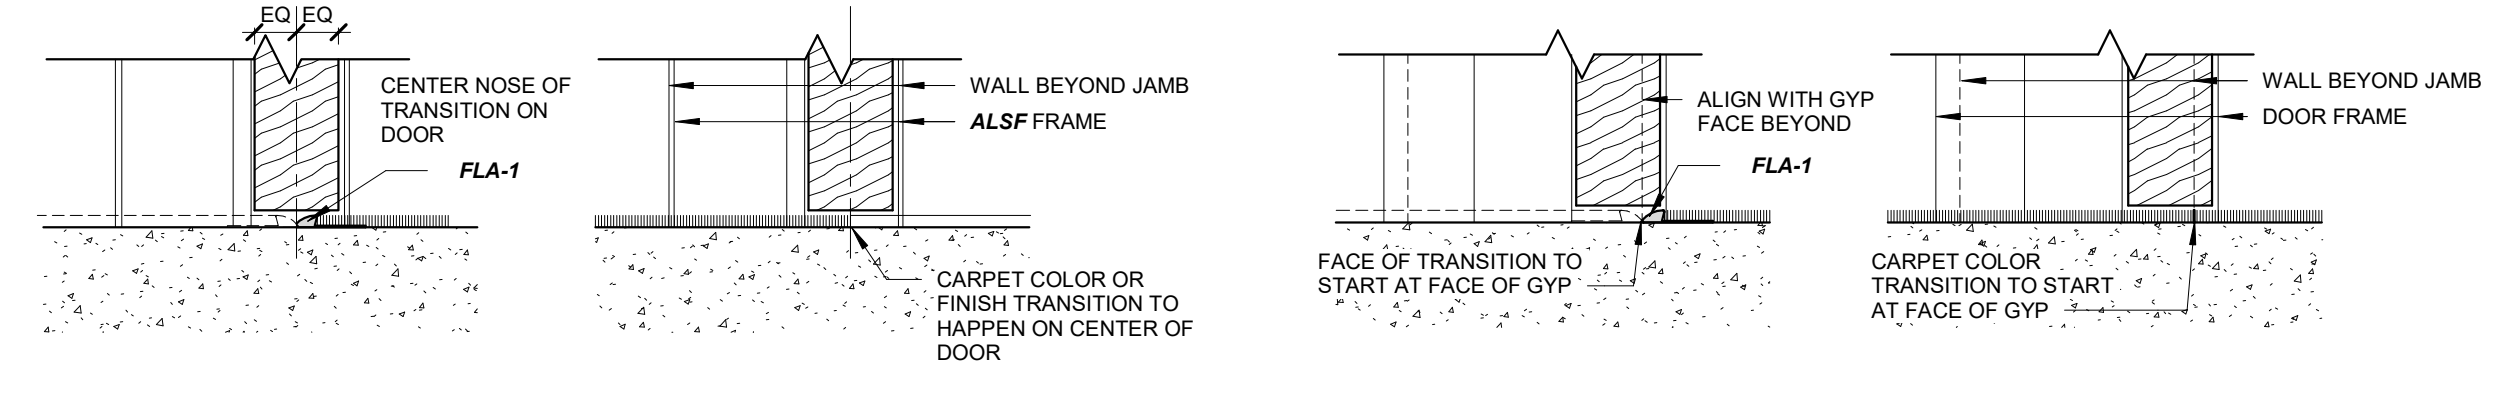

8 SILL DETAIL ALSF
A601 3" = 1'-0"

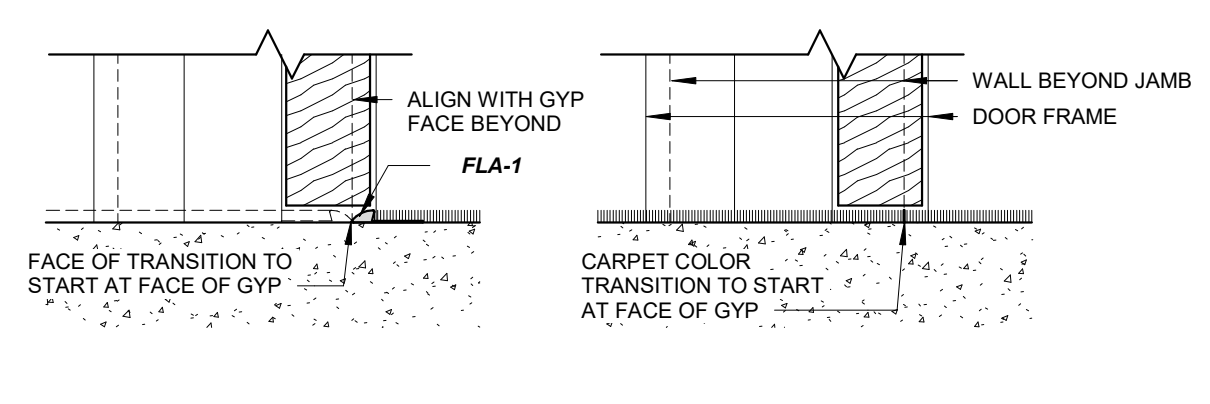

9 SILL DETAIL HOLLOW METAL
A601 3" = 1'-0"

DOOR SCHEDULE												
DOOR NO	DOOR	TYPE	MATL	HEAD	SILL	JAMB	FRAME	TYPE	MATL	FIRE	HDWR	COMMENTS
106	3'-0" x 7'-10" x 1 3/4"	D1	WD-3	4/A601	NA	4/A601	4/A601	F1	HM		13.0	
129E	3'-0" x 7'-10" x 1 3/4"	D2	HM/IGL-1T	EXIST	EXIST	EXIST	EXIST	F1	HM		4.0	NEW DOOR IN EXISTING FRAME - FIELD VERIFY
140A	3'-0" x 7'-10" x 1 3/4"	D2	WD-3GL	EXIST	EXIST	EXIST	EXIST	F1	HM		7.3	NEW DOOR IN EXISTING FRAME - FIELD VERIFY
140B	3'-0" x 7'-10" x 1 3/4"	D2	WD-3GL	EXIST	EXIST	EXIST	EXIST	F1	HM		7.3	
159	3'-0" x 7'-10" x 1 3/4"	D1	WD-3	4/A601	4/A601	4/A601	4/A601	F1	HM		9.0	
162	3'-0" x 7'-10" x 1 3/4"	D2	WD-3GL	4/A601	NA	4/A601	4/A601	F2	HM		11.0	
163	3'-0" x 7'-10" x 1 3/4"	D2	WD-3GL	4/A601	NA	4/A601	4/A601	F2	HM		11.0	
165	3'-0" x 7'-10" x 1 3/4"	D2	WD-3GL	4/A601	NA	4/A601	4/A601	F2	HM		11.0	
166	3'-0" x 7'-10" x 1 3/4"	D2	WD-3GL	4/A601	NA	4/A601	4/A601	F2	HM		11.0	
167	3'-0" x 7'-10" x 1 3/4"	D2	WD-3GL	4/A601	4/A601	4/A601	4/A601	F3	HM		11.0	
168	3'-0" x 7'-10" x 1 3/4"	D2	WD-3GL	4/A601	4/A601	4/A601	4/A601	F3	HM		11.0	
200	20" x 14" x 0 7/8"	D1	WD-1	4/A601	NA	4/A601	4/A601	F1	HM		7.1	
201	3'-0" x 8'-0" x 1 3/4"	D2	WD-1GL	7/A601	NA	7/A601	ALSF-1	AL			11.2	SEE INTERIOR ELEVATIONS FOR FRAME TYPE
201A	6'-0" x 8'-0" x 1 3/4"	D3	HM	4/A601	NA	4/A601	F1	HM		1 HR	6.0	PROVIDE 1 HOUR RATING AT HARDWARE AND DOOR
201E	6'-0" x 8'-0" x 1 3/4"	D5	ALJGU-1T	1/A603	5/A371	1/A603	5/A371	SEE ELEV	AL		3.1	SEE ELEVATIONS FOR FRAME TYPE
204	3'-0" x 8'-0" x 1 3/4"	D2	WD-1GL	7/A601	4/A601	4/A601	27/A551	ALSF-1	AL		11.1	SEE INTERIOR ELEVATIONS FOR FRAME TYPE
205	3'-0" x 8'-0" x 1 3/4"	D2	WD-1GL	7/A601	NA	29/A501	ALSF-1	AL			11.1	SEE INTERIOR ELEVATIONS FOR FRAME TYPE
206	3'-0" x 8'-0" x 1 3/4"	D2	WD-1GL	7/A601	NA	29/A501	ALSF-1	AL			11.1	SEE INTERIOR ELEVATIONS FOR FRAME TYPE
207	3'-0" x 8'-0" x 1 3/4"	D2	WD-1GL	4/A601	NA	4/A601	F2	HM			7.0	
208	3'-0" x 8'-0" x 1 3/4"	D2	WD-1GL	4/A601	NA	4/A601	F1	HM			7.0	
209	3'-0" x 8'-0" x 1 3/4"	D2	WD-1GL	4/A601	NA	4/A601	F1	HM			7.0	
209A	3'-0" x 8'-0" x 1 3/4"	D2	WD-1GL	4/A601	NA	4/A601	F5	HM			7.0	
210	3'-0" x 8'-0" x 1 3/4"	D2	WD-1GL	4/A601	NA	4/A601	F4	HM			7.1	
210A	3'-0" x 8'-0" x 1 3/4"	D1	WD-1	4/A601	NA	4/A601	F1	HM			7.1	
211	3'-0" x 8'-0" x 1 3/4"	D2	WD-1GL	4/A601	NA	4/A601	F2	HM			7.0	
212E	3'-0" x 8'-0" x 1 3/4"	D6	ALJGU-1T	1/A603	1/A372	1/A603	1/A372	SEE ELEV	AL		3.3	SEE ELEVATIONS FOR FRAME TYPE
213E	6'-0" x 8'-0" x 1 3/4"	D6	ALJGU-1T	1/A603	1/A372	1/A603	1/A372	SEE ELEV	AL		3.0	SEE ELEVATIONS FOR FRAME TYPE
214	3'-0" x 8'-0" x 1 3/4"	D1	WD-3GL	4/A601	4/A601	4/A601	4/A601	F2	HMPT-C		9.2	PAINT FRAME PT-C ON BOTH SIDES
215	3'-0" x 8'-0" x 1 3/4"	D1	WD-1	7/A601	4/A601	4/A601	ALSF-1	AL			11.2	SEE INTERIOR ELEVATIONS FOR FRAME TYPE
217	3'-0" x 7'-10" x 1 3/4"	D1	HM	4/A601	NA	4/A601	F1	HM			10.0	
219	3'-0" x 7'-10" x 1 3/4"	D1	HM	4/A601	NA	4/A601	F1	HM			6.2	
219A	3'-0" x 8'-0" x 1 3/4"	D3	WD-1GL	4/A601	4/A601	4/A601	F1	HM			6.1	HM FRAME PT-C ON CORRIDOR SIDE, PT-B ON ROOM SIDE (SEE JAMB DETAIL)
220	6'-0" x 8'-0" x 1 3/4"	D4	WD-1GL	4/A601	4/A601	4/A601	F1	HM			2.1	HM FRAME PT-C ON CORRIDOR SIDE, PT-B ON ROOM SIDE (SEE JAMB DETAIL)
220A	6'-0" x 8'-0" x 1 3/4"	D4	WD-1GL	4/A601	4/A601	4/A601	F1	HM			2.0	HM FRAME PT-C ON CORRIDOR SIDE, PT-B ON ROOM SIDE (SEE JAMB DETAIL)
220B	6'-0" x 8'-0" x 1 3/4"	D4	WD-1GL	4/A601	4/A601	4/A601	F1	HM			2.0	HM FRAME PT-C ON CORRIDOR SIDE, PT-B ON ROOM SIDE (SEE JAMB DETAIL)
220C	6'-0" x 8'-0" x 1 3/4"	D4	WD-1GL	4/A601	4/A601	4/A601	F1	HM			2.0	HM FRAME PT-C ON CORRIDOR SIDE, PT-B ON ROOM SIDE (SEE JAMB DETAIL)
220D	6'-0" x 8'-0" x 1 3/4"	D4	WD-1GL	4/A601	4/A601	4/A601	F1	HM			2.0	HM FRAME PT-C ON CORRIDOR SIDE, PT-B ON ROOM SIDE (SEE JAMB DETAIL)
221	4'-0" x 7'-10" x 1 3/4"	D1	WD-1	4/A601	4/A601	4/A601	F1	HM			10.1	
221A	6'-0" x 7'-10" x 1 3/4"	D3	HM	4/A601	4/A601	4/A601	F1	HM			6.0	
222	3'-0" x 8'-0" x 1 3/4"	D2	WD-1GL	7/A601	4/A601	4/A601	ALSF-1	AL			11.2	SEE INTERIOR ELEVATIONS FOR FRAME TYPE
223	6'-0" x 8'-0" x 1 3/4"	D6	ALJGU-1T	1/A603	1/A372	1/A603	1/A372	SEE ELEV	AL		3.2	SEE ELEVATIONS FOR FRAME TYPE
224	3'-0" x 8'-0" x 1 3/4"	D1	WD-1GL	4/A601	4/A601	4/A601	F1	HM			11.2	
224A	3'-0" x 8'-0" x 1 3/4"	D1	WD-1GL	4/A601	4/A601	4/A601	F1	HM			11.2	
225	3'-0" x 8'-0" x 1 3/4"	D1	WD-1GL	4/A601	4/A601	4/A601	F1	HM			9.1	
226E	6'-0" x 8'-0" x 1 3/4"	D6	ALJGU-1T	1/A603	1/A372	1/A603	1/A372	SEE ELEV	AL		3.2	SEE ELEVATIONS FOR FRAME TYPE
229	3'-0" x 8'-0" x 1 3/4"	D2	WD-1GL	4/A601	4/A601	4/A601	F1	HM			8.0	
229	3'-0" x 8'-0" x 1 3/4"	D2	WD-1GL	4/A601	4/A601	4/A601	F1	HM			8.1	
230	3'-0" x 8'-0" x 1 3/4"	D2	WD-1GL	4/A601	4/A601	4/A601	F1	HM			8.1	
231	3'-0" x 8'-0" x 1 3/4"	D2	WD-1GL	4/A601	4/A601	4/A601	F1	HM			8.1	
232	3'-0" x 8'-0" x 1 3/4"	D2	WD-1GL	4/A601	4/A601	4/A601	F1	HM			8.0	

Architecture and Interiors
MSRDesign
 510 Marquette Avenue South, Suite 200
 Minneapolis, MN 55402 | 612.375.0336

Associate Architect
Hight Jackson Associates PA
 5201 W Village Plaza #300
 Rogers, AR 72758 | 479.464.4965

Civil Engineer
E | D | G
 216 West Birch Street
 Rogers, AR 72758 | 501.378.0200

Landscape Architect
TEN x TEN
 575 SE 9th St #210
 Minneapolis, MN 55414 | 612.440.8369

Structural Engineer
Tatum Smith Welcher Engineers, Inc.
 3100 S Market St #202
 Rogers, AR 72758 | 479.621.6128

MEP Engineer
HP Engineering, Inc.
 5504 W. Pinnacle Point Drive Suite 200
 Rogers, AR 72758 | 479.899.6370

Project No. 20210027
Bentonville Public Library Expansion
 405 S Main Street
 Bentonville, AR 72712

I hereby certify that this plan, specification or report was prepared by me or under my direct supervision and that I am a duly Licensed Architect under the Laws of the State of Arkansas.
 Architect Seal



Signature
 Print Name **Matthew Kruttor**
 Date 5/30/2023 License No. 10100

ASI-03

ISSUE / REVISION

Mark	Date	Description
1	10/28/2022	LARGE SCALE DEVELOPMENT SUBMITTAL
2	11/14/2022	SECOND LSD SUBMITTAL
3	11/28/2022	THIRD LSD SUBMITTAL
4	12/21/2022	PERMIT SET
5	1/6/2023	BID SET
6	3/23/2023	ASI-01
7	5/30/2023	ASI-03

DOOR SCHEDULE, TYPES AND DETAILS

A601