


1 SITE GRADING & DRAINAGE PLAN (NORTH)

SCALE: 1" = 20'-0"

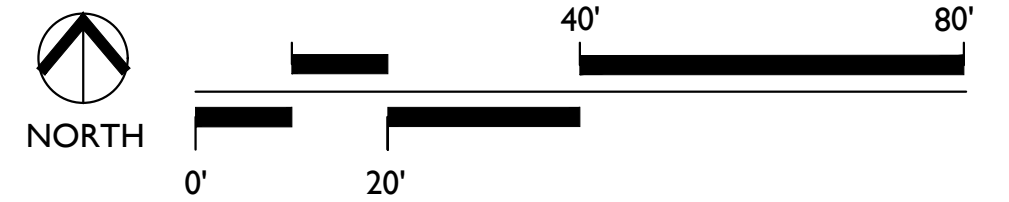

Architecture and Interiors  
**MSRDesign**  
 510 Marquette Avenue South, Suite 200  
 Minneapolis, MN 55402 | 612.375.0396

Associate Architect  
**Hight Jackson Associates PA**  
 5201 W Village Pkwy #300  
 Rogers, AR 72758 | 479.464.4965

Civil Engineer  
**E | D | G**  
 216 West Birch Street  
 Rogers, AR 72756 | 501.378.0200

Landscape Architect  
**TEN x TEN**  
 575 SE 9th St #210  
 Minneapolis, MN 55414 | 612.440.8369


Structural Engineer  
**Tatum Smith Welcher Engineers, Inc.**  
 3100 S Market St #202  
 Rogers, AR 72758 | 479.621.6128

MEP Engineer  
**HP Engineering, Inc.**  
 5214 W Village Pkwy #120  
 Rogers, AR 72758 | 479.899.6370

**Bentonville Public Library**  
**Expansion**  
 405 S Main Street  
 Bentonville, AR 72712

Project No. 2021027

I hereby certify that this plan, specification or report was prepared by me or under my direct supervision and that I am a duly Licensed Architect under the Laws of the State of Minnesota.

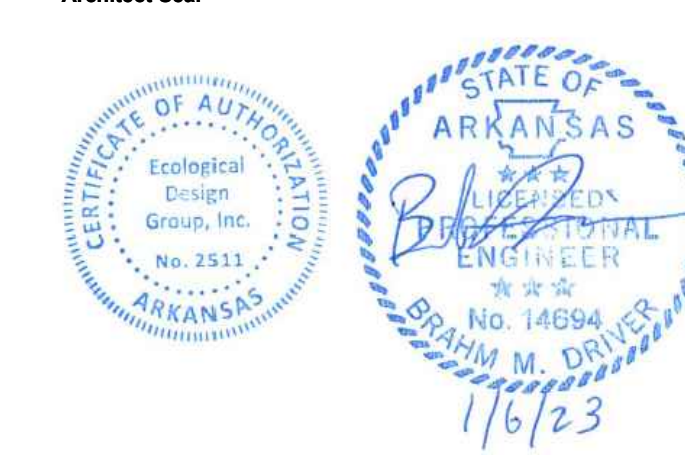

Signature \_\_\_\_\_  
 Print Name \_\_\_\_\_  
 Date \_\_\_\_\_ License No. \_\_\_\_\_

**BID SET**

**ISSUE / REVISION**

Mark	Date	Description
	12/16/2021	SCHEMATIC DESIGN PRICING
	06/22/2022	DESIGN DEVELOPMENT PRICING
	8/1/2022	DD VE OPTION B
	10/13/2022	PRE-APP SET
	10/28/2022	LARGE SCALE DEVELOPMENT SUBMITTAL
	10/31/2022	CD PRICING SET
	11/14/2022	SECOND LRD SUBMITTAL
	11/28/2022	THIRD LRD SUBMITTAL
	12/21/2022	PERMIT SET
	01/06/2023	BID SET
	01/18/2023	BID SET - ADDENDUM 1
	02/02/2023	BID SET - ADDENDUM 3
	03/30/2023	ASI 2
	05/22/2023	ASI 4

**SITE GRADING & DRAINAGE PLAN (NORTH)**  
**C300**