


1 SITE GRADING & DRAINAGE PLAN (NORTH)

SCALE: 1" = 20'-0"

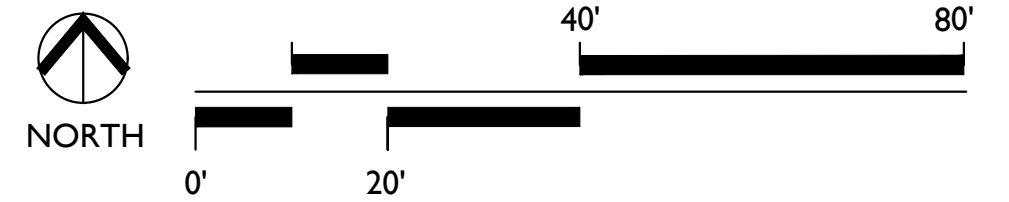

Architecture and Interiors
MSRDesign
 510 Marquette Avenue South, Suite 200
 Minneapolis, MN 55402 | 612.375.0336

Associate Architect
Hight Jackson Associates PA
 5201 W Village Pkwy #300
 Rogers, AR 72758 | 479.464.4965

Civil Engineer
E | D | G
 216 West Birch Street
 Rogers, AR 72756 | 501.378.0200

Landscape Architect
TEN x TEN
 575 SE 9th St #210
 Minneapolis, MN 55414 | 612.440.8369

Structural Engineer
Tatum Smith Welcher Engineers, Inc.
 3100 S Market St #202
 Rogers, AR 72758 | 479.621.6128

MEP Engineer
HP Engineering, Inc.
 5214 W Village Pkwy #120
 Rogers, AR 72758 | 479.899.6370



Bentonville Public Library Expansion
 405 S Main Street
 Bentonville, AR 72712
 AEC - Bentonville Public Library Expansion - LSD22-0062 - REVISION 1 - 7/24/2023

Project No. 2021027

I hereby certify that this plan, specification or report was prepared by me or under my direct supervision and that I am a duly Licensed Architect under the Laws of the State of Minnesota.



Signature _____
 Print Name _____
 Date _____ License No. _____

BID SET

ISSUE / REVISION

Mark	Date	Description
	12/16/2021	SCHEMATIC DESIGN PRICING
	06/22/2022	DESIGN DEVELOPMENT PRICING
	8/1/2022	DD VE OPTION B
	10/13/2022	PRE-APP SET
	10/28/2022	LARGE SCALE DEVELOPMENT SUBMITTAL
	10/31/2022	CD PRICING SET
	11/14/2022	SECOND LSO SUBMITTAL
	11/28/2022	THIRD LSO SUBMITTAL
	12/21/2022	PERMIT SET
	01/06/2023	BID SET
	01/18/2023	BID SET - ADDENDUM 1
	05/25/2023	BID SET - ADDENDUM 3
	03/30/2023	ASI 2
	06/25/2023	ASI 4
	07/24/2023	ASI 5

SITE GRADING & DRAINAGE PLAN (NORTH)
C300