

Project Number: P00000-0000
Printed: 2/2/2026 2:06:45 PM
C:\Users\jdesign1\Documents\Revit\DOBson-Harrill_Restroom_Renovation_Arch_2023_jdesign176322.rvt

HARRILL-DOBSON INTERIOR UPGRADES

NORTHEASTERN OKLAHOMA A&M COLLEGE

200 I STREET NORTHEAST
MIAMI, OK 74354

CONSTRUCTION DOCUMENTS

OWNER
NORTHEASTERN OKLAHOMA A&M
COLLEGE (NEO)
200 I STREET NORTHEAST
MIAMI, OK 74354


CONTACT
JEFF BOMAN
918-540-6226
jboman@neo.edu

PROJECT MANAGER
SAMUEL KESSLER GRAVES, PE
CYNTERGY
810 S CINCINNATI AVE, STE 200
TULSA, OK 74119
918.877.6000
sgraves@cyntergy.com

ARCHITECT
DAVID F. PHELPS, AIA
CYNTERGY
810 S CINCINNATI AVE, STE 200
TULSA, OK 74119

MECHANICAL ENGINEER
SAMUEL KESSLER GRAVES, PE
CYNTERGY
810 S CINCINNATI AVE, STE 200
TULSA, OK 74119

SHEET ISSUE MATRIX													
• ISSUED • ISSUED FOR REFERENCE ONLY			ISSUE FOR CONSTRUCTION										
			03/29/2023	04/06/2023	02/04/2026	01/15/2026	01/15/2026	01/15/2026	01/15/2026	01/15/2026	01/15/2026	01/15/2026	01/15/2026
SHEET NO	SHEET TITLE												
GENERAL													
G-001	COVER SHEET		•	•	•								
ARCHITECTURAL													
A-001	NOTES, LEGENDS, AND ABBREVIATIONS		•	•									
AD101	FIRST FLOOR DEMOLITION PLAN		•	•									
AD102	SECOND FLOOR DEMOLITION PLAN		•	•									
AD103	THIRD FLOOR DEMOLITION PLAN		•	•									
A-101	FIRST FLOOR AND FINISH PLAN		•	•									
A-102	SECOND FLOOR AND FINISH PLAN		•	•									
A-103	THIRD FLOOR AND FINISH PLAN		•	•									
A-111	FIRST FLOOR REFLECTED CEILING PLAN		•										
A-112	SECOND FLOOR REFLECTED CEILING PLAN		•										
A-113	THIRD FLOOR REFLECTED CEILING PLAN		•										
A-603	INTERIOR ELEVATIONS, PARTITION TYPES, DOOR SCHEDULE AND DOOR ELEVATIONS		•	•	•								
PLUMBING													
P-001	PLUMBING NOTES, LEGENDS, & ABBREVIATIONS		•										
P-002	PLUMBING SPECIFICATIONS		•										
P-101	DOBSON-HARRILL DWV FLOOR PLANS		•	•									
P-111	DOBSON-HARRILL WAG FLOOR PLANS		•	•									
P-501	PLUMBING DETAILS		•										
P-601	PLUMBING SCHEDULES		•	•									
P-901	SANITARY RISER DIAGRAMS		•	•									
P-902	DCWDHW RISER DIAGRAMS		•	•									

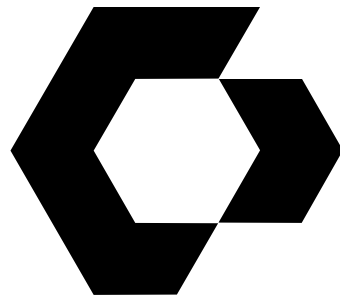

CYNERGY
810 S CINCINNATI AVE, STE 200
TULSA, OK 74119
918.877.6000

CYNERGY ENGINEERING, PLLC
LICENSE # 3537



SAMUEL KESSLER GRAVES, PE
ENGINEER OF RECORD

HARRILL-DOBSON INTERIOR
UPGRADES
NORTHEASTERN OKLAHOMA A&M COLLEGE
200 I STREET NORTHEAST
MIAMI, OK 74354

THIS DRAWING WAS PREPARED SOLELY AND EXCLUSIVELY FOR EXECUTION OF THE PROJECT IDENTIFIED WITHIN THESE DOCUMENTS. IT CONTAINS NO PARTS, MATERIALS, OR METHODS OF CONSTRUCTION THAT ARE NOT IDENTIFIED IN THE PROJECT DESCRIPTION. THIS DRAWING MAY NOT BE USED ON OTHER PROJECTS OR FOR ADDITIONS TO THE PROJECT OUTSIDE THE SCOPE OF WORK WITHOUT WRITTEN CONSENT OF THE OWNER, ARCHITECT, AND THE ARCHITECT'S CONSULTANTS. THE ARCHITECT AND THE ARCHITECT'S CONSULTANTS ARE THE AUTHORS AND OWNERS OF THEIR RESPECTIVE DRAWINGS AND SPECIFICATIONS, AND RETAIN ALL COMMON LAW, STATUTORY, AND OTHER RIGHTS, INCLUDING COPYRIGHTS.

ISSUES / REVISIONS		
	03/29/2023	ISSUE FOR CONSTRUCTION
1	04/06/2023	ASI 1
2	02/04/2026	ASI 2

ISSUE DATE: 03/29/2023
CHECKED BY: S/G
DRAWN BY: JD

SHEET NAME
COVER SHEET

SHEET NUMBER

G-001

ABBREVIATIONS					
ACC	ACCESSIBLE	LAM	LAMINATE		
ACT	ACOUSTICAL CEILING TILE	LAV	LAVATORY		
ADDM	ADDENDUM	LKR	LOCKER		
ADJ	ADJACENT, ADJUSTABLE	LT	LIGHT		
AFF	ABOVE FINISHED FLOOR	LTG	LIGHTING		
AFG	ABOVE FINISHED GRADE	LVR	LOUVER		
AFS	ABOVE FINISHED SLAB				
ALUM	ALUMINUM	MATL	MATERIAL		
ANOD	ANODIZE	MAX	MAXIMUM		
APPROX	APPROXIMATE	MECH	MECHANICAL		
ARCH	ARCHITECTURAL	MEMB	MEMBRANE		
ASPH	ASPHALT	MFD	MANUFACTURED		
		MFR	MANUFACTURER		
BAT	BATTEN	MIN	MINIMUM		
BITUM	BITUMINOUS	MIRR	MIRROR		
BLDG	BUILDING	MISC	MISCELLANEOUS		
BOT	BOTTOM	MO	MASONRY OPENING		
BTWN	BETWEEN	MTD	MOUNTED		
		MTG	MOUNTING		
CAB	CABINET	MTL	METAL		
CG	CORNER GUARD	MULL	MULLION		
CJ	CONTROL JOINT				
CL	CENTER LINE	NIC	NOT IN CONTRACT		
CLG	CEILING	NO	NUMBER		
CLO	CLOSET	NOM	NOMINAL		
CLR	CLEAR	NTS	NOT TO SCALE		
CLRM	CLASSROOM				
CMU	CONCRETE MASONRY UNIT	OIO	OUT TO OUT		
CO	CASED OPENING	OA	OVERALL		
COL	COLUMN	OC	ON CENTER		
CONC	CONCRETE	OD	OUTSIDE DIAMETER		
CONF	CONFERENCE	OFD	OVERFLOW DRAIN		
CONSTR	CONSTRUCTION	OH	OVERHANG		
CONT	CONTINUOUS	OPH	OPPOSITE HAND		
COORD	COORDINATE	OPNG	OPENING		
CORR	CORRIDOR	OPP	OPPOSITE		
CPT	CARPET				
CT	CERAMIC TILE	PLAM	PLASTIC LAMINATE		
CTB	CERAMIC TILE BASE	PLAS	PLASTER		
		PLBG	PLUMBING		
DEMO	DEMOLITION	PLYWD	PLYWOOD		
DF	DRINKING FOUNTAIN	PR	PAIR		
DIA	DIAMETER	PRCST	PRE-CAST		
DISP	DISPENSER	PT	PAINT		
DN	DOWN				
DS	DOWNSPOUT	QT	QUARRY TILE		
DW	DISHWASHER	QTR	QUARTER		
DWR	DRAWER	QTY	QUANTITY		
EA	EACH	R	RADIUS; RISER		
EHD	ELECTRIC HAND DRYER	RB	RUBBER BASE		
EIFS	EXTERIOR INSULATION AND FINISH SYSTEM	RCP	REFLECTED CEILING PLAN		
EJ	EXPANSION JOINT	RD	ROOF DRAIN		
EL	ELEVATION	REF	REFRIGERATOR		
ELEC	ELECTRICAL	REINF	REINFORCED		
ELEV	ELEVATOR	REQ	REQUIRED		
EOS	EDGE OF SLAB	RESIL	RESILIENT		
EQ	EQUAL	REST	RESTROOM		
EQUIP	EQUIPMENT	RM	ROOM		
EQUIV	EQUIVALENT	RO	ROUGH OPENING		
EWC	ELECTRIC WATER COOLER				
EXIST	EXISTING	SC	SOLID CORE		
EXT	EXTERIOR; EXTERNAL	SCHED	SCHEDULE		
		SCWD	SOLID CORE WOOD DOOR		
FD	FLOOR DRAIN	SD	SOAP DISPENSER		
FE	FIRE EXTINGUISHER	SECT	SECTION		
FEC	FIRE EXTINGUISHER CABINET	SHT	SHEET		
FF	FINISH FACE	SIM	SIMILAR		
FHC	FIRE HOSE CABINET	SPEC	SPECIFICATION		
FIN	FINISH	SST	STAINLESS STEEL		
FIXT	FIXTURE	STD	STANDARD		
FLASH	FLASHING	STL	STEEL		
FLEX	FLEXIBLE	STOR	STORAGE		
FLR	FLOOR	STRUCT	STRUCTURAL		
FRMG	FRAMING	SUB	SUBSTITUTE		
FURG	FURRING	SUSP	SUSPENDED		
GALV	GALVANIZED	T	TREAD		
GALV STL	GALVANIZED STEEL	T&G	TONGUE AND GROOVE		
GB	GRAB BAR	TEL	TELEPHONE		
GL	GLASS	THK	THICKNESS		
GLZ	GLAZING	THRES	THRESHOLD		
GRAN	GRANITE	TMPD GL	TEMPERED GLASS		
GT	GREASE TRAP	TS	TUBE STEEL		
GYP BD	GYP SUM BOARD	TV	TELEVISION		
		TYP	TYPICAL		
HC	HANDICAP	UC	UNDERCUT		
HCP	HANDICAPPED	UGND	UNDERGROUND		
HCDW	HOLLOW CORE WOOD DOOR	UNFIN	UNFINISHED		
HDR	HEADER	UNO	UNLESS NOTED OTHERWISE		
HDW	HARDWARE	UR	URNAL		
HDWD	HARDWOOD				
HM	HOLLOW METAL	VCT	VINYL COMPOSITION TILE		
HORIZ	HORIZONTAL	VERT	VERTICAL		
HT	HEIGHT	VEST	VESTIBULE		
		VWC	VINYL WALL COVERING		
ID	INSIDE DIAMETER	VWF	VINYL WALL FABRIC		
INFO	INFORMATION				
INSUL	INSULATION	W	WIDE		
INT	INTERIOR	W/	WITH		
J-BOX	JUNCTION BOX	W/O	WITHOUT		
JAN	JANITOR	WD	WOOD		
		WP	WATERPROOFING		
KIT	KITCHEN	WSCT	WAINSCOT		
KO	KNOCKOUT	WT	WEIGHT		

SYMBOLS	
	CALLOUT INDICATOR
	ELEVATION IDENTIFIER
	EXTERIOR ELEVATION INDICATOR
	INTERIOR ELEVATION INDICATOR
	SECTION IDENTIFIER
	GRID INDICATOR
	KEYNOTE INDICATOR
	MATCH LINE INDICATOR
	NORTH INDICATOR
	REVISION INDICATOR
	ROOM IDENTIFIER

DEMOLITION PLAN LEGEND	
	EXISTING TO REMAIN
	EXISTING TO BE DEMOLISHED
	EXISTING DOOR TO BE DEMOLISHED. REFER DOOR SCHEDULE FOR EXISTING FRAMES TO REMAIN
	FLOOR TO BE DEMOLISHED
	CEILING TO BE DEMOLISHED
	KEYNOTE INDICATOR


FLOOR PLAN LEGEND	
	EXISTING WALLS AND PARTITIONS
	NEW WALLS AND PARTITIONS
	DOOR IDENTIFIER
	ROOM IDENTIFIER
	WALL TYPE INDICATOR

CEILING PLAN LEGEND	
	EXISTING SUSPENDED CEILING
	NEW 2' x 2' SUSPENDED CEILING
	NEW GYPSUM CEILING
	NEW LAY-IN LIGHT FIXTURE
	NEW RECESSED LIGHT FIXTURE
	NEW VANITY LIGHT FIXTURE
	OCCUPANCY SENSOR
	EMERGENCY LIGHT
	MATERIAL CEILING INDICATOR HEIGHT
	ROOM IDENTIFIER
	NEW EXHAUST GRILLE; RE: MECH
	PARTITION TYPE A, EXTENDS TO BOTTOM OF CEILING GRID; RE: FLOOR PLANS FOR LOCATIONS


ROOM FINISH LEGEND	
ROOM IDENTIFIER AND FINISH INDICATOR	
	ROOM NUMBER
	ROOM NAME
	WALL FINISH
	BASE FINISH
	FLOOR FINISH
	FINISH NOTES
	KEYNOTE INDICATOR
	TRANSITION INDICATOR
	T1
	LV1
	ALT1
	ALT2
	NOT IN SCOPE

MOUNTING HEIGHT AND CLEARANCE LEGEND	
WALL MOUNTED MIRROR	
TITLE	
1. THE ACCESSIBLE CRITERIA INDICATED HERE ARE IN COMPLIANCE WITH THE ADA STANDARDS FOR ACCESSIBLE DESIGN 2010 AND ICC/ANSI A117.1-2003.	
2. ALL FIXTURES AND ACCESSORIES TO COMPLY WITH THESE STANDARDS UNLESS NOTED OTHERWISE.	
3. FLUSH CONTROLS SHALL BE LOCATED ON THE OPEN SIDE OF THE WATER CLOSET. IN AMBULATORY ACCESSIBLE COMPARTMENTS, FLUSH CONTROLS SHALL BE PERMITTED TO BE LOCATED ON EITHER SIDE OF THE WATER CLOSET.	
4. GRAPHICS ARE PROVIDED AS REFERENCE FOR STANDARD MOUNTING HEIGHTS AND MAY NOT BE ACCURATE FOR ACTUAL PRODUCTS SELECTED FOR PROJECT.	

ISSUES / REVISIONS	
03/29/2023	ISSUE FOR CONSTRUCTION

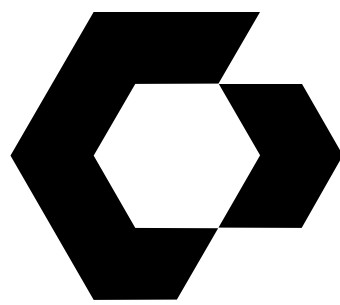

CYNERGY
810 S CINCINNATI AVE, STE 200
TULSA, OK 74119
918.577.5000

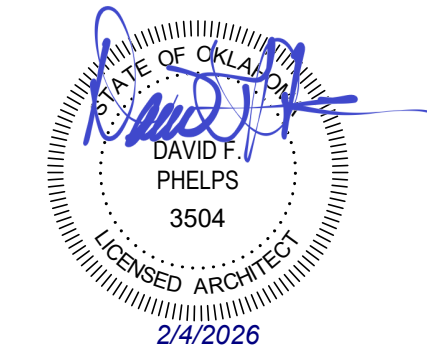

DAVID F. PHELPS, AIA
ARCHITECT OF RECORD

HARRILL-DOBSON INTERIOR
UPGRADES
NORTHEASTERN OKLAHOMA A&M COLLEGE
2001 STREET/NORTHEAST
MARIETTA, OK 74554

THIS DRAWING WAS PREPARED SOLELY AND EXCLUSIVELY FOR EXECUTION OF THE PROJECT IDENTIFIED WITHIN THESE DOCUMENTS. IT IS THE PROPERTY OF THE ARCHITECT. NO PART OF THIS DRAWING MAY BE REPRODUCED OR TRANSMITTED IN ANY FORM OR BY ANY MEANS, ELECTRONIC OR MECHANICAL, WITHOUT THE WRITTEN CONSENT OF THE ARCHITECT. THE ARCHITECT AND THE ARCHITECT'S CONSULTANTS ARE THE AUTHORS AND OWNERS OF THEIR RESPECTIVE DRAWINGS AND SPECIFICATIONS, AND RETAIN ALL COMMON LAW, STATUTORY, AND OTHER RIGHTS, INCLUDING COPYRIGHTS.

ISSUES / REVISIONS		
03/29/2023	ISSUE FOR CONSTRUCTION	
1	02/04/2026	ASI 2

ISSUE DATE: 03/29/2023
CHECKED BY: EW
DRAWN BY: JD

SHEET NAME:
FIRST FLOOR DEMOLITION
PLAN

SHEET NUMBER

AD101

DEMOLITION PLAN LEGEND

- EXISTING TO REMAIN
- EXISTING TO BE DEMOLISHED
- EXISTING DOOR TO BE DEMOLISHED. REFER DOOR SCHEDULE FOR EXISTING FRAMES TO REMAIN
- FLOOR TO BE DEMOLISHED
- CEILING TO BE DEMOLISHED
- KEYNOTE INDICATOR

ALTERNATES

- ALTERNATE 1**
- REMOVE CORRIDOR AND DORM ROOM WALL BASE IN ITS ENTIRETY. PREPARE EXISTING FLOORING FOR NEW LVT FLOORING AND RUBBER BASE INSTALLATION. RE: GENERAL DEMO NOTE 8.
- INSTALL NEW FLOORING ON TOP OF EXISTING FLOORING MATERIAL. LVT1 AND RUBBER BASE RB1. IN HARRILL AND DOBSON CORRIDORS PER MANUFACTURER'S WRITTEN INSTRUCTIONS. CONTRACTOR TO INSTALL APPROPRIATE FLOORING TRANSITION STRIP BETWEEN NEW LVT AND ADJACENT FLOOR FINISHES PER MANUFACTURER'S WRITTEN INSTRUCTIONS. PAINT WALLS PT1.
- ALTERNATE 2**
- DEMOLITION AND INSTALLATION OF STAIR TREADS AND RISERS
- ALTERNATE 3**
- DEMOLITION AND UPDATES TO LOUNGE AREAS INCLUDING, BUT NOT LIMITED TO, DOORS, FLOORING AND WALL BASE, CASEWORK, AND WALL PAINT.
- ALTERNATE 4**
- VANITY AND MIRROR, M2, INSTALLATION IN RESTROOMS


GENERAL DEMO NOTES

- RE: 3/AD101 FOR TYPICAL RESTROOM DEMO PLAN
- RE: 4/AD101 FOR TYPICAL LOUNGE DEMO PLAN
- CONTRACTOR TO FIELD VERIFY ALL EXISTING CONDITIONS AND REPORT DIFFERENCES BETWEEN DRAWINGS AND ACTUAL FIELD CONDITIONS TO THE ARCHITECT FOR RESOLUTION
- WORK SHALL BE PERFORMED IN STRICT ACCORDANCE WITH ALL FEDERAL, STATE, AND LOCAL CODES AND ORDINANCES
- CONTRACTOR TO PROVIDE APPROPRIATE PROTECTION BETWEEN AREAS OF CONSTRUCTION AND EXISTING SPACES
- REFER TO MECHANICAL FOR MECHANICAL DEMOLITION INFORMATION
- REFER TO PLUMBING FOR PLUMBING DEMOLITION INFORMATION
- HAZARDOUS MATERIALS ARE SUSPECTED AT THE JOB SITE IN THE FORM OF ASBESTOS CONTAINING MATERIALS (ACM). THERE IS SUSPECT FLOOR TILE AND/OR MASTIC MATERIAL THAT MAY REQUIRE FURTHER IDENTIFICATION AND TESTING FOR CONTENT OF ASBESTOS. SHOULD THIS MATERIAL BE IDENTIFIED AS PRESENT, IT IS RECOMMENDED THAT PROPER ABATEMENT PROCEDURES BE FOLLOWED AS APPROPRIATE. CONTRACTOR TO PROVIDE ASBESTOS REVIEW PRIOR TO BEGINNING WORK. CONTRACTOR SHALL MAKE IDENTIFIED AREAS READY FOR NEW CONSTRUCTION AND APPLICATION OF NEW FINISHES ACCORDINGLY.


DEMO KEYNOTES

- ACCESSORIES**
- A1** REMOVE SHOWER STALLS IN THEIR ENTIRETY
- A2** REMOVE WALL MIRRORS IN THEIR ENTIRETY
- A3** REMOVE TOILET PARTITIONS IN THEIR ENTIRETY
- A4** REMOVE AND SALVAGE TOILET ACCESSORIES: TOILET TISSUE DISPENSERS, SOAP DISPENSERS, WASTE RECEPTACLES, HAND DRYERS, SHOWER CURTAINS/RODS. CONTRACTOR TO PROTECT DURING DEMOLITION; COORDINATE STORAGE LOCATION WITH OWNER.
- CEILING**
- C1** REMOVE ACT CEILING IN ITS ENTIRETY
- DOOR**
- D1** REMOVE DOOR; HOLLOW METAL FRAME IS EXISTING TO REMAIN
- ELECTRICAL**
- E1** REMOVE ALL ELECTRICAL COMPONENTS AT VANITY ADJACENT TO TOILETS, INCLUDING BUT NOT LIMITED TO: LIGHT FIXTURE, RECEPTACLES, RACEWAYS, AND BOXES. CONTRACTOR SHALL REMOVE BRANCH CIRCUIT CONDUCTORS AND CONDUIT BACK TO THE FIRST AVAILABLE JUNCTION BOX, OR PROVIDE NEW JUNCTION BOX(ES) AS REQUIRED.
- FINISHES**
- F1** REMOVE FLOOR TILE AND FLOORING TRANSITION IN THEIR ENTIRETY; PREP FLOOR FOR NEW FLOOR TILE INSTALLATION
- F2** REMOVE WALL FINISH DOWN TO BARE STUDS. PREPARE FOR NEW WALL FINISH.
- F3** REMOVE TILE CURB. CONTRACTOR TO DETERMINE IF SELF LEVELER COMPOUND IS NEEDED TO ENSURE ALL FLOOR AREAS ARE LEVEL. RAISE FLOOR DRAINS IF NECESSARY.
- F4** REMOVE STAIR TREADS/RISERS, LANDING FLOORING MATERIAL, RESILIENT STRINGER MATERIAL AND WALL BASE. PREPARE FOR NEW STAIR TREADS/RISERS, LANDING FLOORING MATERIAL, RESILIENT STRINGER MATERIAL AND WALL BASE.
- LIGHTING**
- L1** REMOVE WALL LIGHTING OVER MIRRORS IN ITS ENTIRETY
- L2** REMOVE LAY-IN LIGHTING IN ITS ENTIRETY
- L3** REMOVE AND SALVAGE LOUNGE LAY-IN LIGHTING. CONTRACTOR TO PROTECT DURING DEMOLITION.
- MILLWORK**
- M1** REMOVE MILLWORK IN ITS ENTIRETY
- PLUMBING FIXTURES**
- P1** REMOVE EXISTING WATERCLOSETS
- P2** REMOVE EXISTING LAVATORIES
- P3** REMOVE SHOWER FIXTURES
- P4** REMOVE SINK
- WALLS**
- W1** REMOVE GYPSUM WALL BUMP-OUT IN ITS ENTIRETY, INCLUDING MIRROR AND WOOD TRIM.
- W2** REMOVE PART OF EXISTING CMU WALL FOR PLUMBING INSTALLATION. SAWCUT AND SUPPORT DURING CONSTRUCTION. RE: SA-101
- W3** REMOVE CHASE ACCESS PANEL AND INFILL WALL. PREPARE INFILL PORTION OF WALL FOR WALL TILE INSTALLATION.


1 FIRST FLOOR DEMO PLAN - HARRILL
1/8" = 1'-0"

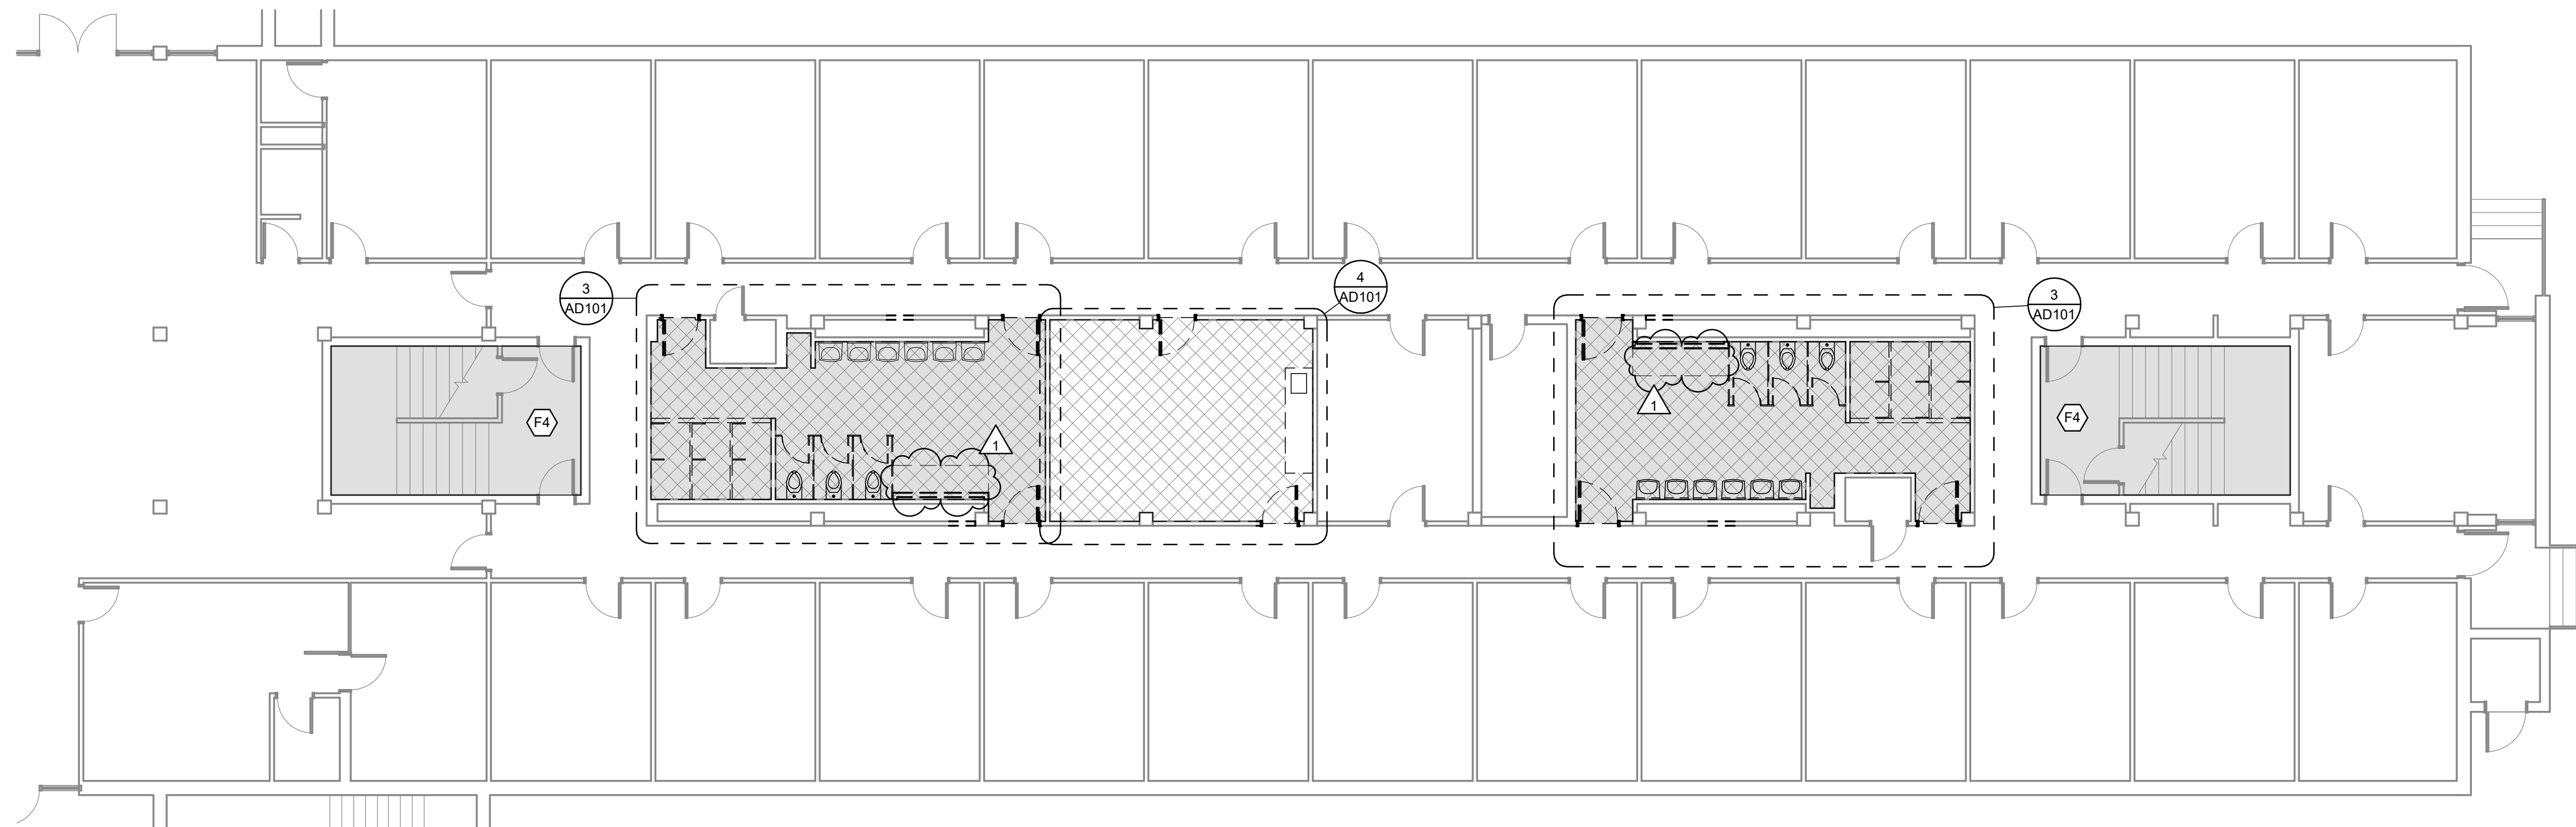


2 FIRST FLOOR DEMO PLAN - DOBSON
1/8" = 1'-0"

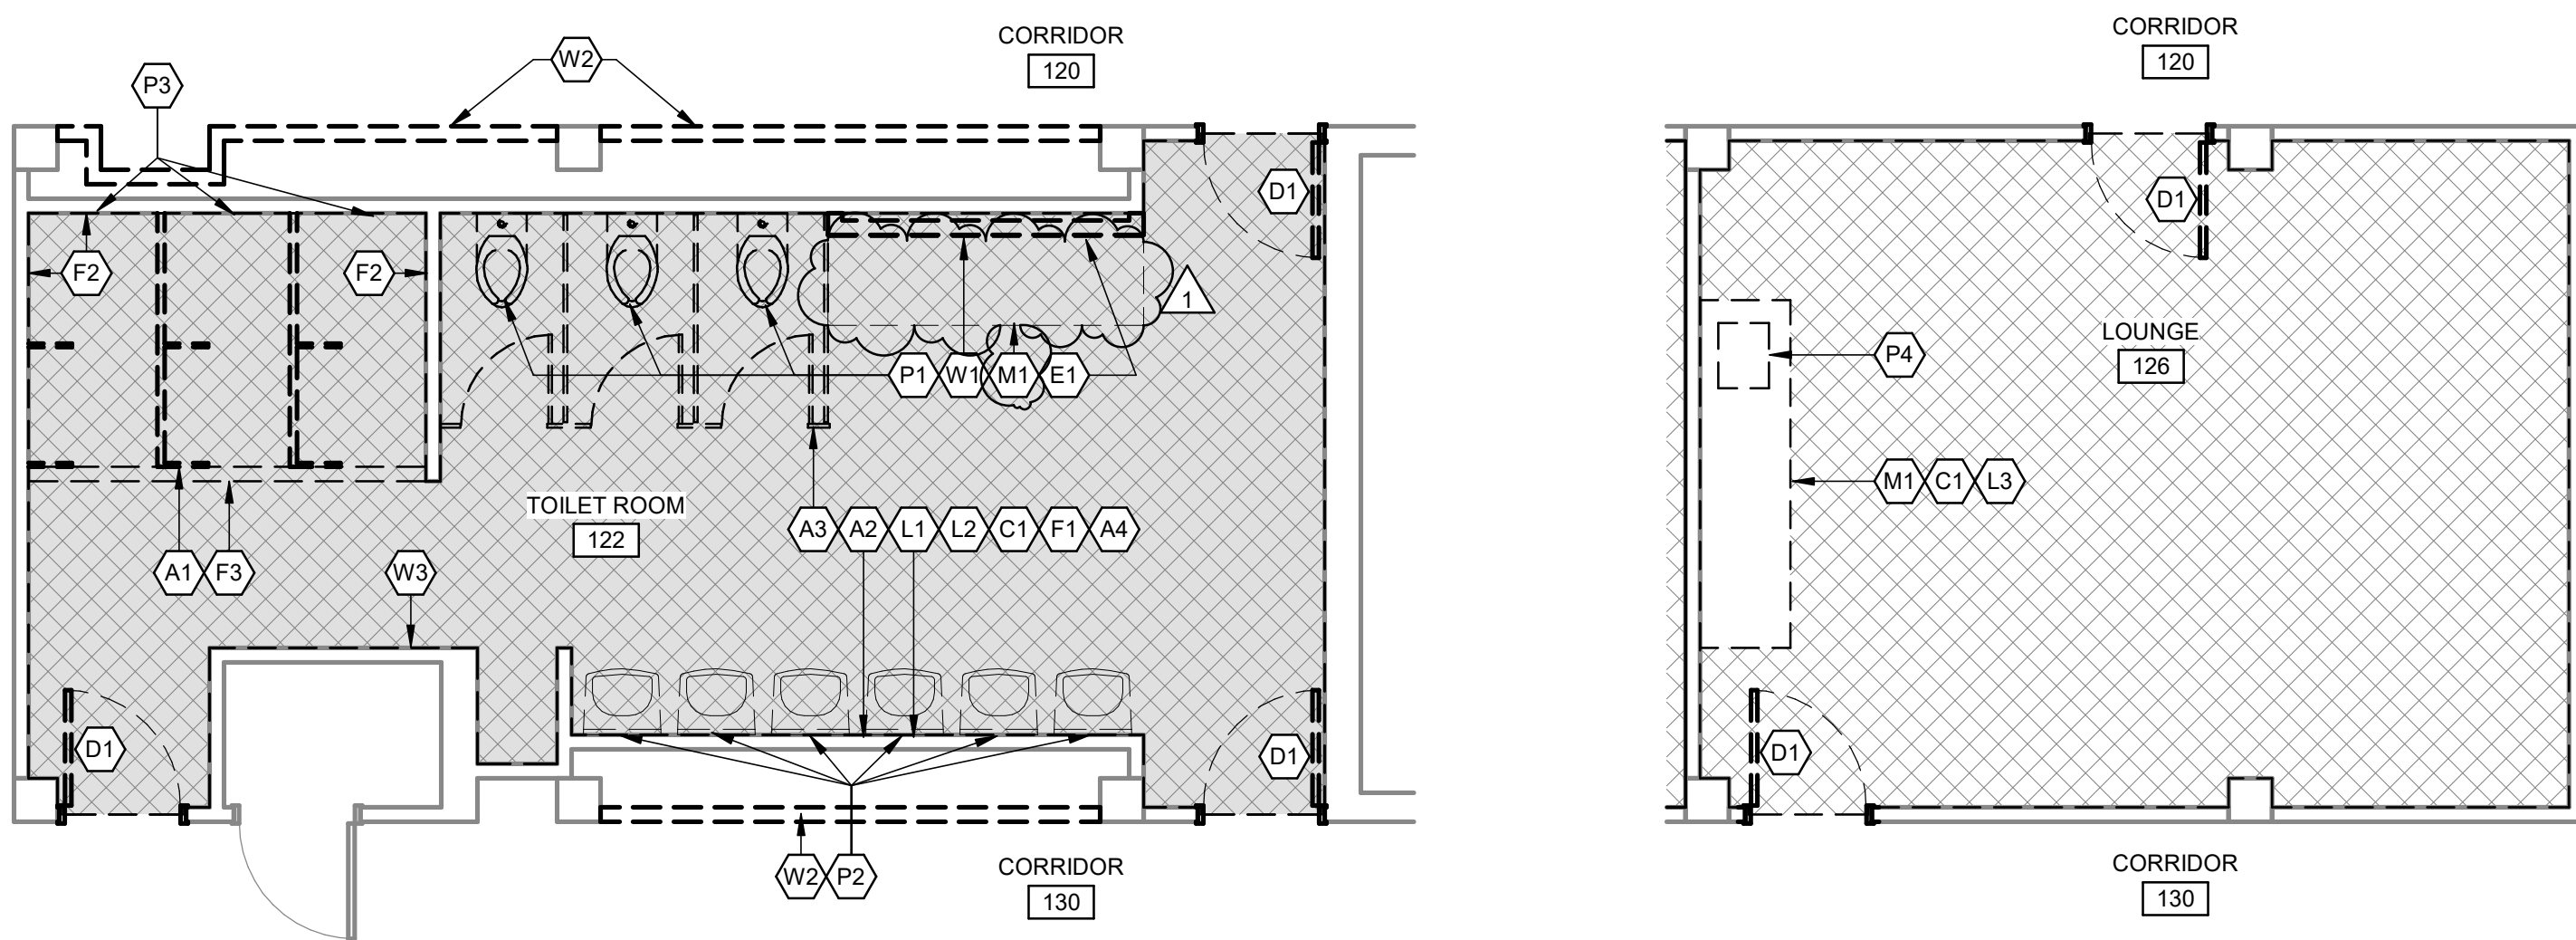


3 TYPICAL RESTROOM DEMO PLAN
1/4" = 1'-0"

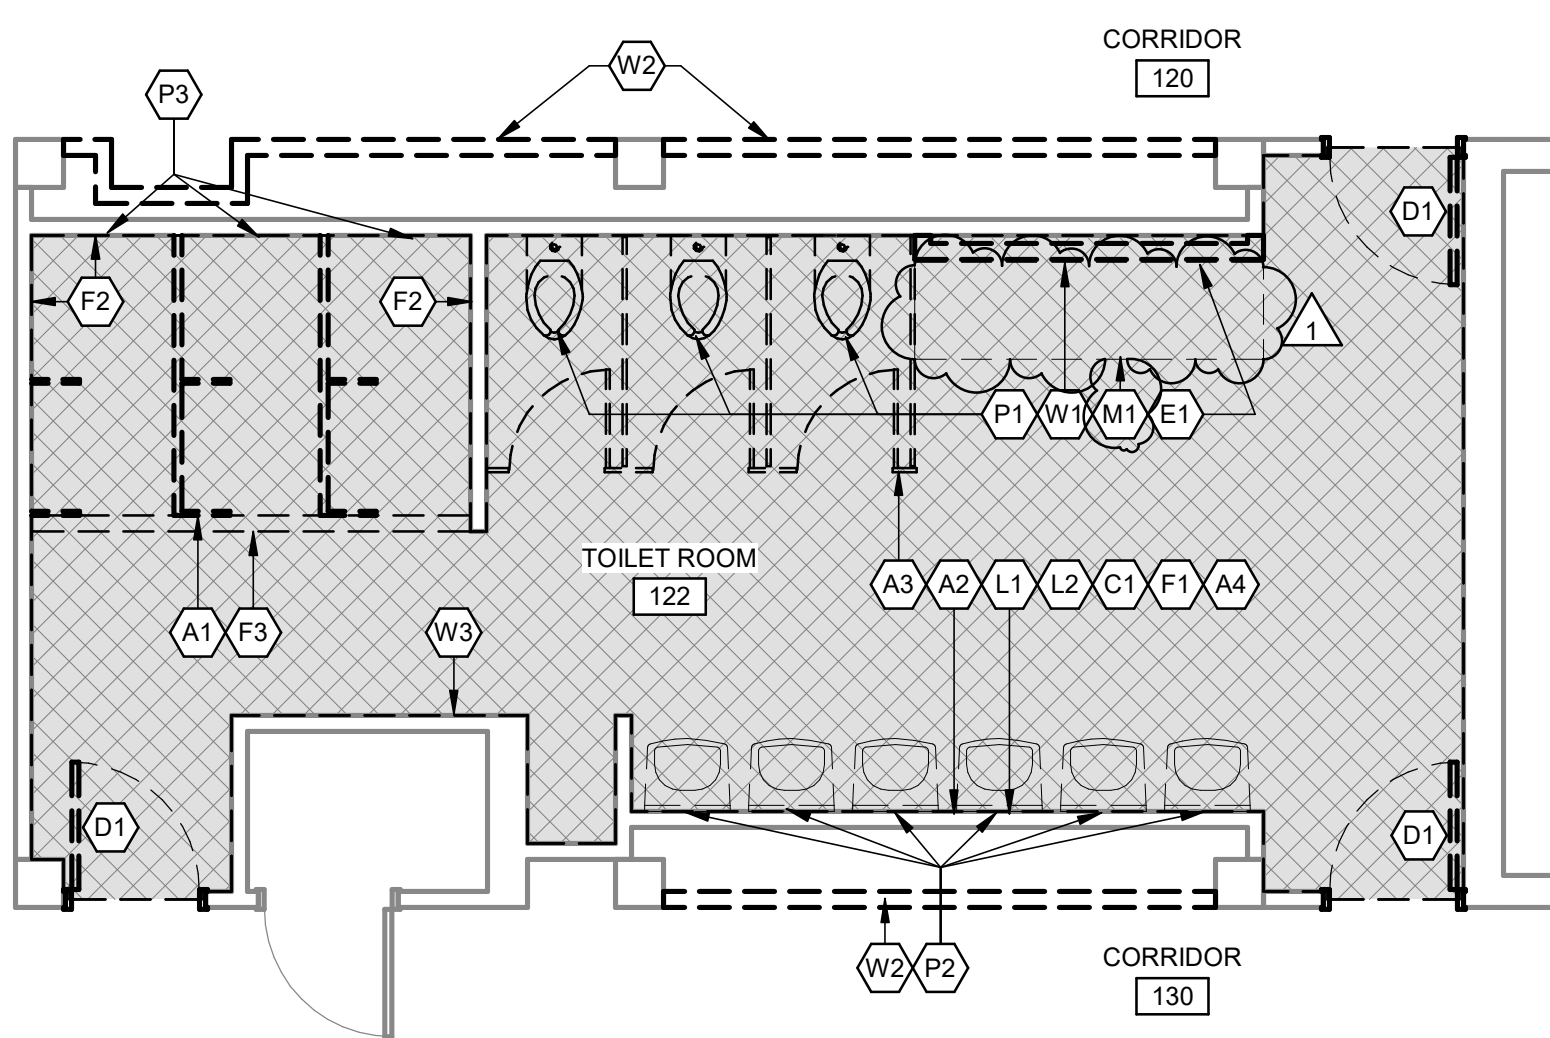

4 TYPICAL LOUNGE DEMO PLAN
1/4" = 1'-0"

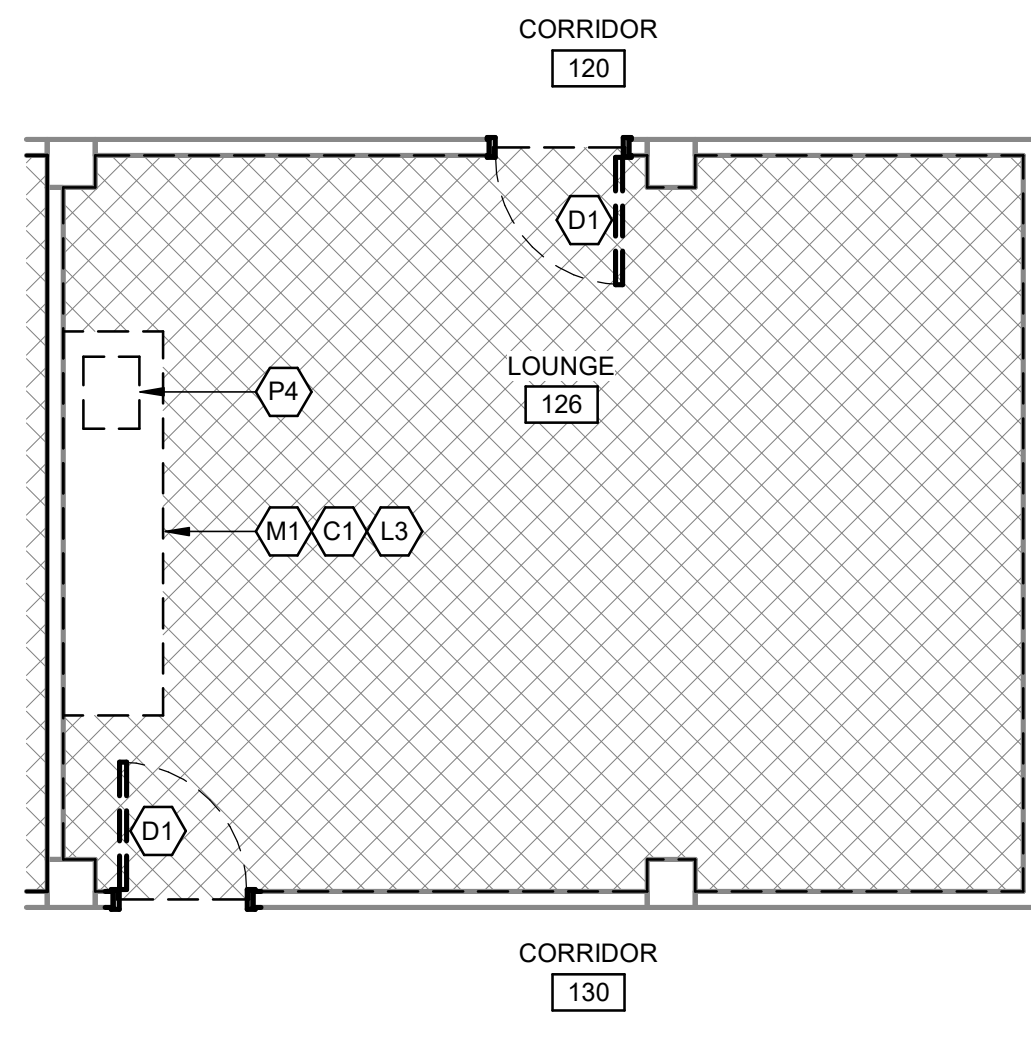

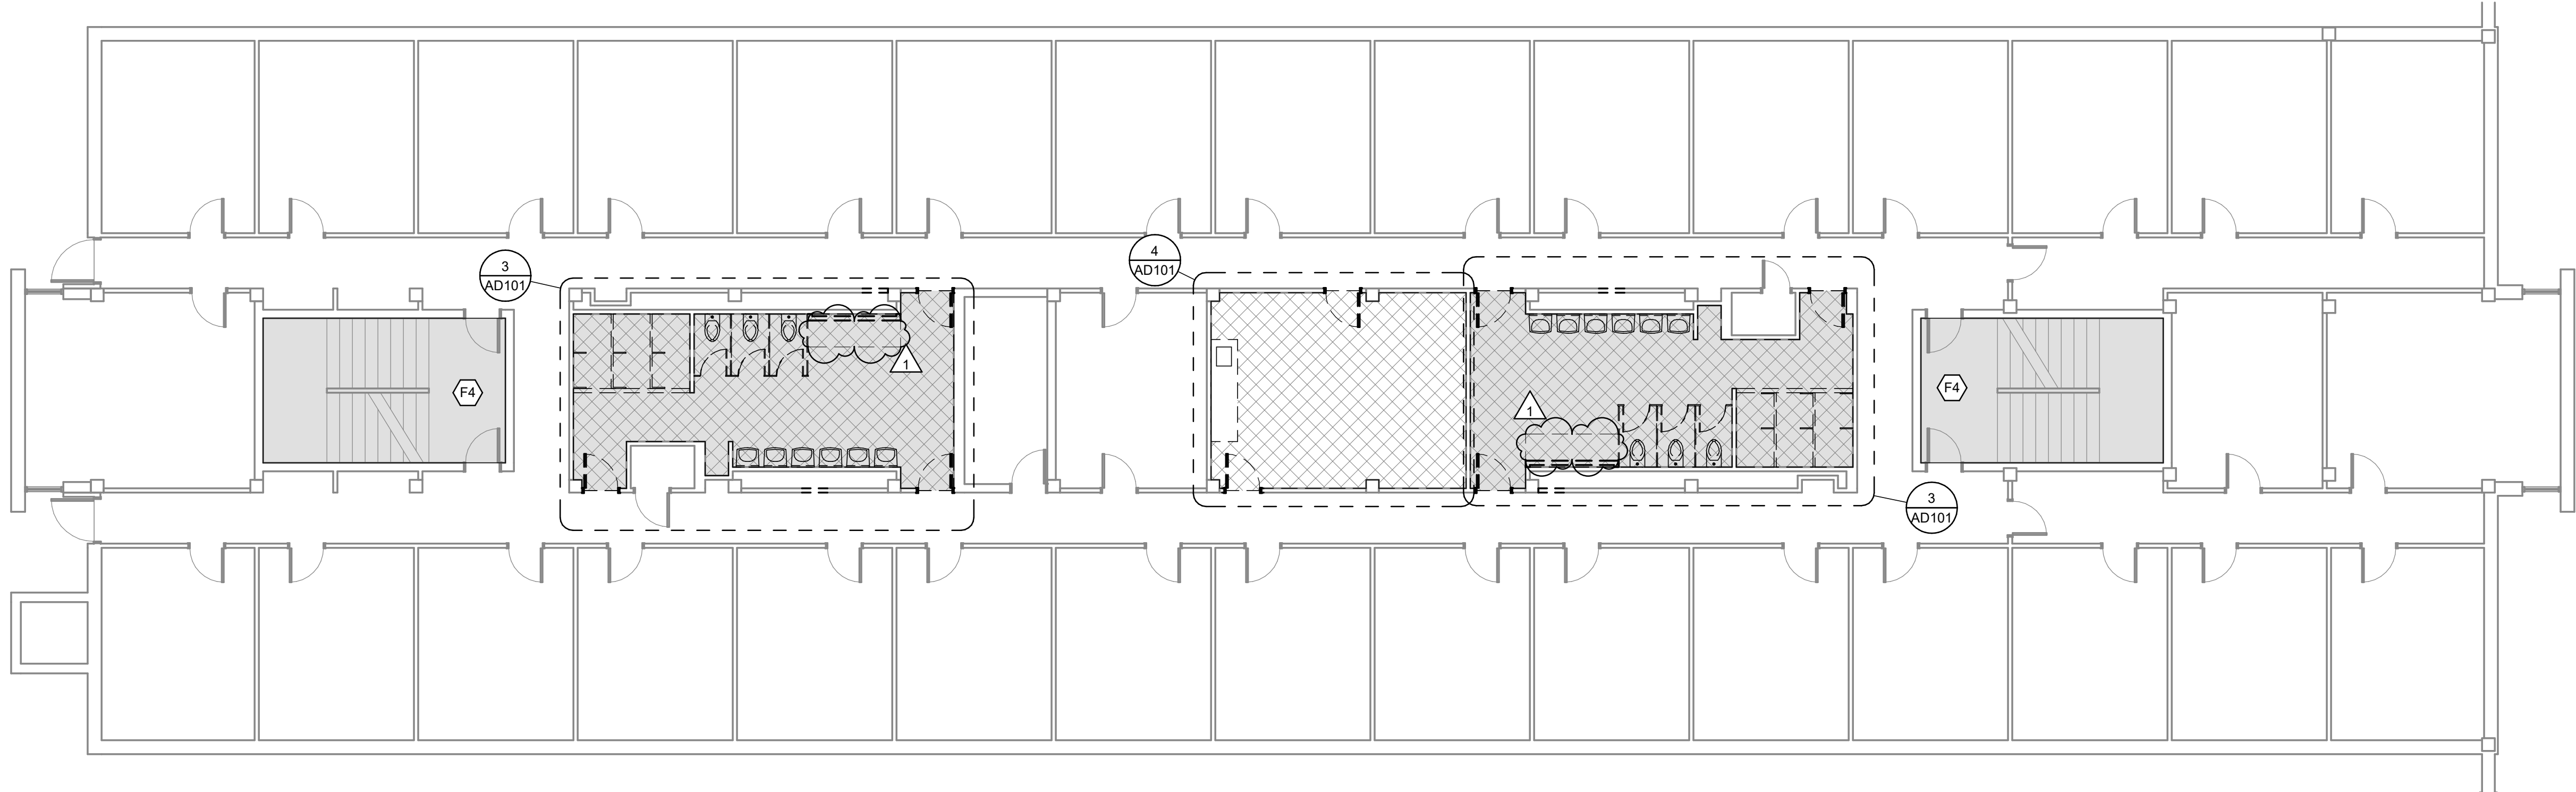

1 SECOND FLOOR DEMO PLAN - HARRILL
1/8" = 1'-0"

DEMOLITION PLAN LEGEND

- EXISTING TO REMAIN
- EXISTING TO BE DEMOLISHED
- EXISTING DOOR TO BE DEMOLISHED. REFER DOOR SCHEDULE FOR EXISTING FRAMES TO REMAIN
- FLOOR TO BE DEMOLISHED
- CEILING TO BE DEMOLISHED
- KEYNOTE INDICATOR

ALTERNATES


- ALTERNATE 1**
REMOVE CORRIDOR AND DORM ROOM WALL BASE IN ITS ENTIRETY. PREPARE EXISTING FLOORING FOR NEW LVT FLOORING AND RUBBER BASE INSTALLATION. RE: GENERAL DEMO NOTE 8.
- INSTALL NEW FLOORING ON TOP OF EXISTING FLOORING MATERIAL. LVT1 AND RUBBER BASE RB1. IN HARRILL AND DOBSON CORRIDORS PER MANUFACTURER'S WRITTEN INSTRUCTIONS. CONTRACTOR TO INSTALL APPROPRIATE FLOORING TRANSITION STRIP BETWEEN NEW LVT AND ADJACENT FLOOR FINISHES PER MANUFACTURER'S WRITTEN INSTRUCTIONS. PAINT WALLS PT1.
- ALTERNATE 2**
DEMOLITION AND INSTALLATION OF STAIR TREADS AND RISERS
- ALTERNATE 3**
DEMOLITION AND UPDATES TO LOUNGE AREAS INCLUDING, BUT NOT LIMITED TO, DOORS, FLOORING AND WALL BASE, CASEWORK, AND WALL PAINT.
- ALTERNATE 4**
VANITY AND MIRROR, M2, INSTALLATION IN RESTROOMS

GENERAL DEMO NOTES


- RE: 3/AD101 FOR TYPICAL RESTROOM DEMO PLAN
- RE: 4/AD101 FOR TYPICAL LOUNGE DEMO PLAN
- CONTRACTOR TO FIELD VERIFY ALL EXISTING CONDITIONS AND REPORT DIFFERENCES BETWEEN DRAWINGS AND ACTUAL FIELD CONDITIONS TO THE ARCHITECT FOR RESOLUTION.
- WORK SHALL BE PERFORMED IN STRICT ACCORDANCE WITH ALL FEDERAL, STATE, AND LOCAL CODES AND ORDINANCES.
- CONTRACTOR TO PROVIDE APPROPRIATE PROTECTION BETWEEN AREAS OF CONSTRUCTION AND EXISTING SPACES.
- REFER TO MECHANICAL FOR MECHANICAL DEMOLITION INFORMATION.
- REFER TO PLUMBING FOR PLUMBING DEMOLITION INFORMATION.
- HAZARDOUS MATERIALS ARE SUSPECTED AT THE JOB SITE IN THE FORM OF ASBESTOS CONTAINING MATERIALS (ACM). THERE IS SUSPECT FLOOR TILE AND/OR MASTIC MATERIAL THAT MAY REQUIRE FURTHER IDENTIFICATION AND TESTING FOR CONTENT OF ASBESTOS. SHOULD THIS MATERIAL BE IDENTIFIED AS PRESENT, IT IS RECOMMENDED THAT PROPER ABATEMENT PROCEDURES BE FOLLOWED AS APPROPRIATE. CONTRACTOR TO PROVIDE ASBESTOS REVIEW PRIOR TO BEGINNING WORK. CONTRACTOR SHALL MAKE IDENTIFIED AREAS READY FOR NEW CONSTRUCTION AND APPLICATION OF NEW FINISHES ACCORDINGLY.

DEMO KEYNOTES


- ACCESSORIES**
A1 REMOVE SHOWER STALLS IN THEIR ENTIRETY
A2 REMOVE WALL MIRRORS IN THEIR ENTIRETY
A3 REMOVE TOILET PARTITIONS IN THEIR ENTIRETY
A4 REMOVE AND SALVAGE TOILET ACCESSORIES: TOILET TISSUE DISPENSERS, SOAP DISPENSERS, WASTE RECEPTACLES, HAND DRYERS, SHOWER CURTAINS/RODS. CONTRACTOR TO PROTECT DURING DEMOLITION. COORDINATE STORAGE LOCATION WITH OWNER.
- CEILING**
C1 REMOVE ACT CEILING IN ITS ENTIRETY
- DOOR**
D1 REMOVE DOOR; HOLLOW METAL FRAME IS EXISTING TO REMAIN
- ELECTRICAL**
E1 REMOVE ALL ELECTRICAL COMPONENTS AT VANITY ADJACENT TO TOILETS, INCLUDING BUT NOT LIMITED TO: LIGHT FIXTURE, RECEPTACLES, RACEWAYS, AND BOXES. CONTRACTOR SHALL REMOVE BRANCH CIRCUIT CONDUCTORS AND CONDUIT BACK TO THE FIRST AVAILABLE JUNCTION BOX, OR PROVIDE NEW JUNCTION BOX(ES) AS REQUIRED.
- FINISHES**
F1 REMOVE FLOOR TILE AND FLOORING TRANSITION IN THEIR ENTIRETY; PREP FLOOR FOR NEW FLOOR TILE INSTALLATION
F2 REMOVE WALL FINISH DOWN TO BARE STUDS. PREPARE FOR NEW WALL FINISH.
F3 REMOVE TILED CURB. CONTRACTOR TO DETERMINE IF SELF LEVELER COMPOUND IS NEEDED TO ENSURE ALL FLOOR AREAS ARE LEVEL. RAISE FLOOR DRAINS IF NECESSARY.
F4 REMOVE STAIR TREADRISERS, LANDING FLOORING MATERIAL, RESILIENT STRINGER MATERIAL AND WALL BASE. PREPARE FOR NEW STAIR TREADRISERS, LANDING FLOORING MATERIAL, RESILIENT STRINGER MATERIAL AND WALL BASE.
- LIGHTING**
L1 REMOVE WALL LIGHTING OVER MIRRORS IN ITS ENTIRETY
L2 REMOVE LAY-IN LIGHTING IN ITS ENTIRETY
L3 REMOVE AND SALVAGE LOUNGE LAY-IN LIGHTING. CONTRACTOR TO PROTECT DURING DEMOLITION.
- MILLWORK**
M1 REMOVE MILLWORK IN ITS ENTIRETY
- PLUMBING FIXTURES**
P1 REMOVE EXISTING WATERCLOSSES
P2 REMOVE EXISTING LAVATORIES
P3 REMOVE SHOWER FIXTURES
P4 REMOVE SINK
- WALLS**
W1 REMOVE GYPSUM WALL BUMPOUT IN ITS ENTIRETY, INCLUDING MIRROR AND WOOD TRIM.
W2 REMOVE PART OF EXISTING CMU WALL FOR PLUMBING INSTALLATION. SAWCUT AND SUPPORT DURING CONSTRUCTION. RE: SA-A-101
W3 REMOVE CHASE ACCESS PANEL AND INFILL WALL. PREPARE INFILLED PORTION OF WALL FOR WALL TILE INSTALLATION.

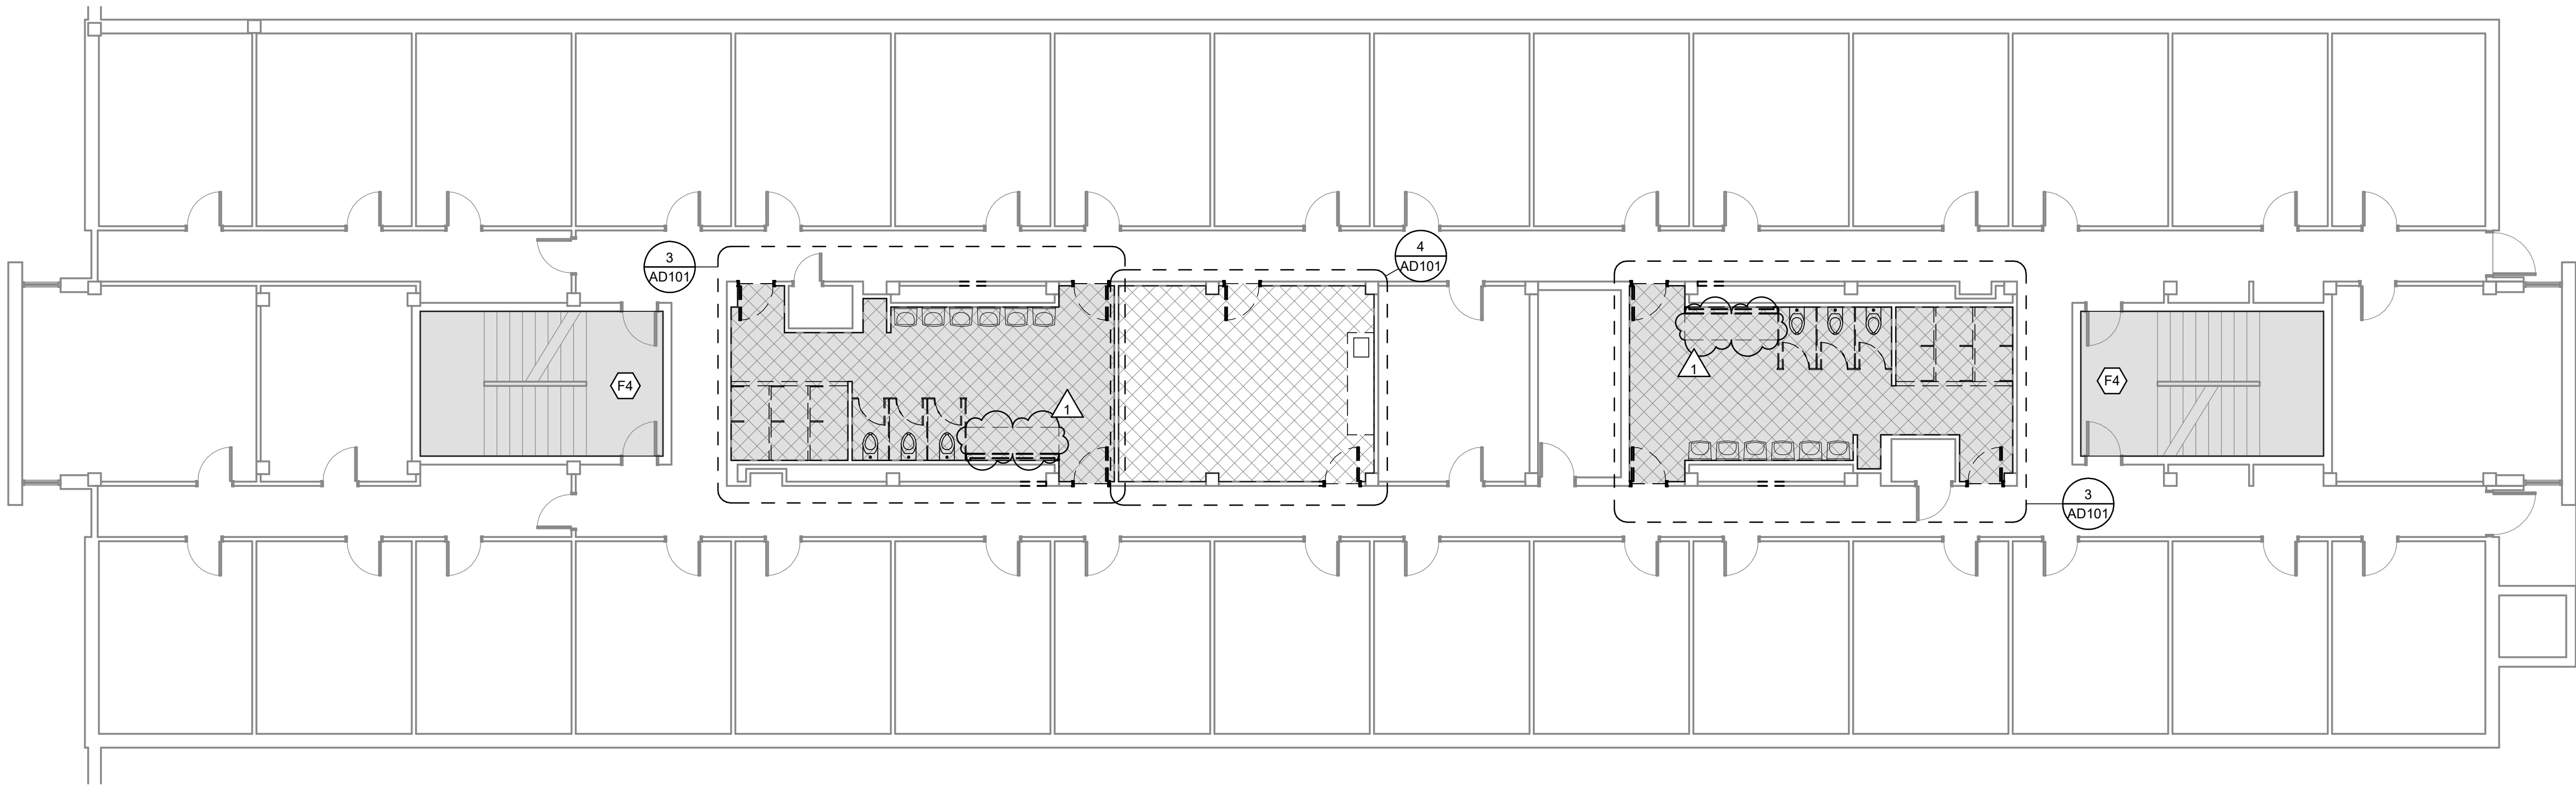

2 SECOND FLOOR DEMO PLAN - DOBSON
1/8" = 1'-0"

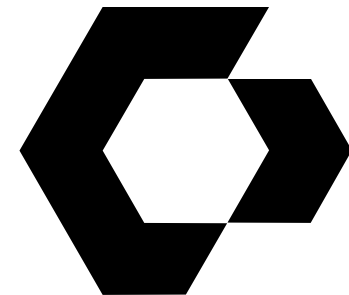

CYNERGY
810 S CINCINNATI AVE, STE 200
TULSA, OK 74119
918.577.6000

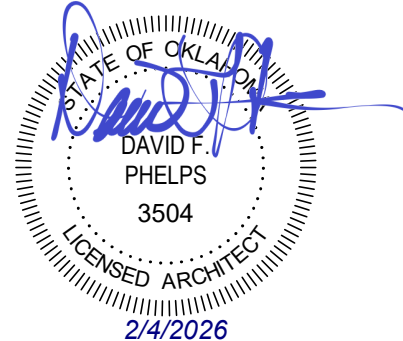

DAVID F. PHELPS, AIA
ARCHITECT OF RECORD

**HARRILL-DOBSON INTERIOR
UPGRADES**
NORTHEASTERN OKLAHOMA A&M COLLEGE
2001 STREET NORTHEAST
MARIETTA, OK 74504

THIS DRAWING WAS PREPARED SOLELY AND EXCLUSIVELY FOR EXECUTION OF THE PROJECT IDENTIFIED WITHIN THESE DOCUMENTS. IT IS THE PROPERTY OF THE ARCHITECT AND THIS DRAWING MAY NOT BE USED ON OTHER PROJECTS OR FOR ADDITIONS TO THE PROJECT OUTSIDE THE SCOPE OF WORK WITHOUT WRITTEN CONSENT OF THE OWNER, ARCHITECT, AND THE ARCHITECT'S CONSULTANTS. THE ARCHITECT AND THE ARCHITECT'S CONSULTANTS ARE THE AUTHORS AND OWNERS OF THEIR RESPECTIVE DRAWINGS AND SPECIFICATIONS, AND RETAIN ALL COMMON LAW, STATUTORY, AND OTHER RIGHTS, INCLUDING COPYRIGHTS.


ISSUES / REVISIONS		
1	03/29/2023	ISSUE FOR CONSTRUCTION
	02/04/2026	ASI 2

ISSUE DATE: 03/29/2023
CHECKED BY: EW
DRAWN BY: JD


SHEET NAME
SECOND FLOOR DEMOLITION
PLAN

SHEET NUMBER

AD102

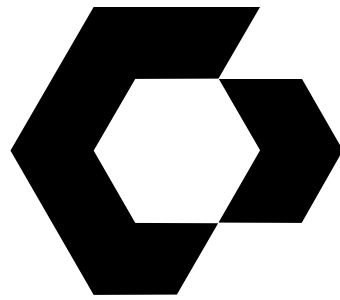

CYNERGY
810 S CINCINNATI AVE, STE 200
TULSA, OK 74119
918.577.5000

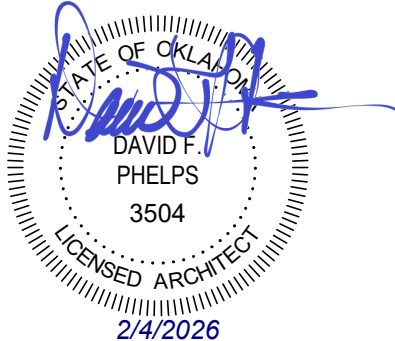

DAVID F. PHELPS, AIA
ARCHITECT OF RECORD

HARRILL-DOBSON INTERIOR
UPGRADES
NORTHEASTERN OKLAHOMA A&M COLLEGE
2001 STREET/NORTHEAST
MARIETTA, OK 74354

THIS DRAWING WAS PREPARED SOLELY AND EXCLUSIVELY FOR EXECUTION OF THE PROJECT IDENTIFIED WITHIN THESE DOCUMENTS. IT IS THE PROPERTY OF THE ARCHITECT AND THE ARCHITECT'S CONSULTANTS. THE ARCHITECT AND THE ARCHITECT'S CONSULTANTS ARE THE AUTHORS AND OWNERS OF THEIR RESPECTIVE DRAWINGS AND SPECIFICATIONS, AND RETAIN ALL COMMON LAW, STATUTORY, AND OTHER RIGHTS, INCLUDING COPYRIGHTS.

ISSUES / REVISIONS

NO.	DATE	DESCRIPTION
1	03/29/2023	ISSUE FOR CONSTRUCTION
2	02/04/2026	ASI 2

ISSUE DATE: 03/29/2023
CHECKED BY: EW
DRAWN BY: JD

SHEET NAME
THIRD FLOOR DEMOLITION
PLAN

SHEET NUMBER

AD103

DEMOLITION PLAN LEGEND

- EXISTING TO REMAIN
- EXISTING TO BE DEMOLISHED
- EXISTING DOOR TO BE DEMOLISHED. REFER DOOR SCHEDULE FOR EXISTING FRAMES TO REMAIN
- FLOOR TO BE DEMOLISHED
- CEILING TO BE DEMOLISHED
- KEYNOTE INDICATOR

ALTERNATES

ALTERNATE 1

REMOVE CORRIDOR AND DORM ROOM WALL BASE IN ITS ENTIRETY. PREPARE EXISTING FLOORING FOR NEW LVT FLOORING AND RUBBER BASE INSTALLATION. RE: GENERAL DEMO NOTE 8.

INSTALL NEW FLOORING ON TOP OF EXISTING FLOORING MATERIAL. LVT1 AND RUBBER BASE RB1. IN HARRILL AND DOBSON CORRIDORS PER MANUFACTURER'S WRITTEN INSTRUCTIONS. CONTRACTOR TO INSTALL APPROPRIATE FLOORING TRANSITION STRIP BETWEEN NEW LVT AND ADJACENT FLOOR FINISHES PER MANUFACTURER'S WRITTEN INSTRUCTIONS. PAINT WALLS PT1.

ALTERNATE 2

DEMOLITION AND INSTALLATION OF STAIR TREADS AND RISERS

ALTERNATE 3

DEMOLITION AND UPDATES TO LOUNGE AREAS INCLUDING, BUT NOT LIMITED TO, DOORS, FLOORING AND WALL BASE, CASEWORK, AND WALL PAINT.

ALTERNATE 4

VANITY AND MIRROR, M2, INSTALLATION IN RESTROOMS

GENERAL DEMO NOTES

- RE: 3/AD101 FOR TYPICAL RESTROOM DEMO PLAN
- RE: 4/AD101 FOR TYPICAL LOUNGE DEMO PLAN
- CONTRACTOR TO FIELD VERIFY ALL EXISTING CONDITIONS AND REPORT DIFFERENCES BETWEEN DRAWINGS AND ACTUAL FIELD CONDITIONS TO THE ARCHITECT FOR RESOLUTION
- WORK SHALL BE PERFORMED IN STRICT ACCORDANCE WITH ALL FEDERAL, STATE, AND LOCAL CODES AND ORDINANCES
- CONTRACTOR TO PROVIDE APPROPRIATE PROTECTION BETWEEN AREAS OF CONSTRUCTION AND EXISTING SPACES.
- REFER TO MECHANICAL FOR MECHANICAL DEMOLITION INFORMATION
- REFER TO PLUMBING FOR PLUMBING DEMOLITION INFORMATION
- HAZARDOUS MATERIALS ARE SUSPECTED AT THE JOB SITE IN THE FORM OF ASBESTOS CONTAINING MATERIALS (ACM). THERE IS SUSPECT FLOOR TILE AND/OR MASTIC MATERIAL THAT MAY REQUIRE FURTHER IDENTIFICATION AND TESTING FOR CONTENT OF ASBESTOS. SHOULD THIS MATERIAL BE IDENTIFIED AS PRESENT, IT IS RECOMMENDED THAT PROPER ABATEMENT PROCEDURES BE FOLLOWED AS APPROPRIATE. CONTRACTOR TO PROVIDE ASBESTOS REVIEW PRIOR TO BEGINNING WORK. CONTRACTOR SHALL MAKE IDENTIFIED AREAS READY FOR NEW CONSTRUCTION AND APPLICATION OF NEW FINISHES ACCORDINGLY.

DEMO KEYNOTES

ACCESSORIES

- A1 REMOVE SHOWER STALLS IN THEIR ENTIRETY
- A2 REMOVE WALL MIRRORS IN THEIR ENTIRETY
- A3 REMOVE TOILET PARTITIONS IN THEIR ENTIRETY
- A4 REMOVE AND SALVAGE TOILET ACCESSORIES: TOILET TISSUE DISPENSERS, SOAP DISPENSERS, WASTE RECEPTACLES, HAND DRYERS, SHOWER CURTAINS/RODS. CONTRACTOR TO PROTECT DURING DEMOLITION. COORDINATE STORAGE LOCATION WITH OWNER.

CEILING

- C1 REMOVE ACT CEILING IN ITS ENTIRETY

DOOR

- D1 REMOVE DOOR; HOLLOW METAL FRAME IS EXISTING TO REMAIN

ELECTRICAL

- E1 REMOVE ALL ELECTRICAL COMPONENTS AT VANITY ADJACENT TO TOILETS, INCLUDING BUT NOT LIMITED TO: LIGHT FIXTURE, RECEPTACLES, RACEWAYS, AND BOXES. CONTRACTOR SHALL REMOVE BRANCH CIRCUIT CONDUCTORS AND CONDUIT BACK TO THE FIRST AVAILABLE JUNCTION BOX, OR PROVIDE NEW JUNCTION BOX(ES) AS REQUIRED.

FINISHES

- F1 REMOVE FLOOR TILE AND FLOORING TRANSITION IN THEIR ENTIRETY; PREP FLOOR FOR NEW FLOOR TILE INSTALLATION
- F2 REMOVE WALL FINISH DOWN TO BARE STUDS. PREPARE FOR NEW WALL FINISH.
- F3 REMOVE TILED CURB. CONTRACTOR TO DETERMINE IF SELF LEVELER COMPOUND IS NEEDED TO ENSURE ALL FLOOR AREAS ARE LEVEL. RAISE FLOOR DRAINS IF NECESSARY.
- F4 REMOVE STAIR TREADRISERS, LANDING FLOORING MATERIAL, RESILIENT STRINGER MATERIAL AND WALL BASE. PREPARE FOR NEW STAIR TREADRISERS, LANDING FLOORING MATERIAL, RESILIENT STRINGER MATERIAL AND WALL BASE.

LIGHTING

- L1 REMOVE WALL LIGHTING OVER MIRRORS IN ITS ENTIRETY
- L2 REMOVE LAY-IN LIGHTING IN ITS ENTIRETY
- L3 REMOVE AND SALVAGE LOUNGE LAY-IN LIGHTING. CONTRACTOR TO PROTECT DURING DEMOLITION.

MILLWORK


- M1 REMOVE MILLWORK IN ITS ENTIRETY

PLUMBING FIXTURES


- P1 REMOVE EXISTING WATERCLOSETS
- P2 REMOVE EXISTING LAVATORIES
- P3 REMOVE SHOWER FIXTURES
- P4 REMOVE SINK

WALLS


- W1 REMOVE GYPSUM WALL BUMPOUT IN ITS ENTIRETY, INCLUDING MIRROR AND WOOD TRIM.
- W2 REMOVE PART OF EXISTING CMU WALL FOR PLUMBING INSTALLATION. SAWCUT AND SUPPORT DURING CONSTRUCTION. RE: SA-A-101
- W3 REMOVE CHASE ACCESS PANEL AND INFILL WALL. PREPARE INFILLED PORTION OF WALL FOR WALL TILE INSTALLATION.

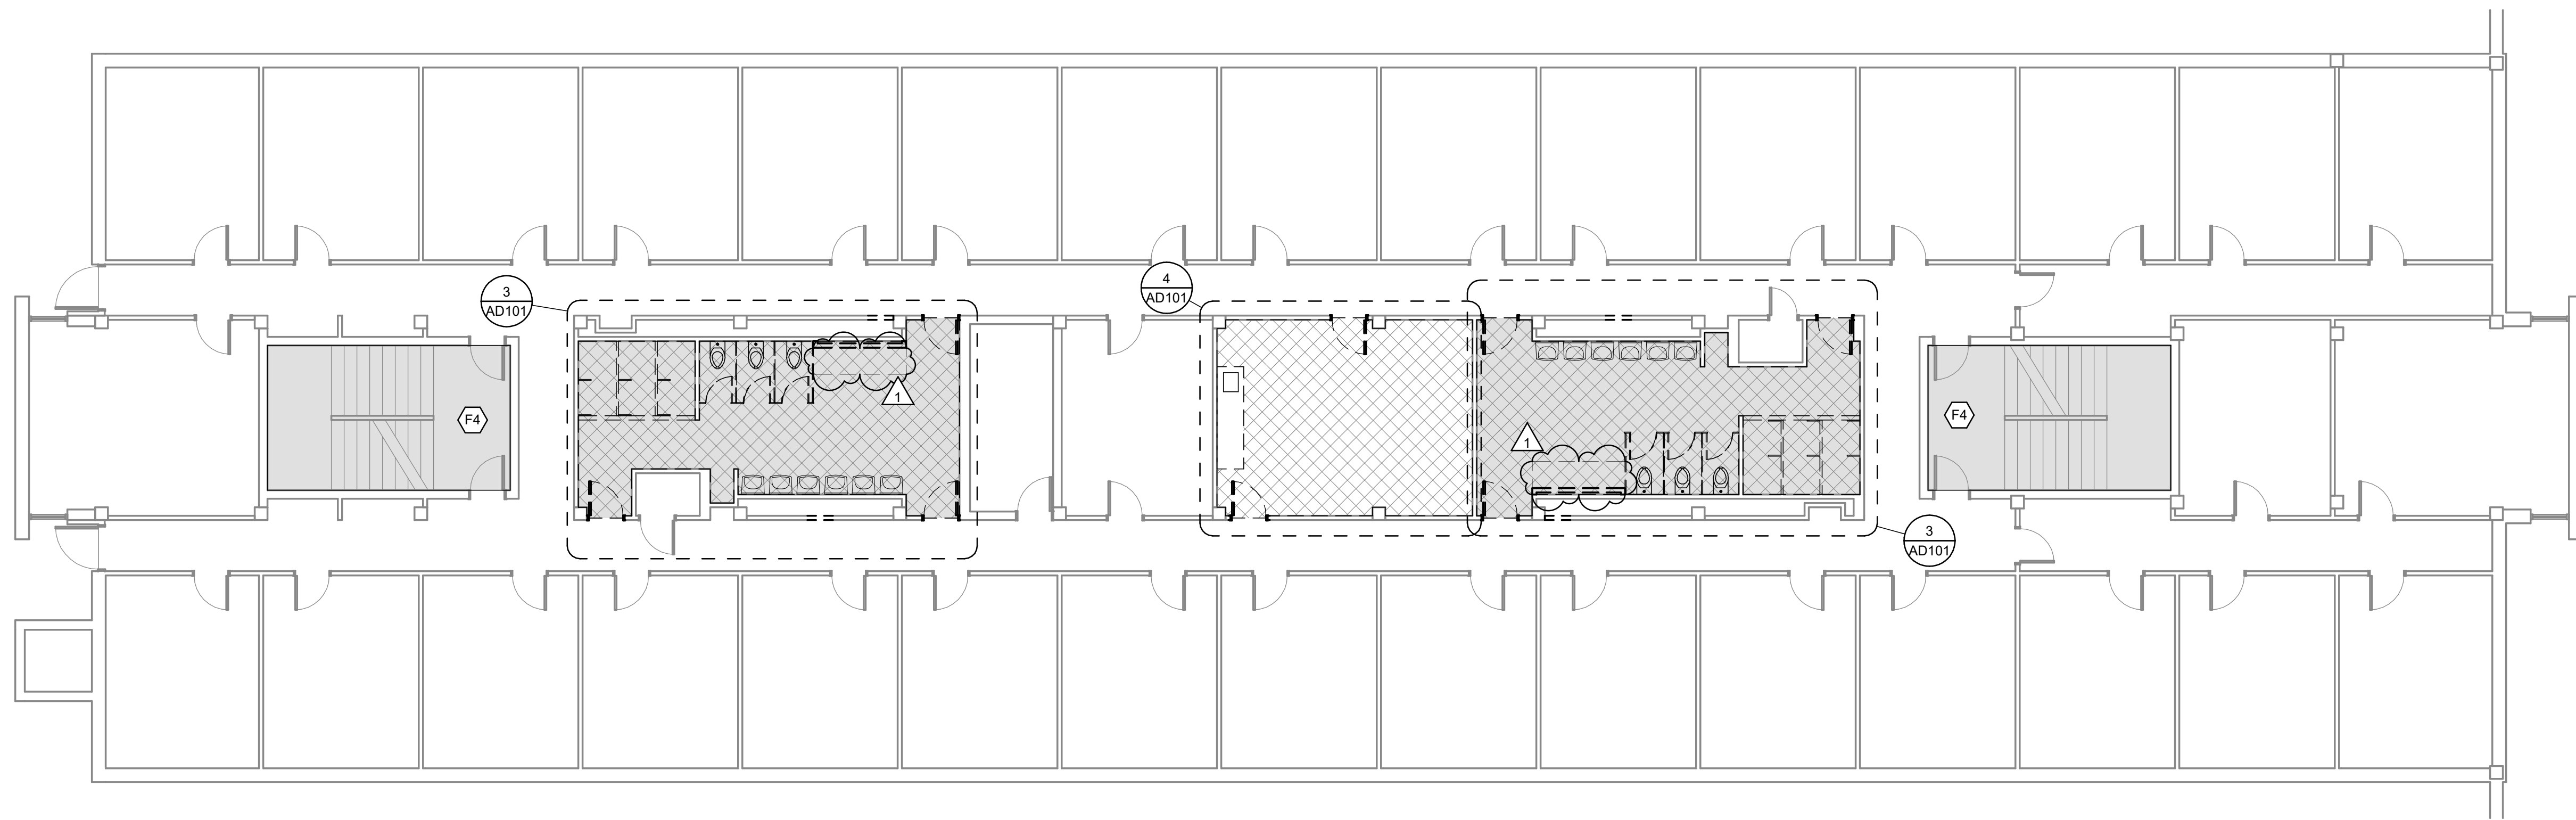


2 THIRD FLOOR DEMO PLAN - HARRILL
1/8" = 1'-0"

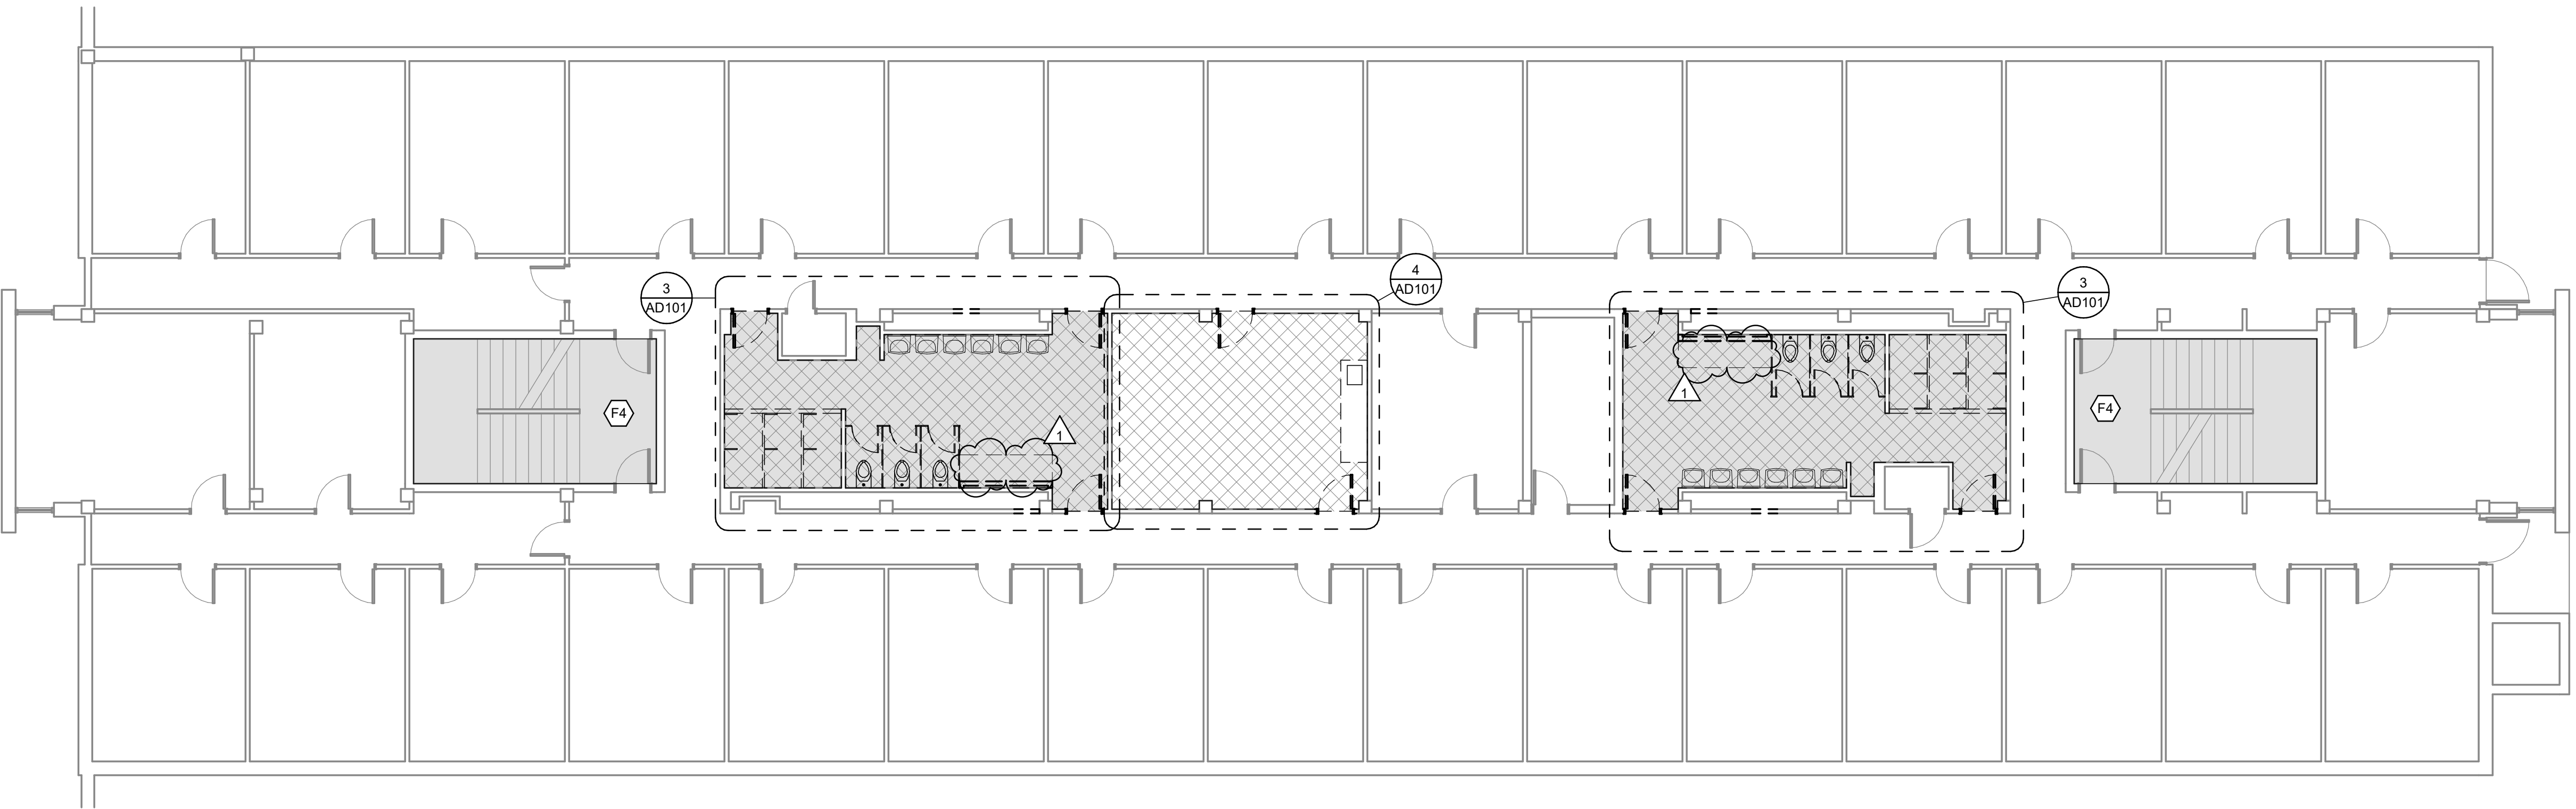

1 THIRD FLOOR DEMO PLAN - DOBSON
1/8" = 1'-0"

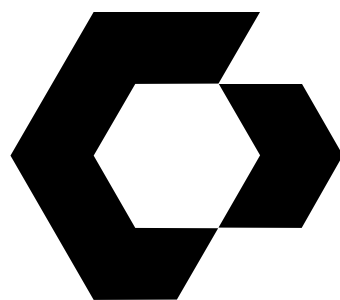

CYNERGY
810 S CINCINNATI AVE, STE 200
TULSA, OK 74119
918.877.0000

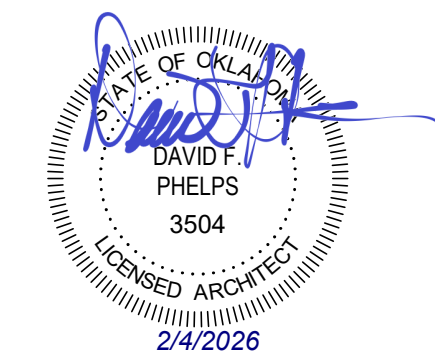

DAVID F. PHELPS, AIA
ARCHITECT OF RECORD

HARRILL-DOBSON INTERIOR
UPGRADES
NORTHEASTERN OKLAHOMA A&M COLLEGE
2001 STREET/NORTHEAST
MARIETTA, OK 74304

THIS DRAWING WAS PREPARED SOLELY AND EXCLUSIVELY FOR EXECUTION OF THE PROJECT IDENTIFIED WITHIN THESE DOCUMENTS. IT IS NOT TO BE REPRODUCED OR COPIED IN ANY MANNER WITHOUT THE WRITTEN CONSENT OF THE ARCHITECT. THE ARCHITECT AND THE ARCHITECT'S CONSULTANTS ARE THE AUTHORS AND OWNERS OF THEIR RESPECTIVE DRAWINGS AND SPECIFICATIONS, AND RETAIN ALL COMMON LAW, STATUTORY, AND OTHER RIGHTS, INCLUDING COPYRIGHTS.

ISSUES / REVISIONS

NO.	DATE	DESCRIPTION
1	03/29/2023	ISSUE FOR CONSTRUCTION
2	04/06/2023	AS 1
3	02/04/2026	AS 2

ISSUE DATE: 03/29/2023
CHECKED BY: EW
DRAWN BY: JD

SHEET NAME
FIRST FLOOR AND FINISH PLAN

SHEET NUMBER

A-101

SPECIALTY AND EQUIPMENT SCHEDULE				
TYPE MARK	DESCRIPTION	MANUFACTURER	MODEL	RESPONSIBILITY
AD1	PLUMBING ACCESS DOOR	NYSTROM	24" X 24", PAINTED TO MATCH ADJACENT FINISH	CPCI
M1	CHANNEL-FRAMED MIRROR/SHELF COMBINATION	GAMCO	G-C-MIRROR, 48X36, 166-30-45, INCLUDE ATTACHED SHELF ENTIRE LENGTH OF MIRROR, ARCHSPEC QUOTE NUMBER: 9314282-1; CONTACT: NIKKI DOUGLAS nkdouglas@archspecsales.com	CPCI
M2	TEMPERED GLASS WITH PENCIL EDGE, INSTALL WITH CHANNEL AND CONSTRUCTION ADHESIVE AS REQUIRED	SCRANTON	72"W X 36"H, RE: INTERIOR ELEVATIONS	CPCI
PSS1	PLASTIC SHOWER STALL	SCRANTON	FOR INSTALLATION WITH FLANGED SHOWER BASE, SB1, SOLID PLASTIC SHOWER STALLS, COLOR: SIDE AND FRONT PANELS TO BE SHALE, BACK PANEL, TO BE LINEN, DRESSING COMPARTMENT PANELS TO BE SHALE, RE: SA-603, INSTALL WITH SHOWER CURTAIN AND SHOWER CURTAIN RINGS, COAT HOOK, RH1, AND FLOOR MOUNTED SEAT, ST1, WHERE INDICATED, INSTALL WITH PLASTIC PLASTER SHOES, CONTRACTOR TO ENSURE WATERPROOFING OF SHOWER PARTITION WALLS AND INSTALLATION WITH SHOWER BASE	CPCI
RH1	ROBE HOOK	SCRANTON	ROBE HOOKS, INCLUDED WITH SHOWER PARTITION ACCESSORIES; INSTALL AT 48" AFF	CPCI
SB1	SHOWER BASE	ACORN	36"X36" TERRAZZO SHOWER BASE, 3 FLANGE, MODEL: SBS-36-3F, COLOR: PLATINUM GREY/OCTO4, INSTALL WITH ACCESSORY KKO2 RUBBER DRAIN GASKET FOR 2" WASTE PIPE	CPCI
ST1	SHOWER SEAT	SCRANTON	FLOOR MOUNTED SHOWER SEAT, INCLUDED WITH SHOWER PARTITION ACCESSORIES	CPCI
TH1	TOILET PARTITIONS	SCRANTON	HIVY HIBERS SOLID PLASTIC, FLOOR MOUNTED, OVERHEAD BRACED, COLOR: SHALE	CPCI

FINISH MATERIAL LEGEND	
MARK	DESCRIPTION
BASE	JOHNSONITE, TRADITIONAL WALL BASE, 4" HIGH CONTINUOUS ROLL, COLOR: 20 CHARCOAL
RB1	JOHNSONITE, TRADITIONAL WALL BASE, 4" HIGH CONTINUOUS ROLL, COLOR: 20 CHARCOAL
LV1	SHAW CONTRACT COVE, COLOR: PLASTER, SIZE: 3" X 48"
RE1	TARGETT/JOHNSONITE, 24" X 24" RUBBER TILE, COLOR: 20 CHARCOAL
RSS1	TARGETT/JOHNSONITE, RUBBER STAIR STRINGER, COLOR: 20 CHARCOAL
RST1	TARGETT/JOHNSONITE, ANGLED RUBBER STAIR TREAD WITH INTEGRATED RISER FOR THE VISUALLY IMPAIRED, GRIT TAPE, TEXTURE, RAISED ROUND, COLOR: 20 CHARCOAL
THRESHOLD/TRANSITION	
MT1	DAL TILES, MARBLE THRESHOLD, DOUBLE HOLLYWOOD BEVEL, COLOR: CARRARA WHITE MARBLE M701-POLISHED, SIZE: 4"
TILE	
T1	CROSSVILLE, SHADES 2.0, COLOR: FOG UPS, SIZE: 12"X24", INSTALLATION: TO BE DETERMINED BY OWNER
T2	CROSSVILLE, SHADES 2.0, COLOR: HAZE UPS, SIZE: 12"X24", INSTALLATION: TO BE DETERMINED BY OWNER
CEILING TILE	USG, SHEETROCK BRAND LAY-IN GYPSUM CEILING PANELS 3260, 2X2, COLOR: WHITE, GRID: DXLA, GRID COLOR: WHITE
MILLWORK	
PL1	CORIAN, COLOR: LINEN
SS1	CORIAN, COLOR: DPG-66 SHARROW, MATTE FINISH
PAINT	
PT1	SHERWIN WILLIAMS, COLOR: SW 9165 GOSSAMER VEIL, COMMENTS: GENERAL WALL PAINT
PT2	SHERWIN WILLIAMS, COLOR: SW 7069 IRON ORE, COMMENTS: TRIM AND DOOR PAINT



GENERAL FINISH NOTES	
A.	HAZARDOUS MATERIALS ARE SUSPECTED AT THE JOB SITE IN THE FORM OF ASBESTOS CONTAINING MATERIALS (ACM). THERE IS SUSPECT FLOOR TILE AND/OR MASTIC MATERIAL THAT MAY REQUIRE FURTHER IDENTIFICATION AND TESTING FOR CONTENT OF ASBESTOS. SHOULD THIS MATERIAL BE IDENTIFIED AS PRESENT, IT IS RECOMMENDED THAT PROPER ABATEMENT PROCEDURES BE FOLLOWED AS APPROPRIATE. CONTRACTOR TO PROVIDE ASBESTOS REVIEW PRIOR TO BEGINNING WORK. CONTRACTOR SHALL MAKE IDENTIFIED AREAS READY FOR NEW CONSTRUCTION AND APPLICATION OF NEW FINISHES ACCORDINGLY.
B.	RE: 3/A-101 FOR TYPICAL RESTROOM FLOOR AND FINISH PLAN.
C.	RE: 4/A-101 FOR TYPICAL LOUNGE FLOOR AND FINISH PLAN.
D.	MATERIAL PATTERNS ON DRAWINGS DO NOT INDICATE PRODUCT INSTALLATION, IF UNCLEAR IN NOTES OR ON FINISH PLAN, VERIFY FLOOR PATTERN DIRECTION PRIOR TO INSTALLATION.
E.	CASEWORK TO BE INSTALLED BEFORE RUBBER BASE. COORDINATE INSTALLATION OF RUBBER BASE AT WALLS AND INSTALL AROUND CASEWORK.
F.	CONTRACTOR TO VERIFY ALL EXISTING DIMENSIONS.
G.	PAINT ALL INTERIOR SOFFITS PT1.
H.	PAINT DOORS AND FRAMES PT2.
I.	FLOORING TRANSITIONS TO BE INSTALLED UNDER CENTER OF DOORS, UNLESS NOTED OTHERWISE.
J.	INSTALL NEW WALL TILE OVER EXISTING GLAZED CMU BLOCK UNLESS NOTED OTHERWISE. CONTRACTOR TO USE ADHESIVE/MORTAR APPROPRIATE FOR THIS CONDITION.
K.	INSTALL NEW LVT FLOORING OVER EXISTING FLOORING UNLESS NOTED OTHERWISE.
L.	DO NOT INSTALL TILE BEHIND SHOWER STALLS, PSS1, PAINT WALL ABOVE SHOWER STALLS PT1.
M.	CONTRACTOR TO MEASURE CLEAR SPACE IN EACH RESTROOM FOR SHOWER INSTALLATION BEFORE ORDERING SHOWER BASES. IF OPENING IS LESS THAN 9'-1 3/4", ALERT ARCHITECT FOR RESOLUTION.

ROOM FINISH LEGEND	
ROOM IDENTIFIER AND FINISH INDICATOR	
ROOM NUMBER	ROOM NAME
101	101
PT1	PT1
RB1	RB1
CPT1	CPT1
NOTES: 2, 3	FINISH NOTES
KEYNOTE INDICATOR	
TRANSITION INDICATOR	
T1	LV1
ALT1	
ALT2	NOT IN SCOPE


FLOOR PLAN LEGEND	
EXISTING WALLS AND PARTITIONS	
NEW WALLS AND PARTITIONS	
DOOR IDENTIFIER	
ROOM NAME	ROOM IDENTIFIER
101	
A3	WALL TYPE INDICATOR

FINISH COMMENTS	
NUMBER	COMMENT
1	INSTALL MILLWORK SO THAT NEW SINK ALIGNS WITH EXISTING PLUMBING
2	NOT USED
3	RE: ALTERNATE 1
4	INSTALL NEW STAIR TREADS/RISERS, RST1, AND RUBBER FLOORING, RB1, AT ALL STAIR LANDINGS. INSTALL NEW RUBBER STAIR STRINGER, RSS1, AT ALL STRINGER LOCATIONS. INSTALL NEW RUBBER BASE, RB1, USING PRE-FORMED RUBBER BASE AT ALL INSIDE AND OUTSIDE CORNERS PER MANUFACTURER'S WRITTEN INSTRUCTIONS. PAINT WALLS PT1.
5	STEVEN'S ADVANTAGE, PLASTIC LAMINATE CABINETS (PL2) AND COUNTERTOP (PL1)
6	INSTALL RUBBER BASE, RB1, AT GYPSUM WALL FURR OUT ONLY
7	INSTALL WALL TILE, T2, FROM FLOOR TO CEILING U.N.O.
8	INSTALL MARBLE THRESHOLD, MT1, AT RESTROOM DOORS
9	RE: ALTERNATE 2
10	RE: ALTERNATE 3
11	RE: ALTERNATE 4


ALTERNATES	
ALTERNATE 1	REMOVE CORRIDOR AND DORM ROOM WALL BASE IN ITS ENTIRETY. PREPARE EXISTING FLOORING FOR NEW LVT FLOORING AND RUBBER BASE INSTALLATION. RE: GENERAL DEMO NOTE 8.
ALTERNATE 2	DEMOLITION AND INSTALLATION OF STAIR TREADS AND RISERS
ALTERNATE 3	DEMOLITION AND UPDATES TO LOUNGE AREAS INCLUDING, BUT NOT LIMITED TO, DOORS, FLOORING AND WALL BASE, CASEWORK, AND WALL PAINT.
ALTERNATE 4	VANITY AND MIRROR, M2, INSTALLATION IN RESTROOMS

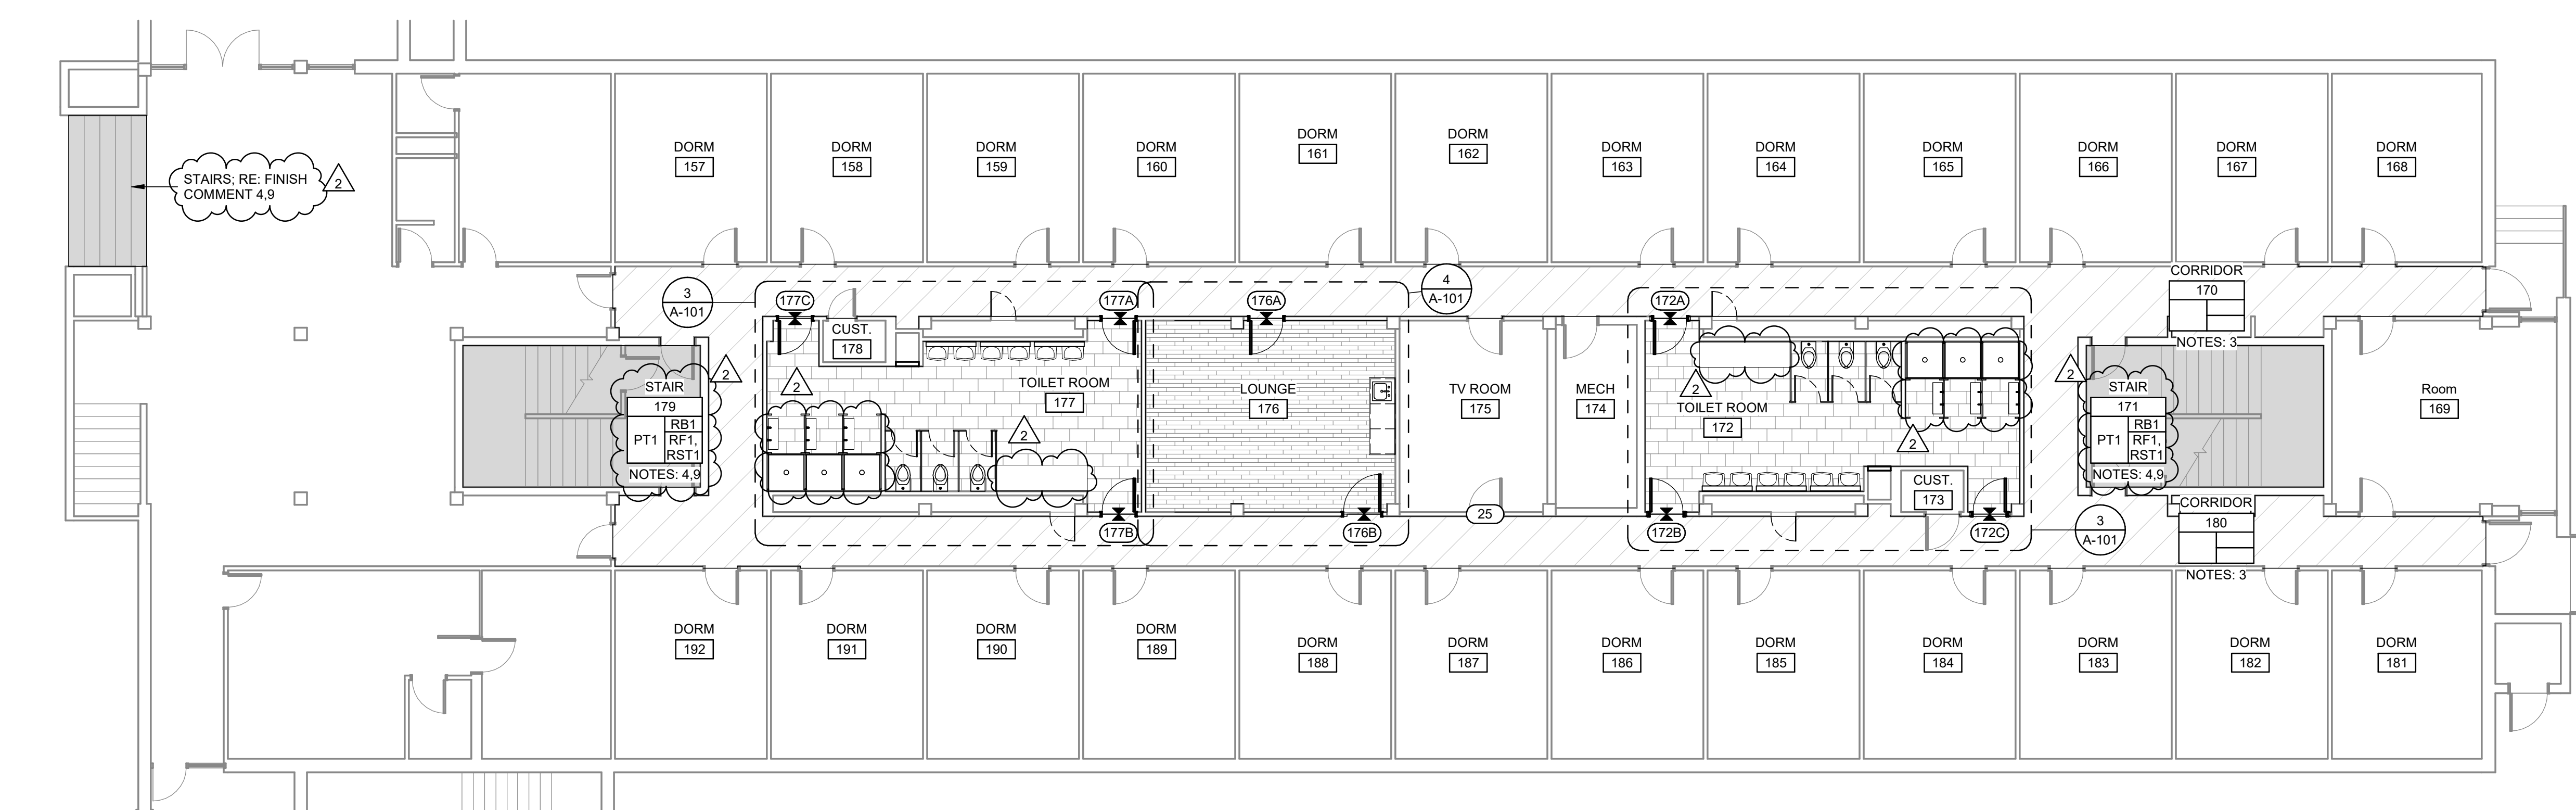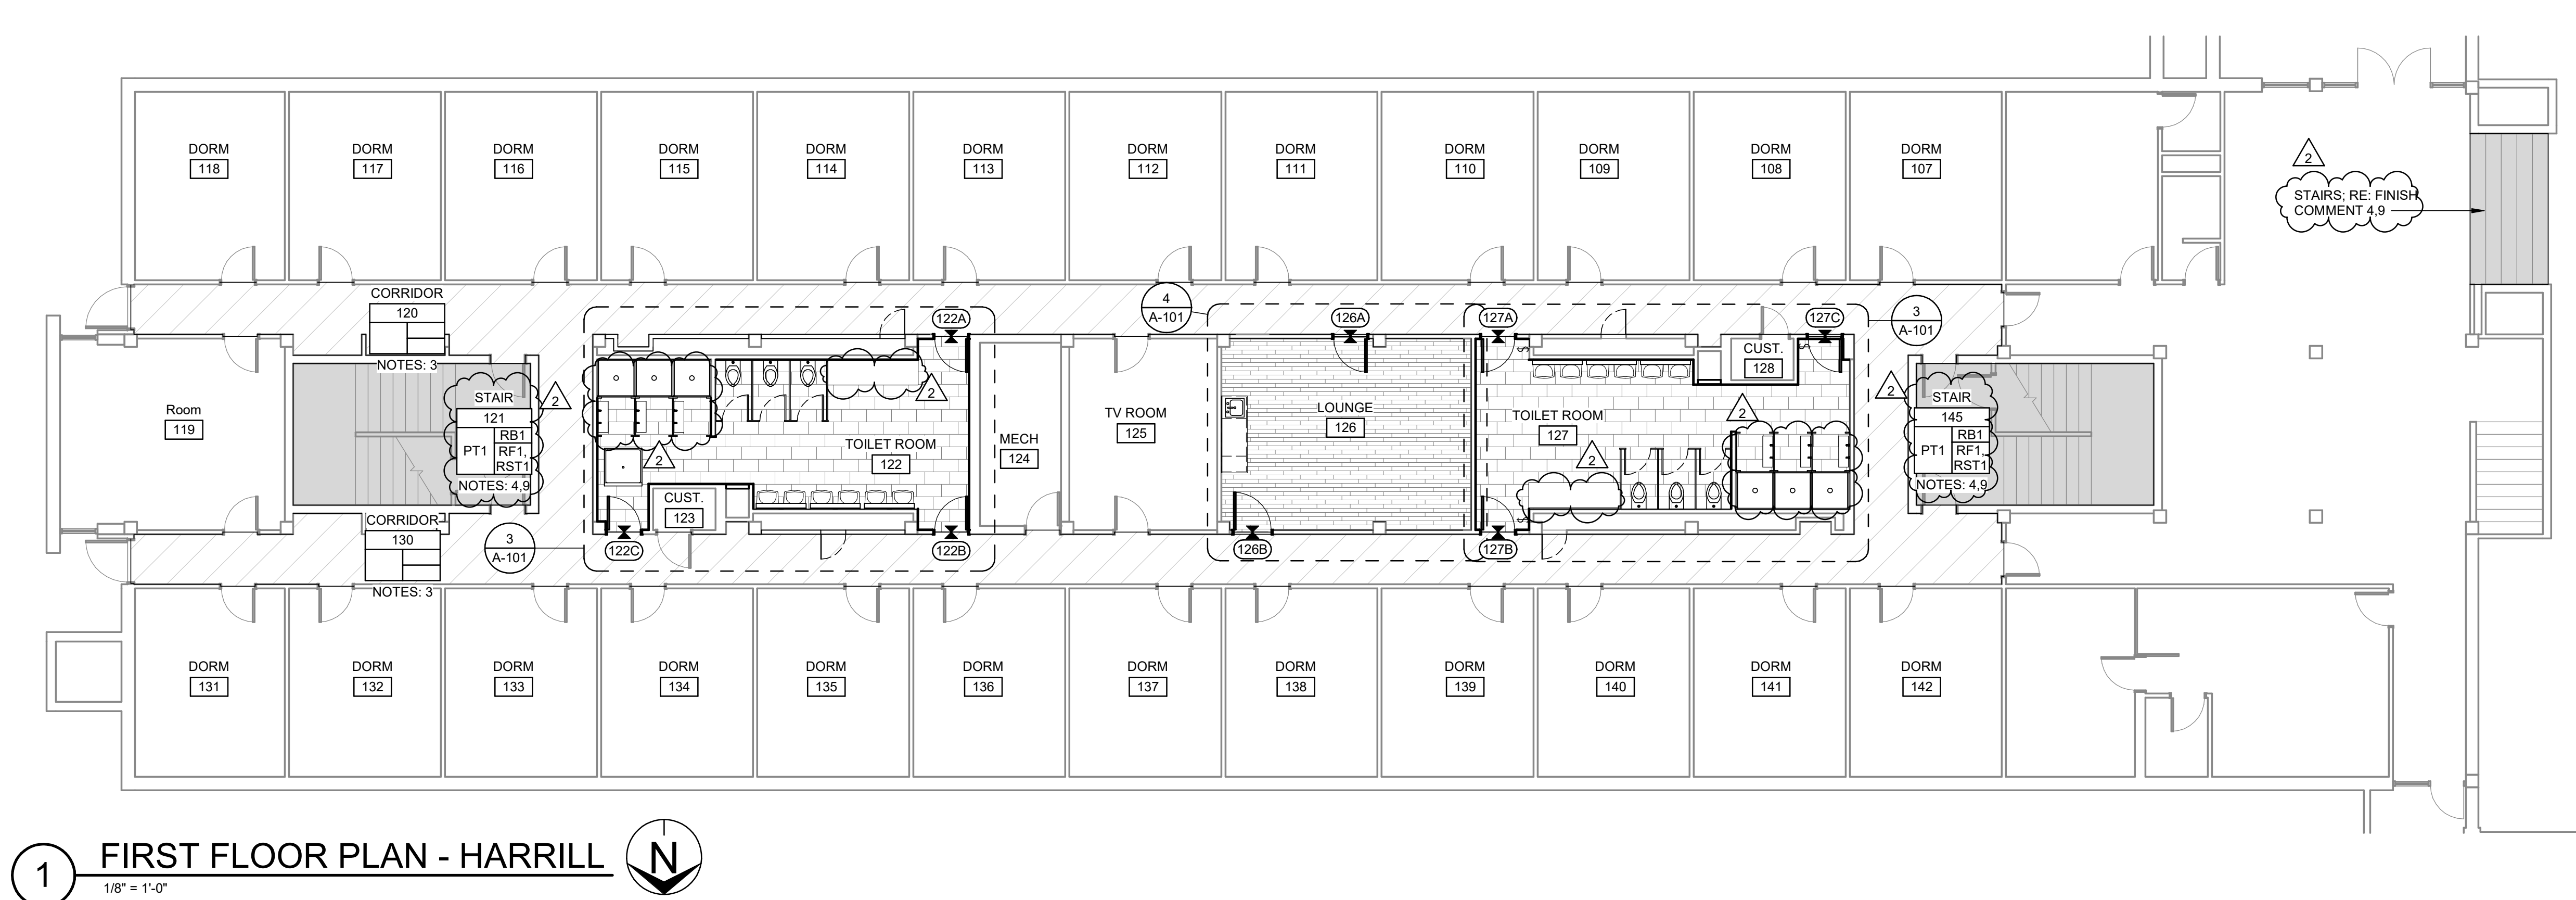


2 FIRST FLOOR PLAN - DOBSON
1/8" = 1'-0"

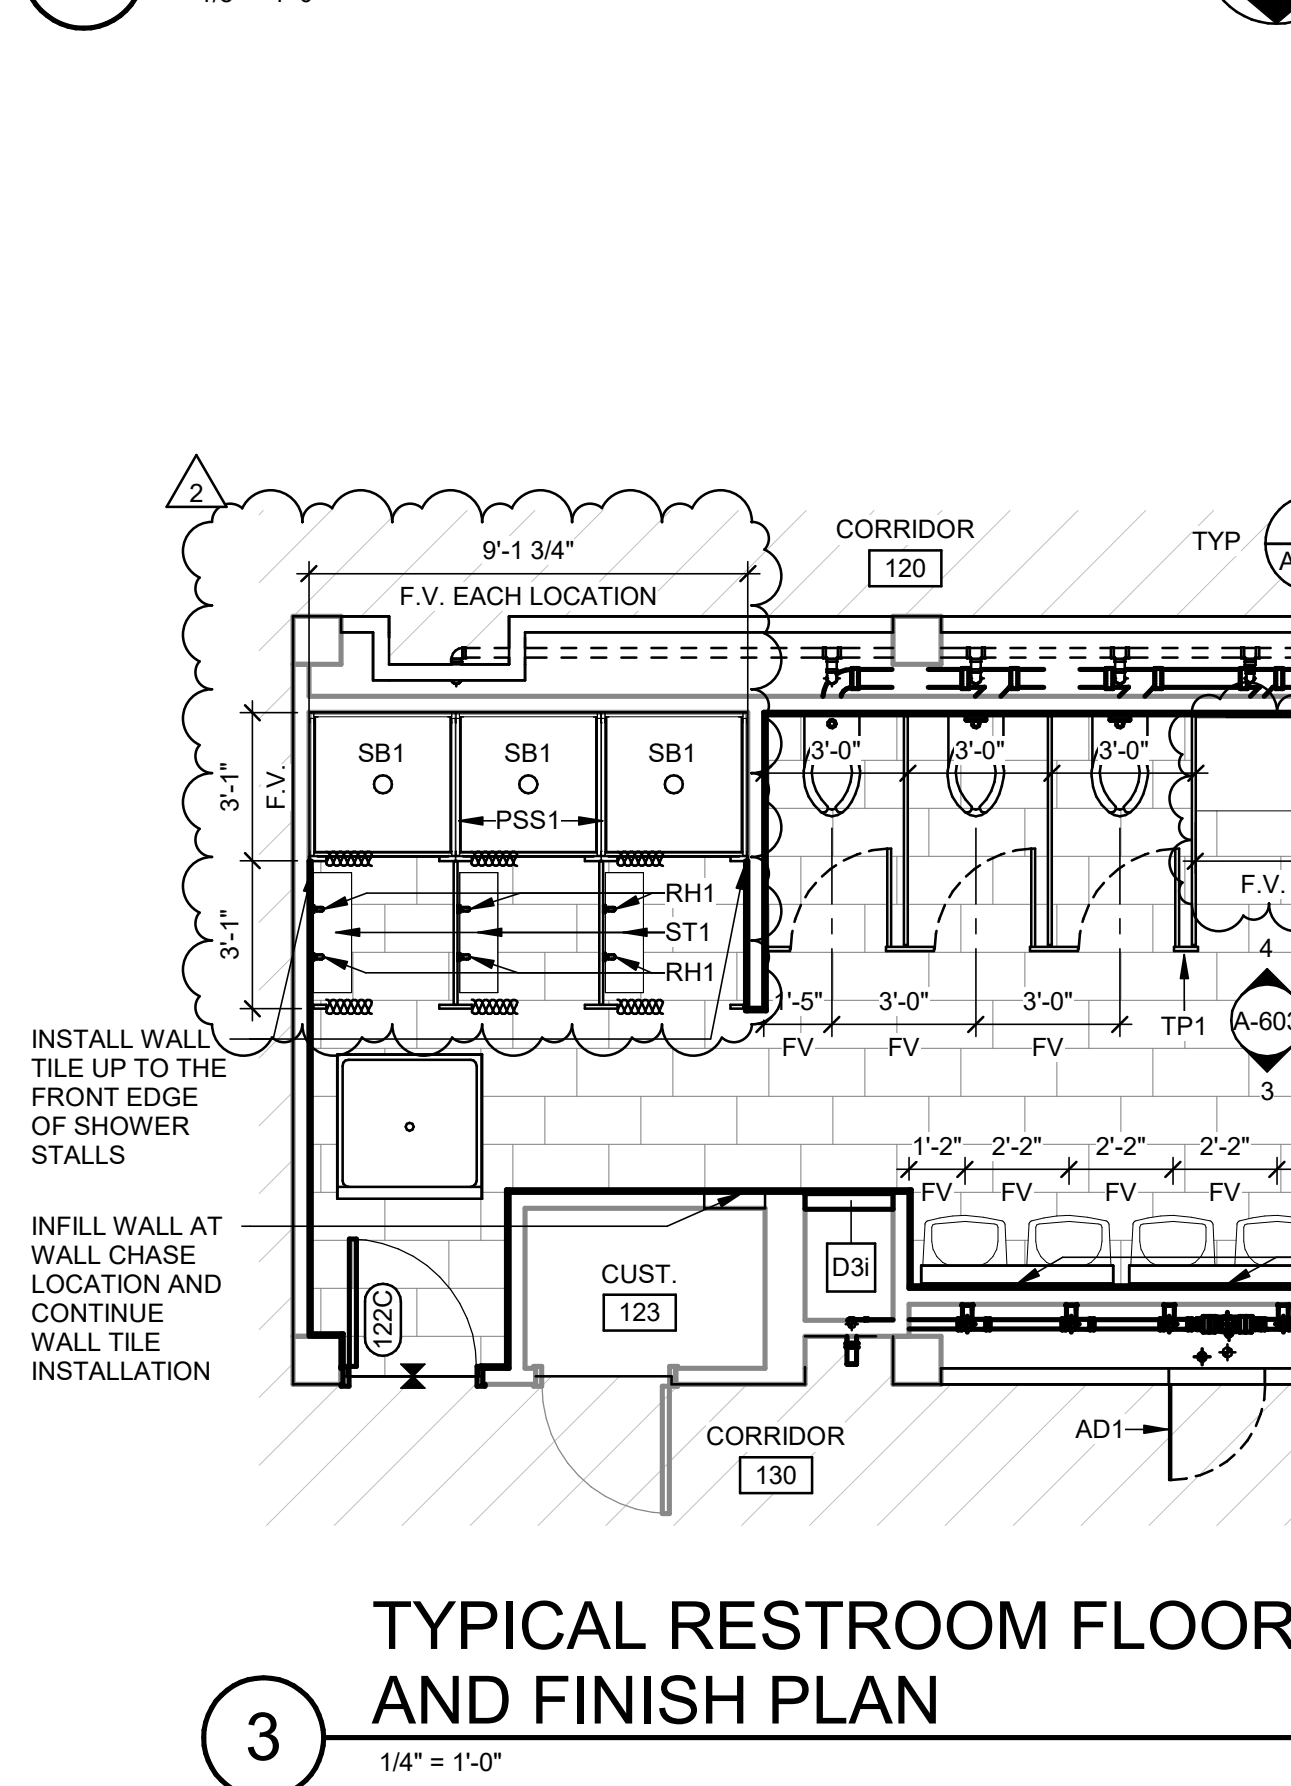


3 TYPICAL RESTROOM FLOOR AND FINISH PLAN
1/4" = 1'-0"

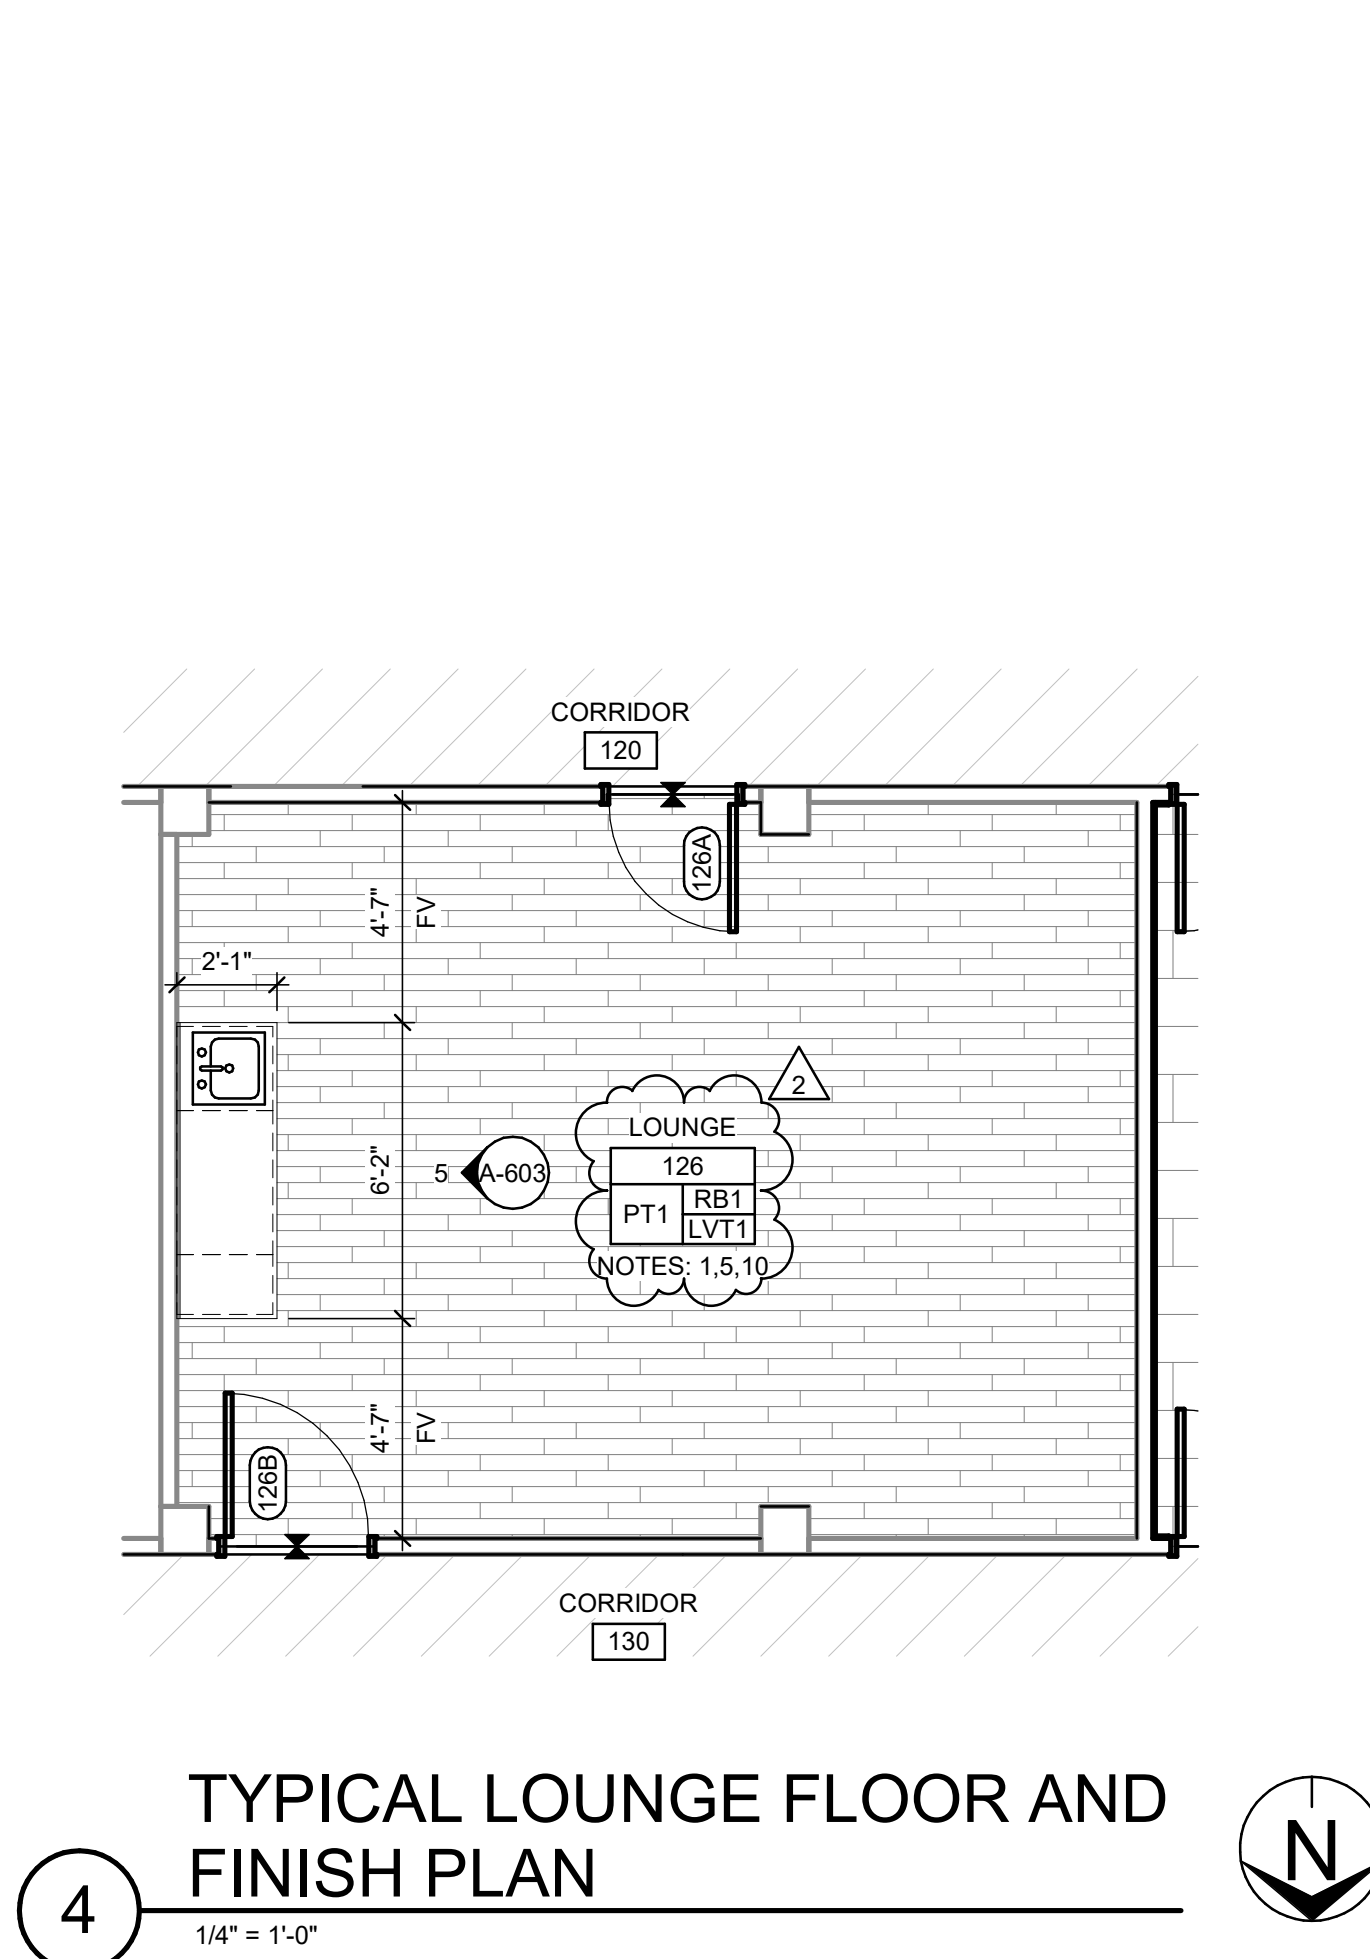


4 TYPICAL LOUNGE FLOOR AND FINISH PLAN
1/4" = 1'-0"

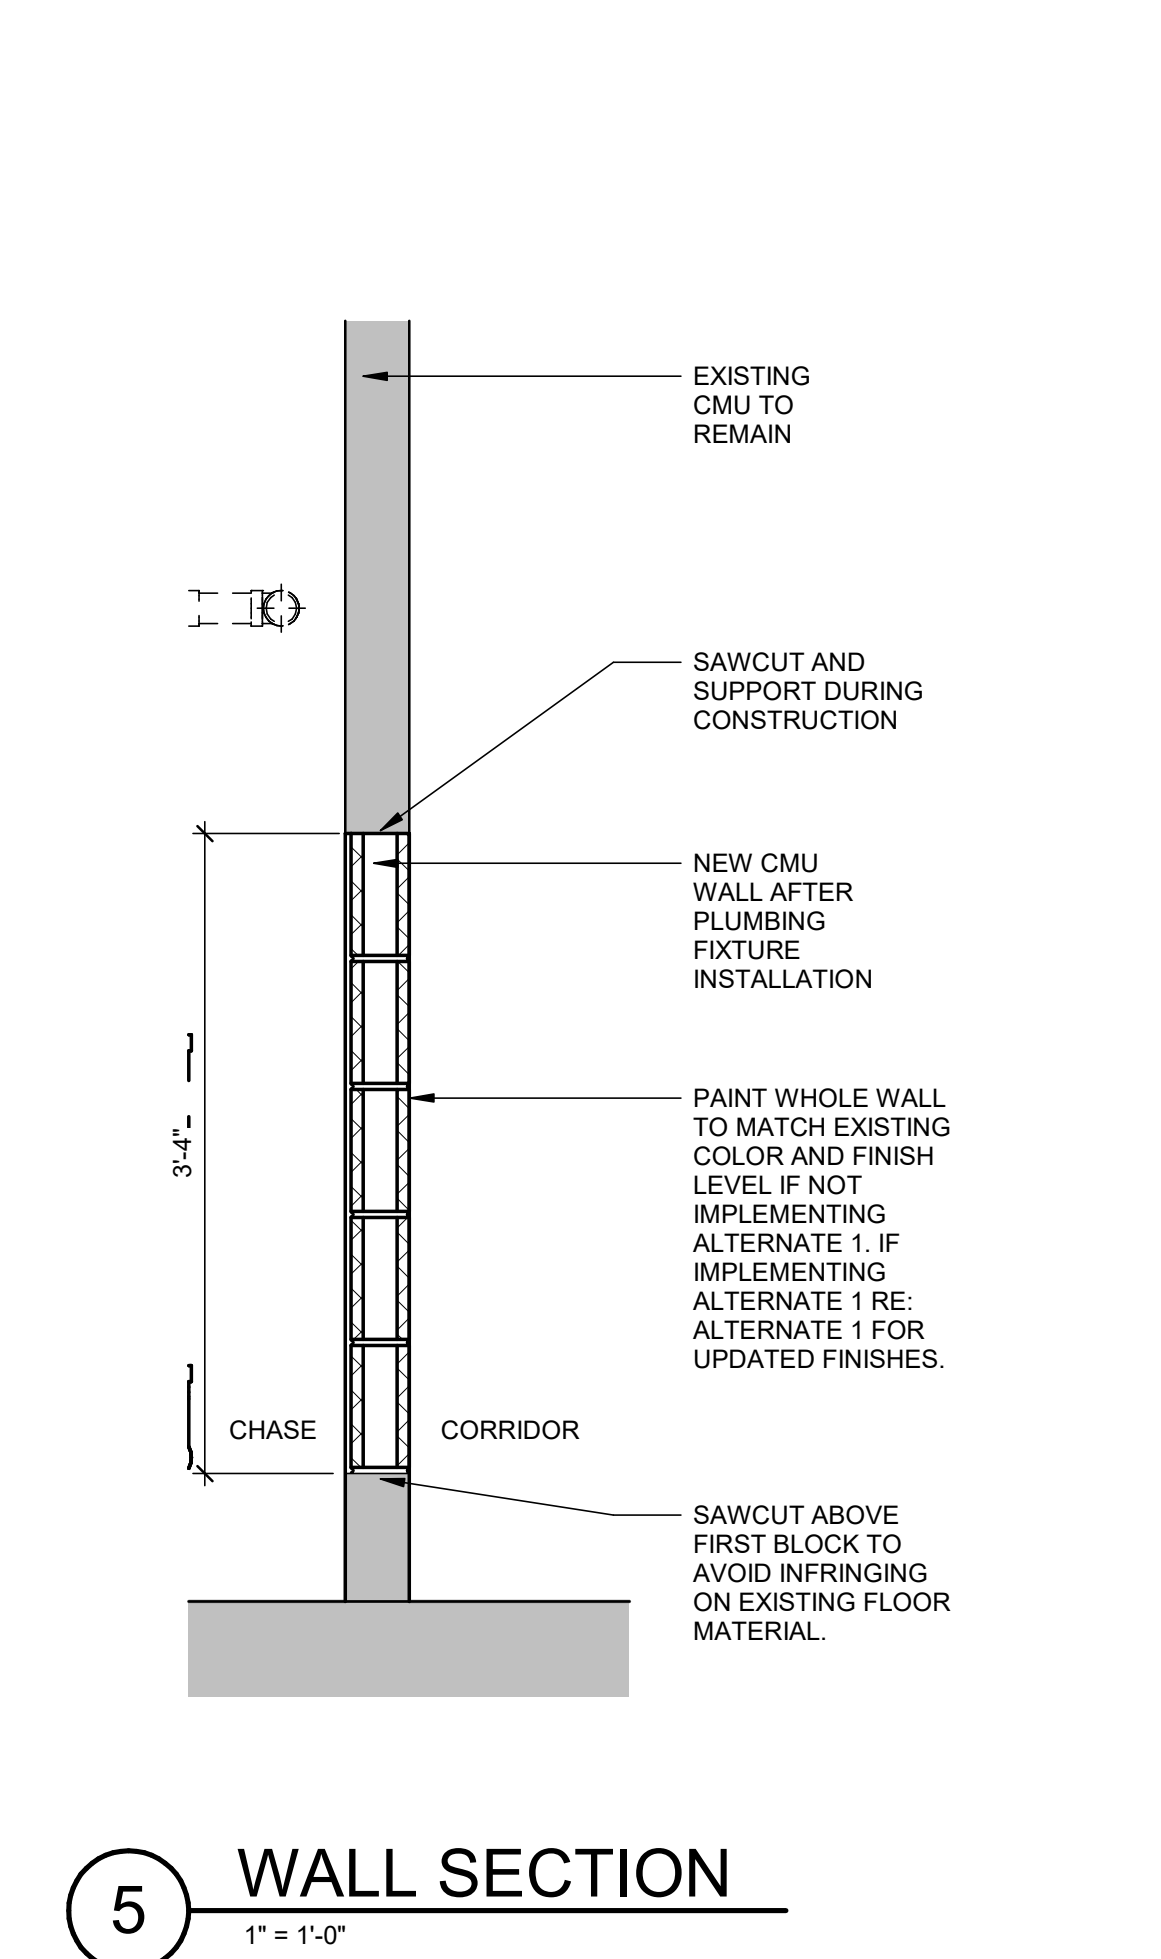

5 WALL SECTION
1" = 1'-0"

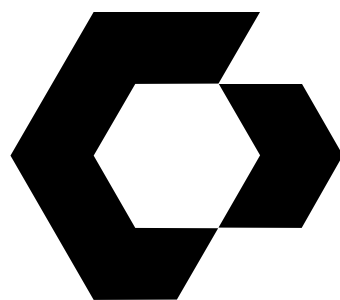

CYNERGY
810 S CINCINNATI AVE, STE 200
TULSA, OK 74119
918.877.6000

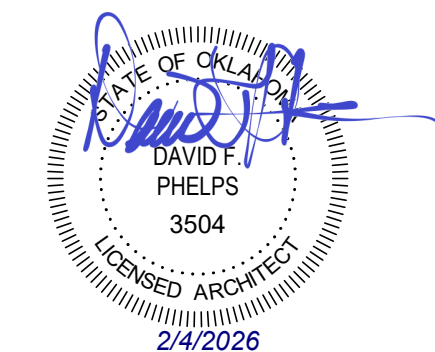

DAVID F. PHELPS, AIA
ARCHITECT OF RECORD

HARRILL-DOBSON INTERIOR
UPGRADES
NORTHEASTERN OKLAHOMA A&M COLLEGE
2001 STREET/NORTHEAST
MARIETTA, OK 74304

THIS DRAWING WAS PREPARED SOLELY AND EXCLUSIVELY FOR EXECUTION OF THE PROJECT IDENTIFIED WITHIN THESE DOCUMENTS. IT IS THE PROPERTY OF CYNERGY AND ITS SUBSIDIARIES. IT IS TO BE USED ONLY FOR THE PROJECT AND SITE SPECIFIC WORK IDENTIFIED HEREIN. IT IS NOT TO BE REPRODUCED, COPIED, OR TRANSMITTED IN ANY FORM OR BY ANY MEANS, ELECTRONIC OR MECHANICAL, INCLUDING PHOTOCOPYING, RECORDING, OR BY ANY INFORMATION STORAGE AND RETRIEVAL SYSTEM, WITHOUT THE WRITTEN PERMISSION OF CYNERGY. THE ARCHITECT AND THE ARCHITECT'S CONSULTANTS ARE THE AUTHORS AND OWNERS OF THESE RESPECTIVE DRAWINGS AND SPECIFICATIONS, AND RETAIN ALL COMMON LAW, STATUTORY, AND OTHER RIGHTS, INCLUDING COPYRIGHTS.

ISSUES / REVISIONS

NO.	DATE	DESCRIPTION
1	04/06/2023	ISSUE FOR CONSTRUCTION
2	02/04/2026	AS 1
		AS 2

ISSUE DATE: 03/29/2023
CHECKED BY: EW
DRAWN BY: JD

SHEET NAME:
SECOND FLOOR AND FINISH PLAN

SHEET NUMBER

A-102

SPECIALTY AND EQUIPMENT SCHEDULE				
TYPE MARK	DESCRIPTION	MANUFACTURER	MODEL	RESPONSIBILITY
AD1	PLUMBING ACCESS DOOR	NYSTROM	24" X 24", PAINTED TO MATCH ADJACENT FINISH	CPCI
M1	CHANNEL-FRAMED MIRROR/SHELF COMBINATION	GAMCO	G-C MIRROR, 18X36, 166-30-45, INCLUDE ATTACHED SHELF, ENTIRE LENGTH OF MIRROR, ARCHSPEC QUOTE NUMBER: 9314282-1; CONTACT: NIKKI DOUGLAS nkd@archspecsales.com	CPCI
M2	TEMPERED GLASS WITH PENCIL EDGE; INSTALL WITH CHANNEL AND CONSTRUCTION ADHESIVE AS REQUIRED		72"W X 36"H, RE-INTERIOR ELEVATIONS	CPCI
PS1	PLASTIC SHOWER STALL	SCRANTON	FOR INSTALLATION WITH FLANGED SHOWER BASE, SB1, SOLID PLASTIC SHOWER STALLS; COLOR: SIDE AND FRONT PANELS TO BE SHALE, BACK PANEL TO BE LINEN, DRESSING COMPARTMENT PANELS TO BE SHALE; RE: SA-603, INSTALL WITH SHOWER CURTAIN AND SHOWER CURTAIN RINGS, COAT HOOK, RH1, AND FLOOR MOUNTED SEAT, ST1, WHERE INDICATED, INSTALL WITH PLASTIC PLASTER SHOES; CONTRACTOR TO ENSURE WATERPROOFING OF SHOWER PARTITION WALLS AND INSTALLATION WITH SHOWER BASE	CPCI
RH1	ROBE HOOK	SCRANTON	ROBE HOOKS; INCLUDED WITH SHOWER PARTITION ACCESSORIES; INSTALL AT 48" AFF	CPCI
SB1	SHOWER BASE	ACORN	36"X36" TERRAZZO SHOWER BASE, 3 FLANGE, MODEL: SBS-36-3F; COLOR: PLATINUM GREY; OCTO4, INSTALL WITH ACCESSORY KKO2 RUBBER DRAIN GASKET FOR 2" WASTE PIPE	CPCI
ST1	SHOWER SEAT	SCRANTON	FLOOR MOUNTED SHOWER SEAT; INCLUDED WITH SHOWER PARTITION ACCESSORIES	CPCI
HP1	TOILET PARTITIONS	SCRANTON	NIKKI HIBERS SOLID PLASTIC, FLOOR MOUNTED, OVERHEAD BRACED; COLOR: SHALE	CPCI

FINISH MATERIAL LEGEND	
MARK	DESCRIPTION
BASE	JOHNSONITE: TRADITIONAL WALL BASE, 4" HIGH
RB1	JOHNSONITE: TRADITIONAL WALL BASE, 4" HIGH
RESILIENT FLOORING	SHAW CONTRACT COVE, COLOR: PLASTER, SIZE: 3" X 48"
LV1	JOHNSONITE: 24" X 24" RUBBER TILE, COLOR: 20 CHARCOAL
RE1	JOHNSONITE: 24" X 24" RUBBER TILE, COLOR: 20 CHARCOAL
RSS1	TARGETT/JOHNSONITE: RUBBER STAIR STRINGER, COLOR: 20 CHARCOAL
RST1	TARGETT/JOHNSONITE: ANGLED RUBBER STAIR TREAD WITH INTEGRATED RISER FOR THE VISUALLY IMPAIRED, GRIT TAPE, TEXTURE: RAISED ROUND, COLOR: 20 CHARCOAL
THRESHOLD/TRANSITION	
MTH1	DAL TILE: MARBLE THRESHOLD, DOUBLE HOLLYWOOD BEVEL, COLOR: CARRARA WHITE MARBLE M701-POLISHED, SIZE: 4"
TILE	
T1	CROSSVILLE, SHADES 2.0, COLOR: FOG UPS, SIZE: 12"X24"; INSTALLATION: TO BE DETERMINED BY OWNER
T2	CROSSVILLE, SHADES 2.0, COLOR: HAZE UPS, SIZE: 12"X24"; INSTALLATION: TO BE DETERMINED BY OWNER
CEILING TILE	
CT1	USG: SHEETROCK BRAND LAY-IN GYPSUM CEILING PANELS 3260, 2X2, COLOR: WHITE, GRID: DXLA; GRID COLOR: WHITE
MILLWORK	
PL1	CORIAN, COLOR: LINEN
PL2	CORIAN, COLOR: DUNE, 66" SHARQW; MATTE FINISH
SS1	CORIAN, COLOR: ARTISTA CANVAS
PAINT	
PT1	SHERWIN WILLIAMS: COLOR: SW 9165 GOSSAMER VEIL; COMMENTS: GENERAL WALL PAINT
PT2	SHERWIN WILLIAMS: COLOR: SW 7069 IRON ORE; COMMENTS: TRIM AND DOOR PAINT


GENERAL FINISH NOTES	
A.	HAZARDOUS MATERIALS ARE SUSPECTED AT THE JOB SITE IN THE FORM OF ASBESTOS CONTAINING MATERIALS (ACM). THERE IS SUSPECT FLOOR TILE AND/OR MASTIC MATERIAL THAT MAY REQUIRE FURTHER IDENTIFICATION AND TESTING FOR CONTENT OF ASBESTOS. SHOULD THIS MATERIAL BE IDENTIFIED AS PRESENT, IT IS RECOMMENDED THAT PROPER ABATEMENT PROCEDURES BE FOLLOWED AS APPROPRIATE. CONTRACTOR TO PROVIDE ASBESTOS REVIEW PRIOR TO BEGINNING WORK. CONTRACTOR SHALL MAKE IDENTIFIED AREAS READY FOR NEW CONSTRUCTION AND APPLICATION OF NEW FINISHES ACCORDINGLY.
B.	RE: 3/A-101 FOR TYPICAL RESTROOM FLOOR AND FINISH PLAN.
C.	RE: 4/A-101 FOR TYPICAL LOUNGE FLOOR AND FINISH PLAN.
D.	MATERIAL PATTERNS ON DRAWINGS DO NOT INDICATE PRODUCT INSTALLATION; IF UNCLEAR IN NOTES OR ON FINISH PLAN, VERIFY FLOOR PATTERN DIRECTION PRIOR TO INSTALLATION.
E.	CASEWORK TO BE INSTALLED BEFORE RUBBER BASE. COORDINATE INSTALLATION OF RUBBER BASE AT WALLS AND INSTALL AROUND CASEWORK.
F.	CONTRACTOR TO VERIFY ALL EXISTING DIMENSIONS.
G.	PAINT ALL INTERIOR SOFFITS PT1.
H.	PAINT DOORS AND FRAMES PT2.
I.	FLOORING TRANSITIONS TO BE INSTALLED UNDER CENTER OF DOORS, UNLESS NOTED OTHERWISE.
J.	INSTALL NEW WALL TILE OVER EXISTING GLAZED CMU BLOCK UNLESS NOTED OTHERWISE. CONTRACTOR TO USE ADHESIVE/MORTAR APPROPRIATE FOR THIS CONDITION.
K.	INSTALL NEW LVT FLOORING OVER EXISTING FLOORING UNLESS NOTED OTHERWISE.
L.	DO NOT INSTALL TILE BEHIND SHOWER STALLS, PSS1, PARTIAL WALL ABOVE SHOWER STALLS PT1.
M.	CONTRACTOR TO MEASURE CLEAR SPACE IN EACH RESTROOM FOR SHOWER INSTALLATION BEFORE ORDERING SHOWER BASES. IF OPENING IS LESS THAN 9'-1 3/4", ALERT ARCHITECT FOR RESOLUTION.

ROOM FINISH LEGEND	
ROOM IDENTIFIER AND FINISH INDICATOR	
ROOM NUMBER	ROOM NAME
101	101
PT1	PT1
RB1	RB1
CT1	CT1
NOTES: 2, 3	FINISH NOTES
KEYNOTE INDICATOR	
TRANSITION INDICATOR	
T1	LV1
ALT1	
ALT2	NOT IN SCOPE


FLOOR PLAN LEGEND	
EXISTING WALLS AND PARTITIONS	
NEW WALLS AND PARTITIONS	
DOOR IDENTIFIER	
ROOM NAME	ROOM IDENTIFIER
101	
A3	WALL TYPE INDICATOR

FINISH COMMENTS	
NUMBER	COMMENT
1	INSTALL MILLWORK SO THAT NEW SINK ALIGNS WITH EXISTING PLUMBING
2	NOT USED
3	RE: ALTERNATE 1
4	INSTALL NEW STAIR TREAD/RISERS, RST1, AND RUBBER FLOORING, RB1, AT ALL STAIR LANDINGS. INSTALL NEW RUBBER STAIR STRINGER, RSS1, AT ALL STRINGER LOCATIONS. INSTALL NEW RUBBER BASE, RB1, USING PRE-FORMED RUBBER BASE AT ALL INSIDE AND OUTSIDE CORNERS PER MANUFACTURER'S WRITTEN INSTRUCTIONS. PAINT WALLS PT1.
5	STEVENS ADVANTAGE, PLASTIC LAMINATE CABINETS (PL2) AND COUNTERTOP (PL1)
6	INSTALL RUBBER BASE, RB1, AT GYPSUM WALL FUR OUT ONLY
7	INSTALL WALL TILE, T2, FROM FLOOR TO CEILING U.N.O.
8	INSTALL MARBLE THRESHOLD, MTH1, AT RESTROOM DOORS
9	RE: ALTERNATE 2
10	RE: ALTERNATE 3
11	RE: ALTERNATE 4


ALTERNATES	
ALTERNATE 1	
REMOVE CORRIDOR AND DORM ROOM WALL BASE IN ITS ENTIRETY. PREPARE EXISTING FLOORING FOR NEW LVT FLOORING AND RUBBER BASE INSTALLATION. RE: GENERAL DEMO NOTE 8.	
INSTALL NEW FLOORING ON TOP OF EXISTING FLOORING MATERIAL, LV1, AND RUBBER BASE, RB1, IN HARRILL AND DOBSON CORRIDORS PER MANUFACTURER'S WRITTEN INSTRUCTIONS. CONTRACTOR TO INSTALL APPROPRIATE FLOORING TRANSITION STRIP BETWEEN NEW LVT AND ADJACENT FLOOR FINISHES PER MANUFACTURER'S WRITTEN INSTRUCTIONS.	
ALTERNATE 2	
DEMOLITION AND INSTALLATION OF STAIR TREADS AND RISERS	
ALTERNATE 3	
DEMOLITION AND UPDATES TO LOUNGE AREAS INCLUDING, BUT NOT LIMITED TO, DOORS, FLOORING AND WALL BASE, CASEWORK, AND WALL PAINT.	
ALTERNATE 4	
VANITY AND MIRROR, M2, INSTALLATION IN RESTROOMS	

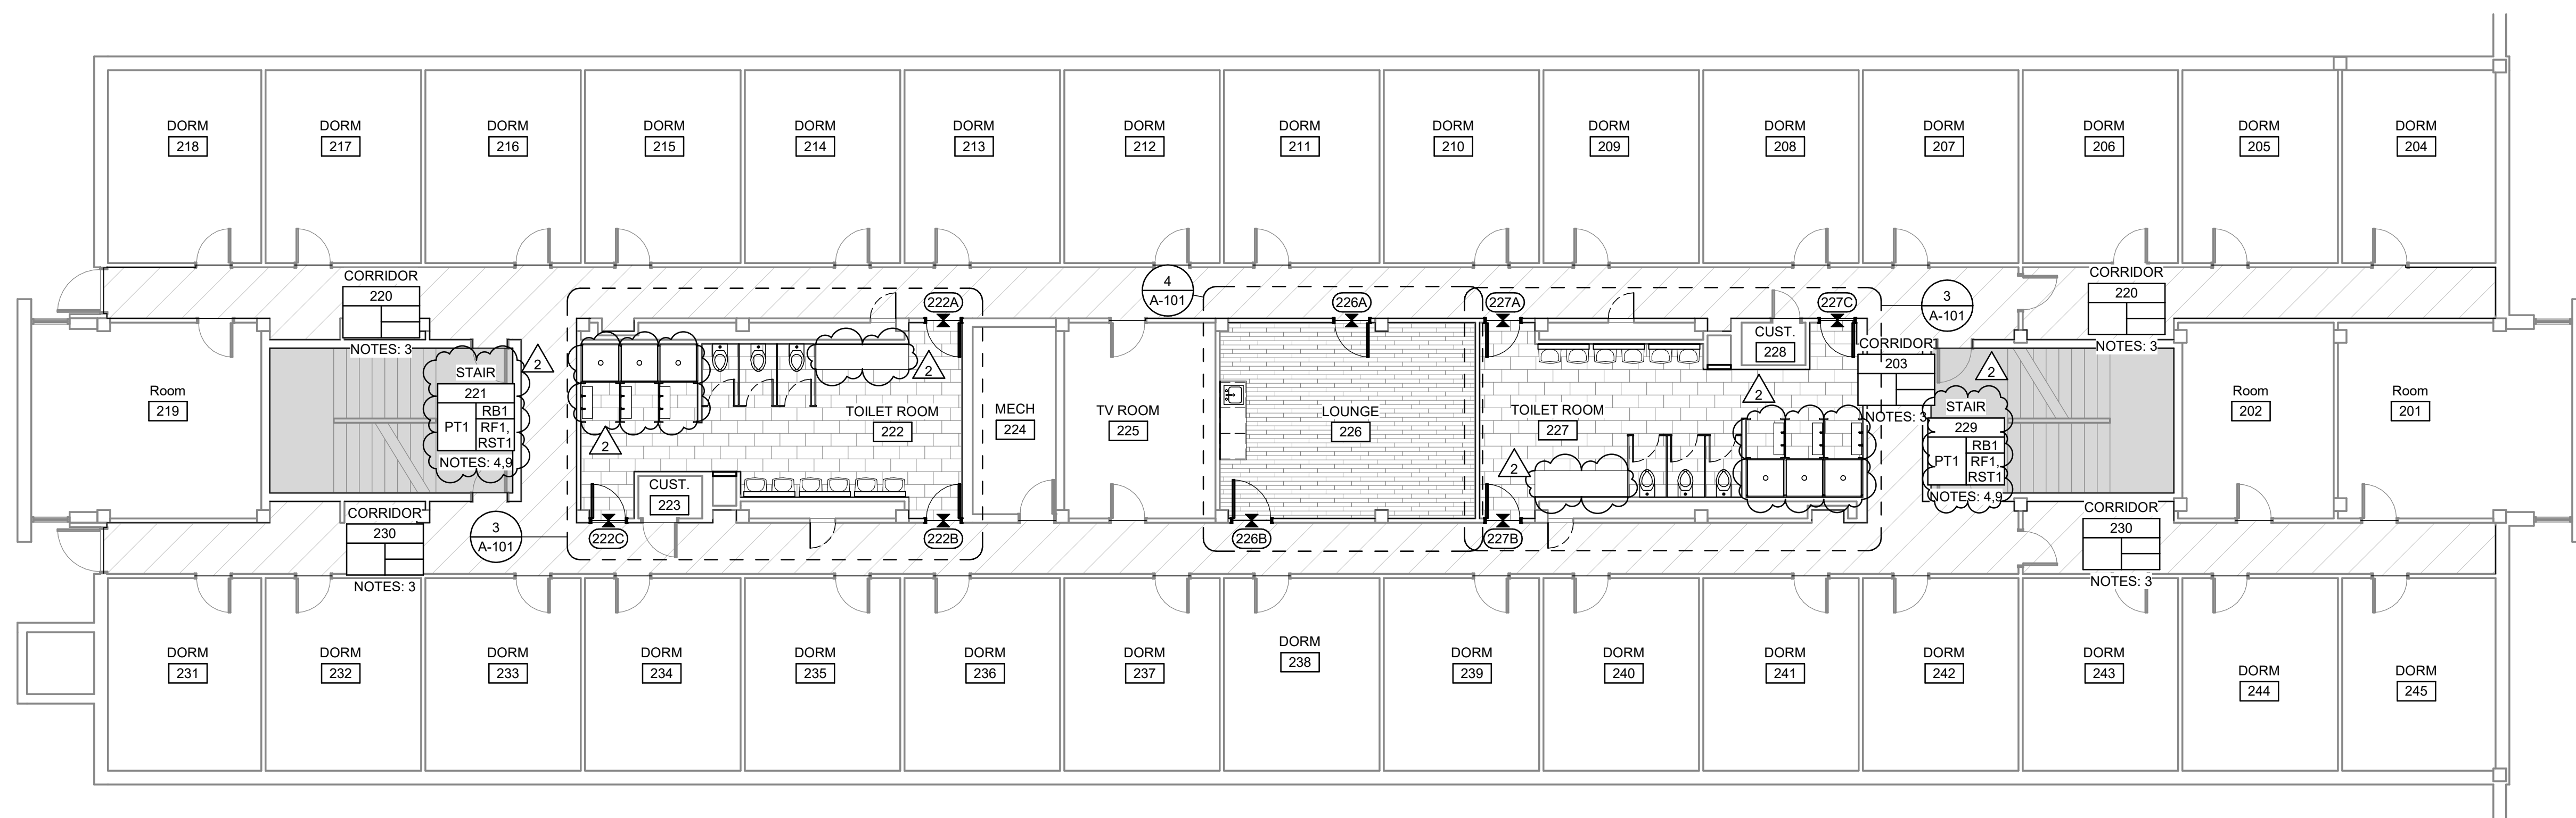


1 SECOND FLOOR PLAN - HARRILL
1/8" = 1'-0"

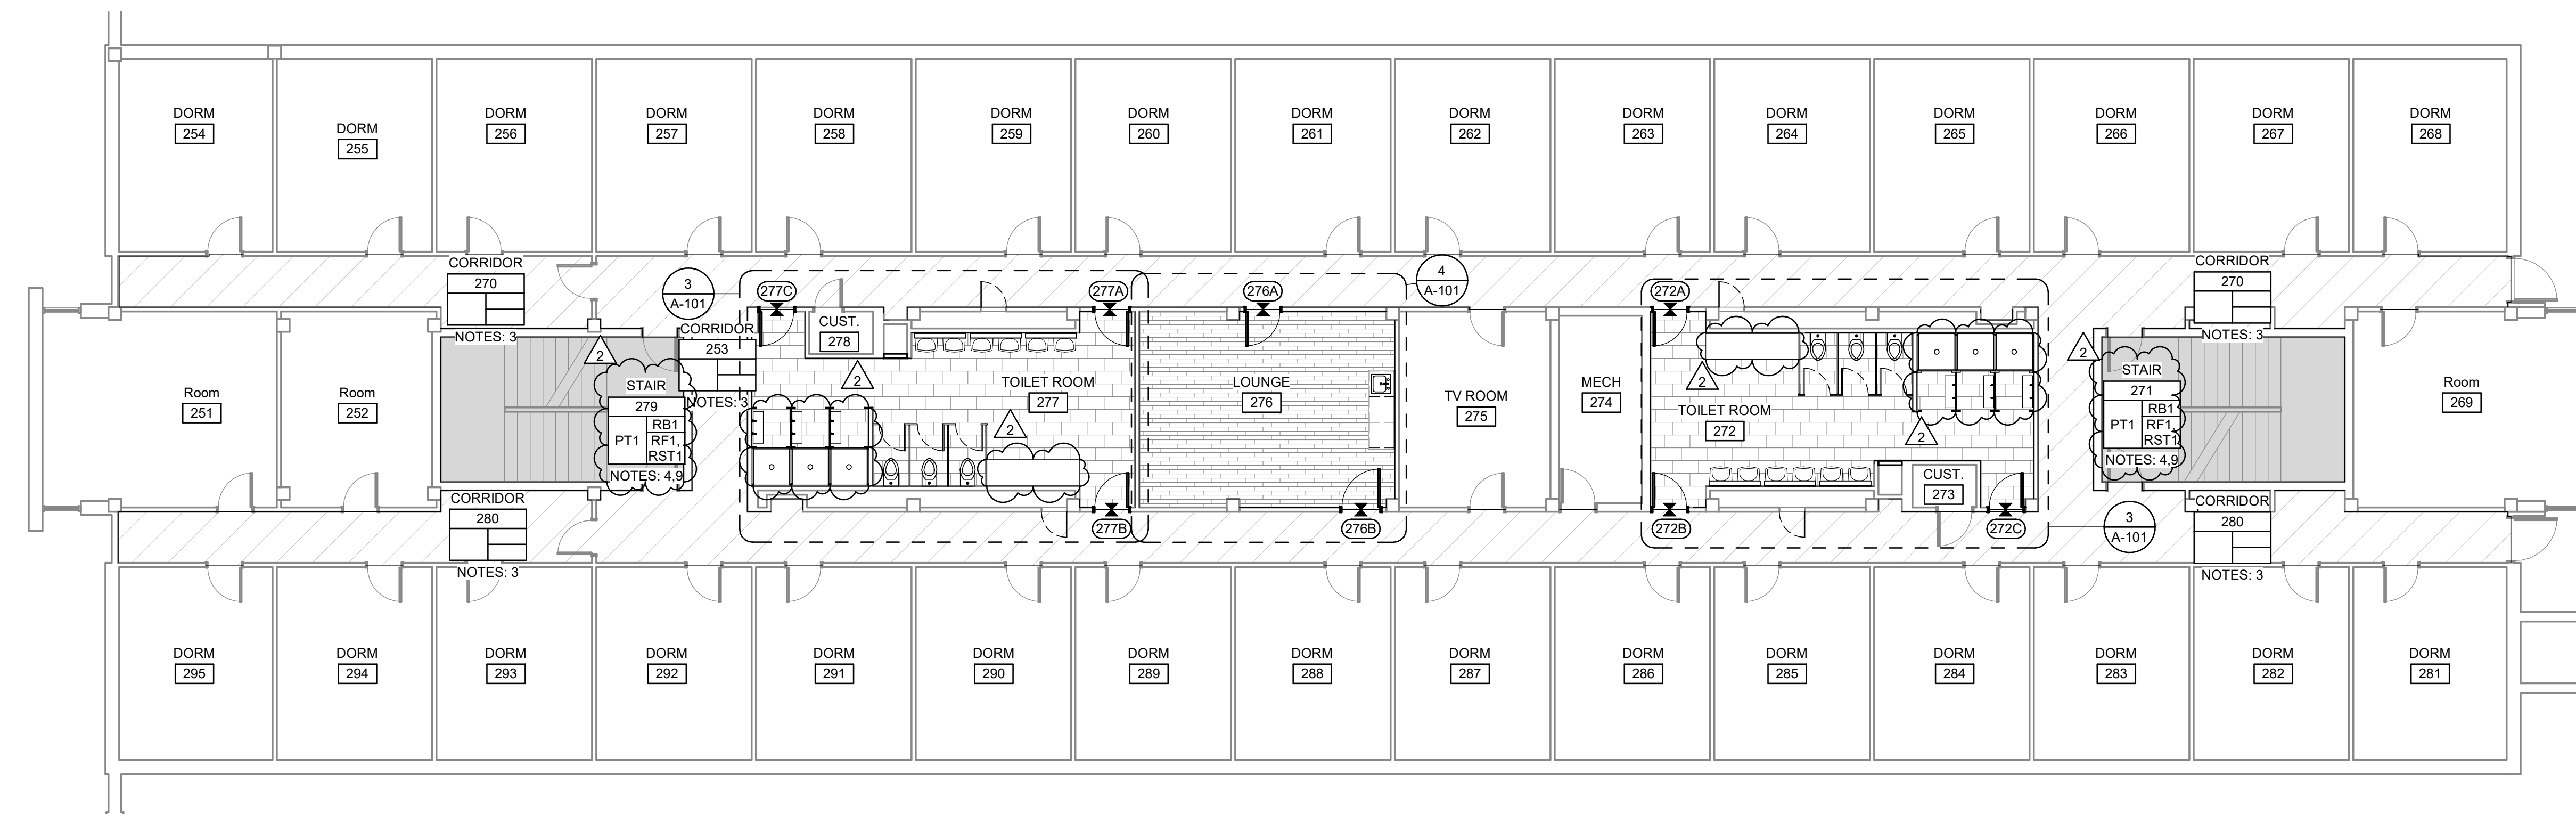

2 SECOND FLOOR PLAN - DOBSON
1/8" = 1'-0"

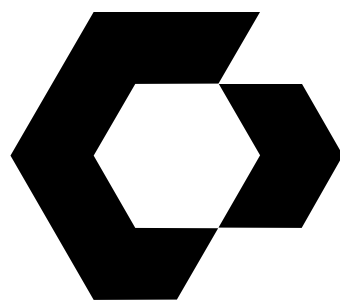

CYNERGY
810 S CINCINNATI AVE, STE 200
TULSA, OK 74119
918.877.6000

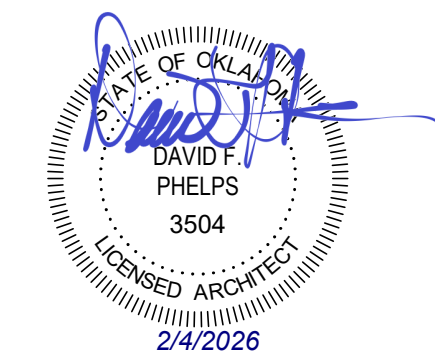

DAVID F. PHELPS, AIA
ARCHITECT OF RECORD

HARRILL-DOBSON INTERIOR
UPGRADES
NORTHEASTERN OKLAHOMA A&M COLLEGE
2001 STREET NORTHEAST
MARIETTA, OK 74304

THIS DRAWING WAS PREPARED SOLELY AND EXCLUSIVELY FOR EXECUTION OF THE PROJECT IDENTIFIED WITHIN THESE DOCUMENTS. IT IS THE PROPERTY OF THE ARCHITECT. NO PART OF THIS DRAWING MAY BE REPRODUCED OR TRANSMITTED IN ANY FORM OR BY ANY MEANS, ELECTRONIC OR MECHANICAL, WITHOUT THE WRITTEN PERMISSION OF THE ARCHITECT. THE ARCHITECT AND THE ARCHITECT'S CONSULTANTS ARE THE AUTHORS AND OWNERS OF THEIR RESPECTIVE DRAWINGS AND SPECIFICATIONS, AND RETAIN ALL COMMON LAW, STATUTORY, AND OTHER RIGHTS, INCLUDING COPYRIGHTS.

ISSUES / REVISIONS

NO.	DATE	DESCRIPTION
1	03/29/2023	ISSUE FOR CONSTRUCTION
2	04/06/2023	AS 1
3	02/04/2026	AS 2

ISSUE DATE: 03/29/2023
CHECKED BY: EW
DRAWN BY: JD

SHEET NAME
THIRD FLOOR AND FINISH PLAN

SHEET NUMBER


A-103

SPECIALTY AND EQUIPMENT SCHEDULE				
TYPE MARK	DESCRIPTION	MANUFACTURER	MODEL	RESPONSIBILITY
AD1	PLUMBING ACCESS DOOR	NYSTROM	24" X 24", PAINTED TO MATCH ADJACENT FINISH	CPCI
M1	CHANNEL-FRAMED MIRROR/SHELF COMBINATION	GAMCO	G-C-MIRROR, 18X36, 166-30-45, INCLUDE ATTACHED SHELF ENTIRE LENGTH OF MIRROR, ARCHSPEC QUOTE NUMBER: 9314282-1; CONTACT: NIKKI DOUGLAS nkdougl@archspecsales.com	CPCI
M2	TEMPERED GLASS WITH PENCIL EDGE; INSTALL WITH CHANNEL AND CONSTRUCTION ADHESIVE AS REQUIRED		72"W X 36"H, RE-INTERIOR ELEVATIONS	CPCI
PSS1	PLASTIC SHOWER STALL	SCRANTON	FOR INSTALLATION WITH FLANGED SHOWER BASE, SB1. SOLID PLASTIC SHOWER STALLS; COLOR: SIDE AND FRONT PANELS TO BE SHALE, BACK PANEL TO BE LINEN, DRESSING COMPARTMENT PANELS TO BE SHALE; RE: SA-603. INSTALL WITH SHOWER CURTAIN AND SHOWER CURTAIN RINGS, COAT HOOK, RH1, AND FLOOR MOUNTED SEAT, ST1. WHERE INDICATED, INSTALL WITH PLASTIC PLASTER SHOES; CONTRACTOR TO ENSURE WATERPROOFING OF SHOWER PARTITION WALLS AND INSTALLATION WITH SHOWER BASE.	CPCI
RH1	ROBE HOOK	SCRANTON	ROBE HOOKS; INCLUDED WITH SHOWER PARTITION ACCESSORIES; INSTALL AT 48" AFF	CPCI
SB1	SHOWER BASE	ACORN	36"X36" TERRAZZO SHOWER BASE, 3 FLANGE, MODEL: SBS-36-3F; COLOR: PLATINUM GREY/OCTO; INSTALL WITH ACCESSORY KKO2 RUBBER DRAIN GASKET FOR 2" WASTE PIPE	CPCI
ST1	SHOWER SEAT	SCRANTON	FLOOR MOUNTED SHOWER SEAT; INCLUDED WITH SHOWER PARTITION ACCESSORIES	CPCI
TP1	TOILET PARTITIONS	SCRANTON	HINXY HIDERS SOLID PLASTIC; FLOOR MOUNTED, OVERHEAD BRACED; COLOR: SHALE	CPCI


FINISH MATERIAL LEGEND	
MARK	DESCRIPTION
BASE	JOHNSONITE; TRADITIONAL WALL BASE; 4" HIGH CONTINUOUS ROLL; COLOR: 20 CHARCOAL
RB1	JOHNSONITE; TRADITIONAL WALL BASE; 4" HIGH CONTINUOUS ROLL; COLOR: 20 CHARCOAL
LV1	SHAW CONTRACT; COVE; COLOR: PLASTER; SIZE: 8" X 48"
RE1	TARGETT/JOHNSONITE; 24" X 24" RUBBER TILE; COLOR: 20 CHARCOAL
RSS1	TARGETT/JOHNSONITE; RUBBER STAIR STRINGER; COLOR: 20 CHARCOAL
RST1	TARGETT/JOHNSONITE; ANGLED RUBBER STAIR TREAD WITH INTEGRATED RISER FOR THE VISUALLY IMPAIRED; GRIT TAPE; TEXTURE: RAISED ROUND; COLOR: 20 CHARCOAL
THRESHOLD/TRANSITION	
MTH1	DAL TILE; MARBLE THRESHOLD; DOUBLE HOLLYWOOD BEVEL; COLOR: CARRARA WHITE MARBLE M701-POLISHED; SIZE: 4"
TILE	
T1	CROSSVILLE; SHADES 2.0; COLOR: FOG UPS; SIZE: 12"X24"; INSTALLATION: TO BE DETERMINED BY OWNER
T2	CROSSVILLE; SHADES 2.0; COLOR: HAZE UPS; SIZE: 12"X24"; INSTALLATION: TO BE DETERMINED BY OWNER
CEILING TILE	
CT1	USG; SHEETROCK BRAND LAY-IN GYPSUM CEILING PANELS 3260; 2X2; COLOR: WHITE; GRID: DXLA; GRID COLOR: WHITE
MILLWORK	
PL1	CORIAN; COLOR: LINEN
PL2	CORIAN; COLOR: DPG-66 SHARROW; MATTE FINISH
SS1	CORIAN; COLOR: ARTISTA CANVAS
PAINT	
PT1	SHERWIN WILLIAMS; COLOR: SW 9165 GOSSAMER VEIL; COMMENTS: GENERAL WALL PAINT
PT2	SHERWIN WILLIAMS; COLOR: SW 7069 IRON ORE; COMMENTS: TRIM AND DOOR PAINT

GENERAL FINISH NOTES	
A.	HAZARDOUS MATERIALS ARE SUSPECTED AT THE JOB SITE IN THE FORM OF ASBESTOS CONTAINING MATERIALS (ACM). THERE IS SUSPECT FLOOR TILE AND/OR MASTIC MATERIAL THAT MAY REQUIRE FURTHER IDENTIFICATION AND TESTING FOR CONTENT OF ASBESTOS. SHOULD THIS MATERIAL BE IDENTIFIED AS PRESENT, IT IS RECOMMENDED THAT PROPER ABATEMENT PROCEDURES BE FOLLOWED AS APPROPRIATE. CONTRACTOR TO PROVIDE ASBESTOS REVIEW PRIOR TO BEGINNING WORK. CONTRACTOR SHALL MAKE IDENTIFIED AREAS READY FOR NEW CONSTRUCTION AND APPLICATION OF NEW FINISHES ACCORDINGLY.
B.	RE: 3/A-101 FOR TYPICAL RESTROOM FLOOR AND FINISH PLAN.
C.	RE: 4/A-101 FOR TYPICAL LOUNGE FLOOR AND FINISH PLAN.
D.	MATERIAL PATTERNS ON DRAWINGS DO NOT INDICATE PRODUCT INSTALLATION; IF UNCLER IN NOTES OR ON FINISH PLAN, VERIFY FLOOR PATTERN DIRECTION PRIOR TO INSTALLATION.
E.	CASEWORK TO BE INSTALLED BEFORE RUBBER BASE. COORDINATE INSTALLATION OF RUBBER BASE AT WALLS AND INSTALL AROUND CASEWORK.
F.	CONTRACTOR TO VERIFY ALL EXISTING DIMENSIONS.
G.	PAINT ALL INTERIOR SOFFITS PT1.
H.	PAINT DOORS AND FRAMES PT2.
I.	FLOORING TRANSITIONS TO BE INSTALLED UNDER CENTER OF DOORS, UNLESS NOTED OTHERWISE.
J.	INSTALL NEW WALL TILE OVER EXISTING GLAZED CMU BLOCK UNLESS NOTED OTHERWISE. CONTRACTOR TO USE ADHESIVE/MORTAR APPROPRIATE FOR THIS CONDITION.
K.	INSTALL NEW LVT FLOORING OVER EXISTING FLOORING UNLESS NOTED OTHERWISE.
L.	DO NOT INSTALL TILE BEHIND SHOWER STALLS, PSS1; PAINT WALL ABOVE SHOWER STALLS PT1.
M.	CONTRACTOR TO MEASURE CLEAR SPACE IN EACH RESTROOM FOR SHOWER INSTALLATION BEFORE ORDERING SHOWER BASES. IF OPENING IS LESS THAN 9'-1 3/4", ALERT ARCHITECT FOR RESOLUTION.


ALTERNATES	
ALTERNATE 1	REMOVE CORRIDOR AND DORM ROOM WALL BASE IN ITS ENTIRETY. PREPARE EXISTING FLOORING FOR NEW LVT FLOORING AND RUBBER BASE INSTALLATION. RE: GENERAL DEMO NOTE 8.
ALTERNATE 2	DEMOLITION AND INSTALLATION OF STAIR TREADS AND RISERS
ALTERNATE 3	DEMOLITION AND UPDATES TO LOUNGE AREAS INCLUDING, BUT NOT LIMITED TO, DOORS, FLOORING AND WALL BASE, CASEWORK, AND WALL PAINT.
ALTERNATE 4	VANITY AND MIRROR, M2, INSTALLATION IN RESTROOMS

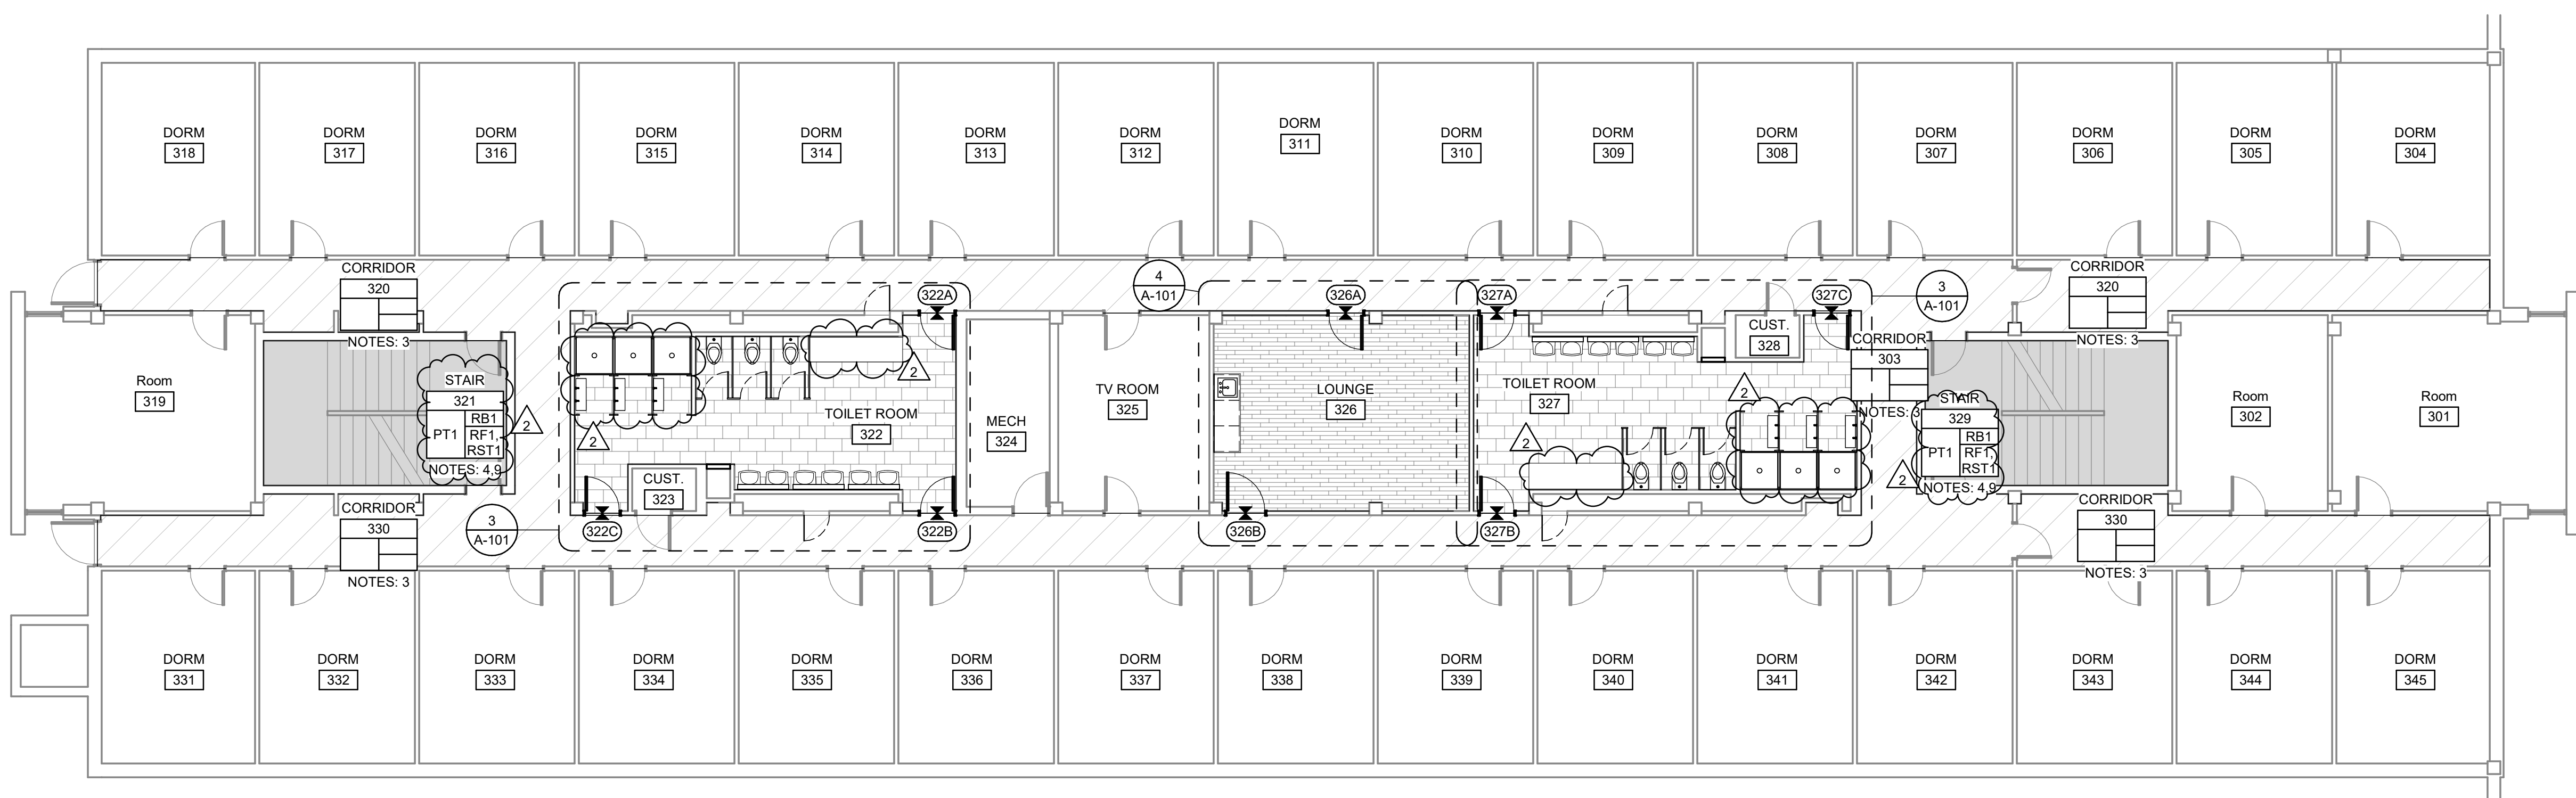


1 THIRD FLOOR PLAN - HARRILL
1/8" = 1'-0"

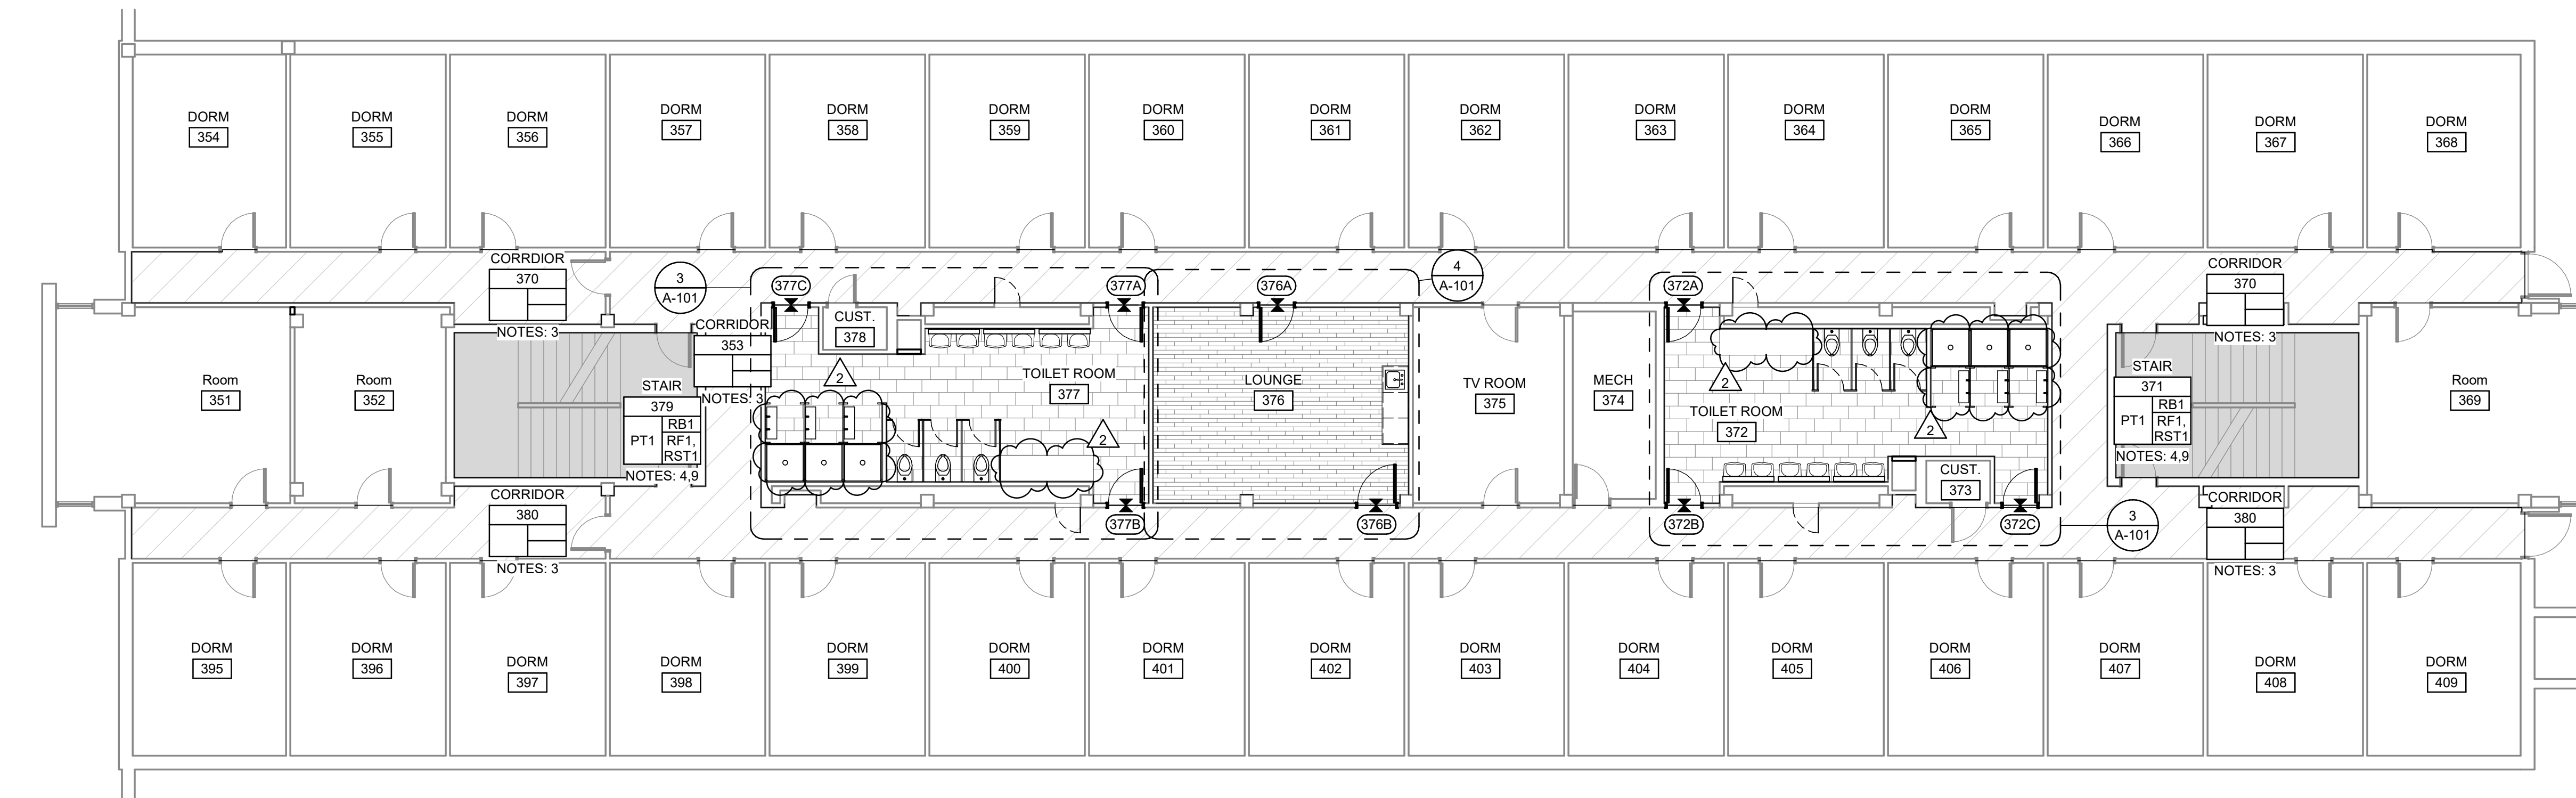

2 THIRD FLOOR PLAN - DOBSON
1/8" = 1'-0"

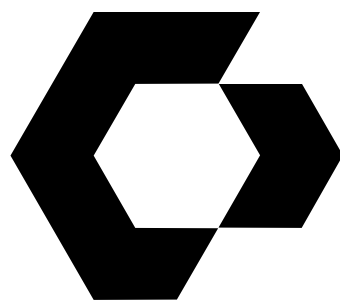

CYNERGY
810 S CINCINNATI AVE, STE 200
TULSA, OK 74119
918.577.5000

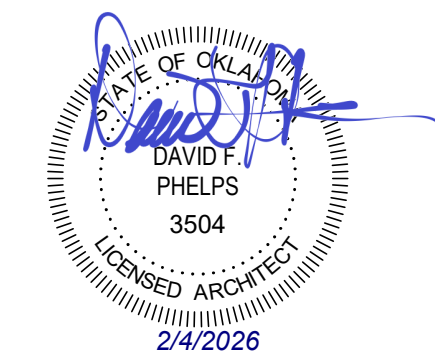

DAVID F. PHELPS, AIA
ARCHITECT OF RECORD

HARRILL-DOBSON INTERIOR
UPGRADES
NORTHEASTERN OKLAHOMA A&M COLLEGE
2001 STREET NORTHEAST
MUSKOGEE, OK 74454

THIS DRAWING WAS PREPARED SOLELY AND EXCLUSIVELY FOR EXECUTION OF THE PROJECT IDENTIFIED WITHIN THESE DOCUMENTS. IT IS THE PROPERTY OF CYNERGY AND SHALL REMAIN THE PROPERTY OF CYNERGY. IT IS TO BE USED ONLY FOR THE PROJECT AND FOR ADDITIONS TO THE PROJECT OUTSIDE THE SCOPE OF WORK WITHOUT WRITTEN CONSENT OF THE OWNER, ARCHITECT, AND THE ARCHITECT'S CONSULTANTS. THE ARCHITECT AND THE ARCHITECT'S CONSULTANTS ARE THE AUTHORS AND OWNERS OF THEIR RESPECTIVE DRAWINGS AND SPECIFICATIONS, AND RETAIN ALL COMMON LAW, STATUTORY, AND OTHER RIGHTS, INCLUDING COPYRIGHTS.

ISSUES / REVISIONS	
03/29/2023	ISSUE FOR CONSTRUCTION

ISSUE DATE: 03/29/2023
CHECKED BY: EW
DRAWN BY: JD

SHEET NAME
FIRST FLOOR REFLECTED
CEILING PLAN

SHEET NUMBER


A-111

CEILING PLAN LEGEND

- EXISTING SUSPENDED CEILING
- NEW 2' x 2' SUSPENDED CEILING
- NEW GYPSUM CEILING
- NEW LAY-IN LIGHT FIXTURE
- NEW RECESSED LIGHT FIXTURE
- NEW VANITY LIGHT FIXTURE
- OCCUPANCY SENSOR
- EMERGENCY LIGHT
- MATERIAL
CEILING INDICATOR
HEIGHT
- ROOM NAME
ROOM IDENTIFIER
- NEW EXHAUST GRILLE; RE: MECH
- PARTITION TYPE A, EXTENDS
TO BOTTOM OF CEILING GRID;
RE FLOOR PLANS FOR
LOCATIONS


GENERAL RCP NOTES

- RE-3/A-111 FOR TYPICAL RESTROOM REFLECTED CEILING PLAN PLAN.
- MATCH EXISTING HEIGHT WHEN INSTALLING NEW CEILING TILES AND GRID, UNLESS NOTED OTHERWISE.
- CEILING MOUNTED FIXTURES TO BE CENTERED IN TILE UNLESS NOTED OTHERWISE.
- PROVIDE EXPOSED TEES AROUND ELECTRICAL FIXTURES, MECHANICAL GRILLES AND DIFFUSERS, ETC.
- MAINTAIN 3" MINIMUM WIDTH FOR CEILING TILE AT ROOM PERIMETER.
- REFER TO MECHANICAL SHEETS FOR MECHANICAL INFORMATION.
- PAINT ALL INTERIOR SOFFITS PT1.

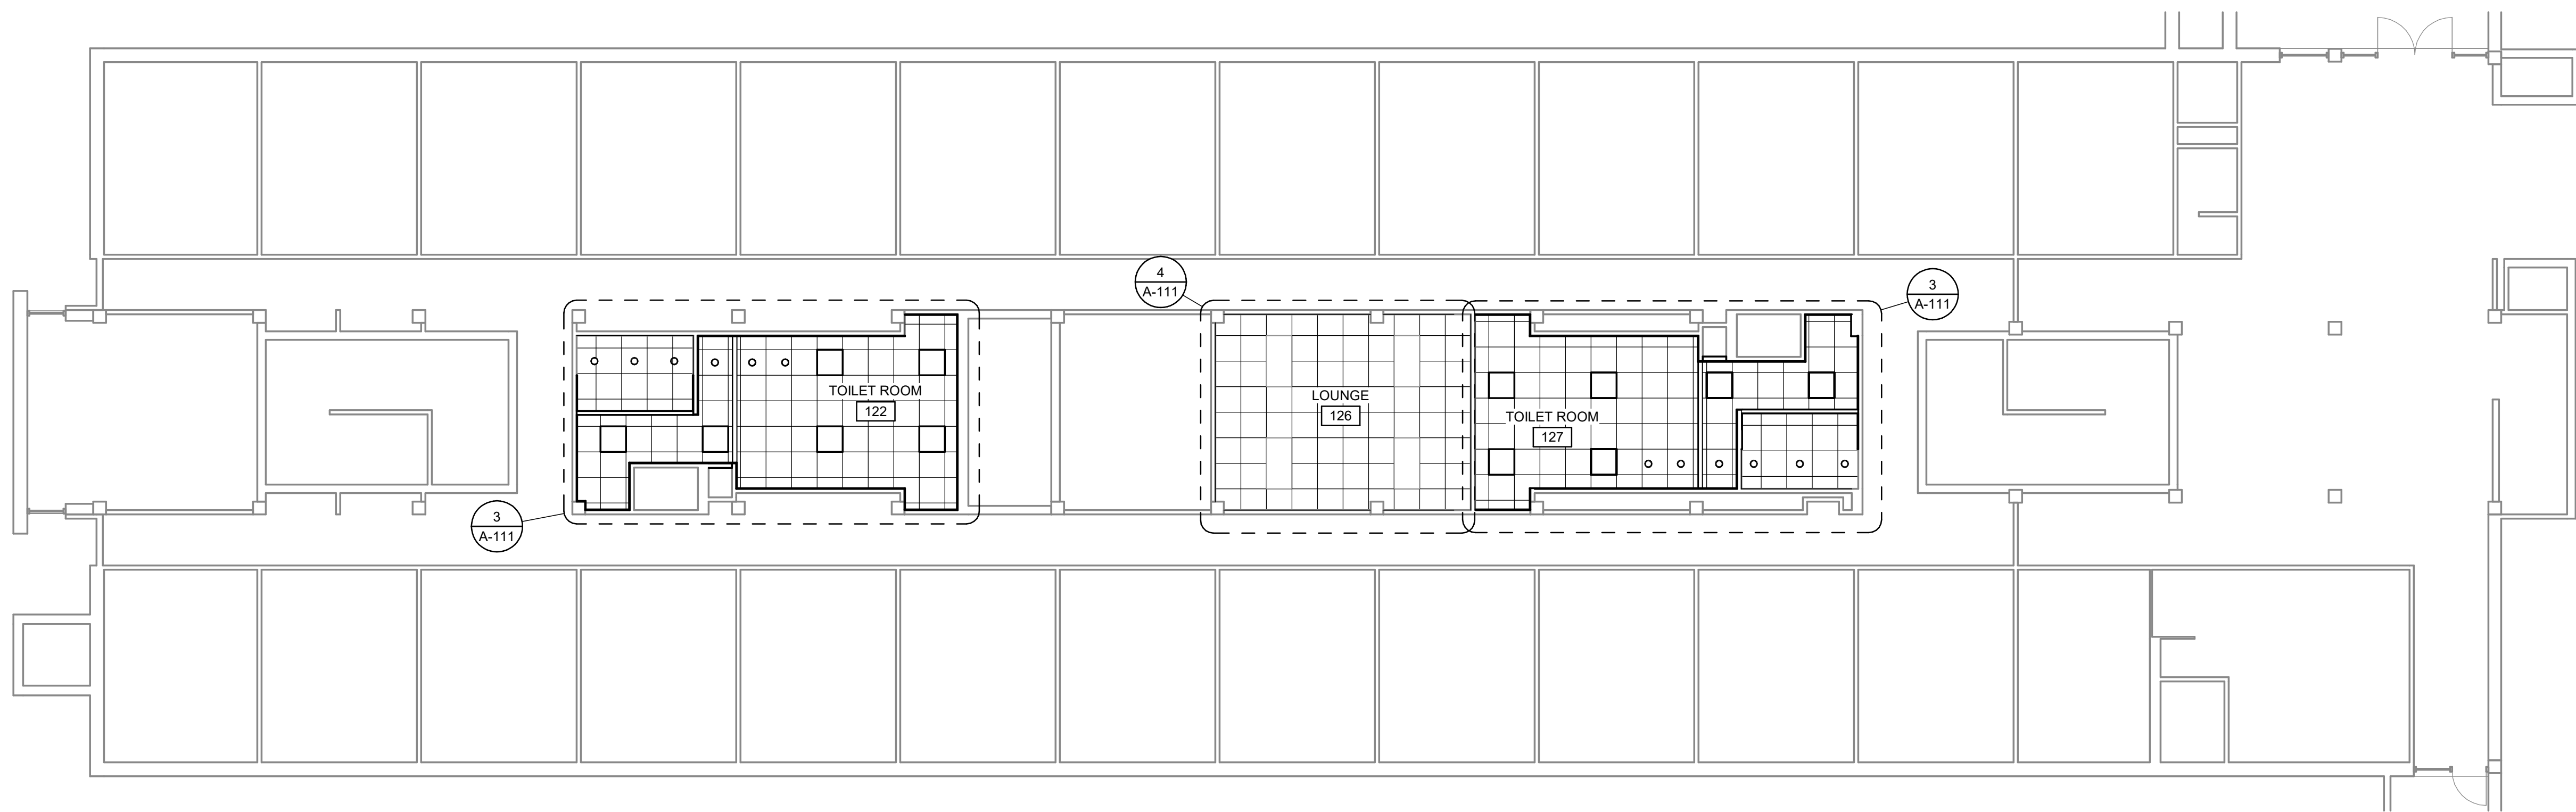

1 FIRST FLOOR RCP - HARRILL

1/8" = 1'-0"

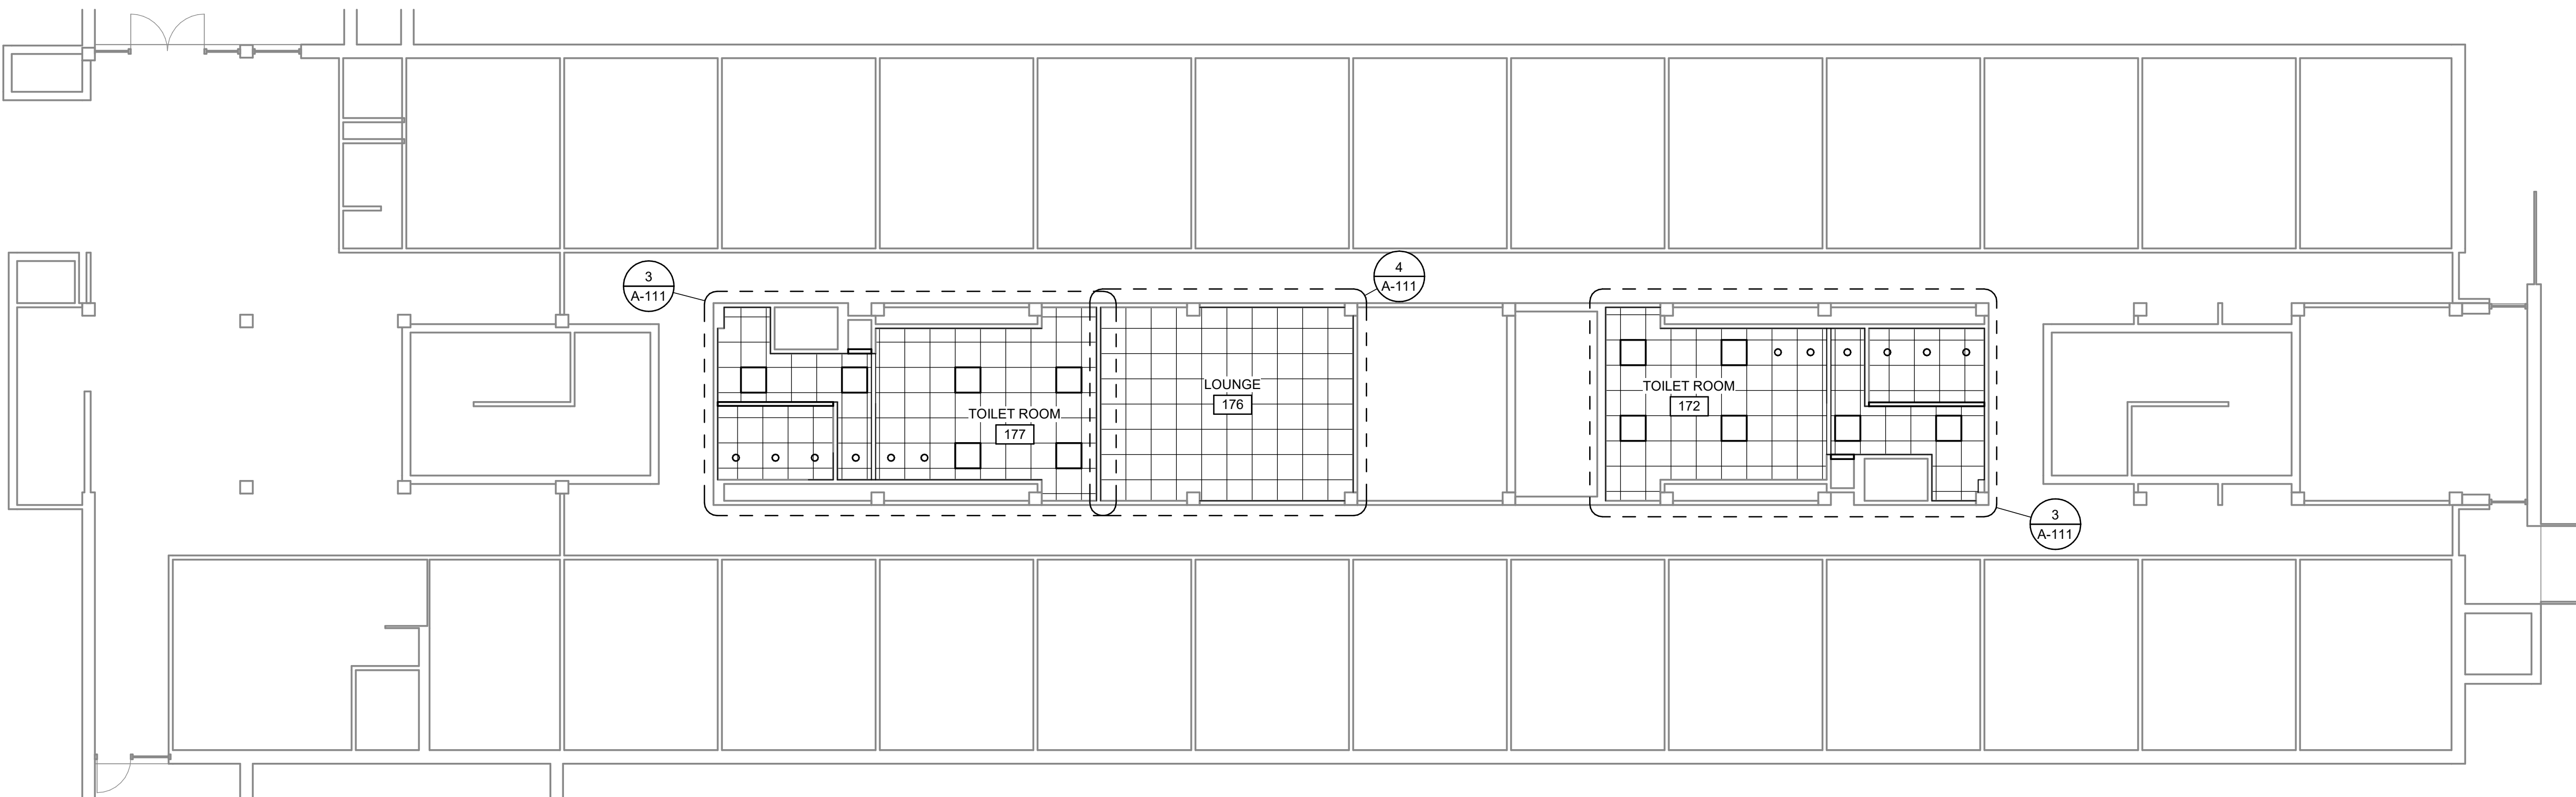

2 FIRST FLOOR RCP - DOBSON


1/8" = 1'-0"

LIGHTING (AS NOTED BELOW OR APPROVED EQUALS)

- A: 2x2' LED PANEL - ATLAS LIGHTING: FAELP 22 LED U
B: VANITY LIGHT - METALUX: 4BCLED LD4 20SL F UNV L840 CD 1
C: RECESSED DOWNLIGHT - HALO: PR6 FS12 D010 HB128APK PR6M 12 MD 8FS MW (1500LM, 4000K)
D: EMERGENCY LIGHT - MULE LIGHTING: SQ-LED W SD
S: LIGHT SWITCH (MATCH TYPE TO THAT OF EXISTING) - 20A, 120V TOGGLE SWITCH, GRAY FINISH WITH STAINLESS STEEL WALL PLATE.


GENERAL NOTES

- CONNECT NEW LIGHTING TO EXISTING LIGHTING CIRCUIT FOR THAT ROOM.
- CONNECT EMERGENCY LIGHTING (TYPE D) TO UNSWITCHED HOT LEG OF LIGHTING CIRCUIT FOR THAT ROOM.
- REUSE EXISTING WALL MOUNTED LIGHT FIXTURE ROUGH-IN LOCATIONS FOR NEW (TYPE B).
- REUSE EXISTING LIGHT SWITCH ROUGH-IN LOCATIONS FOR NEW. MATCH SWITCHING SCHEME TO THAT OF EXISTING.
- NO EXPOSED CONDUIT WILL BE ALLOWED.

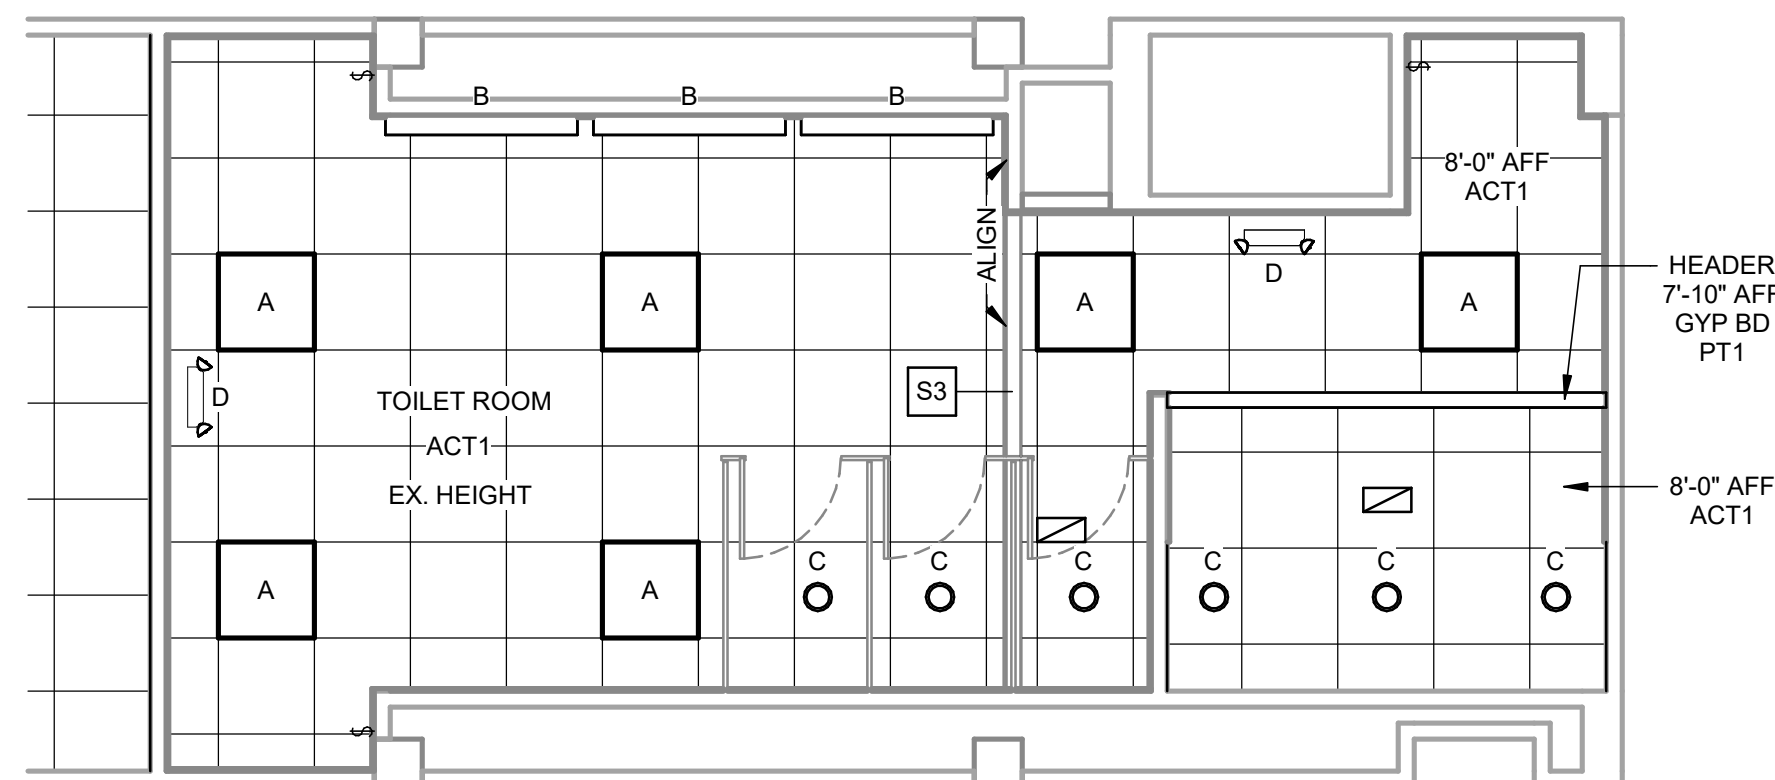


3 TYPICAL RESTROOM REFLECTED CEILING PLAN

1/4" = 1'-0"

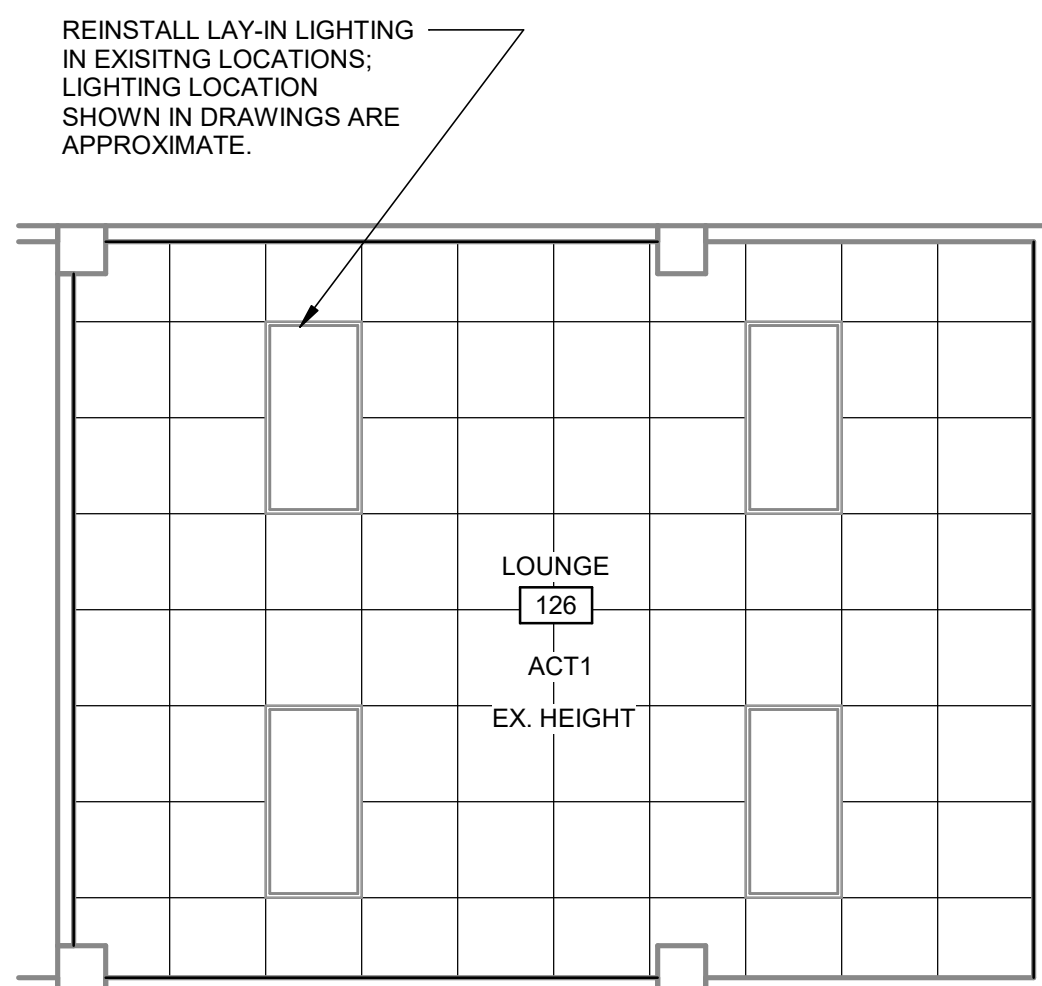


4 TYPICAL LOUNGE REFLECTED CEILING PLAN

1/4" = 1'-0"

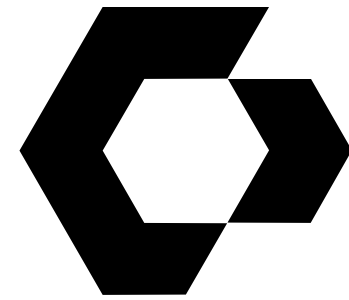

CYNTERGY
810 S CINCINNATI AVE, STE 200
TULSA, OK 74119
918.577.6000

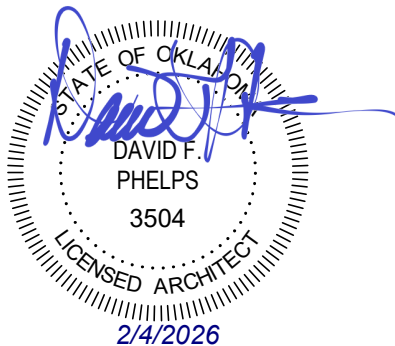

DAVID F. PHELPS, AIA
ARCHITECT OF RECORD

HARRILL-DOBSON INTERIOR
UPGRADES
NORTHEASTERN OKLAHOMA A&M COLLEGE
2001 STREET NORTHEAST
MARIETTA, OK 74354

THIS DRAWING WAS PREPARED SOLELY AND EXCLUSIVELY FOR EXECUTION OF THE PROJECT IDENTIFIED WITHIN THESE DOCUMENTS CONTAINED HEREIN. IT IS THE SOLE PROPERTY OF THE ARCHITECT AND IS NOT TO BE REPRODUCED OR TRANSMITTED IN ANY FORM OR BY ANY MEANS, ELECTRONIC OR MECHANICAL, INCLUDING PHOTOCOPYING, RECORDING, OR BY ANY INFORMATION STORAGE AND RETRIEVAL SYSTEM, WITHOUT THE WRITTEN CONSENT OF THE ARCHITECT. THE ARCHITECT AND THE ARCHITECT'S CONSULTANTS ARE THE AUTHORS AND OWNERS OF THEIR RESPECTIVE DRAWINGS AND SPECIFICATIONS, AND RETAIN ALL COMMON LAW, STATUTORY, AND OTHER RIGHTS, INCLUDING COPYRIGHTS.

ISSUES / REVISIONS

DATE	DESCRIPTION
03/29/2023	ISSUE FOR CONSTRUCTION

ISSUE DATE: 03/29/2023
CHECKED BY: EW
DRAWN BY: JD

SHEET NAME
SECOND FLOOR REFLECTED
CEILING PLAN

SHEET NUMBER


A-112

CEILING PLAN LEGEND


- EXISTING SUSPENDED CEILING
- NEW 2' x 2' SUSPENDED CEILING
- NEW GYPSUM CEILING
- NEW LAY-IN LIGHT FIXTURE
- NEW RECESSED LIGHT FIXTURE
- NEW VANITY LIGHT FIXTURE
- OCCUPANCY SENSOR
- EMERGENCY LIGHT
- MATERIAL CEILING INDICATOR HEIGHT
- ROOM NAME
101
- ROOM IDENTIFIER
- NEW EXHAUST GRILLE; RE: MECH
- PARTITION TYPE A, EXTENDS TO BOTTOM OF CEILING GRID; RE: FLOOR PLANS FOR LOCATIONS

GENERAL RCP NOTES

- RE: 3/A-111 FOR TYPICAL RESTROOM REFLECTED CEILING PLAN PLAN.
- MATCH EXISTING HEIGHT WHEN INSTALLING NEW CEILING TILES AND GRID, UNLESS NOTED OTHERWISE.
- CEILING MOUNTED FIXTURES TO BE CENTERED IN TILE UNLESS NOTED OTHERWISE.
- PROVIDE EXPOSED TEES AROUND ELECTRICAL FIXTURES, MECHANICAL GRILLES AND DIFFUSERS, ETC.
- MAINTAIN 3" MINIMUM WIDTH FOR CEILING TILE AT ROOM PERIMETER.
- REFER TO MECHANICAL SHEETS FOR MECHANICAL INFORMATION.
- PAINT ALL INTERIOR SOFFITS PT1.

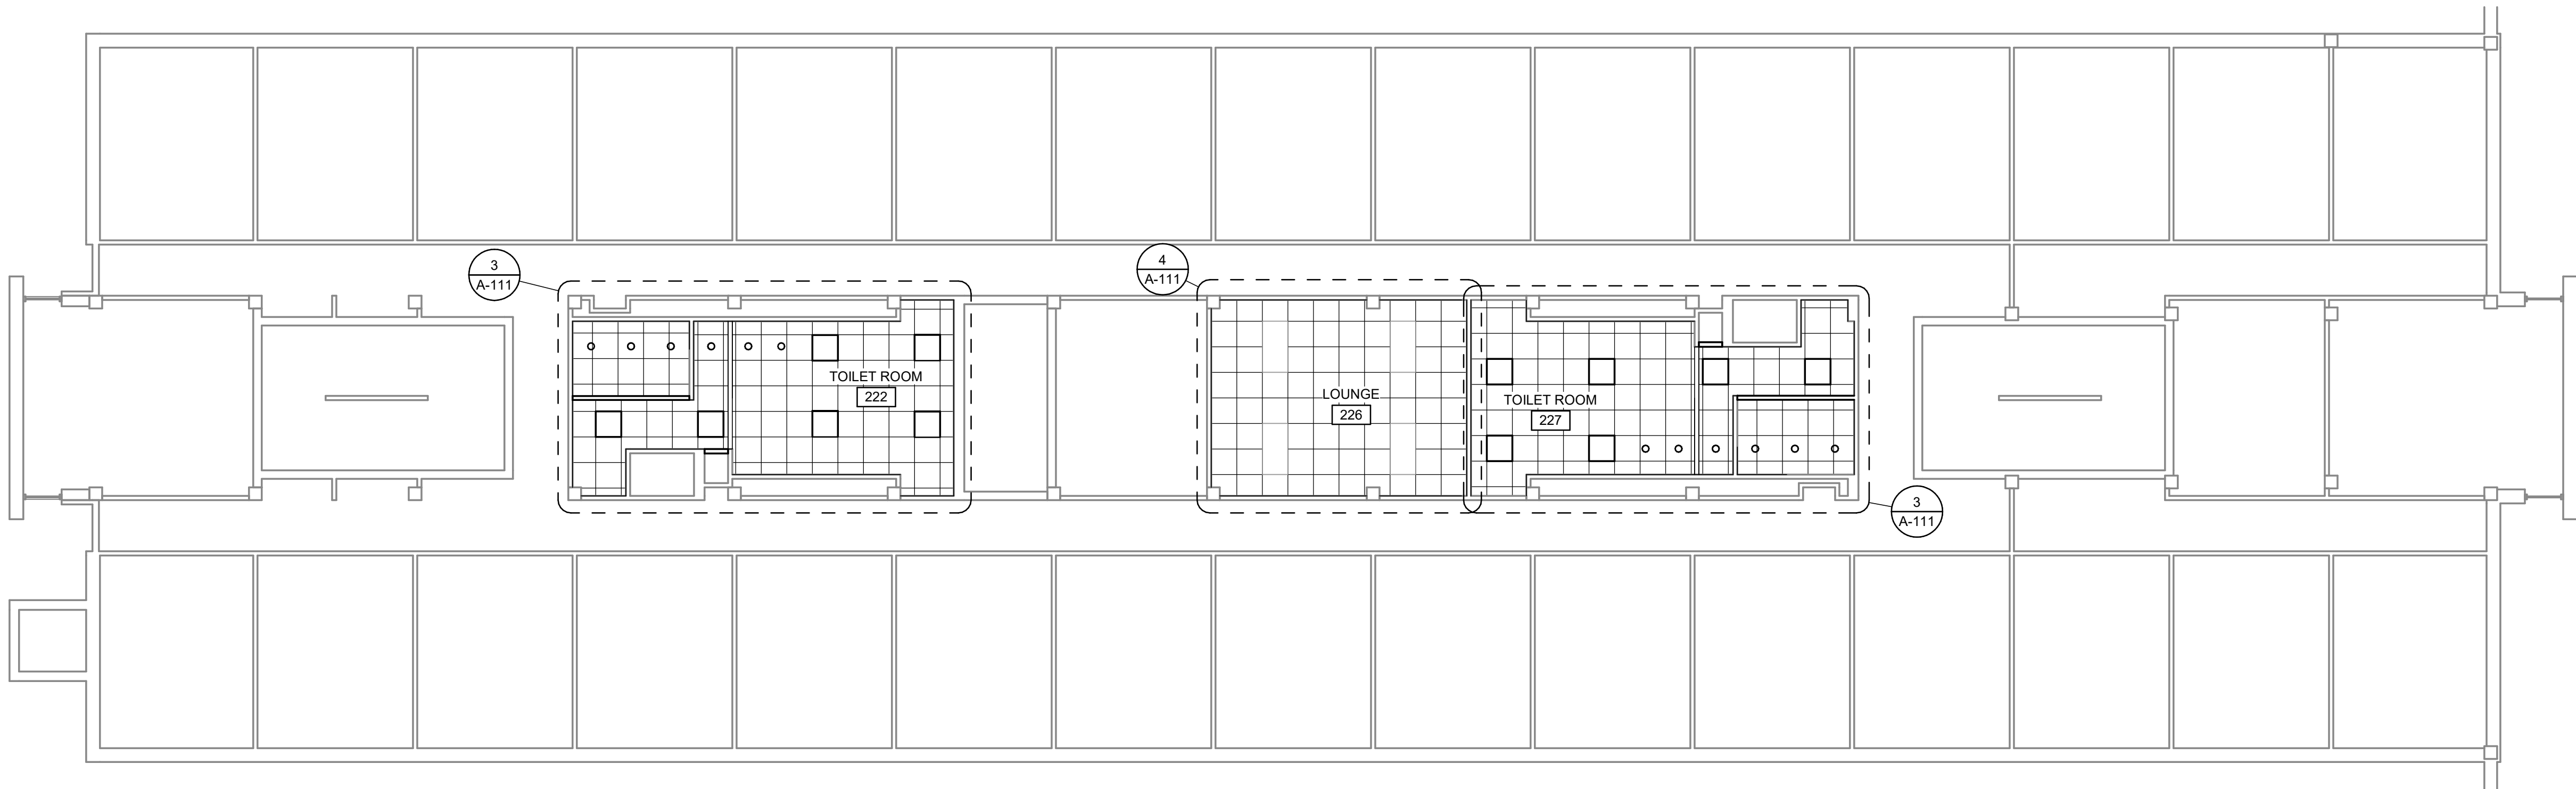


1 SECOND FLOOR RCP - HARRILL
1/8" = 1'-0"

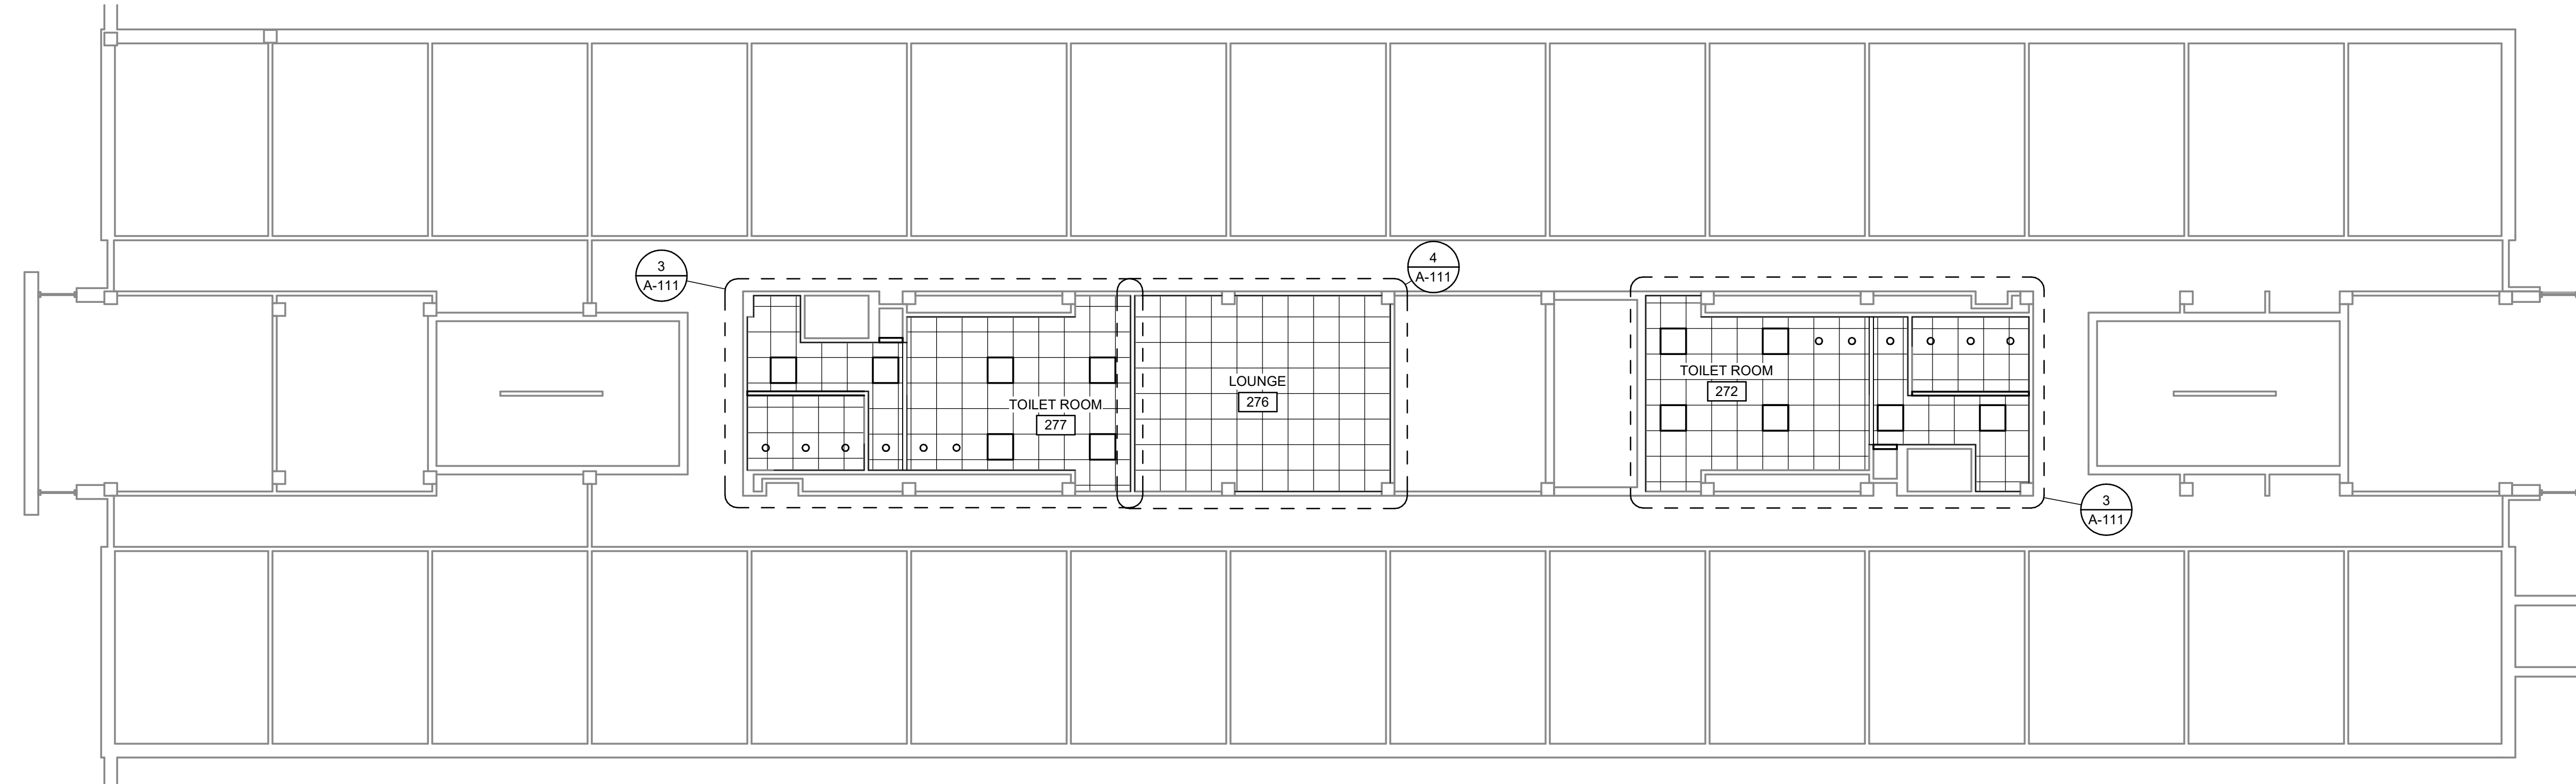


2 SECOND FLOOR RCP - DOBSON
1/8" = 1'-0"



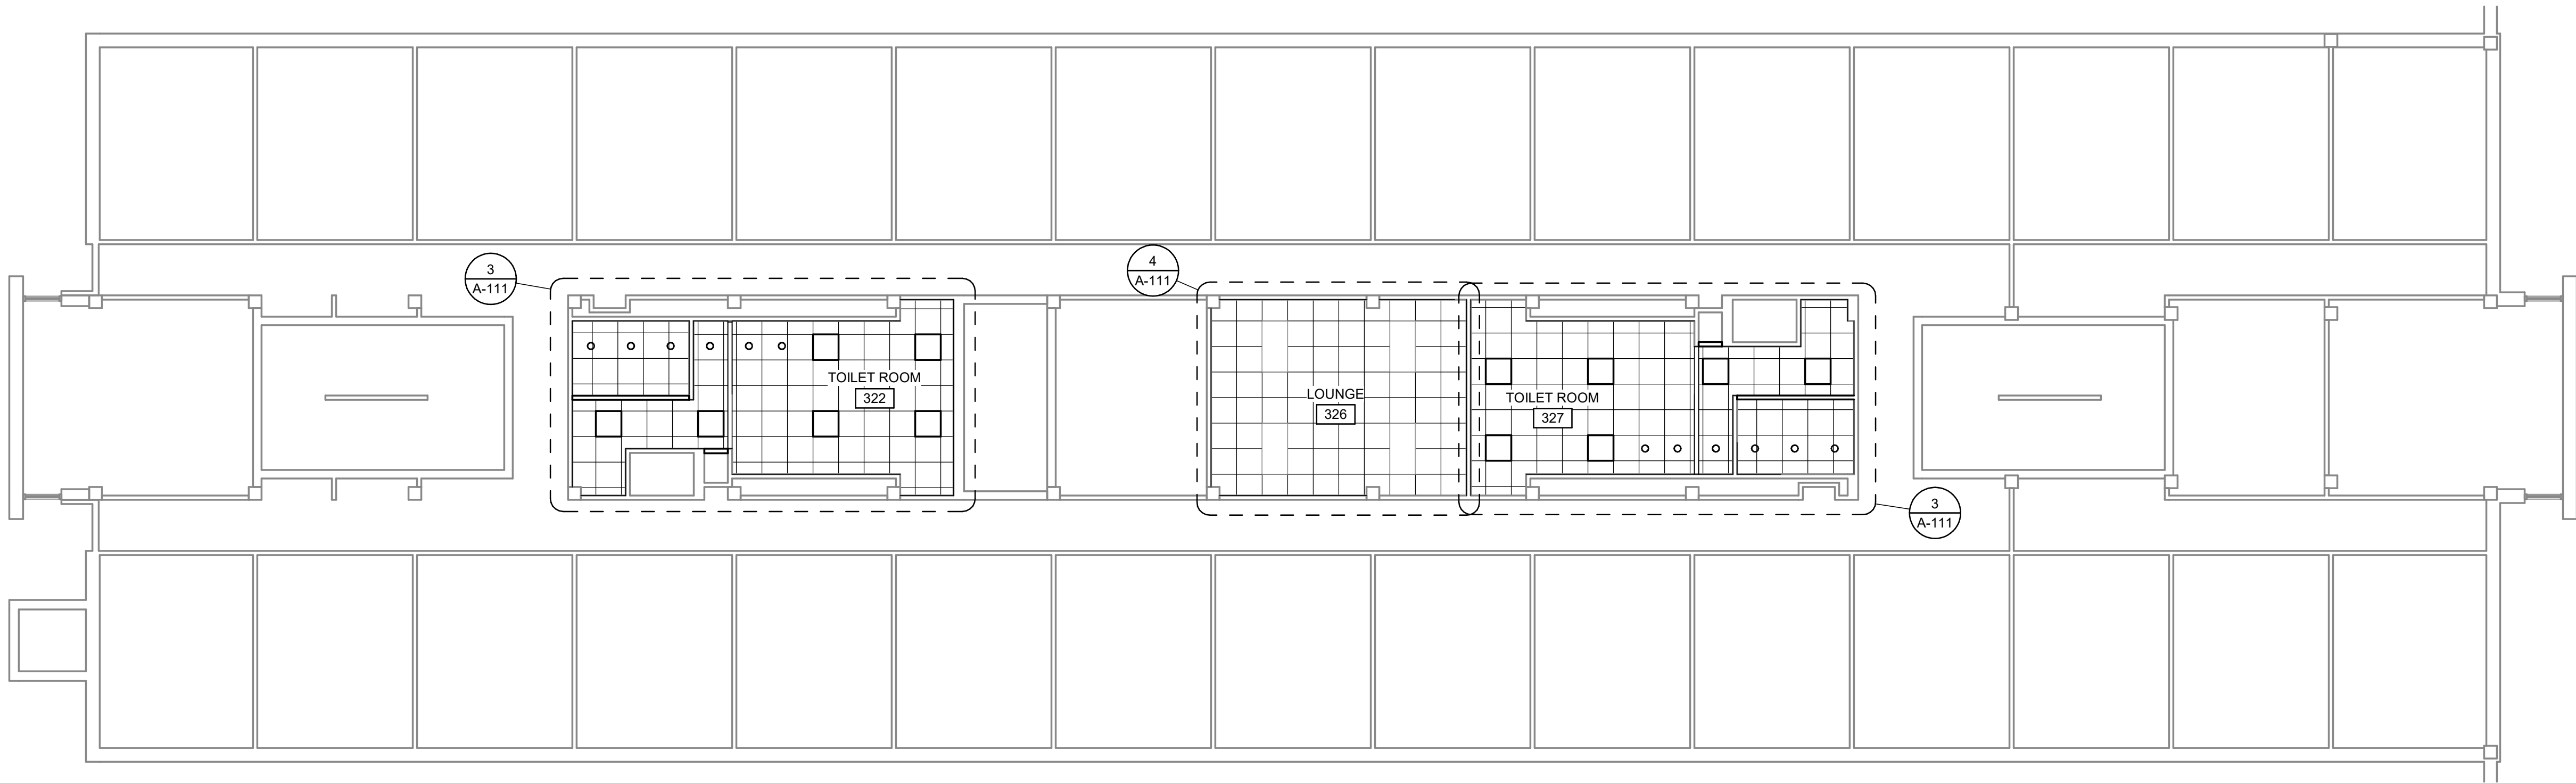

2 THIRD FLOOR RCP - HARRILL
1/8" = 1'-0"

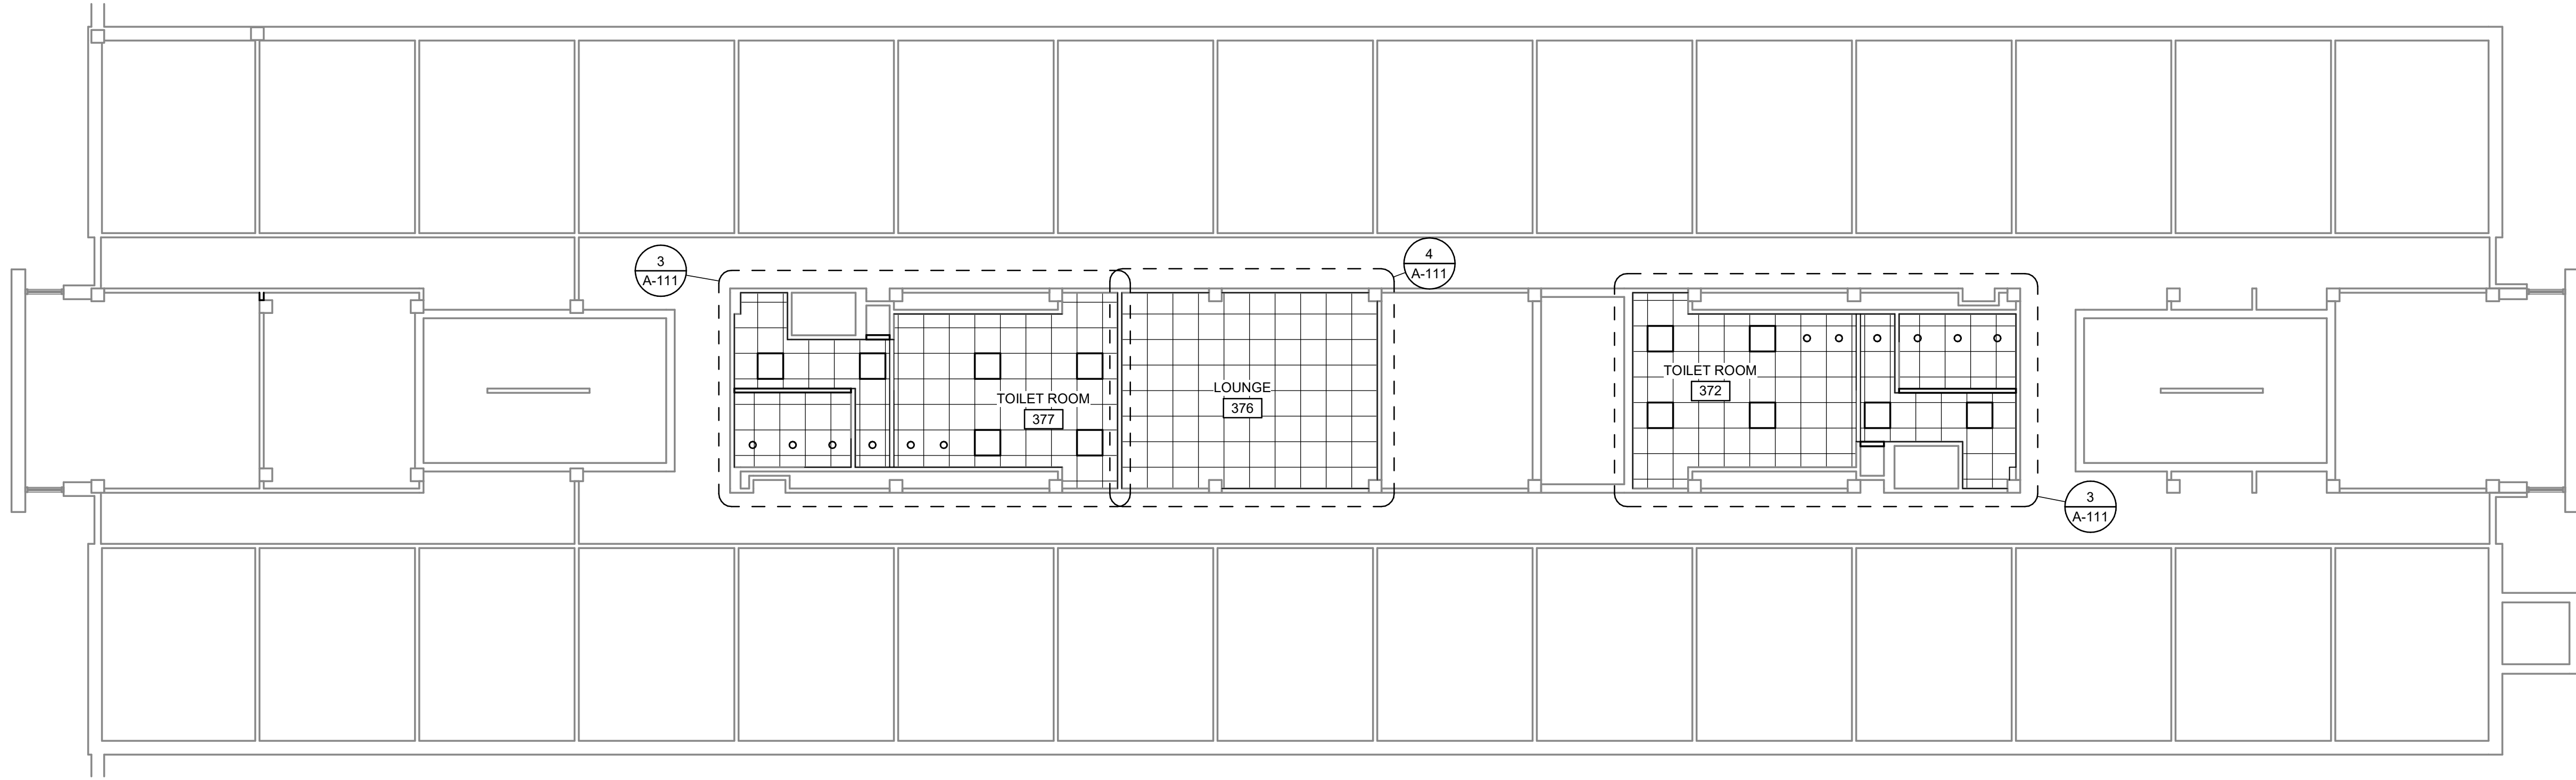


1 THIRD FLOOR RCP - DOBSON
1/8" = 1'-0"

CEILING PLAN LEGEND


- EXISTING SUSPENDED CEILING
- NEW 2' x 2' SUSPENDED CEILING
- NEW GYPSUM CEILING
- NEW LAY-IN LIGHT FIXTURE
- NEW RECESSED LIGHT FIXTURE
- NEW VANITY LIGHT FIXTURE
- OCCUPANCY SENSOR
- EMERGENCY LIGHT
- MATERIAL CEILING INDICATOR
- ROOM NAME
- ROOM IDENTIFIER
- NEW EXHAUST GRILLE; RE: MECH
- PARTITION TYPE A, EXTENDS TO BOTTOM OF CEILING GRID; RE: FLOOR PLANS FOR LOCATIONS

GENERAL RCP NOTES

- A. RE: 3/A-111 FOR TYPICAL RESTROOM REFLECTED CEILING PLAN PLAN.
- B. MATCH EXISTING HEIGHT WHEN INSTALLING NEW CEILING TILES AND GRID, UNLESS NOTED OTHERWISE.
- C. CEILING MOUNTED FIXTURES TO BE CENTERED IN TILE UNLESS NOTED OTHERWISE.
- D. PROVIDE EXPOSED TEES AROUND ELECTRICAL FIXTURES, MECHANICAL GRILLES AND DIFFUSERS, ETC.
- E. MAINTAIN 3" MINIMUM WIDTH FOR CEILING TILE AT ROOM PERIMETER.
- F. REFER TO MECHANICAL SHEETS FOR MECHANICAL INFORMATION.
- G. PAINT ALL INTERIOR SOFFITS PT1.

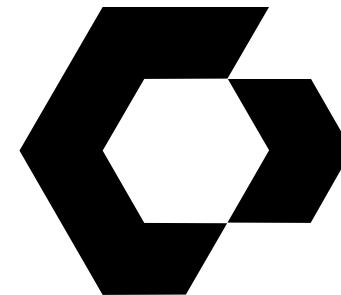

CYNERGY
810 S CINCINNATI AVE, STE 200
TULSA, OK 74119
918.877.6000

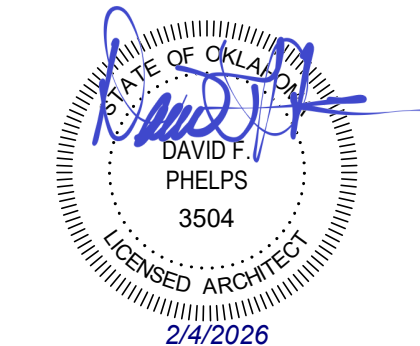

DAVID F. PHELPS, AIA
ARCHITECT OF RECORD

HARRILL-DOBSON INTERIOR
UPGRADES
NORTHEASTERN OKLAHOMA A&M COLLEGE
2001 STREET NORTHEAST
MARIETTA, OK 74304

THIS DRAWING WAS PREPARED SOLELY AND EXCLUSIVELY FOR EXECUTION OF THE PROJECT IDENTIFIED WITHIN THESE DOCUMENTS CONTAINED HEREIN. THIS DRAWING IS THE PROPERTY OF THE ARCHITECT AND THE ARCHITECT'S CONSULTANTS. THE ARCHITECT AND THE ARCHITECT'S CONSULTANTS ARE THE AUTHORS AND OWNERS OF THEIR RESPECTIVE DRAWINGS AND SPECIFICATIONS, AND RETAIN ALL COMMON LAW, STATUTORY, AND OTHER RIGHTS, INCLUDING COPYRIGHTS.

ISSUES / REVISIONS	
03/29/2023	ISSUE FOR CONSTRUCTION


ISSUE DATE: 03/29/2023
CHECKED BY: EW
DRAWN BY: JD

SHEET NAME
THIRD FLOOR REFLECTED
CEILING PLAN


SHEET NUMBER

A-113


Project Number: P00000.0000
Printed: 2/2/2026 2:07:03 PM
C:\Users\design1\Documents\Restroom-Dobson-Harrill Restroom Renovation_Arch_2023_dwg\A-603.dwg

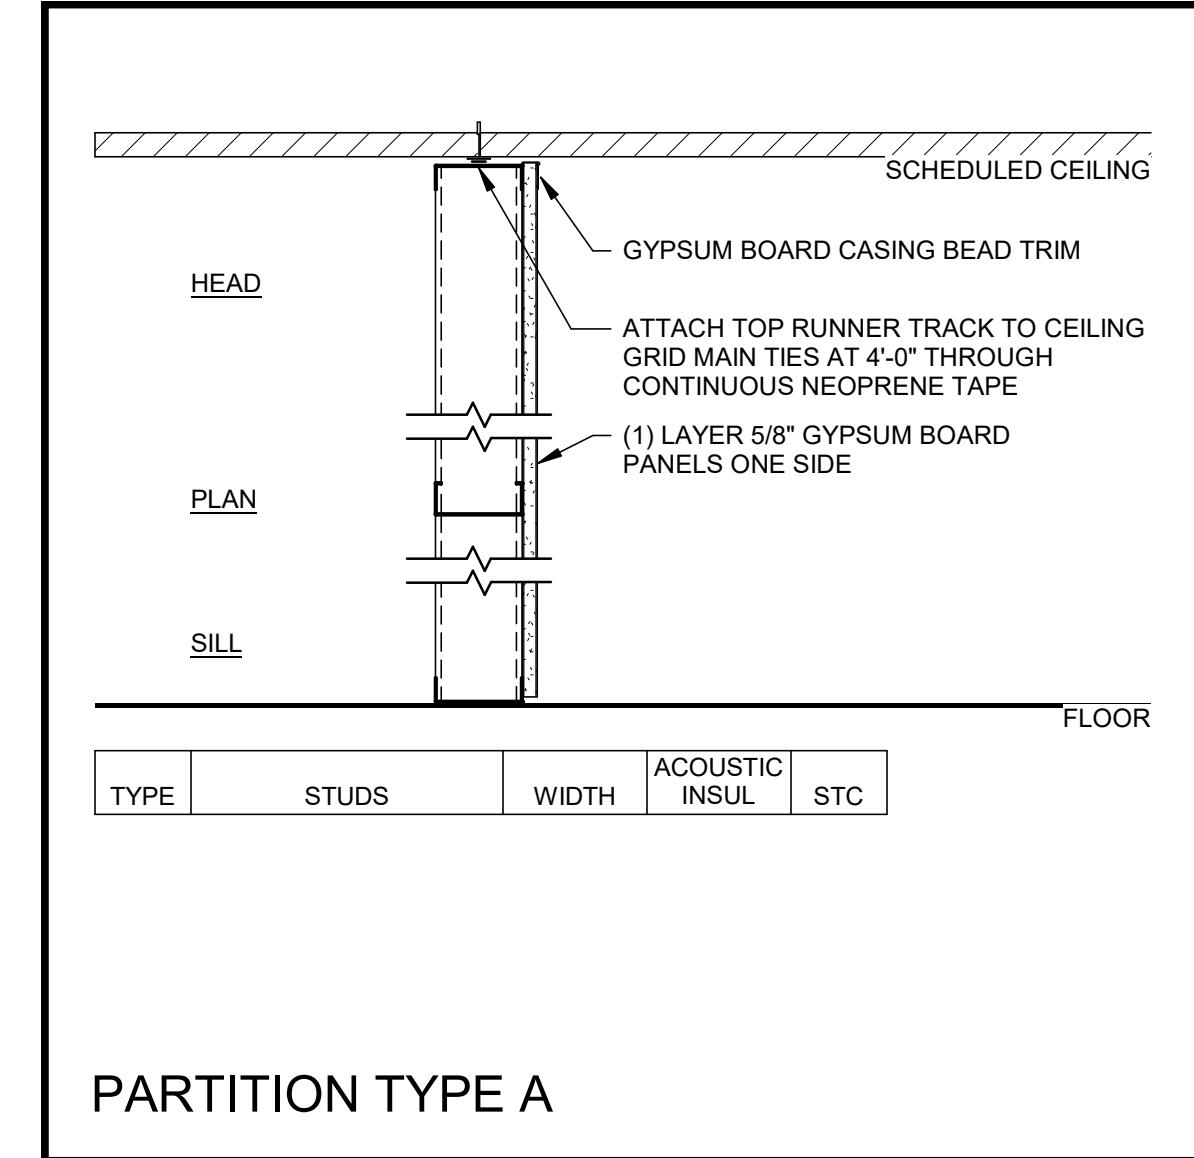

PARTITION TYPE A

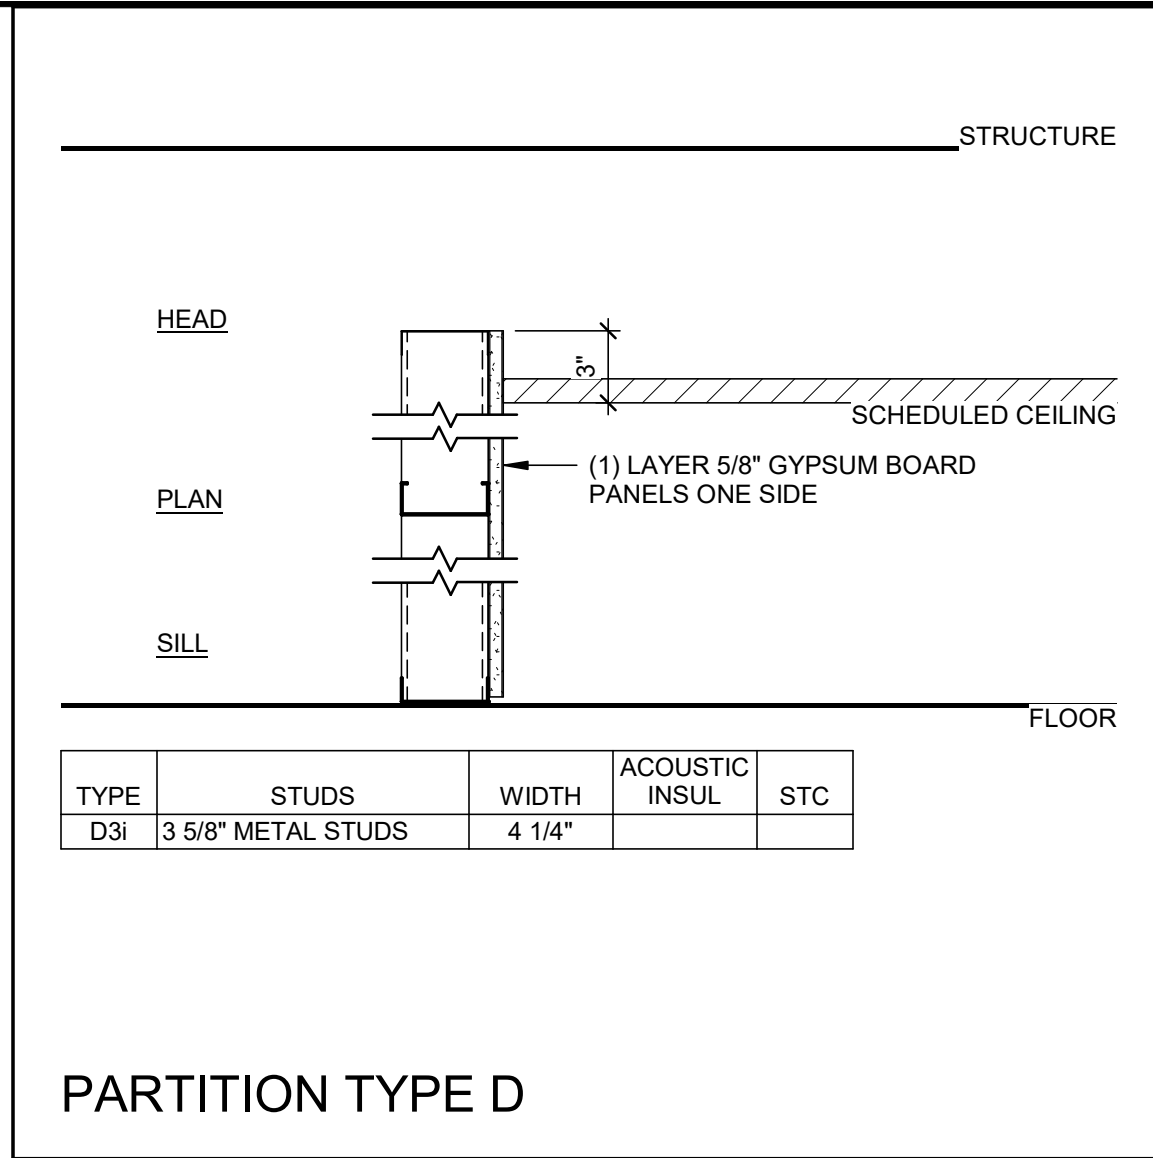


PARTITION TYPE D

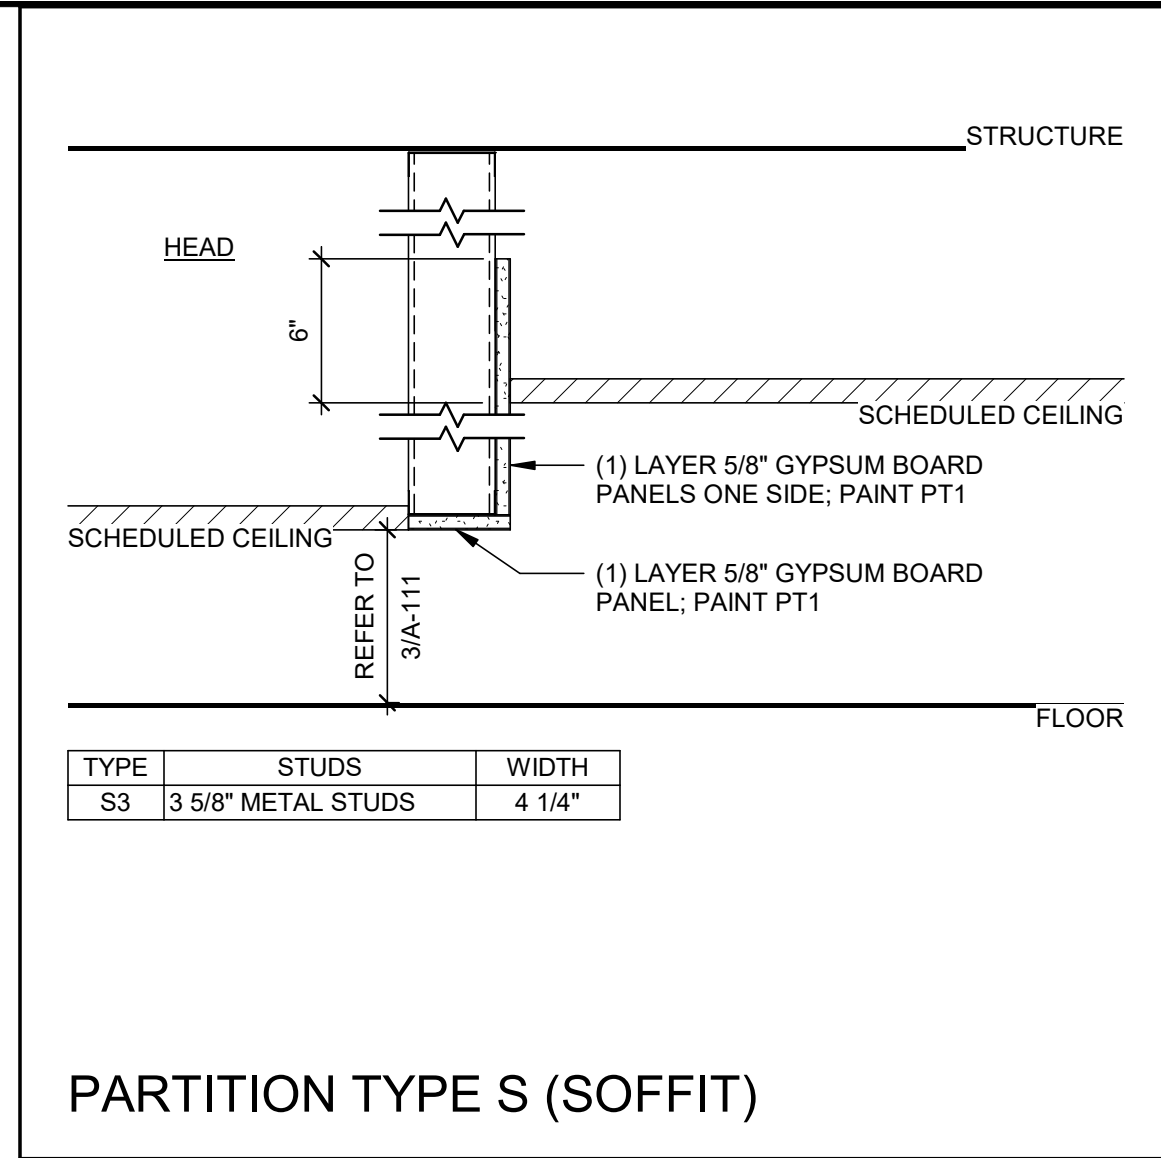


PARTITION TYPE S (SOFFIT)

DOOR HARDWARE	
1. PUBLIC RESTROOM HARDWARE (RESTROOM DOORS)	(3) BUTT HINGES (1) CLOSER (1) KICK PLATE (3) SILENCERS (1) PUSH PLATE (1) PULL PLATE (1) TOE PULL
2. PASSAGE HARDWARE (LOUNGE DOORS)	(3) BUTT HINGES (1) CLOSER (1) KICK PLATE (3) SILENCERS (1) PUSH PLATE (1) PULL PLATE

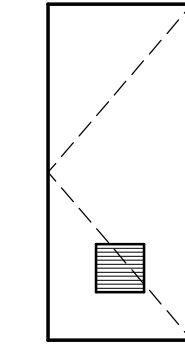

L1
HOLLOW METAL LOUVER

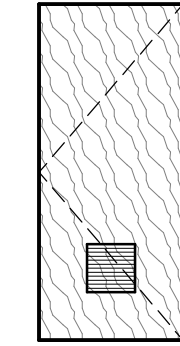





L2
SOLID CORE WOOD DOOR LOUVER

DOOR ELEVATIONS


1/4" = 1'-0"

DOOR AND FRAME SCHEDULE									
DOOR							H/W SET NO	NOTES	
MARK	NO	W	HT	THK	MATL	EL			
FIRST FLOOR									
122A	1	2'-8"	6'-8"	1 3/4"	HM	L1	1		
122B	1	2'-8"	6'-8"	1 3/4"	HM	L1	1		
122C	1	2'-8"	6'-8"	1 3/4"	HM	L1	1		
126A	1	2'-8"	6'-8"	1 3/4"	SCWD	L2	2		
126B	1	3'-0"	6'-8"	1 3/4"	SCWD	L2	2		
127A	1	2'-8"	6'-8"	1 3/4"	HM	L1	1		
127B	1	2'-8"	6'-8"	1 3/4"	HM	L1	1		
127C	1	2'-8"	6'-8"	1 3/4"	HM	L1	1		
172A	1	2'-8"	6'-8"	1 3/4"	HM	L1	1		
172B	1	2'-8"	6'-8"	1 3/4"	HM	L1	1		
172C	1	2'-8"	6'-8"	1 3/4"	HM	L1	1		
176A	1	2'-8"	6'-8"	1 3/4"	SCWD	L2	2		
176B	1	3'-0"	6'-8"	1 3/4"	SCWD	L2	2		
177A	1	2'-8"	6'-8"	1 3/4"	HM	L1	1		
177B	1	2'-8"	6'-8"	1 3/4"	HM	L1	1		
177C	1	2'-8"	6'-8"	1 3/4"	HM	L1	1		
SECOND FLOOR									
222A	1	2'-8"	6'-8"	1 3/4"	HM	L1	1		
222B	1	2'-8"	6'-8"	1 3/4"	HM	L1	1		
222C	1	2'-8"	6'-8"	1 3/4"	HM	L1	1		
226A	1	2'-8"	6'-8"	1 3/4"	SCWD	L2	2		
226B	1	3'-0"	6'-8"	1 3/4"	SCWD	L2	2		
227A	1	2'-8"	6'-8"	1 3/4"	HM	L1	1		
227B	1	2'-8"	6'-8"	1 3/4"	HM	L1	1		
227C	1	2'-8"	6'-8"	1 3/4"	HM	L1	1		
272A	1	2'-8"	6'-8"	1 3/4"	HM	L1	1		
272B	1	2'-8"	6'-8"	1 3/4"	HM	L1	1		
272C	1	2'-8"	6'-8"	1 3/4"	HM	L1	1		
276A	1	2'-8"	6'-8"	1 3/4"	SCWD	L2	2		
276B	1	3'-0"	6'-8"	1 3/4"	SCWD	L2	2		
277A	1	2'-8"	6'-8"	1 3/4"	HM	L1	1		
277B	1	2'-8"	6'-8"	1 3/4"	HM	L1	1		
277C	1	2'-8"	6'-8"	1 3/4"	HM	L1	1		
THIRD FLOOR									
322A	1	2'-8"	6'-8"	1 3/4"	HM	L1	1		
322B	1	2'-8"	6'-8"	1 3/4"	HM	L1	1		
322C	1	2'-8"	6'-8"	1 3/4"	HM	L1	1		
326A	1	2'-8"	6'-8"	1 3/4"	SCWD	L2	2		
326B	1	3'-0"	6'-8"	1 3/4"	SCWD	L2	2		
327A	1	2'-8"	6'-8"	1 3/4"	HM	L1	1		
327B	1	2'-8"	6'-8"	1 3/4"	HM	L1	1		
327C	1	2'-8"	6'-8"	1 3/4"	HM	L1	1		
372A	1	2'-8"	6'-8"	1 3/4"	HM	L1	1		
372B	1	2'-8"	6'-8"	1 3/4"	HM	L1	1		
372C	1	2'-8"	6'-8"	1 3/4"	HM	L1	1		
376A	1	2'-8"	6'-8"	1 3/4"	SCWD	L2	2		
376B	1	3'-0"	6'-8"	1 3/4"	SCWD	L2	2		
377A	1	2'-8"	6'-8"	1 3/4"	HM	L1	1		
377B	1	2'-8"	6'-8"	1 3/4"	HM	L1	1		
377C	1	2'-8"	6'-8"	1 3/4"	HM	L1	1		


****CONTRACTOR TO VERIFY ALL DOOR DIMENSIONS****

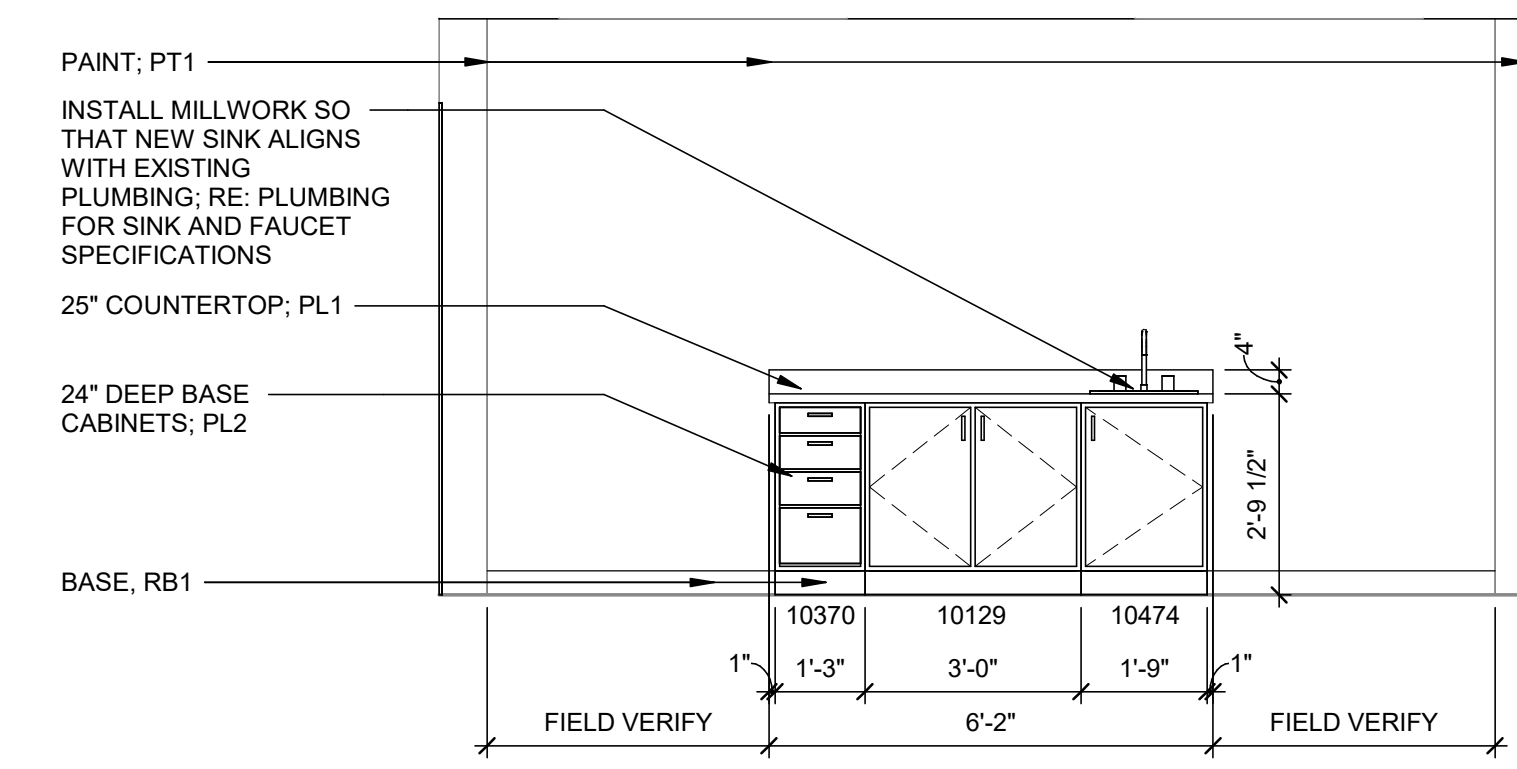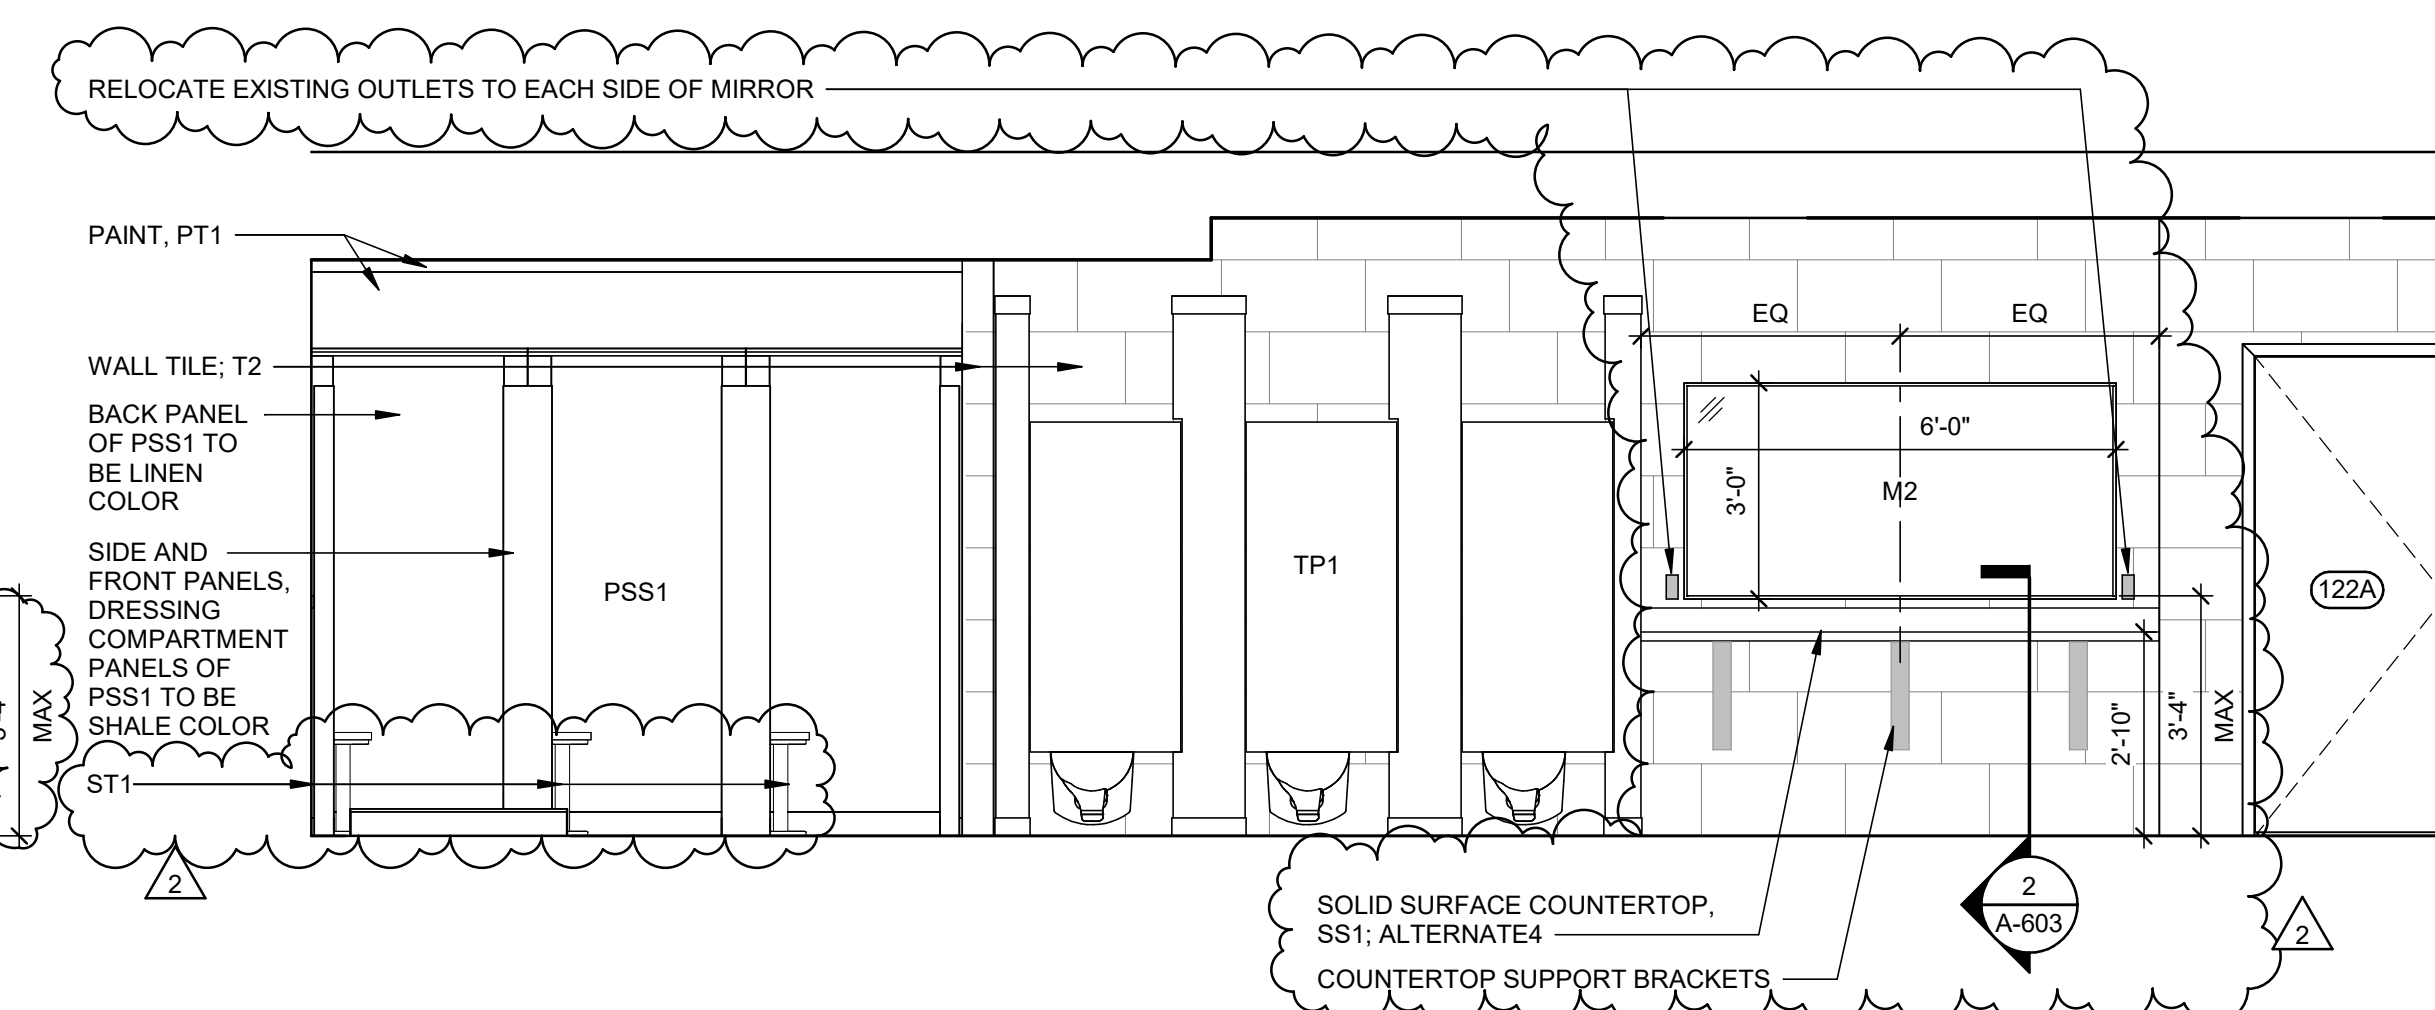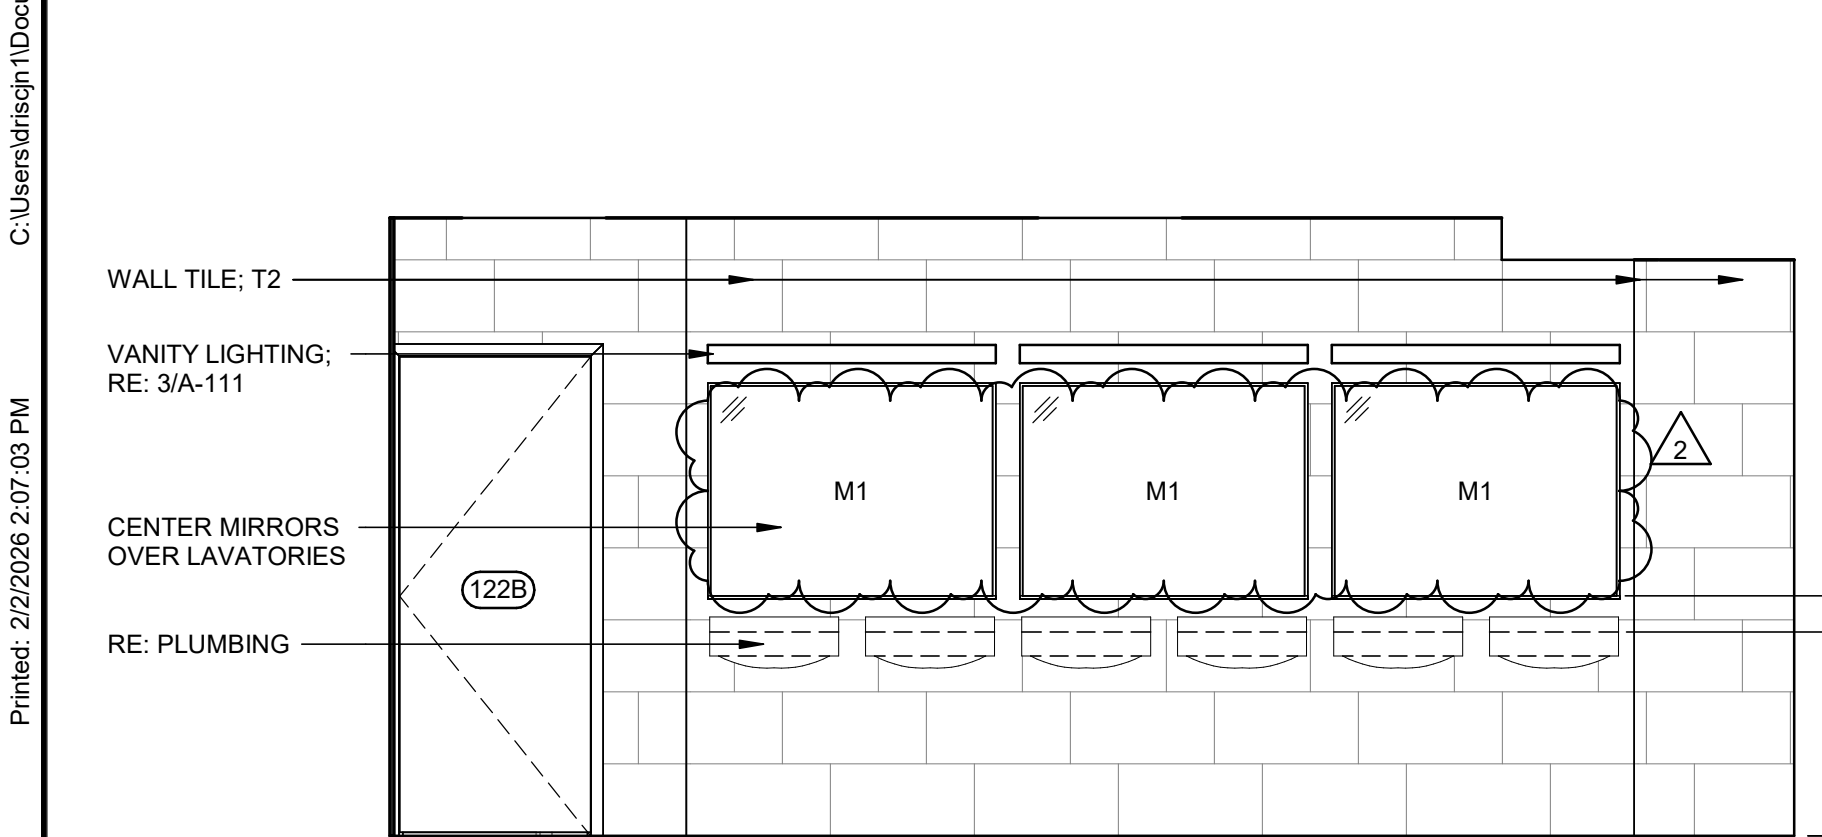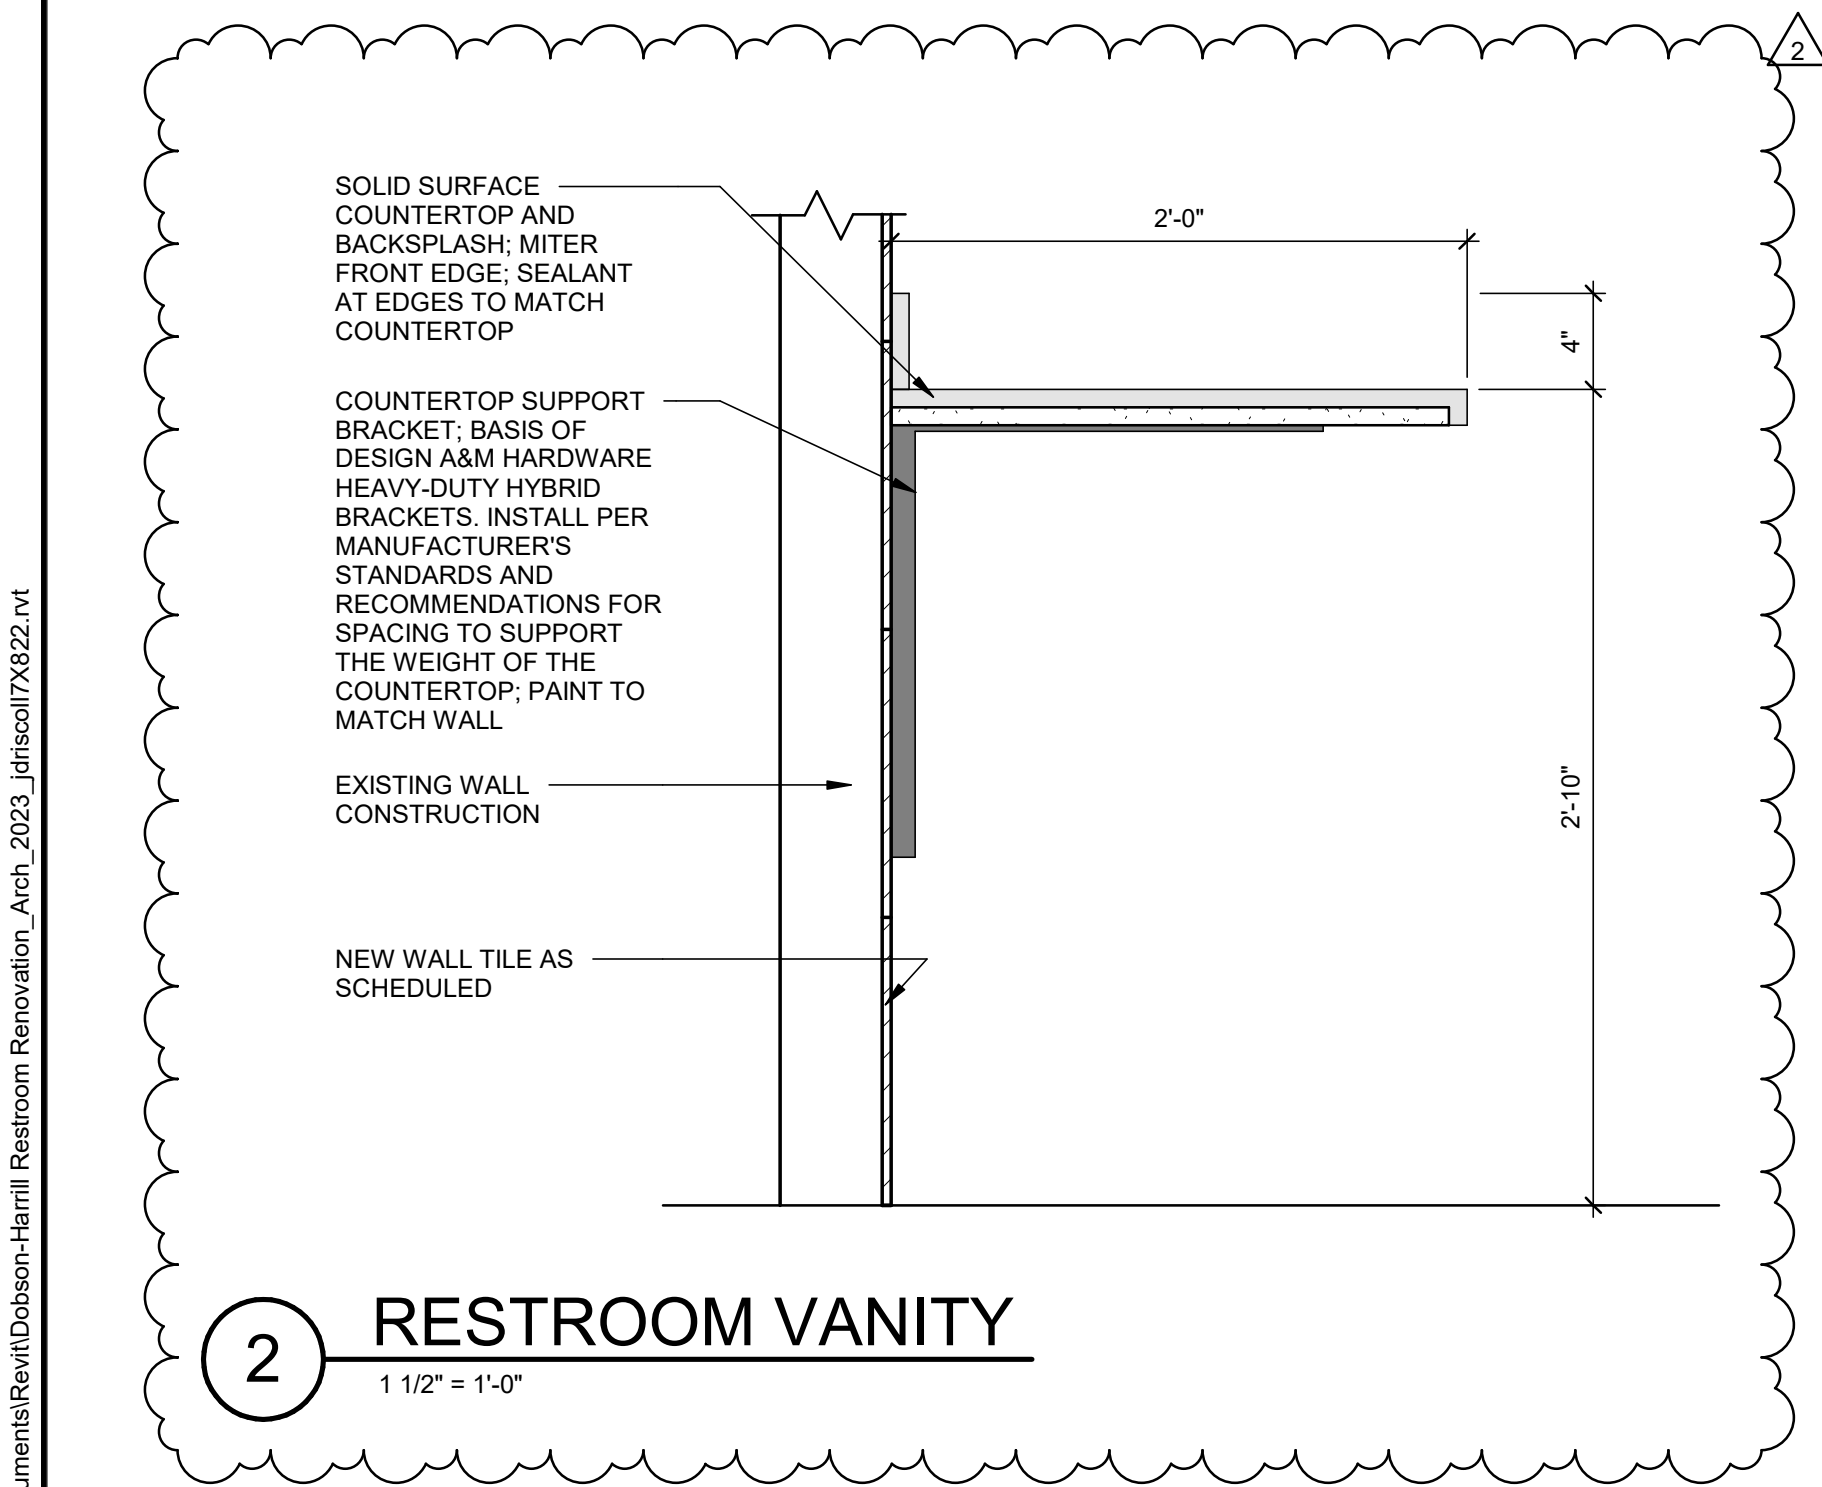

GENERAL CASEWORK NOTES	
A.	ALL EXPOSED ENDS OF CABINETS SHALL BE FINISHED WITH PLASTIC LAMINATE.
B.	CABINET BASIS OF DESIGN: STEVEN'S ADVANTAGE
C.	COUNTERTOP BASIS OF DESIGN: STEVEN'S ADVANTAGE

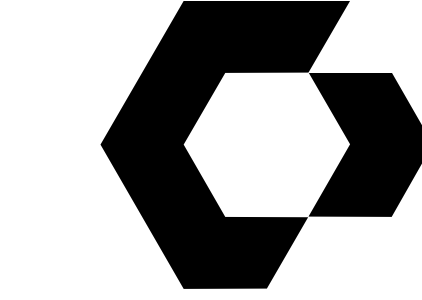

CYNERGY
810 S CINCINNATI AVE, STE 200
TULSA, OK 74119
918.877.0000

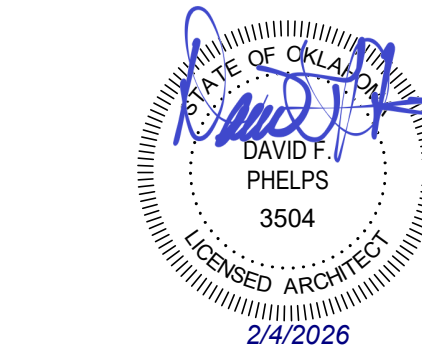

DAVID F. PHELPS, AIA
ARCHITECT OF RECORD

HARRILL-DOBSON INTERIOR
UPGRADES
NORTHEASTERN OKLAHOMA A&M COLLEGE
2001 STREET NORTHEAST
MARIETTA, OK 74304

THIS DRAWING WAS PREPARED SOLELY AND EXCLUSIVELY FOR EXECUTION OF THE PROJECT IDENTIFIED WITHIN THESE DOCUMENTS. IT IS THE PROPERTY OF THE ARCHITECT. NO PART OF THIS DRAWING MAY BE REPRODUCED OR TRANSMITTED IN ANY FORM OR BY ANY MEANS, ELECTRONIC OR MECHANICAL, WITHOUT THE WRITTEN CONSENT OF THE ARCHITECT. THE ARCHITECT AND THE ARCHITECT'S CONSULTANTS ARE THE AUTHORS AND OWNERS OF THEIR RESPECTIVE DRAWINGS AND SPECIFICATIONS, AND RETAIN ALL COMMON LAW, STATUTORY, AND OTHER RIGHTS, INCLUDING COPYRIGHTS.

ISSUES / REVISIONS	
03/29/2023	ISSUE FOR CONSTRUCTION
1	04/06/2023 AS 1
2	02/04/2026 AS 2

ISSUE DATE: 03/29/2023
CHECKED BY: EJM
DRAWN BY: JD

SHEET NAME
INTERIOR ELEVATIONS,
PARTITION TYPES, DOOR
SCHEDULE AND DOOR
ELEVATIONS

SHEET NUMBER

A-603

PLUMBING SYMBOLS LEGEND

SYMBOL	DESCRIPTION	SYMBOL	DESCRIPTION
	BACKFLOW PREVENTER, SEE SPECS		DISTILLED WATER
	BALL VALVE		DEMINERALIZED OR DEIONIZED WATER
	BLIND FLANGE		DOMESTIC COLD WATER
	CAP		DOMESTIC HOT WATER
	CHECK VALVE		DOMESTIC HOT WATER RETURN
	CHECK VALVE, SILENT		DOMESTIC HOT WATER (110°F)
	CIRCUIT SETTER		DOMESTIC HOT WATER (140°F)
	FLEXIBLE CONNECTOR		IRRIGATION WATER
	GENERAL VALVE, SEE SPECS		NATURAL GAS, LOW PRESS
	PRESSURE AND TEMPERATURE RELIEF		NATURAL GAS, MED PRESS
	PRESSURE REDUCING VALVE		NATURAL GAS, HIGH PRESS
	RELIEF VALVE, ASME		COMPRESSED AIR
	SOLENOID VALVE		PRIMARY ROOF DRAIN
	STRAINER		ROOF DRAIN
	TRIPLE DUTY VALVE		SECONDARY ROOF DRAIN
	UNION		STORM DRAIN
	RISER DOWN (ELBOW)		VENT, SANITARY SEWER
	RISER UP (ELBOW)		VENT, ACID WASTE
	RISE OR DROP		VENT, GREASE
	TEE DOWN		VACUUM
	TEE UP		WASTE, ACID
	TOP CONNECTION		WASTE, GREASE
	BOTTOM CONNECTION		WASTE, SANITARY SEWER
	SIDE CONNECTION		
	FLOW IN DIRECTION OF ARROW		
	PIPE SLOPE IN DIRECTION OF ARROW		
	REMOVE EXISTING TO THIS POINT		
	TIE-IN TO EXISTING AT THIS POINT		
	PUMP		
	EQUIPMENT TAG		
	EQUIPMENT NUMBER		
	CLEANOUT PLUG		
	CLEANOUT, FLOOR		
	CLEANOUT, WALL		
	HOSE BIBB		
	FREEZE PROOF WALL HYDRANT		
	GAS REGULATOR		
	FLOOR DRAIN		
	SHOWER DRAIN		
	FLOOR SINK		
	PRIMARY ROOF DRAIN		
	SECONDARY ROOF DRAIN		

DEMOLITION NOTES

- DEMOLISH EXISTING AS REQUIRED FOR NEW CONSTRUCTION AS DIRECTED BY ARCHITECT AND/OR AS NOTED ON DRAWINGS. AVOID DISRUPTION OF SERVICES DURING NORMAL BUSINESS HOURS. ALL SYSTEM SHUT-DOWNS AND DISRUPTION OF BUILDING SERVICES SHALL BE COORDINATED WITH OWNER AND SCHEDULED AFTER NORMAL BUILDING HOURS OR AS OTHERWISE APPROVED BY OWNER.
- PRIOR TO DEMOLITION FIELD VERIFY AND IDENTIFY ANY EXISTING EQUIPMENT TO REMAIN IN SERVICE THAT IS SERVED BY SYSTEMS TO BE DEMOLISHED. NOTIFY ENGINEER OF ANY SUCH CONDITIONS AND REMOVE AND/OR RELOCATE THE SERVICES AS DIRECTED.
- MEET WITH OWNER PRIOR TO DEMOLITION TO IDENTIFY WHETHER EXISTING MATERIALS SYSTEMS, EQUIPMENT, ETC. ARE CONSIDERED SALVAGE OR DEBRIS. REMOVE DEBRIS FROM SITE AND DISPOSE OF IN AN APPROVED MANNER. RETURN SALVAGE TO OWNER IN A LOCATION AND MANNER AS DIRECTED BY OWNER.
- TERMINATE DEMOLISHED SYSTEM SERVICES IN A CONCEALED LOCATION IN AN APPROVED MANNER. COORDINATE WITH NEW AND EXISTING CONSTRUCTION.
- FIELD VERIFY EXISTING PIPING LOCATIONS PRIOR TO WORK.
- VERIFY EXTENT OF DEMOLITION OF HVAC, PLUMBING, AND FIRE PROTECTION PIPING, EQUIPMENT, AND SYSTEMS PRIOR TO WORK. ALL DEMOLITION WORK SHALL BE IN COMPLIANCE WITH APPLICABLE CODES, STANDARDS AND THE AUTHORITY HAVING JURISDICTION.
- WHERE REQUIRED, COORDINATE EQUIPMENT ELECTRICAL TERMINATION REQUIREMENTS WITH ELECTRICAL CONTRACTOR.
- COMPLY WITH REQUIREMENTS OF ASHRAE 15 AND ASHRAE 147 FOR REFRIGERANT SAFETY, LEAKS, RECOVERY, HANDLING, STORAGE AND DISPOSAL REQUIREMENTS. ALL TANKS AND REFRIGERANTS THAT ARE DISCARDED MUST BE DISPOSED OF ACCORDING TO EPA REQUIREMENTS. REFER TO THE CLEAN AIR ACT, SECTION 608 FOR REGULATIONS. CONTRACTOR SHALL MAINTAIN VENTILATION IN THE AREA OF WORK IN ACCORDANCE WITH ASHRAE 15 AT ALL TIMES DURING CONSTRUCTION.
- CONTRACTOR SHALL COORDINATE WITH OWNER AND OWNER'S ROOFING CONTRACTOR IN REGARDS TO ANY ROOF WARRANTIES. ALL NEW WORK SHALL BE IN ACCORDANCE WITH THE REQUIREMENTS OF CURRENT ROOF WARRANTIES THAT ARE IN EFFECT.

PLUMBING ABBREVIATIONS


A	L
ADD ADJ AFF AV AVTR AW	ADDENDUM ADJUSTABLE ABOVE FINISHED FLOOR ACID VENT ACID VENT THRU THE ROOF ACID WASTE
B BFF BFPD BTM	THOUSAND THOUSAND BTU/H MANUFACTURER MFG MPG MIN MISC MOP SERVICE BASIN
C CA CD CL CO CONT CP	N NC NIC NO NOM NTS
D (D) DCW DF DHW DI DF DN DS DWG DWV	O OI P PHASE PRV PRD PSI PSIG PSIG P R
E (E) EW ENGR EQIP EWC EWH EWT EXT	(R) RD RE RM RPM RPS RV Ø
F FCO FD FLR FPWH FPM FT FS	S SD SSI SQIN SQFT SRD
G GAL GI GPF GPH GPM GCO GW GWH	T TEMP THRU TMV TYP
H HB HD HP HPG	U UL UNO UR
I IN INV INWC IW	V V VAC VFD VTR VTW
K KW K	W WAG W WB WC WHA
	Y YH

RENOVATION NOTES

- THE CONTRACTOR SHALL VISIT THE SITE BEFORE BIDDING AND SHALL BECOME FULLY INFORMED AS TO THE EXTENT AND CHARACTER OF THE WORK REQUIRED AND ITS RELATION TO OTHER WORK. FAILURE TO VISIT SITE SHALL NOT CONSTITUTE A BASIS FOR FUTURE CLAIMS.
- EXISTING CONDITIONS WERE TAKEN FROM OBSERVABLE SITE CONDITIONS AND ORIGINAL DRAWINGS. THUS DRAWINGS MAY NOT REFLECT EXACT "AS-BUILT" CONDITIONS. CONTRACTOR SHALL FIELD VERIFY ALL EXISTING CONDITIONS PRIOR TO SUBMITTING FINAL BIDS. CONTRACTOR SHALL CAREFULLY COORDINATE NEW WORK AND DEMOLITION WITH ALL OTHER DISCIPLINES AND EXISTING CONDITIONS.
- FIELD VERIFY EXISTING SYSTEM PRESSURES AND TEMPERATURES PRIOR TO ANY SYSTEM TIE-INS. ALL NEW MATERIALS SHALL MEET OR EXCEED PERFORMANCE OF MATERIALS USED ON EXISTING SYSTEMS.
- AVOID DISRUPTION OF BUILDING SERVICES DURING NORMAL BUSINESS HOURS. COORDINATE ALL SYSTEM SHUT DOWNS WITH OWNER. REQUIRED SYSTEM SHUT DOWNS AND DISRUPTION OF BUILDING SERVICES WILL BE SCHEDULED AFTER NORMAL BUSINESS HOURS AND/OR AS DIRECTED BY OWNER. CONTRACTOR SHOULD ANTICIPATE THAT SHUTDOWNS MAY OCCUR AT PREMIUM TIME. CONTRACTOR SHALL INDICATE ON THEIR BID PROPOSAL QUANTITY AND DURATION OF EACH BUILDING SYSTEM SHUTDOWN REQUIRED TO COMPLETE WORK AS DESCRIBED ON CONTRACT DOCUMENTS.
- THE CONTRACTOR TO FIELD VERIFY EXISTING CONDITIONS AND EXACT LOCATION OF ALL EQUIPMENT, DUCTWORK, AND PIPING, INCLUDING SYSTEM TIE-INS. NOTIFY ARCHITECT AND ENGINEER OF ANY MODIFICATIONS REQUIRED FROM THE PLANS TO FACILITATE INSTALLATION PRIOR TO INSTALLATION.
- THE CONTRACTOR SHALL COORDINATE AND SCHEDULE ALL CONSTRUCTION WITH BUILDING OCCUPANTS LOCATED IN THE WORK AREA.
- THE CONTRACTOR SHALL COORDINATE ALL PATCH AND REPAIR OF WALLS, FLOORS, AND FINISHES WHEN DISTURBED BY NEW CONSTRUCTION.
- WHERE SYSTEM TIE-INS ARE MADE AND AT ALL LOCATIONS WHERE DAMAGE OCCURRED FROM NEW CONSTRUCTION, PATCH AND REPAIR DAMAGED INSULATION WITH INSULATION TYPE AND THICKNESS TO MATCH EXISTING.
- TEST AND BALANCE EXISTING HVAC SYSTEMS AS REQUIRED TO ACCOMMODATE SYSTEM MODIFICATIONS AND ADDITIONS. MAINTAIN ACCEPTABLE COMFORT LEVELS DURING TEST AND BALANCE AS REQUIRED. ENSURE THE INTEGRITY OF THE EXISTING SYSTEM BALANCE.
- THE CONTRACTOR SHALL COORDINATE WORK WITH EXISTING FIRE PROTECTION PIPING AND/OR SPRINKLER HEADS. ANY WORK ASSOCIATED WITH MODIFYING THESE SYSTEMS SHALL BE PERFORMED BY A LICENSED AND APPROVED CONTRACTOR. NEW SPRINKLER HEADS SHALL MATCH EXISTING. FIELD VERIFY MANUFACTURER AND MODEL NUMBER. FIRE PROTECTION CONTRACTOR SHALL INFORM THE BUILDING SECURITY OFFICE EVERY DAY WHEN A SHUTDOWN OF SPRINKLER SYSTEM IS REQUIRED FOR CONSTRUCTION. THE CONTRACTOR SHALL RECONNECT AND FILL THE SPRINKLER SYSTEM INTO WORKING CONDITION AT THE END OF EACH WORKING DAY TO ASSURE PROTECTION DURING UNOCCUPIED PERIODS.


GENERAL NOTES

- THE CONTRACTOR IS RESPONSIBLE TO COMPLY WITH CURRENT APPLICABLE LOCAL, STATE, FEDERAL, FIRE, AND HEALTH CODES AND ORDINANCES AND IS RESPONSIBLE TO COMPLY WITH ALL REGULATIONS OF REGULATORY AGENCIES HAVING JURISDICTION. THE CONTRACTOR SHALL ALSO CONFORM TO THE REQUIREMENTS OF THE OWNER'S INSURANCE CARRIER. NOTIFY THE ARCHITECT AND ENGINEER OF ANY CONFLICTS PRIOR TO INSTALLATION. CODES, ORDINANCES AND REGULATIONS SHALL HAVE PRECEDENCE OVER SPECIFICATIONS AND DRAWINGS WHERE THERE IS A CONFLICT. OBTAIN CURRENT COPIES OF ALL ADOPTED CODES AND ORDINANCES PRIOR TO BID AND INCLUDE ALL COSTS TO COMPLY WITH CODES AND ORDINANCES IN BID.
- PAY ALL LAWFUL FEES, PERMITS OR LICENSES REQUIRED TO ACCOMPLISH WORK. OBTAIN AND PAY FOR ALL NECESSARY CERTIFICATES OF APPROVAL.
- THE CONTRACTOR IS RESPONSIBLE TO PROVIDE ALL LABOR, MATERIALS, EQUIPMENT, SERVICE AND ANYTHING REASONABLY INCIDENTAL TO COMPLETE ALL WORK INDICATED ON THE DRAWINGS AND AS SPECIFIED IN ACCORDANCE WITH THE INTENT OF THE CONSTRUCTION DOCUMENTS.
- THE CONTRACTOR IS RESPONSIBLE TO VISIT AND EXAMINE THE JOB SITE AND BECOME FAMILIAR WITH ALL EXISTING CONDITIONS PERTINENT TO THE WORK TO BE PERFORMED.
- INCORPORATE ALL CODE AND ORDINANCE REQUIREMENTS INTO THE BID AND INSTALLATION OF WORK. NO ADDITIONAL FUNDS WILL BE ALLOCATED FOR WORK REQUIRED TO CONFORM TO REGULATIONS AND REQUIREMENT AND/OR TO OBTAIN APPROVAL OF WORK.
- THE DRAWINGS ARE DIAGRAMMATIC AND ARE ONLY INTENDED TO DEFINE THE BASIC FUNCTIONS REQUIRED. THE DRAWINGS SHALL BE FOLLOWED AS CLOSELY AS ACTUAL CONSTRUCTION CONDITIONS AND COORDINATION WITH OTHER TRADES WILL ALLOW. MINOR DEVIATIONS FROM THE DESIGN LAYOUT ARE ANTICIPATED AND ARE A PART OF THE WORK INCLUDED; HOWEVER, CHANGES THAT ALTER THE CHARACTER OF THE WORK ARE NOT PERMITTED. APPROVAL OF ARCHITECT AND ENGINEER SHALL BE OBTAINED BEFORE DEVIATIONS FROM THESE PLANS ARE MADE.
- PLUMBING SYSTEMS ARE NOT DIMENSIONED. DO NOT SCALE FROM DRAWING(S). THE CONTRACTOR SHALL COORDINATE WITH OTHER TRADES AND ENSURE THERE IS AVAILABLE SPACE FOR INSTALLATION BEFORE ORDERING EQUIPMENT AND FABRICATING PIPING.
- THE CONTRACTOR SHALL STUDY THE ARCHITECTURAL, STRUCTURAL, MECHANICAL, AND ELECTRICAL PLANS TO ENSURE ALL PLUMBING SYSTEMS WILL FIT WITH SUFFICIENT CLEARANCES FOR INSTALLATION, SERVICING AND MAINTENANCE. NOTIFY THE ARCHITECT AND ENGINEER OF ANY CONFLICTS PRIOR TO INSTALLATION.
- THE CONTRACTOR SHALL COMPLY WITH SPECIFICATIONS AND INDUSTRY STANDARDS FOR ALL INSTALLATIONS.
- PROVIDE ALL DOMESTIC POTABLE WATER EQUIPMENT AND PIPING AS "LEAD FREE" PER THE "REDUCTION OF LEAD IN DRINKING WATER ACT". NOTIFY ENGINEER OF ANY CONFLICTS PRIOR TO SUBMITTAL.
- UNLESS OTHERWISE NOTED, CONTRACTOR SHALL REFER TO MECHANICAL DRAWINGS FOR MECHANICAL EQUIPMENT LOCATIONS. REFER TO PLUMBING DRAWINGS FOR PLUMBING EQUIPMENT.
- SEAL ALL PENETRATIONS WATER TIGHT. SEAL AROUND ALL WALL PENETRATIONS. PROVIDE ESCUTCHEONS ON ALL PIPING ON EXTERIOR AND EXPOSED LOCATIONS. CAULK WITH REQUIRED THICKNESS 3M BRAND FIRE BARRIER CAULK CP-25 (OR OTHER APPROVED METHOD) TO MAINTAIN FIRE RESISTANCE RATING OF FIRE RATED ASSEMBLIES.
- ALL CUTTING AND PATCHING OF STRUCTURE SHALL BE APPROVED BY THE STRUCTURAL ENGINEER PRIOR TO PERFORMING WORK.
- THE CONTRACTOR SHALL COORDINATE ALL ROUTING AND MOUNTING OF EQUIPMENT, PIPING, ETC (ALL WORK) WITH ALL OTHER TRADES.
- PROVIDE ACCESS PANELS WHERE INDICATED ON DRAWINGS AND AS REQUIRED TO PROPERLY OPERATE, ADJUST AND MAINTAIN ALL EQUIPMENT. VALVES, DAMPERS AND OTHER ACCESSORIES. VERIFY EXACT LOCATION WITH ARCHITECT PRIOR TO INSTALLATION. COORDINATE INSTALLATION WITH ALL OTHER TRADES. ACCESS PANEL TO BE MILGOR, MATHEBROOK, OR APPROVED EQUAL, HINGED WITH SCREWDRIVER LOCK.
- ROUTE PIPING AS HIGH AS POSSIBLE ABOVE FINISHED CEILING TO AVOID CONFLICT WITH LIGHTS.
- INSTALL ALL PIPING PARALLEL AND PERPENDICULAR TO BUILDING WALLS AND PARTITIONS UNLESS DISTINCTLY SHOWN OR NOTED OTHERWISE. ROUTE PIPING LOCATED NEAR EACH OTHER PARALLEL IN ALL PLANES AND WITH SUFFICIENT CLEARANCE.
- ALL PIPING SHALL BE INSTALLED SO THAT IT MAY EXPAND AND CONTRACT FREELY WITHOUT DAMAGES TO EQUIPMENT, OTHER WORK, OR INJURY TO PIPING SYSTEM. ALL NECESSARY SWING JOINTS, EXPANSION JOINTS, OR OFFSETS TO PROTECT PIPING, ETC. SHALL BE INSTALLED WHETHER INDICATED OR NOT.
- PROPERLY SUPPORT ALL PIPING. PROVIDE ALL REQUIRED ANCHORS, GUIDES AND EXPANSION DEVICES.
- PAINT ALL EXTERIOR AND EXPOSED PIPING. COORDINATE COLOR TO MATCH SURROUNDING ARCHITECTURAL ELEMENTS. NATURAL GAS OR PROPANE PIPING TO BE PAINTED YELLOW.
- THE CONTRACTOR SHALL TAKE ALL NECESSARY PRECAUTIONS TO PROTECT ALL MATERIAL, EQUIPMENT, APPARATUS AND WORK FROM DAMAGE. FAILURE TO DO SO TO THE SATISFACTION OF THE OWNER OR OWNER'S REPRESENTATIVE WILL BE SUFFICIENT CAUSE FOR THE REJECTION OF THE MATERIAL, EQUIPMENT, APPARATUS AND WORK IN QUESTION.
- THE CONTRACTOR SHALL GUARANTEE ALL EQUIPMENT, MATERIALS AND WORKMANSHIP FOR A PERIOD OF 1 YEAR FOLLOWING THE DATE OF ACCEPTANCE. THE CONTRACTOR'S GUARANTEE INCLUDES EQUIPMENT CAPACITY, PERFORMANCE RATINGS AND NOISE RATINGS. ANY DEFICIENCIES SHALL BE PROMPTLY CORRECTED. ROUTINE MAINTENANCE SHALL NOT BE INCLUDED.
- THE CONTRACTOR SHALL CLEAN ALL FIXTURES, PIPES, EQUIPMENT AND EXPOSED WORK AFTER COMPLETION OF FINAL TESTING AND BEFORE ACCEPTANCE.
- ALL PLATED AND OTHER FINISHED PRODUCTS SHALL BE THOROUGHLY CLEANED AND POLISHED.
- THE MANUFACTURER MODEL OR CATALOG NUMBERS INDICATED IN THE CONSTRUCTION DOCUMENTS ESTABLISH A STANDARD FOR THE GENERAL DESIGN, PERFORMANCE, AND QUALITY OF THE PRODUCT REQUIRED.
- ALTERNATE MANUFACTURERS LISTED IN THE SCHEDULE OR SPECIFICATIONS ARE APPROVED TO BID; HOWEVER, THE SUBMITTED PRODUCT MUST MEET THE GENERAL DESIGN, PERFORMANCE, DIMENSIONS, WEIGHT, AND QUALITY OF THE SCHEDULED PRODUCT. EACH MANUFACTURER WILL HAVE DIFFERENCES IN INSTALLATION REQUIREMENTS. IF THE CONTRACTOR ELECTS TO GO WITH A NON-BASIS OF DESIGN MANUFACTURER, THE CONTRACTOR SHALL BE RESPONSIBLE TO INCLUDE THE COST FOR ENGINEERING TIME, AS REQUIRED, TO ADJUST THE DESIGN TO THOSE DIFFERENCES IN THEIR BID. IF THE BASIS OF DESIGN IS NOT BID, THE CONTRACTOR IS RESPONSIBLE TO IDENTIFY THE DIFFERENCES IN THE INSTALLATION REQUIREMENTS BETWEEN THE BASIS OF DESIGN AND THE SUBMITTED MANUFACTURER DURING THE SUBMITTAL PHASE.
- WHERE "OR APPROVED EQUAL" IS INDICATED, OTHER PRODUCTS SIMILAR IN DESIGN AND OF EQUAL QUALITY AND PERFORMANCE, AND COMPLYING WITH THE PLANS AND SPECIFICATIONS MAY BE APPROVED IF FOUND ACCEPTABLE BY THE ARCHITECT/ENGINEER. THE CONTRACTOR MUST SUBMIT TO THE ARCHITECT/ENGINEER A LINE-BY-LINE COMPARISON BETWEEN SCHEDULED MANUFACTURER AND "OR APPROVED EQUAL" MANUFACTURER 10 DAYS PRIOR TO BID.
- ALL MATERIALS, EQUIPMENT, ETC., INSTALLED UNDER THIS CONTRACT SHALL CONFORM TO ALL RULES, CODES, ETC., AS RECOMMENDED OR ADAPTED BY THE NATIONAL ASSOCIATION GOVERNING THE MANUFACTURER, RATING AND TESTING OF SUCH MATERIALS, EQUIPMENT, ETC., ALL ELECTRICALLY OPERATED EQUIPMENT SHALL BE U.L. APPROVED FOR THE USE INTENDED.
- ALL FIRED AND UNFIRED PRESSURE VESSELS SHALL CONFORM TO THE RULES OF THE A.S.M.E. AND NATIONAL BOARD CODES AND SHALL BE SO LABELED. FURNISH A S.M.E. AND NATIONAL BOARD CERTIFICATES.
- MOTORS SHALL CONFORM TO THE RULES OF THE N.E.M.A. FOR THE SERVICE INTENDED AND TO THEIR STANDARDIZED FORM SIZES.
- SHOP DRAWINGS, CATALOG CUTSHEETS AND PERFORMANCE DATA PERTAINING TO ALL MATERIALS AND EQUIPMENT PROPOSED FOR USE SHALL BE SUBMITTED.
- JOINTS BETWEEN DISSIMILAR METALS SHALL BE MADE WITH DIELECTRIC NIPPLES DOWNSTREAM OF A VALVE.
- ALL MATERIALS EXPOSED IN A RETURN AIR PLENUM SHALL COMPLY WITH NFPA 90A FLAME SPREAD UNDER 25 AND SMOKE DEVELOPED AND FUEL CONTRIBUTED UNDER 50.
- THE DISCHARGE OF SAFETY VALVES, BLOWOFF PIPES AND OTHER OUTLETS SHALL BE LOCATED AND SUPPORTED SO AS TO PREVENT INJURY TO PERSONNEL.
- PROVIDE RETURN AIR SMOKE DETECTOR IN EACH HVAC UNIT OVER 2,000 CFM AS REQUIRED BY THE LATEST ADOPTED INTERNATIONAL MECHANICAL CODE.

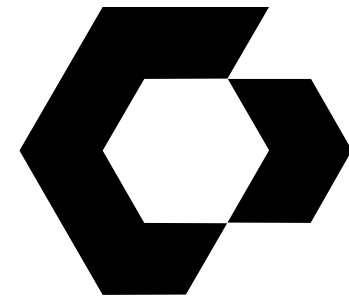

CYNERGY
810 S CINCINNATI AVE, STE 200
TULSA, OK 74119
918.877.6000

CYNERGY ENGINEERING, PLLC
LICENSE # 3537 | EXPIRES 06/30/2024

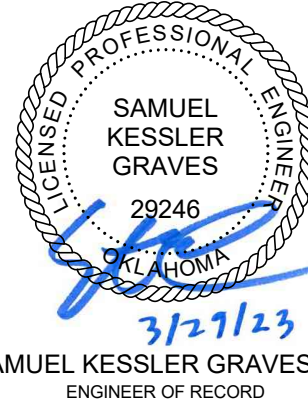

SAMUEL KESSLER GRAVES, PE
ENGINEER OF RECORD

DOBSON-HARRILL RESTROOM
RENOVATION
NEO

2001 STREET/NORTHEAST
MARIETTA, GA 30067

THIS DRAWING WAS PREPARED SOLELY AND EXCLUSIVELY FOR EXECUTION OF THE PROJECT IDENTIFIED WITHIN THESE DOCUMENTS. IT IS THE PROPERTY OF THE ARCHITECT. THIS DRAWING MAY NOT BE USED ON OTHER PROJECTS OR FOR ANY OTHER PURPOSE WITHOUT THE WRITTEN CONSENT OF THE ARCHITECT. THE ARCHITECT AND THE ARCHITECT'S CONSULTANTS, THE ARCHITECT AND THE ARCHITECT'S CONSULTANTS ARE THE AUTHORS AND OWNERS OF THEIR RESPECTIVE DRAWINGS AND SPECIFICATIONS, AND RETAIN ALL COMMON LAW, STATUTORY, AND OTHER RIGHTS, INCLUDING COPYRIGHTS.

ISSUES / REVISIONS	
03/29/2023	ISSUE FOR CONSTRUCTION

ISSUE DATE: 03/29/2023
CHECKED BY: SKG
DRAWN BY: SMN

SHEET NAME
PLUMBING NOTES, LEGENDS, &
ABBREVIATIONS


SHEET NUMBER
P-001

HVAC NOTES AND SPECIFICATIONS

1. HVAC GENERAL
 - 1.1. THE HVAC SYSTEM SHALL BE SIZED AND INSTALLED PER THE LATEST ADAPTED INTERNATIONAL MECHANICAL CODE.
 - 1.2. WORK INCLUDED: PROVIDE HVAC SYSTEMS WHERE SHOWN ON THE DRAWINGS, AS SPECIFIED HEREIN, AND AS NEEDED FOR A COMPLETE AND PROPER INSTALLATION INCLUDING, BUT NOT NECESSARILY LIMITED TO:
 - 1.2.1. AIR CONDITIONING SUPPLY, RETURN AND OUTSIDE AIR DUCTWORK SYSTEMS WITH GRILLES, DIFFUSERS, REGISTERS, DAMPERS, SHEET METAL HARDWARE, AND RELATED ITEMS
 - 1.2.2. TEMPERATURE CONTROLS AND SEQUENCES FOR EACH SYSTEM
 - 1.2.3. ACoustICAL AND THERMAL INSULATION OF DUCTS, PIPING, AND EQUIPMENT
 - 1.2.4. EXHAUST SYSTEMS INCLUDING, DUCTWORK, GRILLES, REGISTERS, CONTROLS AND RELATED ITEMS
 - 1.2.5. AIR AND HYDRONIC SYSTEMS BALANCE FOR AIR AND WATER QUANTITIES SHOWN ON THE PLANS
 - 1.3. RELATED WORK: DOCUMENTS AFFECTING WORK OF THIS SECTION INCLUDE, BUT ARE NOT NECESSARILY LIMITED TO GENERAL CONDITIONS, SUPPLEMENTARY AND SECTIONS IN DIVISION ONE (1) SPECIFICATIONS
 - 1.4. FIELD CONDITIONS: EXAMINE THE AREAS AND CONDITIONS UNDER WHICH WORK OF THIS SECTION WILL BE PERFORMED. CORRECT CONDITIONS DETRIMENTAL TO TIMELY AND PROPER COMPLETION OF THE WORK. DO NOT PROCEED UNTIL UNSATISFACTORY CONDITIONS ARE CORRECTED.
 - 1.5. LAYOUT AND WORK COORDINATION
 - 1.5.1. THE HVAC DRAWINGS ARE DIAGRAMMATIC AND SHOW THE GENERAL ARRANGEMENT OF PIPING, DUCTWORK, EQUIPMENT, AND APPURTENANCES AND SHALL BE FOLLOWED AS CLOSELY AS ACTUAL BUILDING CONSTRUCTION, SITE CONDITIONS, AND THE WORK OF OTHER TRADES WILL PERMIT. THE HVAC WORK SHALL CONFORM TO THE REQUIREMENTS SHOWN ON ALL OF THE DRAWINGS. DUE TO THE DIAGRAMMATIC NATURE OF THE HVAC DRAWINGS, IT IS NOT POSSIBLE TO ADJUST OFFSETS, FITTINGS AND ACCESSORIES WHICH MAY BE REQUIRED. THE CONTRACTOR SHALL INVESTIGATE STRUCTURAL ELEMENTS, FINISH CONDITIONS AND NEW CONSTRUCTION AFFECTING THE WORK AND SHALL ARRANGE HIS WORK ACCORDINGLY.
 - 1.5.2. LAY OUT THE HVAC SYSTEM IN CAREFUL CONSIDERATION OF THE DRAWINGS, DETERMINING PROPER ELEVATIONS FOR ALL COMPONENTS OF THE SYSTEM AND USING ONLY THE MINIMUM NUMBER OF BENDS AND OFFSETS TO PRODUCE A SATISFACTORILY FUNCTIONING SYSTEM
 - 1.5.3. FOLLOW THE GENERAL LAYOUT SHOWN ON THE DRAWINGS IN ALL CASES EXCEPT WHERE OTHER WORK MAY INTERFERE.
 - 1.5.4. LAY OUT PIPES AND DUCTWORK TO FIT WITHIN PARTITION, WALL, OR ROOF CAVITIES AND DO NOT REQUIRE FURRING OTHER THAN AS SHOWN ON THE DRAWINGS. DO NOT INSTALL HYDRONIC LINES IN EXTERIOR WALLS OR IN FRONT OF EXTERIOR OPENINGS WITHOUT PROPER CONSIDERATIONS OF REQUIRED INSULATION AND ROLTING.
 - 1.5.5. NO CUTS SHALL BE MADE INTO ANY STRUCTURAL ELEMENT, BEAM OR COLUMN, WITHOUT WRITTEN APPROVAL. OPENINGS IN EXISTING STRUCTURES SHALL BE PROVIDED BY THE TRADE REQUIRING SAME OR AS COORDINATED WITH THE GENERAL CONTRACTOR
 - 1.5.6. LOCATIONS OF PIPES, DUCTS, SWITCHES, PANELS, EQUIPMENT, FIXTURES, ETC. SHALL BE ADJUSTED TO ACCOMMODATE THE WORK TO ACCOUNT FOR INTERFERENCES, ANTICIPATED OR ENCOUNTERED. THE CONTRACTOR SHALL DETERMINE THE EXACT ROUTE AND LOCATION OF EACH PIPE, DUCT AND ELECTRICAL RACEWAY PRIOR TO FABRICATION.
 - 1.5.7. RIGHT-OF-WAY: LINES WHICH PITCH SHALL HAVE THE RIGHT-OF-WAY OVER THOSE WHICH DO NOT PITCH. FOR EXAMPLE, PLUMBING DRAINS SHALL NORMALLY HAVE RIGHT-OF-WAY. LINES WHOSE ELEVATIONS CANNOT BE CHANGED SHALL HAVE THE RIGHT-OF-WAY OVER LINES WHOSE ELEVATIONS CAN BE CHANGED.
 - 1.5.8. OFFSETS, TRANSITIONS AND CHANGES IN DIRECTION OF PIPING AND DUCTS SHALL BE MADE AS REQUIRED TO MAINTAIN PROPER HEAD ROOM AND PITCH OF SLOPING LINES WHETHER OR NOT INDICATED ON THE DRAWINGS. THE CONTRACTOR SHALL FURNISH AND INSTALL ALL TURNING VANES, CLEANOUTS AND AIR VENTS, AS REQUIRED TO AFFECT THESE OFFSETS, TRANSITIONS AND CHANGES IN DIRECTION.
2. DUCTWORK (GENERAL)
 - 2.1. FABRICATE, PROVIDE, AND INSTALL ALL DUCTWORK IN ACCORDANCE WITH THE 2005 EDITION OF SMACNA HVAC DUCT CONSTRUCTION STANDARDS AND THE LATEST ADAPTED INTERNATIONAL MECHANICAL CODE.
 - 2.2. PROVIDE GALVANIZED SHEET STEEL, COMPLY WITH ASTM A 653/A 653M. PROVIDE G90 GALVANIZED COATING. PROVIDE MILL PHOSPHATIZED FINISH FOR SURFACES EXPOSED TO VIEW.
 - 2.3. REFER TO DUCTWORK SEALANT SCHEDULE, SEAL DUCTWORK WITH HEAVY LIQUID SEALANT (HARCASST - GALVAGRIP OR APPROVED EQUAL) TO PREVENT LEAKAGE.
 - 2.4. DUCTWORK DIMENSIONS ARE INSIDE CLEAR DIMENSIONS.
 - 2.5. PROVIDE SINGLE THICKNESS TURNING VANES AT ALL RECTANGULAR DUCT TURNS GREATER THAN 90 DEGREES. CONSTRUCT TURNING VANES PER LATEST SMACNA DUCT CONSTRUCTION STANDARDS. DO NOT INSTALL TURNING VANES OR SCOOPS AT ENTRANCES TO BRANCH DUCTS.
 - 2.6. PROVIDE ALL OFFSETS AND FITTINGS REQUIRED FOR A COMPLETE SYSTEM. COORDINATE WITH EXISTING CONDITIONS, STRUCTURAL FRAMED MEMBERS, FINISH CONDITIONS AND NEW CONSTRUCTION.
 - 2.7. LAP METAL DUCTS IN DIRECTION OF AIR FLOW. HAMMER DOWN EDGES AND SLIP JOINTS TO LEAVE SMOOTH DUCT INTERIOR.
 - 2.8. INSULATED (MINIMUM R-6), FLEXIBLE DUCTWORK SHALL BE SUPPORTED PER SMACNA AND INDUSTRY STANDARDS. MAXIMUM 5'-0" PER HVAC DUCT CONSTRUCTION STANDARDS, FIGURE 3-6. FLEXIBLE DUCT SUPPORTS, AVOID TIGHT RADIUS TURNS THAT RESTRICT AIRFLOW. WHERE TIGHT RADIUS TURNS ARE NECESSARY PROVIDE RIGID SHEET METAL ELBOWS.
 - 2.9. PROVIDE SADDLE UNDER FLEXIBLE DUCT HANGER TO SUPPORT DUCT AND PREVENT PINCHING OF DUCTWORK. FLEXIBLE DUCT SHALL BE INSTALLED SO AS NOT TO REDUCE CROSS SECTION AREA OF DUCT.
 - 2.10. FLEXIBLE DUCTWORK SHALL BE UL LISTED FOR UL181 CLASS 1 AIR DUCT MATERIAL AND SHALL COMPLY WITH NFPA STANDARDS 90A AND 90B.
 - 2.11. ALL LOW PRESSURE RECTANGULAR DUCTS TO BE SHEET METAL, DUCTBOARD OR LINED DUCTWORK IS NOT ALLOWED UNLESS NOTED OTHERWISE. METAL DUCTWORK SHALL BE GALVANIZED STEEL OR ALUMINUM. CONSTRUCTION DETAILS AND GAUGES SHALL BE ACCORDING TO NFPA BULLETIN 90A AND SMACNA DUCT MANUAL.
 - 2.12. PROVIDE FLANGE CONNECTIONS AND TRANSITIONS TO CONNECT DUCTWORK TO ALL EQUIPMENT.
 - 2.13. PROVIDE MANUAL VOLUME BALANCING DAMPERS AT ALL BRANCH DUCTWORK TO INDIVIDUAL SUPPLY AND EXHAUST DIFFUSERS, GRILLES, AND REGISTERS ON LOW PRESSURE SYSTEMS. INSTALL DAMPER AS CLOSE AS PRACTICAL TO THE MAIN DUCTWORK BRANCH CONNECTION.
 - 2.14. PROVIDE A COMPLETE WORKING SYSTEM.
 - 2.15. INSTALL DUCTWORK COMPLETELY FREE FROM VIBRATION UNDER OPERATING CONDITIONS. THE CONTRACTOR SHALL COORDINATE ROUTING AND SIZE OF DUCTWORK WITH ACTUAL EXISTING AND FINAL BUILDING CONDITIONS OF STRUCTURE, SIZE AND LOCATION, LIGHT LOCATIONS, ARCHITECTURAL FEATURES, AND WORK OF OTHER TRADES. WHERE DUCT SIZES MUST BE REVISED FROM THOSE SHOWN ON THE DRAWINGS, MAINTAIN SAME CROSS SECTIONAL AREA, VELOCITY, AND PRESSURE DROP. WHEN NECESSARY, REROUTE DUCT TO CLEAR OBSTRUCTIONS WITH MINIMUM NUMBER OF FITTINGS AND ELBOWS. WHERE DUCT MUST BE SIGNIFICANTLY ALTERED FROM THAT SHOWN ON THE DRAWINGS, NOTIFY THE ARCHITECT PRIOR TO PROCEEDING.


1. HARRILL WING RESTROOMS SHOWN IN VIEW. DOBSON WING RESTROOMS SIMILAR.
2. REBALANCE EXHAUST FANS ON ROOF TO PROVIDE CFM AS SHOWN.

1. REMOVED.
2. SANITARY AND VENT RISER 1; RE: 1/M-901.
3. SANITARY AND VENT RISER 2; RE: 2/M-902.
4. REMOVE E/A GRILLE AND CONNECT TO EXISTING E/A FROM CHASE.
5. OFFSET UP TO ABOVE CEILING. HOLD AS HIGH AS POSSIBLE. REFER TO ARCH FOR CEILING HEIGHTS.
6. CONNECT SINK TO EXISTING SANITARY RISER

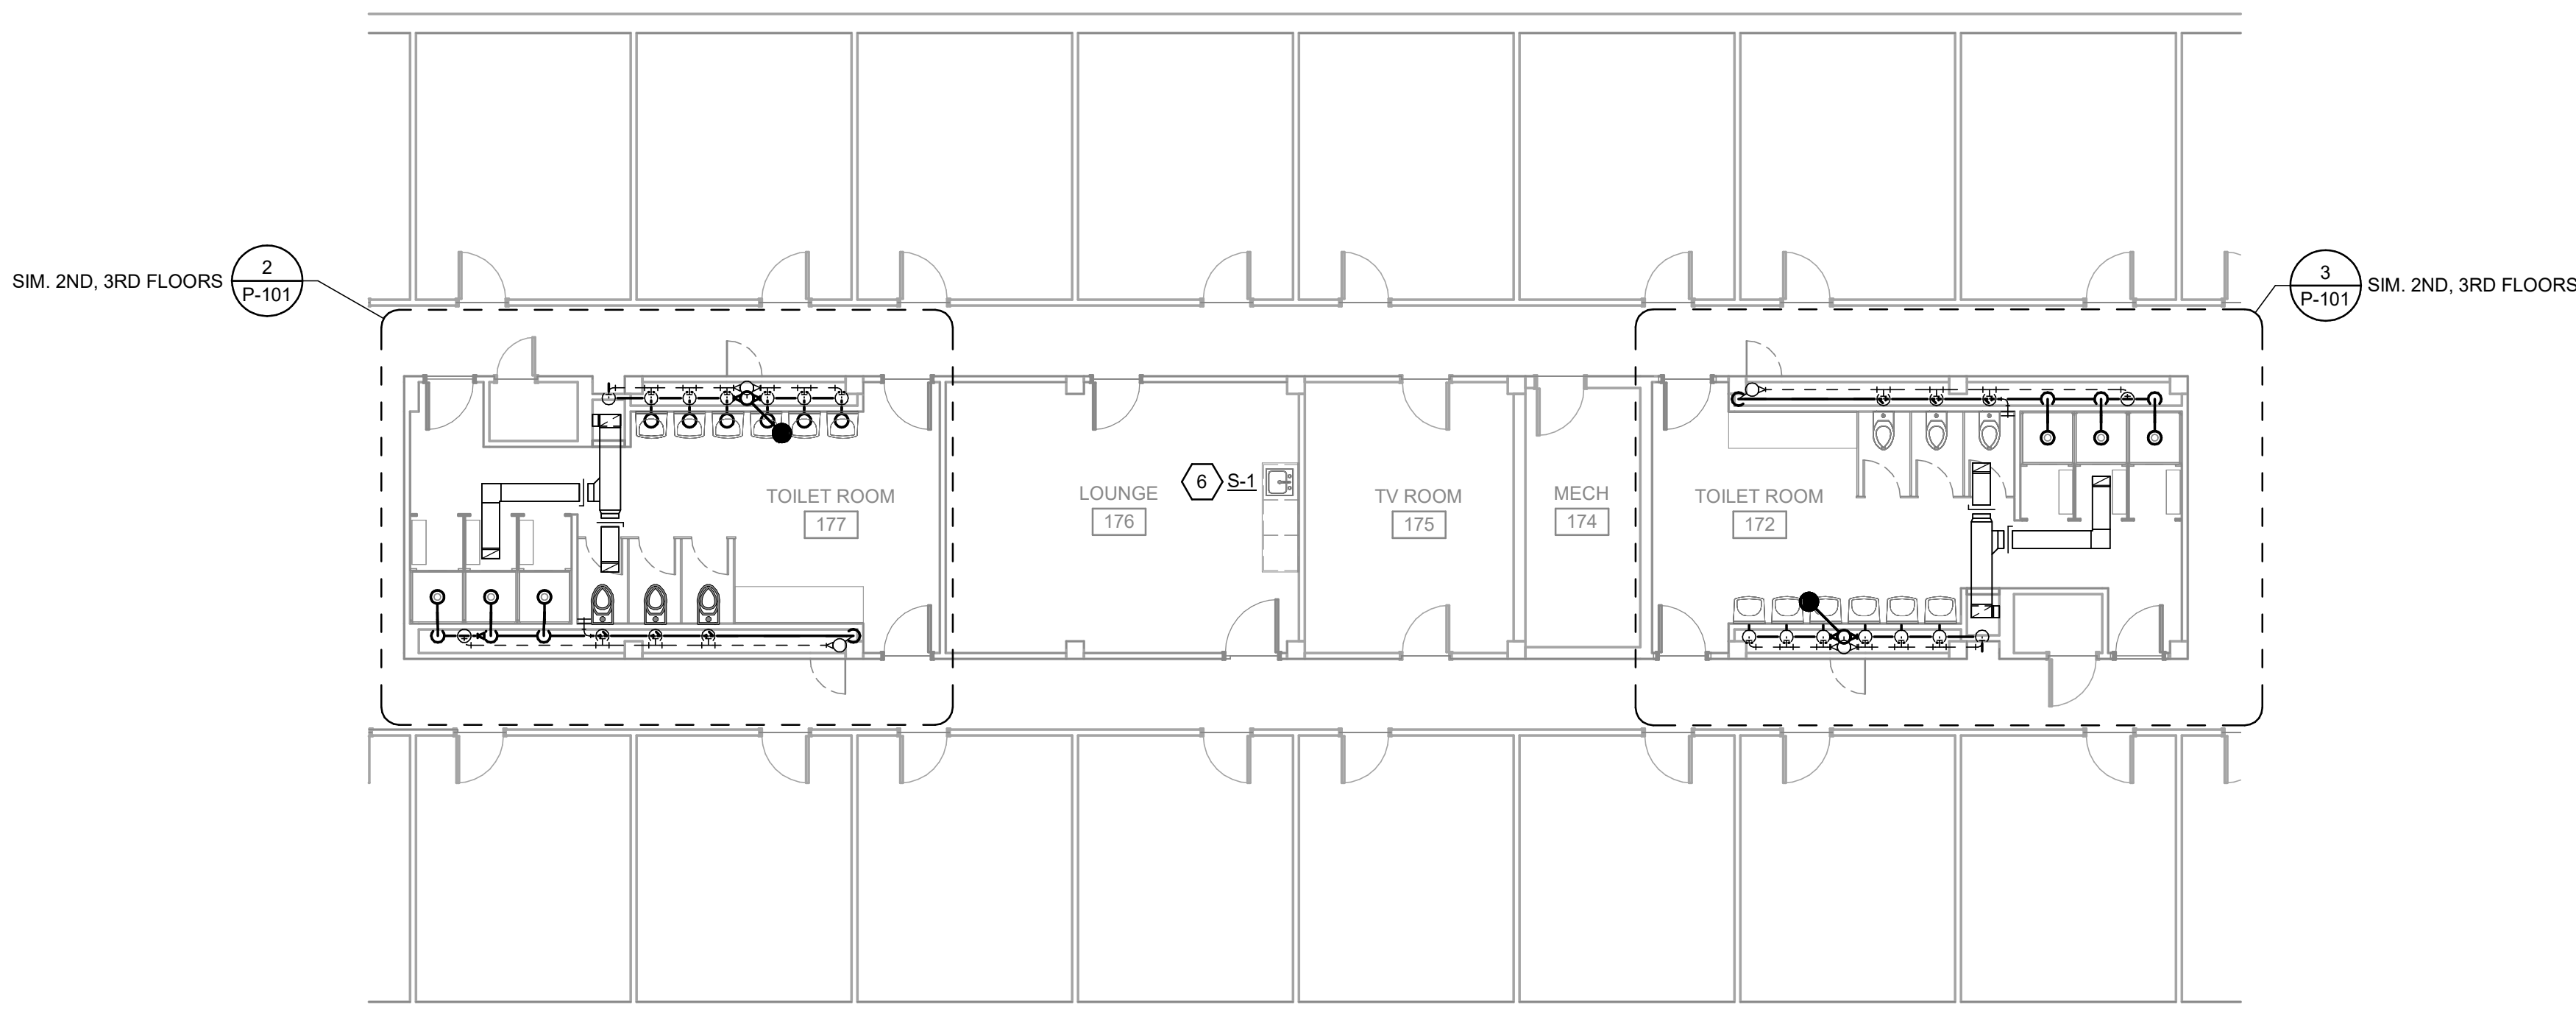


1 FIRST FLOOR PLAN
1/8" = 1'-0"



GENERAL NOTE: DEMO ALL PLUMBING FIXTURES AND PIPING FROM UNDERSIDE OF ROOF (EXISTING VTR TO REMAIN) DOWN TO CONNECTION TO THE MAIN IN THE CRAWLSPACE PRIOR TO STARTING INSTALLATION.

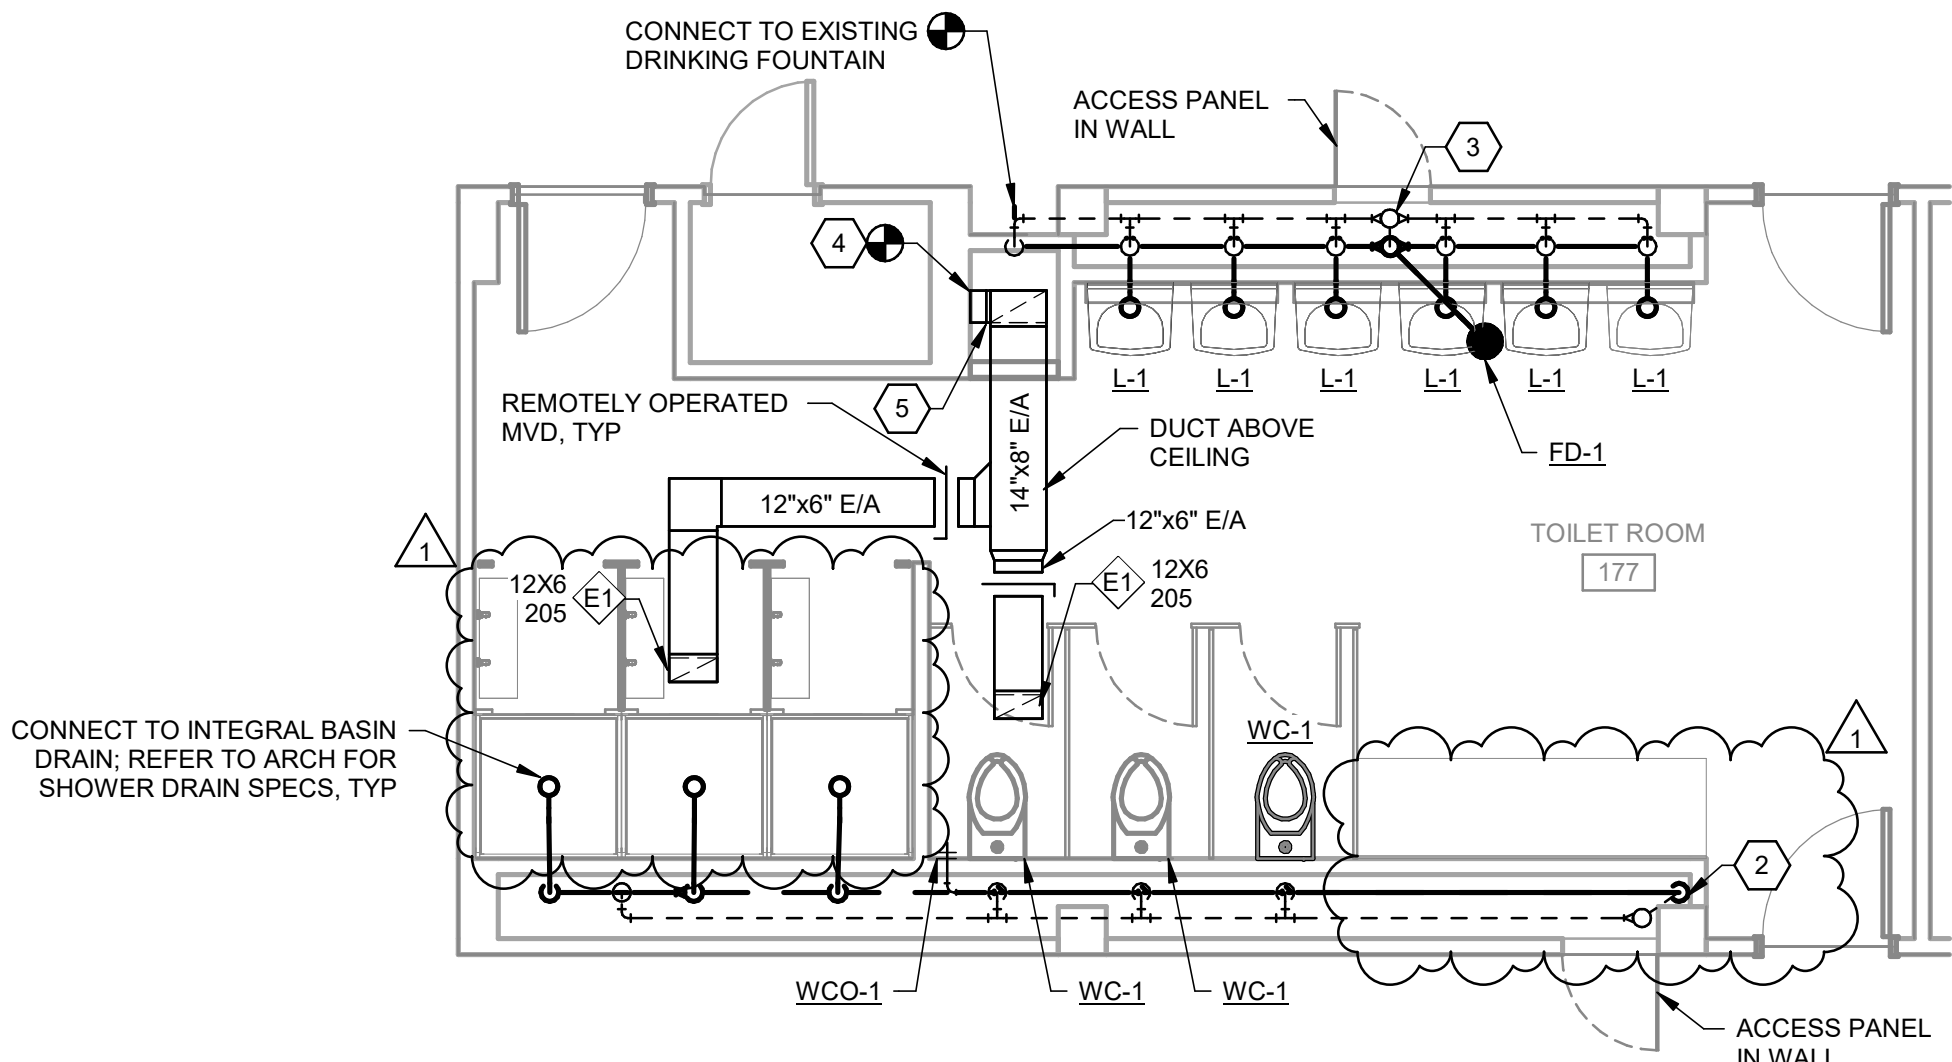

2 ENLARGED PLAN #1
1/4" = 1'-0"

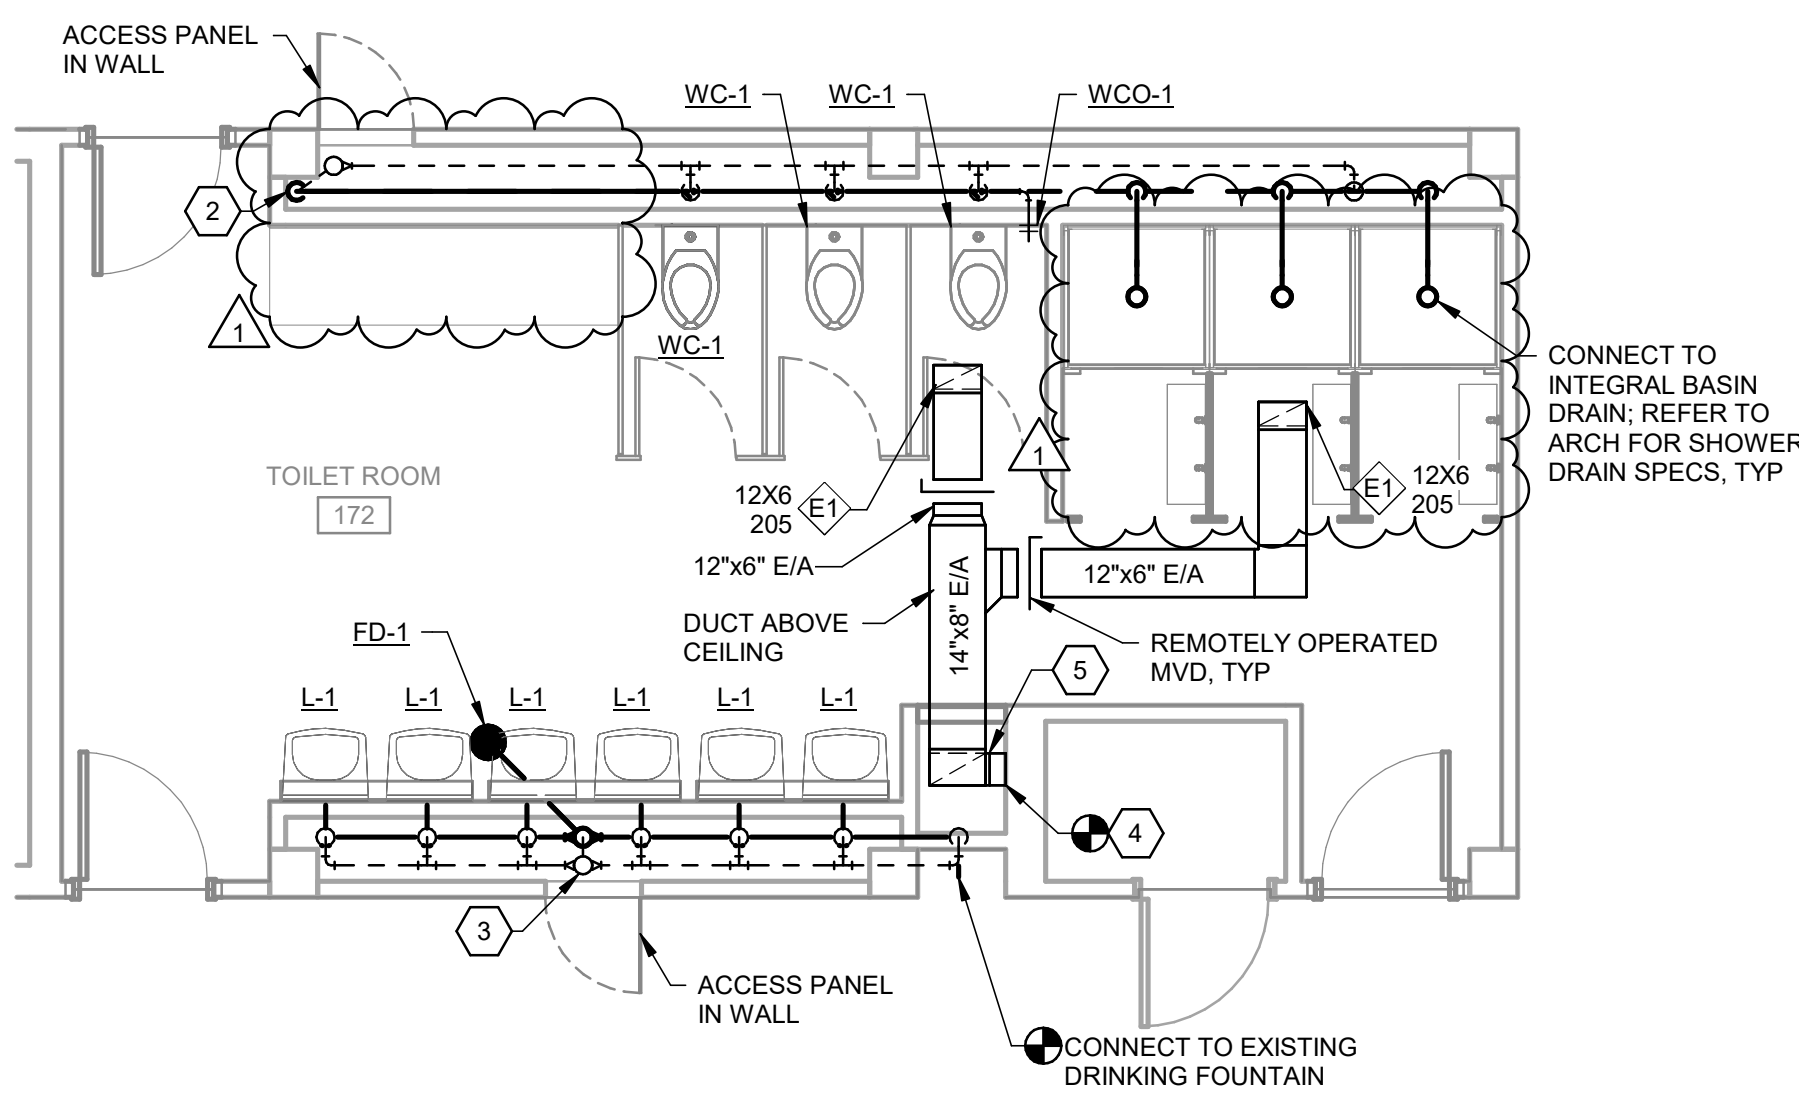

3 ENLARGED PLAN #2
1/4" = 1'-0"

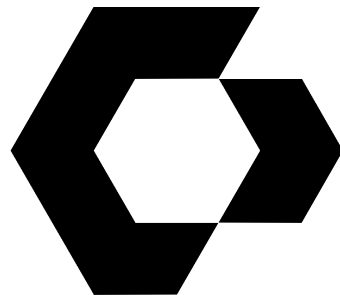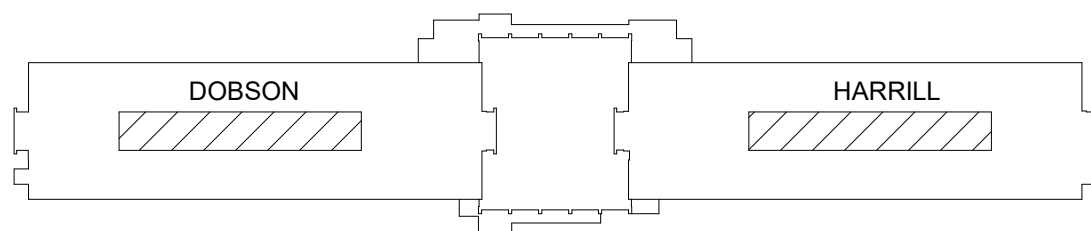

CYNTERGY
810 S CINCINNATI AVE, STE 200
TULSA, OK 74119
918.877.6000

CYNTERGY ENGINEERING, PLLC
LICENSE # 3537 | EXPIRES 06/30/2024



SAMUEL KESSLER GRAVES, PE
ENGINEER OF RECORD

DOBSON-HARRILL RESTROOM RENOVATION

THIS DRAWING WAS PREPARED SOLELY AND EXCLUSIVELY FOR EXECUTION OF THE PROJECT IDENTIFIED WITHIN THESE DOCUMENTS CONTEMPORANEOUSLY WITH ITS ISSUE DATE. THIS DRAWING MAY NOT BE USED ON OTHER PROJECTS OR FOR ADDITIONS TO THE PROJECT OUTSIDE THE SCOPE OF WORK WITHOUT WRITTEN CONSENT OF THE OWNER, ARCHITECT, AND THE ARCHITECT'S CONSULTANTS. THE ARCHITECT AND THE ARCHITECT'S CONSULTANTS ARE THE AUTHORS AND OWNERS OF THEIR RESPECTIVE DRAWINGS AND SPECIFICATIONS, AND RETAIN ALL COMMON LAW, STATUTORY, AND OTHER RIGHTS, INCLUDING COPYRIGHTS.


[illegible]

ISSUE DATE: 03/29/2023
CHECKED BY: SKG
DRAWN BY: SMN

SHEET NAME
DOBSON-HARRILL DWV FLOOR
PLANS

SHEET NUMBER

P-101

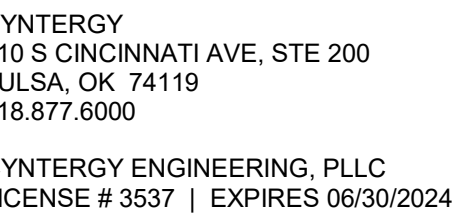

1. HARRILL WING RESTROOMS SHOWN IN VIEW.
DOBSON WING RESTROOMS SIMILAR.

1. HARRILL WING RESTROOMS SHOWN IN VIEW.
DOBSON WING RESTROOMS SIMILAR.

1. REMOVED.

2. DCW/DHW RISER 1; RE: 1/P-902.
3. DCW/DHW RISER 2; RE: 2/P-902
4. CONNECT SINK TO EXISTING DCW/DHW RISER.


$$1/8'' = 1'-0''$$

0

GENERAL NOTE: DEMO ALL PLUMBING FIXTURES AND PIPING FROM UNDERSIDE OF ROOF (EXISTING VTR TO REMAIN) DOWN TO CONNECTION TO THE MAIN IN THE CRAWLSPACE PRIOR TO STARTING INSTALLATION.



$$\frac{1}{4}'' = 1'-0''$$

DOBSON-HARRILL WAG ENLARGED PLAN #1

GENERAL NOTE: DEMO ALL PLUMBING FIXTURES AND PIPING FROM UNDERSIDE OF ROOF (EXISTING VTR TO REMAIN) DOWN TO CONNECTION TO THE MAIN IN THE CRAWLSPACE PRIOR TO STARTING INSTALLATION.


$$1/4^{\circ} = 1'-0''$$

DOBSON-HARRILL WAG ENLARGED PLAN #2

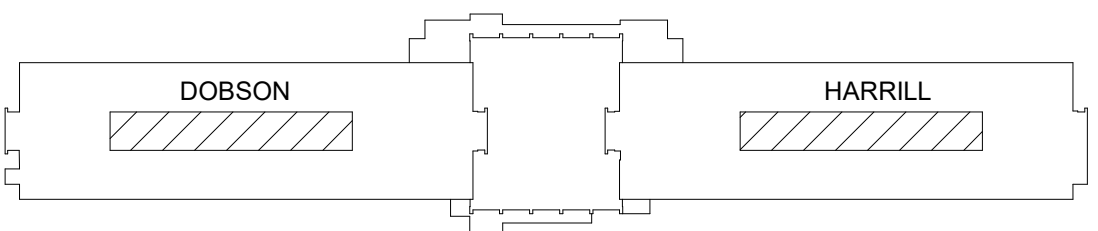

DOBSON-HARRILL RESTROOM RENOVATION

2001 STREET NORTH EAST
MIAMI, OK 74354

THIS DRAWING WAS PREPARED SOLELY AND EXCLUSIVELY FOR EXECUTION OF THE PROJECT IDENTIFIED WITH THESE DOCUMENTS CONTEMPORANEOUSLY WITH ITS ISSUE DATE. THIS DRAWING MAY NOT BE USED ON OTHER PROJECTS OR FOR ADDITIONS TO THE PROJECT OUTSIDE THE SCOPE OF WORK WITHOUT WRITTEN CONSENT OF THE OWNER, ARCHITECT, AND THE ARCHITECT'S CONSULTANTS. THE ARCHITECT AND THE ARCHITECT'S CONSULTANTS ARE THE AUTHORS AND OWNERS OF THEIR RESPECTIVE DRAWINGS AND SPECIFICATIONS, AND RETAIN ALL COMMON LAW, STATUTORY, AND OTHER RIGHTS, INCLUDING COPYRIGHTS.


[illegible]

ISSUE DATE: 03/29/2023
CHECKED BY: SKG
DRAWN BY: SMN

ROBSON-HARRILL WAG FLOOR
PLANS

SHEET NUMBER

P-111

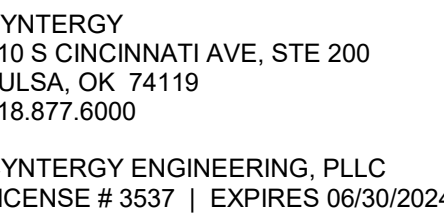
[illegible]

PLUMBING DETAILS

SHEET NUMBER
P-501

AIR DEVICE SCHEDULE							
MARK	MANUFACTURER MODEL	SERVICE	TYPE	MOUNTING	FACE SIZE	MATERIAL	REMARKS
E1	TITUS 25RL	E/A	LOUVERED	SURFACE	SEE PLANS	ALUM.	ALL
REMARKS: 1. PROVIDE STANDARD WHITE FINISH. 2. REFER TO PLANS FOR NECK SIZE. 3. PROVIDE SPECIFIC MODEL/MANUFACTURER OR APPROVED EQUAL.							

PLUMBING FIXTURE SCHEDULE								
MARK	FIXTURE	MANUFACTURE MODEL	TRIM	CONNECTIONS				REMARKS
				WASTE	VENT	DCW	DHW	
WC-1	WATER CLOSET (WALL HUNG, FLUSH VALVE, SIPHON JET)	ZURN Z5615-BWL	FLUSH VALVE: ZURN MODEL Z8000AV-HET 1.28 GPF; SEAT: ZURN MODEL Z695SS-EL OPEN FRONT ELONGATED; CARRIER: ZURN MODEL Z1201/1202; FIXTURE COLOR: WHITE	4"	2"	1 1/4"	--	1,2
UR-1	REMOVED.	--	--	--	--	--	--	--
L-1	LAVATORY (WALL HUNG, ADA)	ZURN Z5344	FAUCET: ZURN MODEL Z81000-XL-28M 2-HOLE DRILLING ON 4" CENTERS, 0.5 GPM AERATOR; GRID STRAINER DRAIN: ZURN MODEL Z8743-PC; CARRIER: ZURN Z1231; FIXTURE COLOR: WHITE	2"	1 1/2"	1/2"	1/2"	1,4,5,6
S-1	SINK (SINGLE COMPARTMENT, COUNTERTOP, ADA)	JUST SLN-ADA-2017-A-GR	FAUCET: ZURN MODEL Z812A4-XL, 0.5 GPM AERATOR	2"	1 1/2"	1/2"	1/2"	1,4,5,8,10
SH-1	SHOWER HEAD/VALVE	ZURN Z7101-SS-LH	SHOWER HEAD & VALVE: ZURN MODEL Z7101-SS-LH (PRESS. BALANCE, PRESS. & TEMP. CONTROL); CURTAIN ROD WITH ANTI-BACTERIAL WHITE VINYL CURTAIN (WITH HOOKS).	--	--	1/2"	1/2"	1
WCO-1	WALL CLEANOUT	ZURN Z1446	ADJUSTABLE, STAINLESS STEEL WALL COVER	--	--	--	--	7,10
REMARKS: 1. REFER TO ARCHITECTURAL PLANS AND ELEVATIONS FOR FINAL FIXTURE LOCATION AND MOUNTING HEIGHTS, MOUNT PER ADA REQUIREMENTS WHERE INDICATED. 2. PROVIDE FLUSH VALVE WITH SWEAT SOLDER ADAPTER AND CAST WALL FLANGE (ESCUTCHEON) WITH SET SCREW. 3. PROVIDE FLUSH VALVE WITH ADA COMPLIANT HANDLE. 4. PROVIDE CHROME PLATED, HEAVY DUTY, COMMERCIAL GRADE, ANGLE SUPPLY (HOT AND COLD, AS REQUIRED) WITH WHEEL HANDLE STOP(S), STAINLESS STEEL FLEXIBLE RISER HOSE(S), AND CHROME PLATED WALL ESCUTCHEON(S). 5. PROVIDE 1/2" GAUGE CHROME PLATED P-TRAP WITH CLEANOUT AND WALL ESCUTCHEON. 6. PROVIDE TRUEBRO INC. HAND LAY-GUARD OR EQUAL UNDERSINK PROTECTIVE PIPE COVERING MODEL 103, FOR WASTE, HOT, AND COLD PIPING, COLOR: WHITE. COVERS SHALL BE SECURED WITH SNAP-CLIP FLUSH REUSABLE FASTENERS. PROVIDE ALL REQUIRED ACCESSORIES FOR A COMPLETE INSTALLATION MEETING CURRENT ADA STANDARDS WHERE REQUIRED. 7. PROVIDE CAULKED OR THREADED CLEANOUT, EXTEND ACCESS COVER TO FINISHED WALL SURFACE. ENSURE AMPLE CLEARANCE AT CLEANOUT FOR RODDING OF DRAINAGE SYSTEM. 8. PROVIDE 1/2" DEEP SINGLE/DOUBLE COMPARTMENT, 18 GAUGE, TYPE 304 STAINLESS STEEL, SELF-RIMMING, UNDERCOATED, 3 HOLE DRILLING IN LEDGEBACK, WITH ZURN STRAINER Z8741-17-SS. 9. REMOVED. 10. PROVIDE SPECIFIED MODEL/MANUFACTURER OR APPROVED EQUAL.								

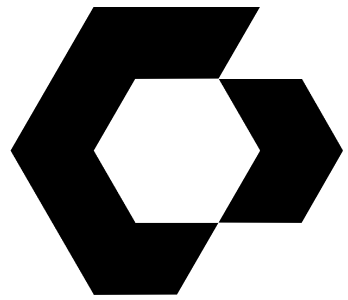

CYNTERGY
810 S CINCINNATI AVE, STE 200
TULSA, OK 74119
918.877.6000

CYNTERGY ENGINEERING, PLLC
LICENSE # 3537 | EXPIRES 06/30/2024



SAMUEL KESSLER GRAVES, PE
ENGINEER OF RECORD

DOBSON-HARRILL RESTROOM
RENOVATION
NEO
2001 STREET NORTHEAST
TULSA, OK 74104

THIS DRAWING WAS PREPARED SOLELY AND EXCLUSIVELY FOR EXECUTION OF THE PROJECT IDENTIFIED WITHIN THESE DOCUMENTS CONTAINED HEREIN. IT IS THE RESPONSIBILITY OF THE USER OF THIS DRAWING TO VERIFY THAT THE PROJECT IDENTIFIED WITHIN THESE DOCUMENTS IS THE SAME AS THE PROJECT FOR WHICH THIS DRAWING WAS PREPARED. THIS DRAWING MAY NOT BE USED ON OTHER PROJECTS OR FOR ADDITIONS TO THE PROJECT OUTSIDE THE SCOPE OF WORK WITHOUT WRITTEN CONSENT OF THE OWNER, ARCHITECT, AND THE ARCHITECT'S CONSULTANTS. THE ARCHITECT AND THE ARCHITECT'S CONSULTANTS ARE THE AUTHORS AND OWNERS OF THEIR RESPECTIVE DRAWINGS AND SPECIFICATIONS, AND RETAIN ALL COMMON LAW, STATUTORY, AND OTHER RIGHTS, INCLUDING COPYRIGHTS.

ISSUES / REVISIONS		
	03/29/2023	ISSUE FOR CONSTRUCTION
1	02/04/2026	ASI 2

ISSUE DATE: 03/29/2023
CHECKED BY: SKG
DRAWN BY: SMN

SHEET NAME:
PLUMBING SCHEDULES

SHEET NUMBER:
P-601

C:\Users\graveswa\Documents\Bent\Bent-Harrill Restroom Renovation_Plan_2023_gradeswale.rvt
Printed: 2/2/2026 8:51:16 AM
Project Number: P10850.0100

KEYNOTES

1.

SS IN WALL.

2.

SS BELOW FLOOR.

3.

CONNECT TO (E) 4" SS IN CRAWLSPACE.
PROVIDE FULL-SIZED CO.

4.

CIRCUIT VENT FOR THREE (3) SHOWER
DRAINS.

CYNTERGY
810 S CINCINNATI AVE, STE 200
TULSA, OK 74119
918.877.6000

CYNTERGY ENGINEERING, PLLC
LICENSE # 3537 | EXPIRES 06/30/2024

SAMUEL
KESSLER
GRAVES
29246
OKLAHOMA

02.04.26

SAMUEL KESSLER GRAVES, PE
ENGINEER OF RECORD

DOBSON-HARRILL RESTROOM
RENOVATION
NEO
2001 STREET NORTHEAST
MARIETTA, GA 30067



THIS DRAWING WAS PREPARED SOLELY AND EXCLUSIVELY FOR EXECUTION OF THE PROJECT IDENTIFIED WITHIN THESE DOCUMENTS CONTAINED HEREIN. IT IS THE PROPERTY OF THE ARCHITECT AND THE ARCHITECT'S CONSULTANTS. THE ARCHITECT AND THE ARCHITECT'S CONSULTANTS ARE THE AUTHORS AND OWNERS OF THEIR RESPECTIVE DRAWINGS AND SPECIFICATIONS, AND RETAIN ALL COMMON LAW, STATUTORY, AND OTHER RIGHTS, INCLUDING COPYRIGHTS.

ISSUES / REVISIONS		
	03/29/2023	ISSUE FOR CONSTRUCTION
1	02/04/2026	ASI 2


ISSUE DATE: 03/29/2023
CHECKED BY: SKG
DRAWN BY: SMN

SHEET NAME
SANITARY RISER DIAGRAMS

SHEET NUMBER
P-901

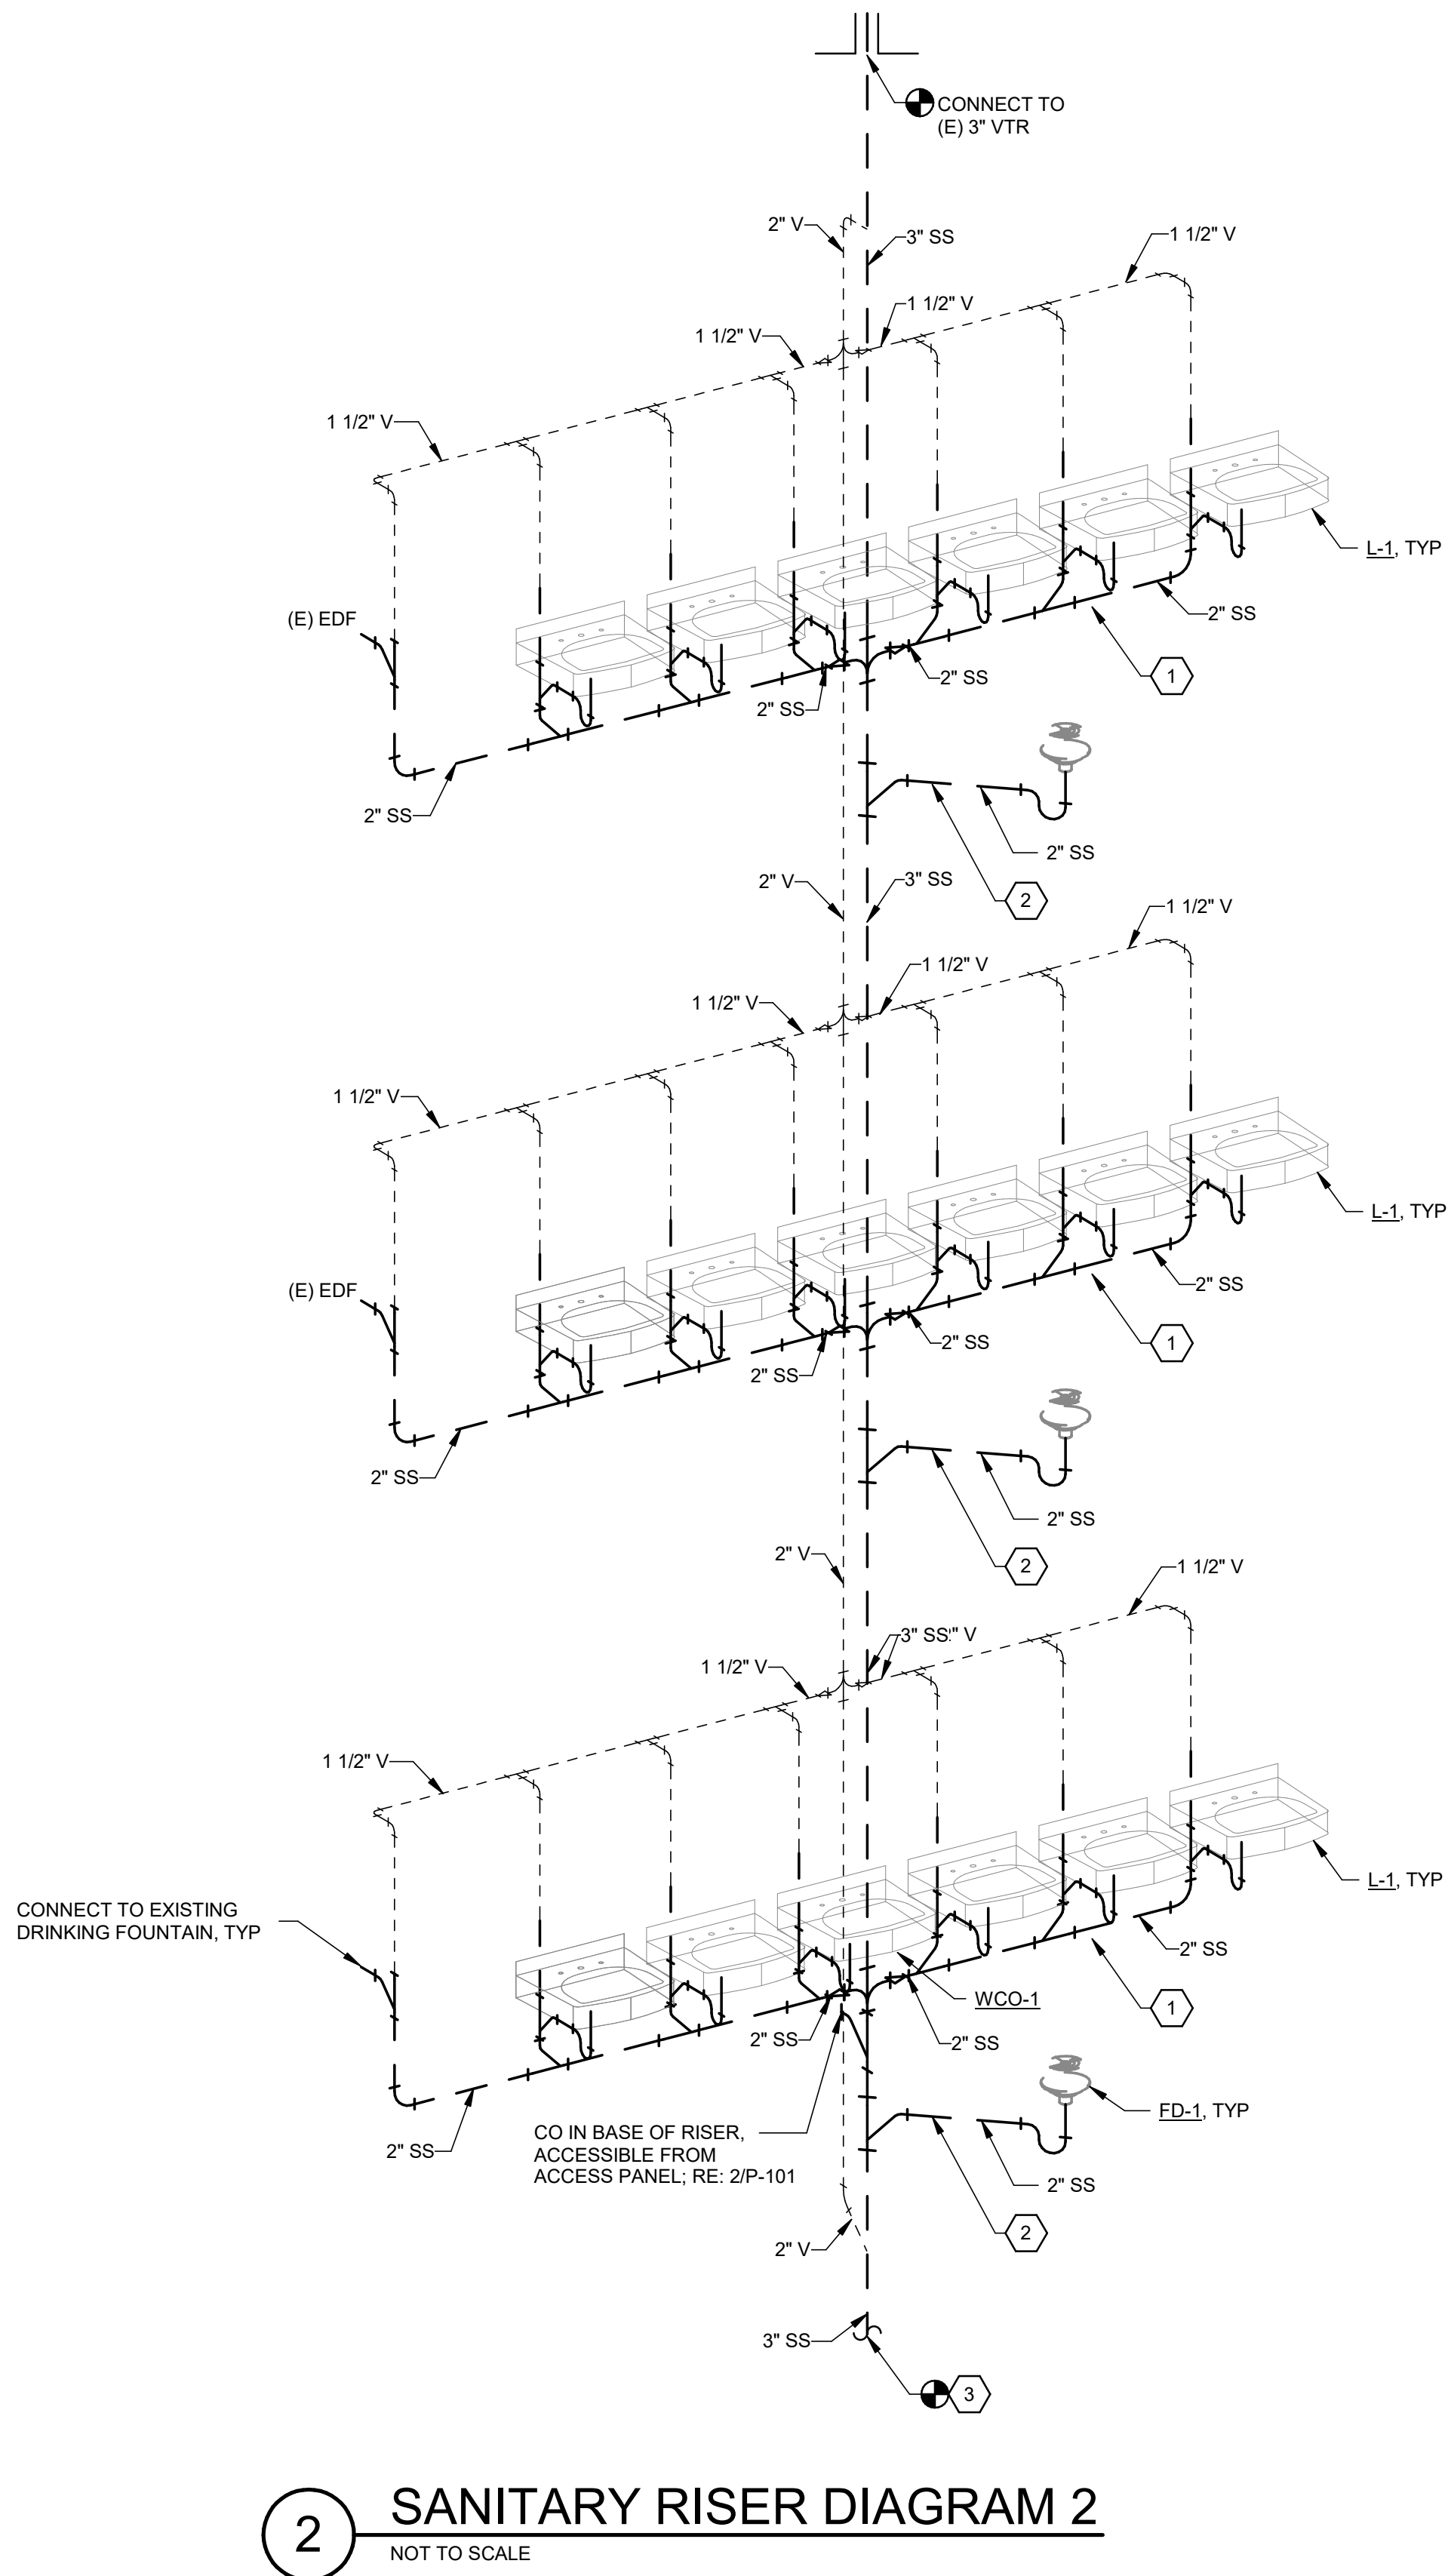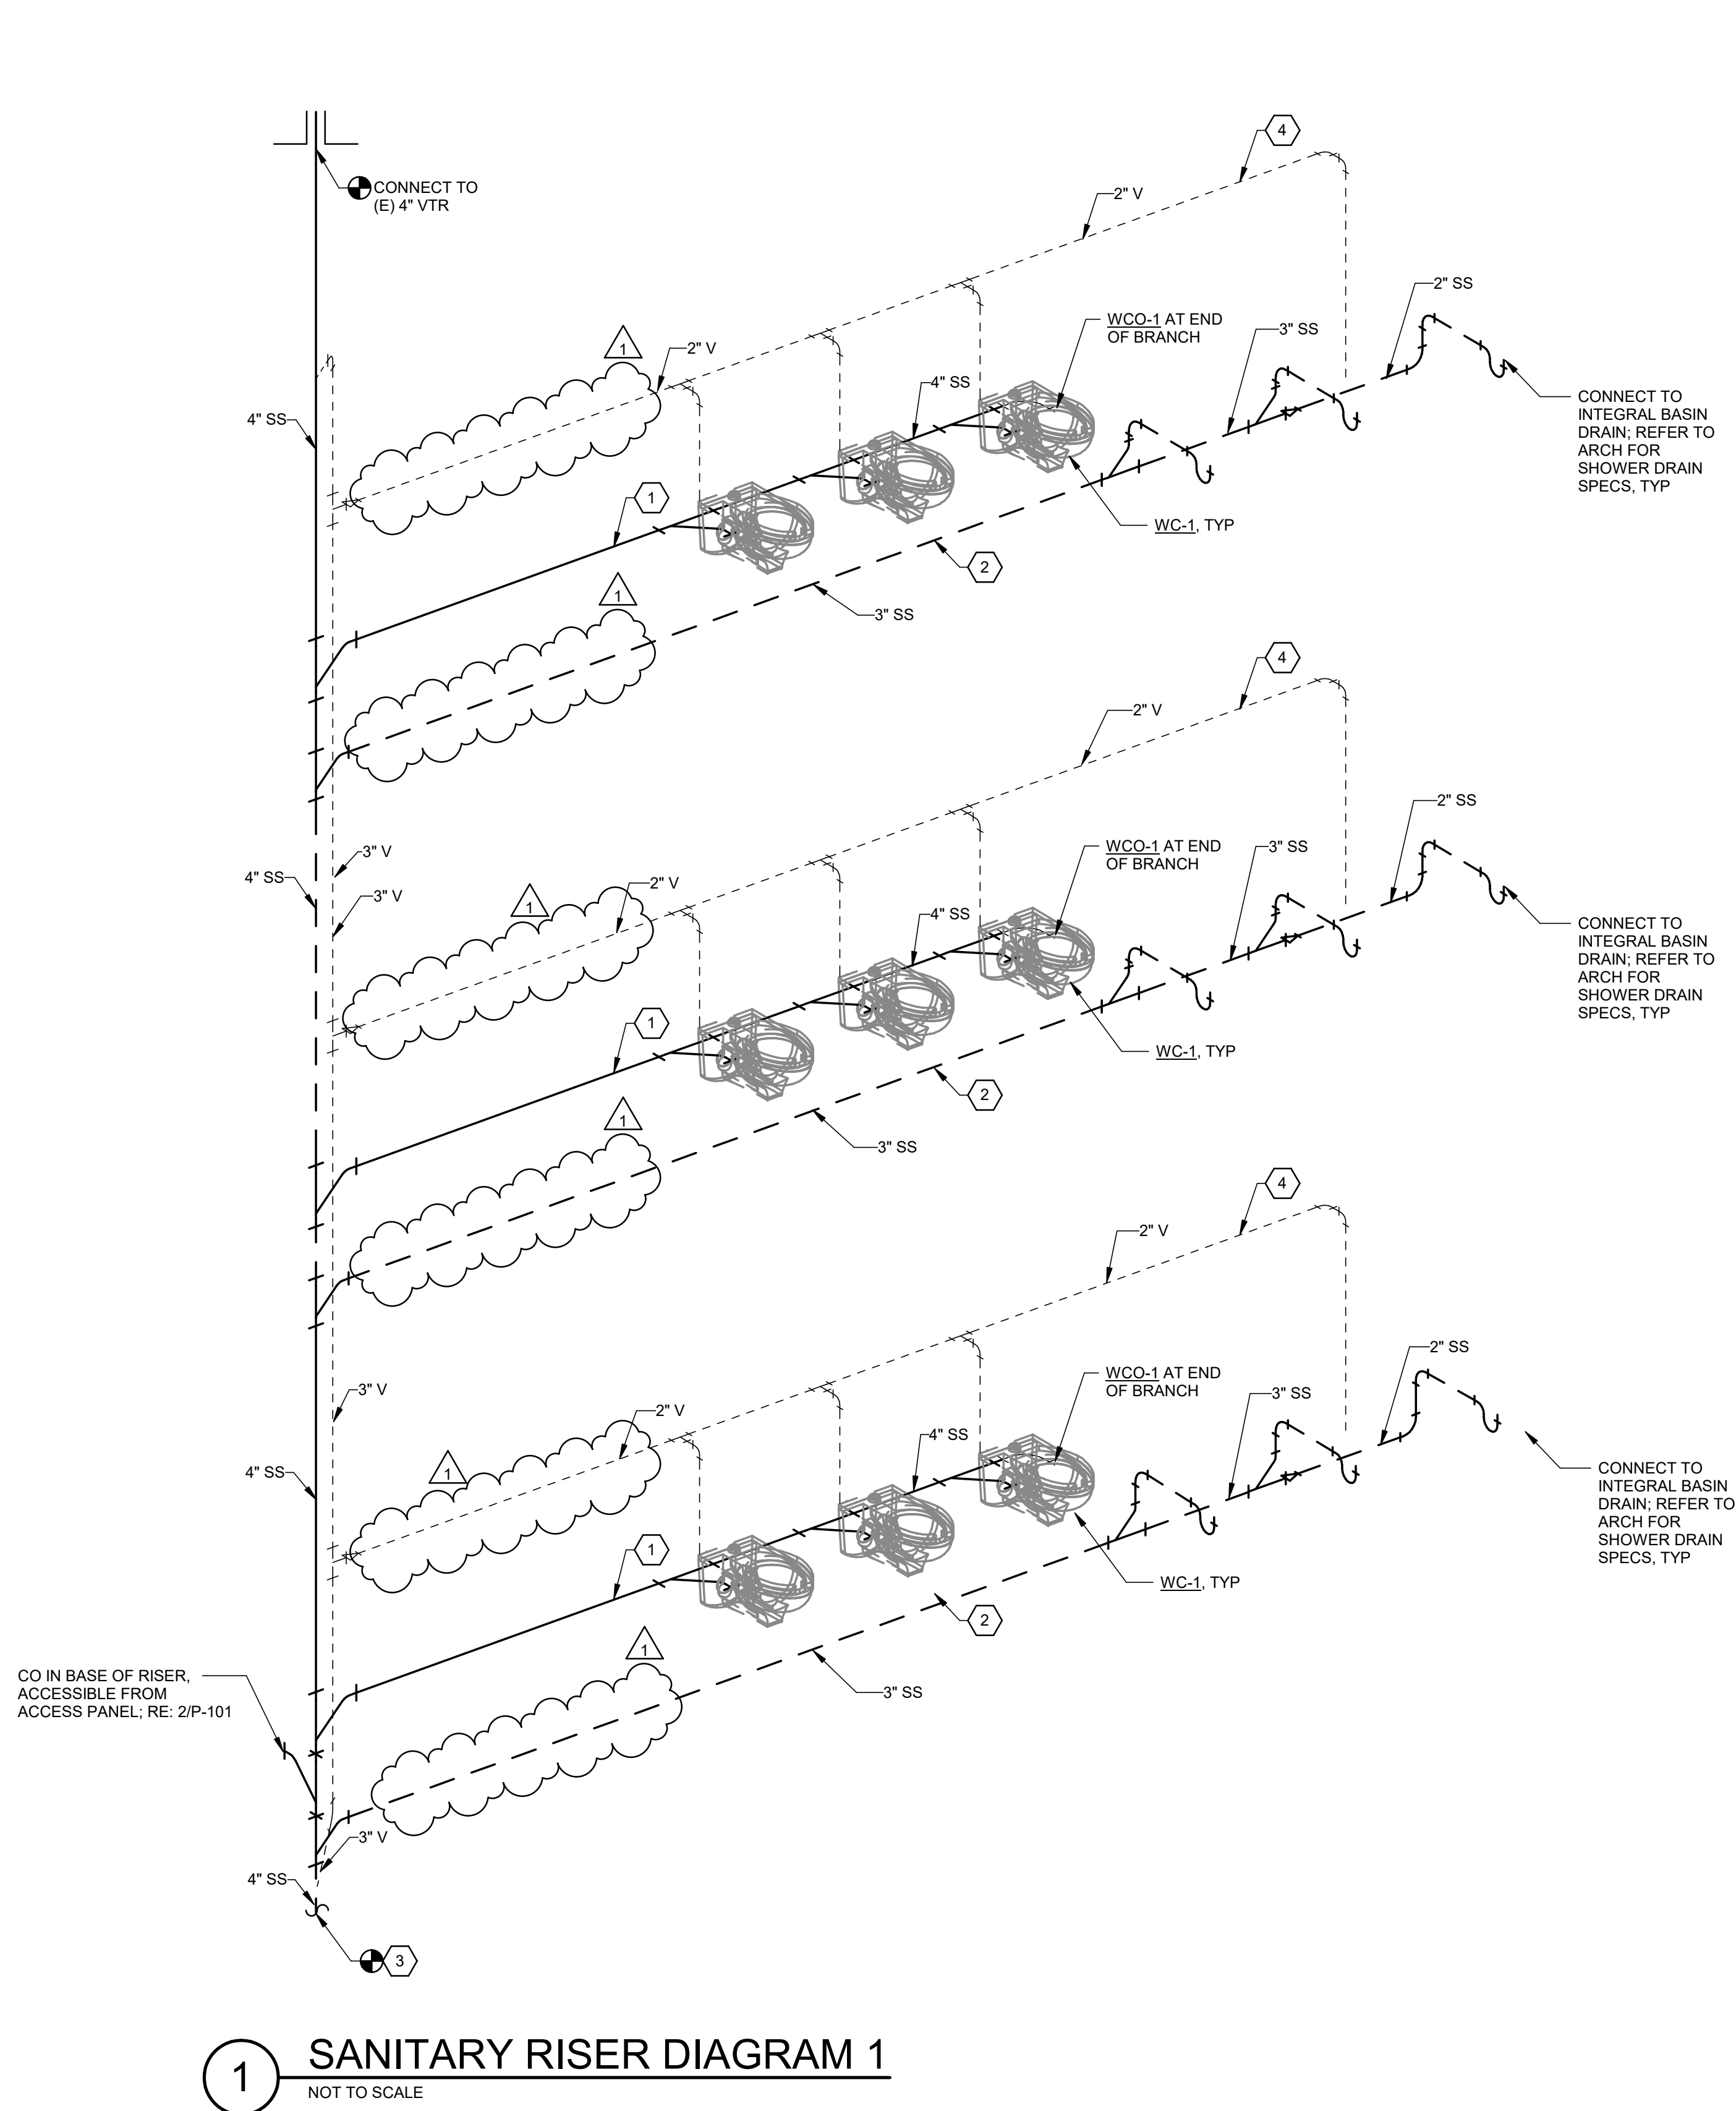


Project Number: P10850.0100
Printed: 2/2/2026 8:51:16 AM
C:\Users\gmadsen\OneDrive\Documents\Bent\Benson-Harrill Restroom Renovation_Plan_2023_gmadsen\dwg\14

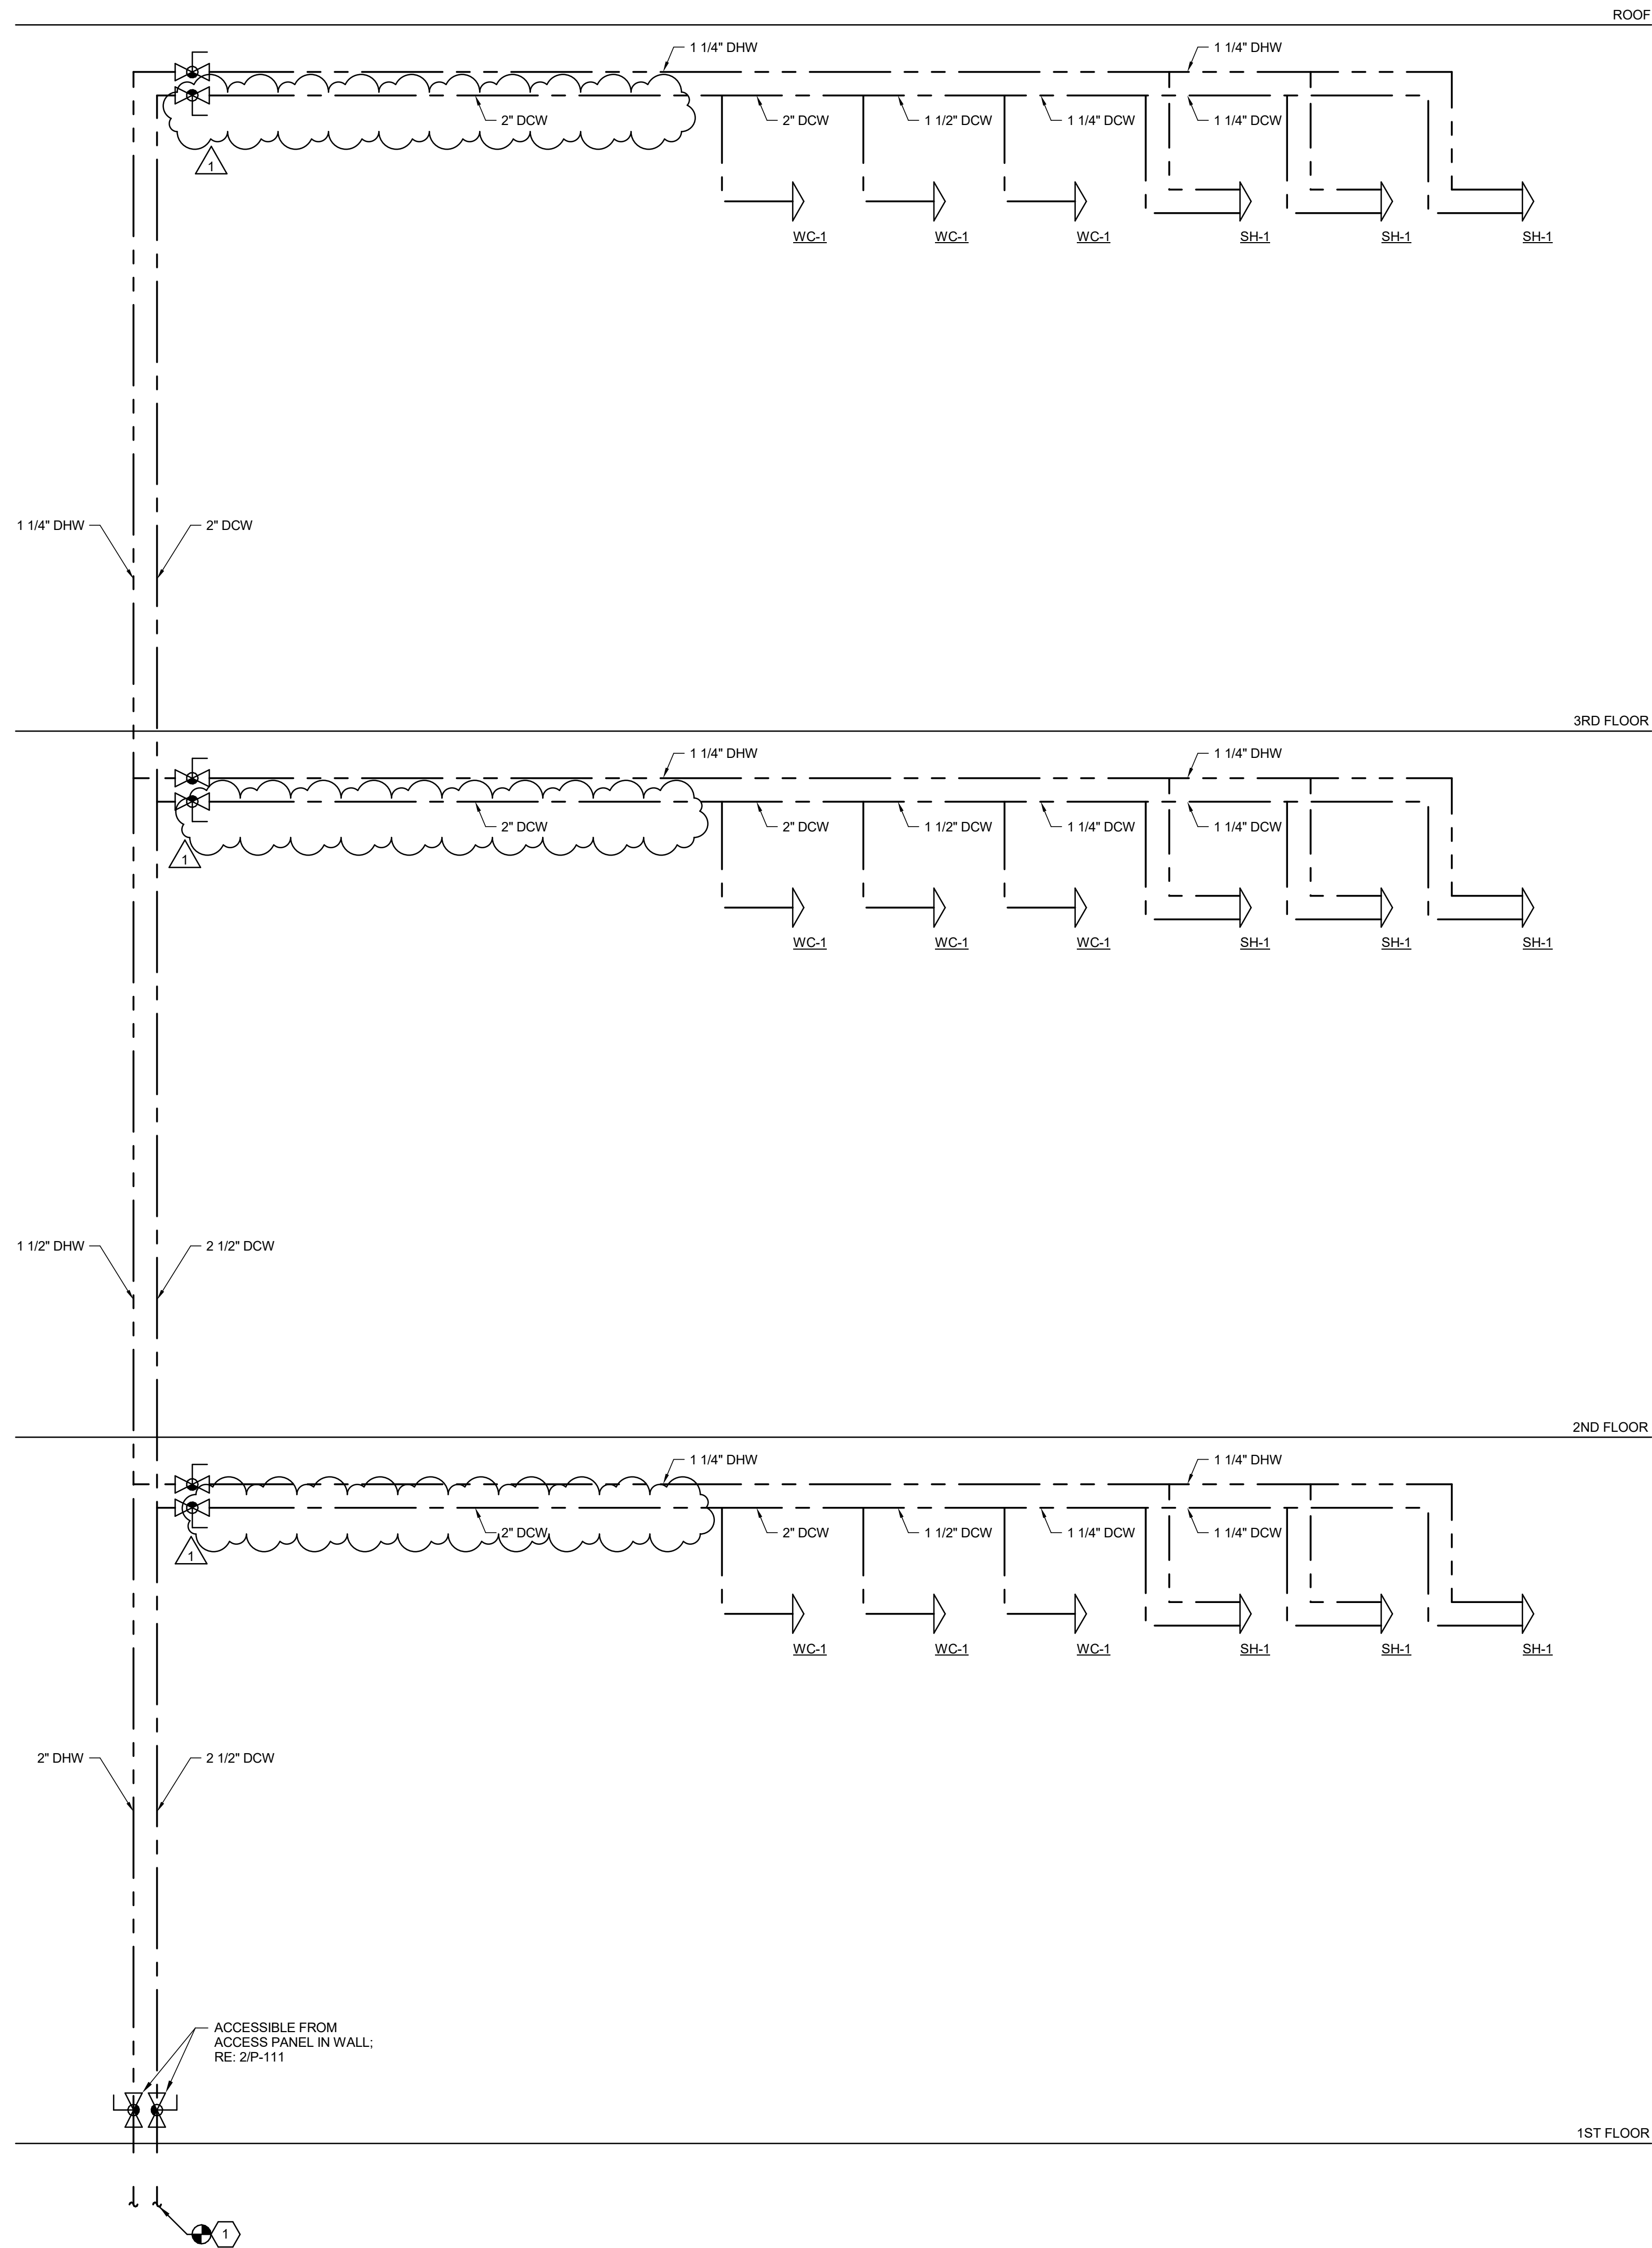


1 DCW/DHW RISER DIAGRAM 1
NOT TO SCALE

KEYNOTES
1. CONNECT TO (E) 2 1/2\" OR LARGER DHW IN CRAWLSPACE.

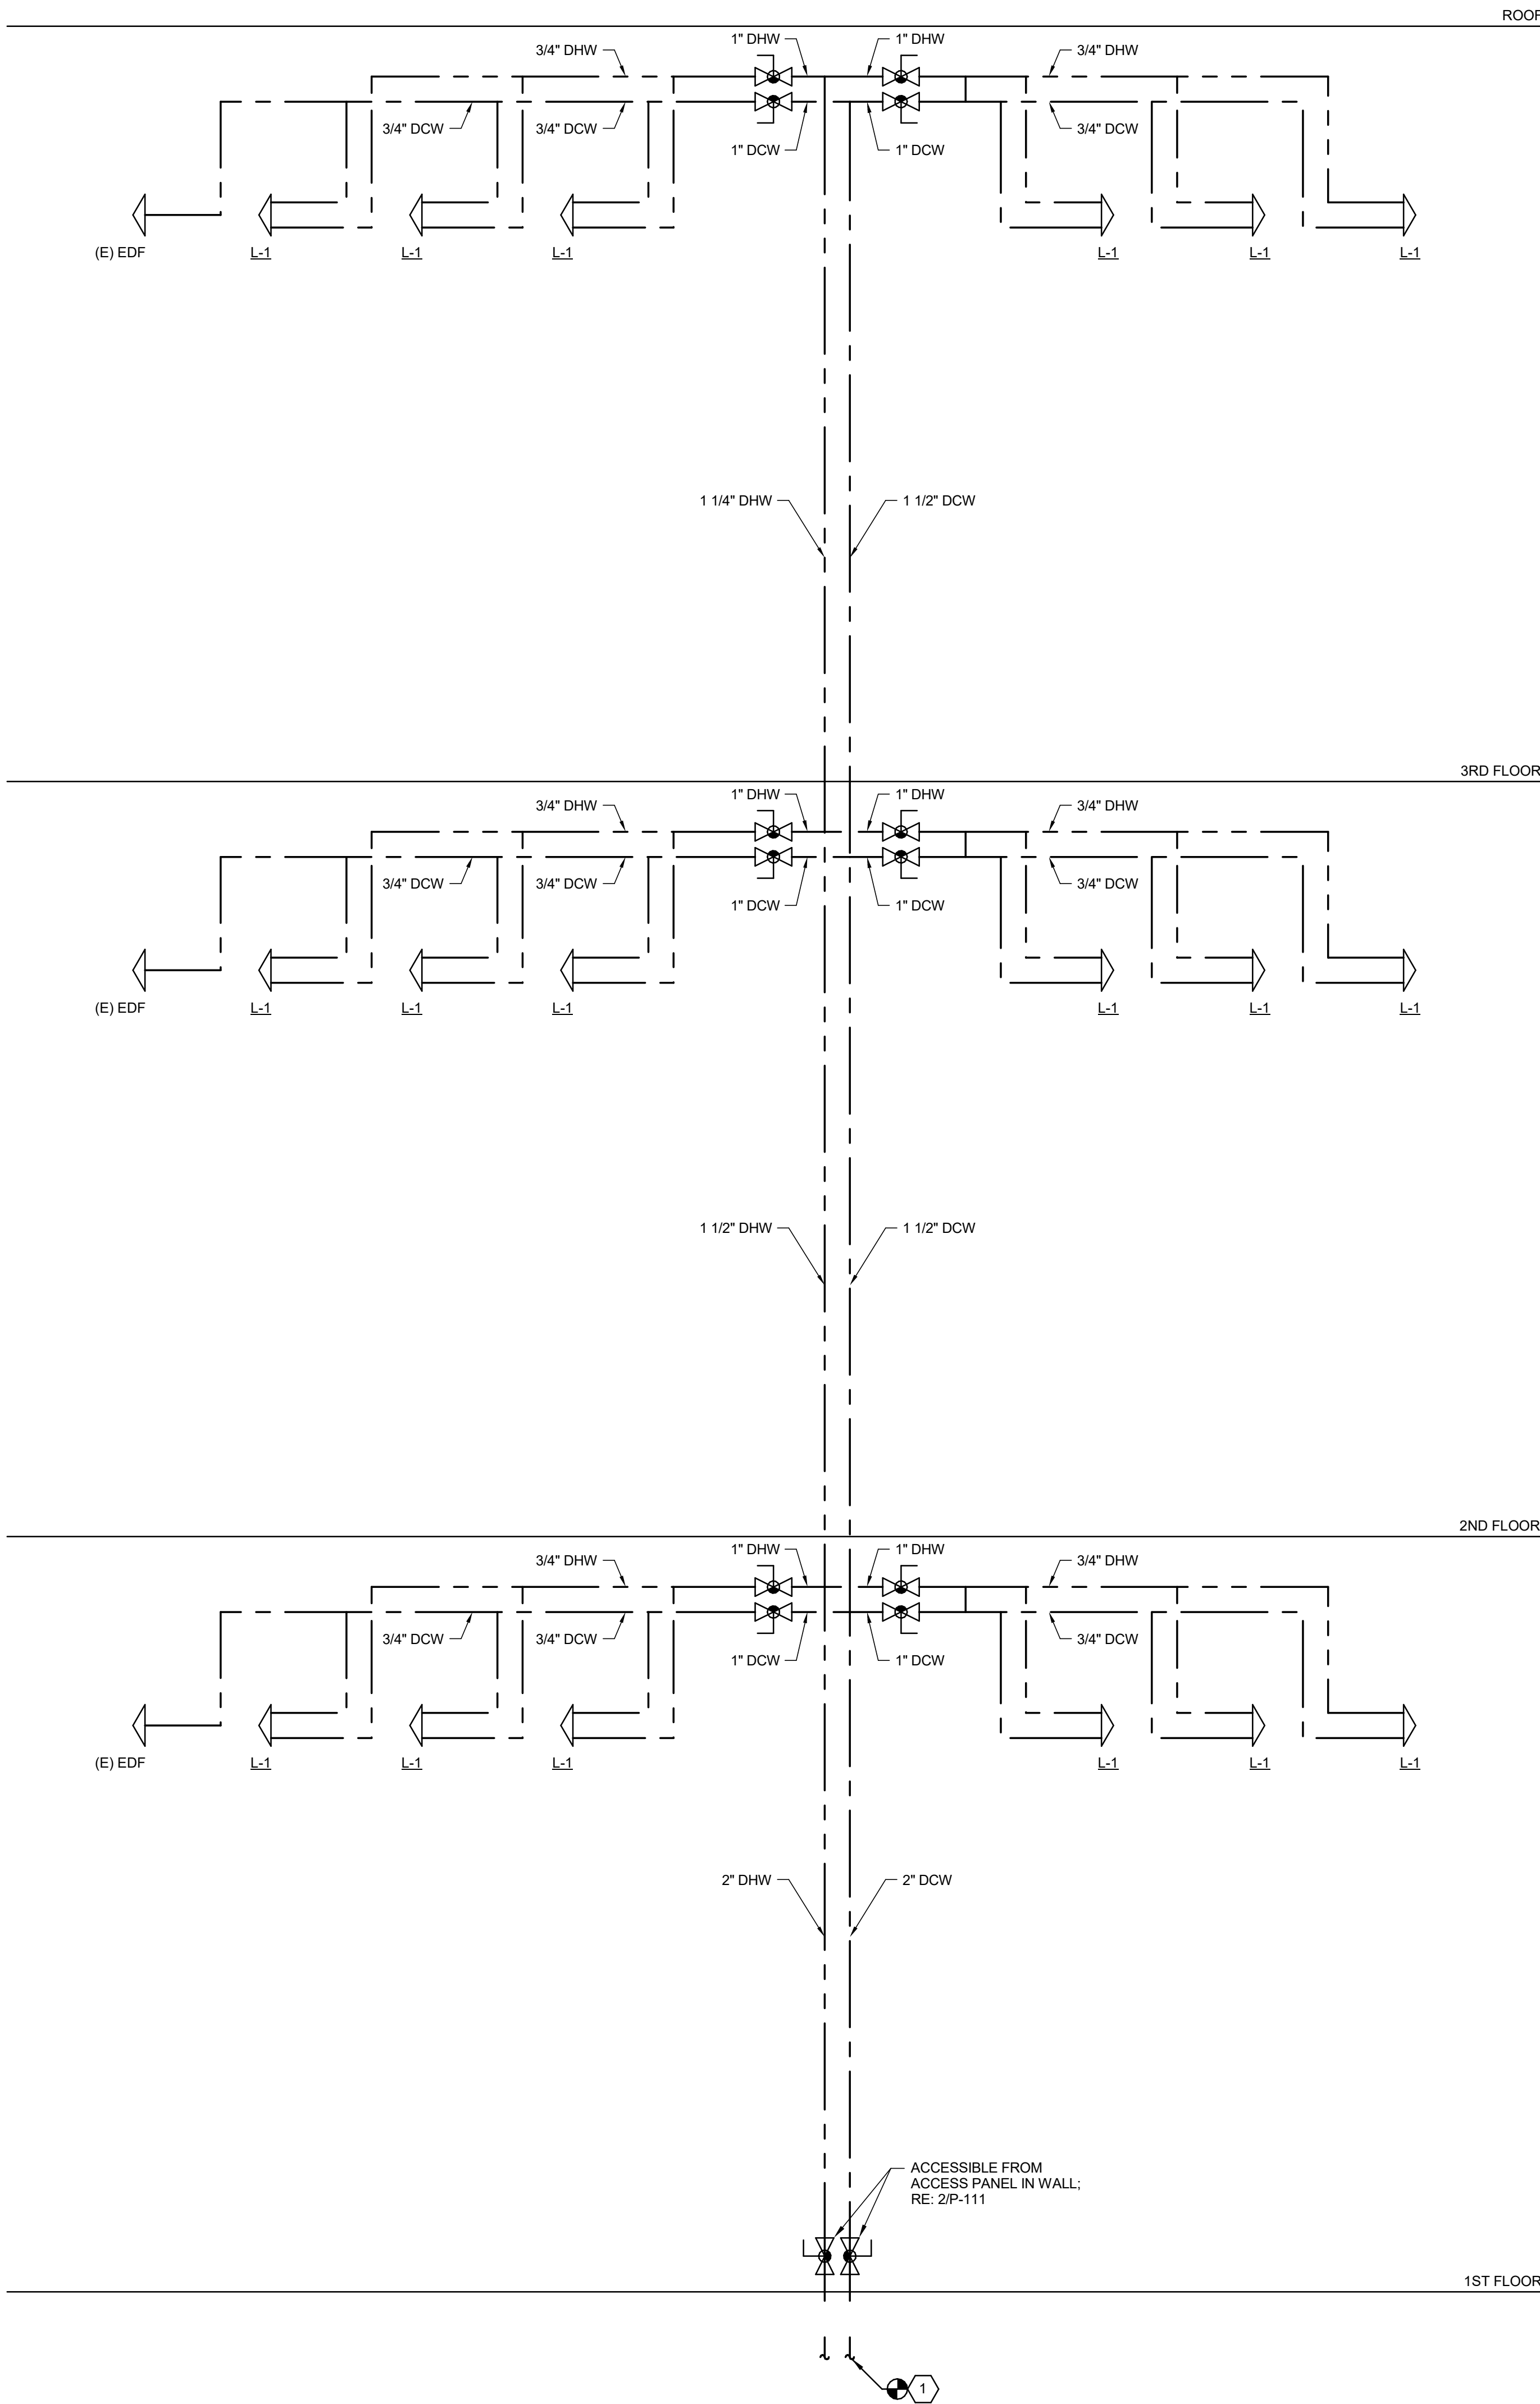

2 DCW/DHW RISER DIAGRAM 2
NOT TO SCALE

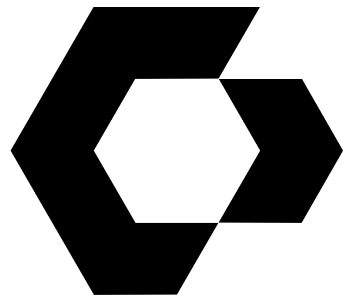

CYNERGY
810 S CINCINNATI AVE, STE 200
TULSA, OK 74119
918.877.6000

CYNERGY ENGINEERING, PLLC
LICENSE # 3537 | EXPIRES 06/30/2024



SAMUEL
KESSLER
GRAVES
29246
02-04-26
OKLAHOMA
PE
ENGINEER OF RECORD

**DOBSON-HARRILL RESTROOM
RENOVATION**
NEO
200 STREET NORTHEAST
MARIETTA, GA 30067

THIS DRAWING WAS PREPARED SOLELY AND EXCLUSIVELY FOR EXECUTION OF THE PROJECT IDENTIFIED WITHIN THESE DOCUMENTS CONTAINED HEREIN. IT IS THE PROPERTY OF THE ARCHITECT AND THE ARCHITECT'S CONSULTANTS. THE ARCHITECT AND THE ARCHITECT'S CONSULTANTS ARE THE AUTHORS AND OWNERS OF THEIR RESPECTIVE DRAWINGS AND SPECIFICATIONS, AND RETAIN ALL COMMON LAW, STATUTORY, AND OTHER RIGHTS, INCLUDING COPYRIGHTS.

ISSUES / REVISIONS	
1	03/29/2023 ISSUE FOR CONSTRUCTION
	02/04/2026 ASI 2

ISSUE DATE: 03/29/2023
CHECKED BY: SKG
DRAWN BY: SMN

SHEET NAME
DCW/DHW RISER DIAGRAMS

SHEET NUMBER
P-902