




ADDITION / ALTERATION OF
FIRE STATION
 ARKANSAS AIR NATIONAL GUARD
 FORT SMITH, ARKANSAS

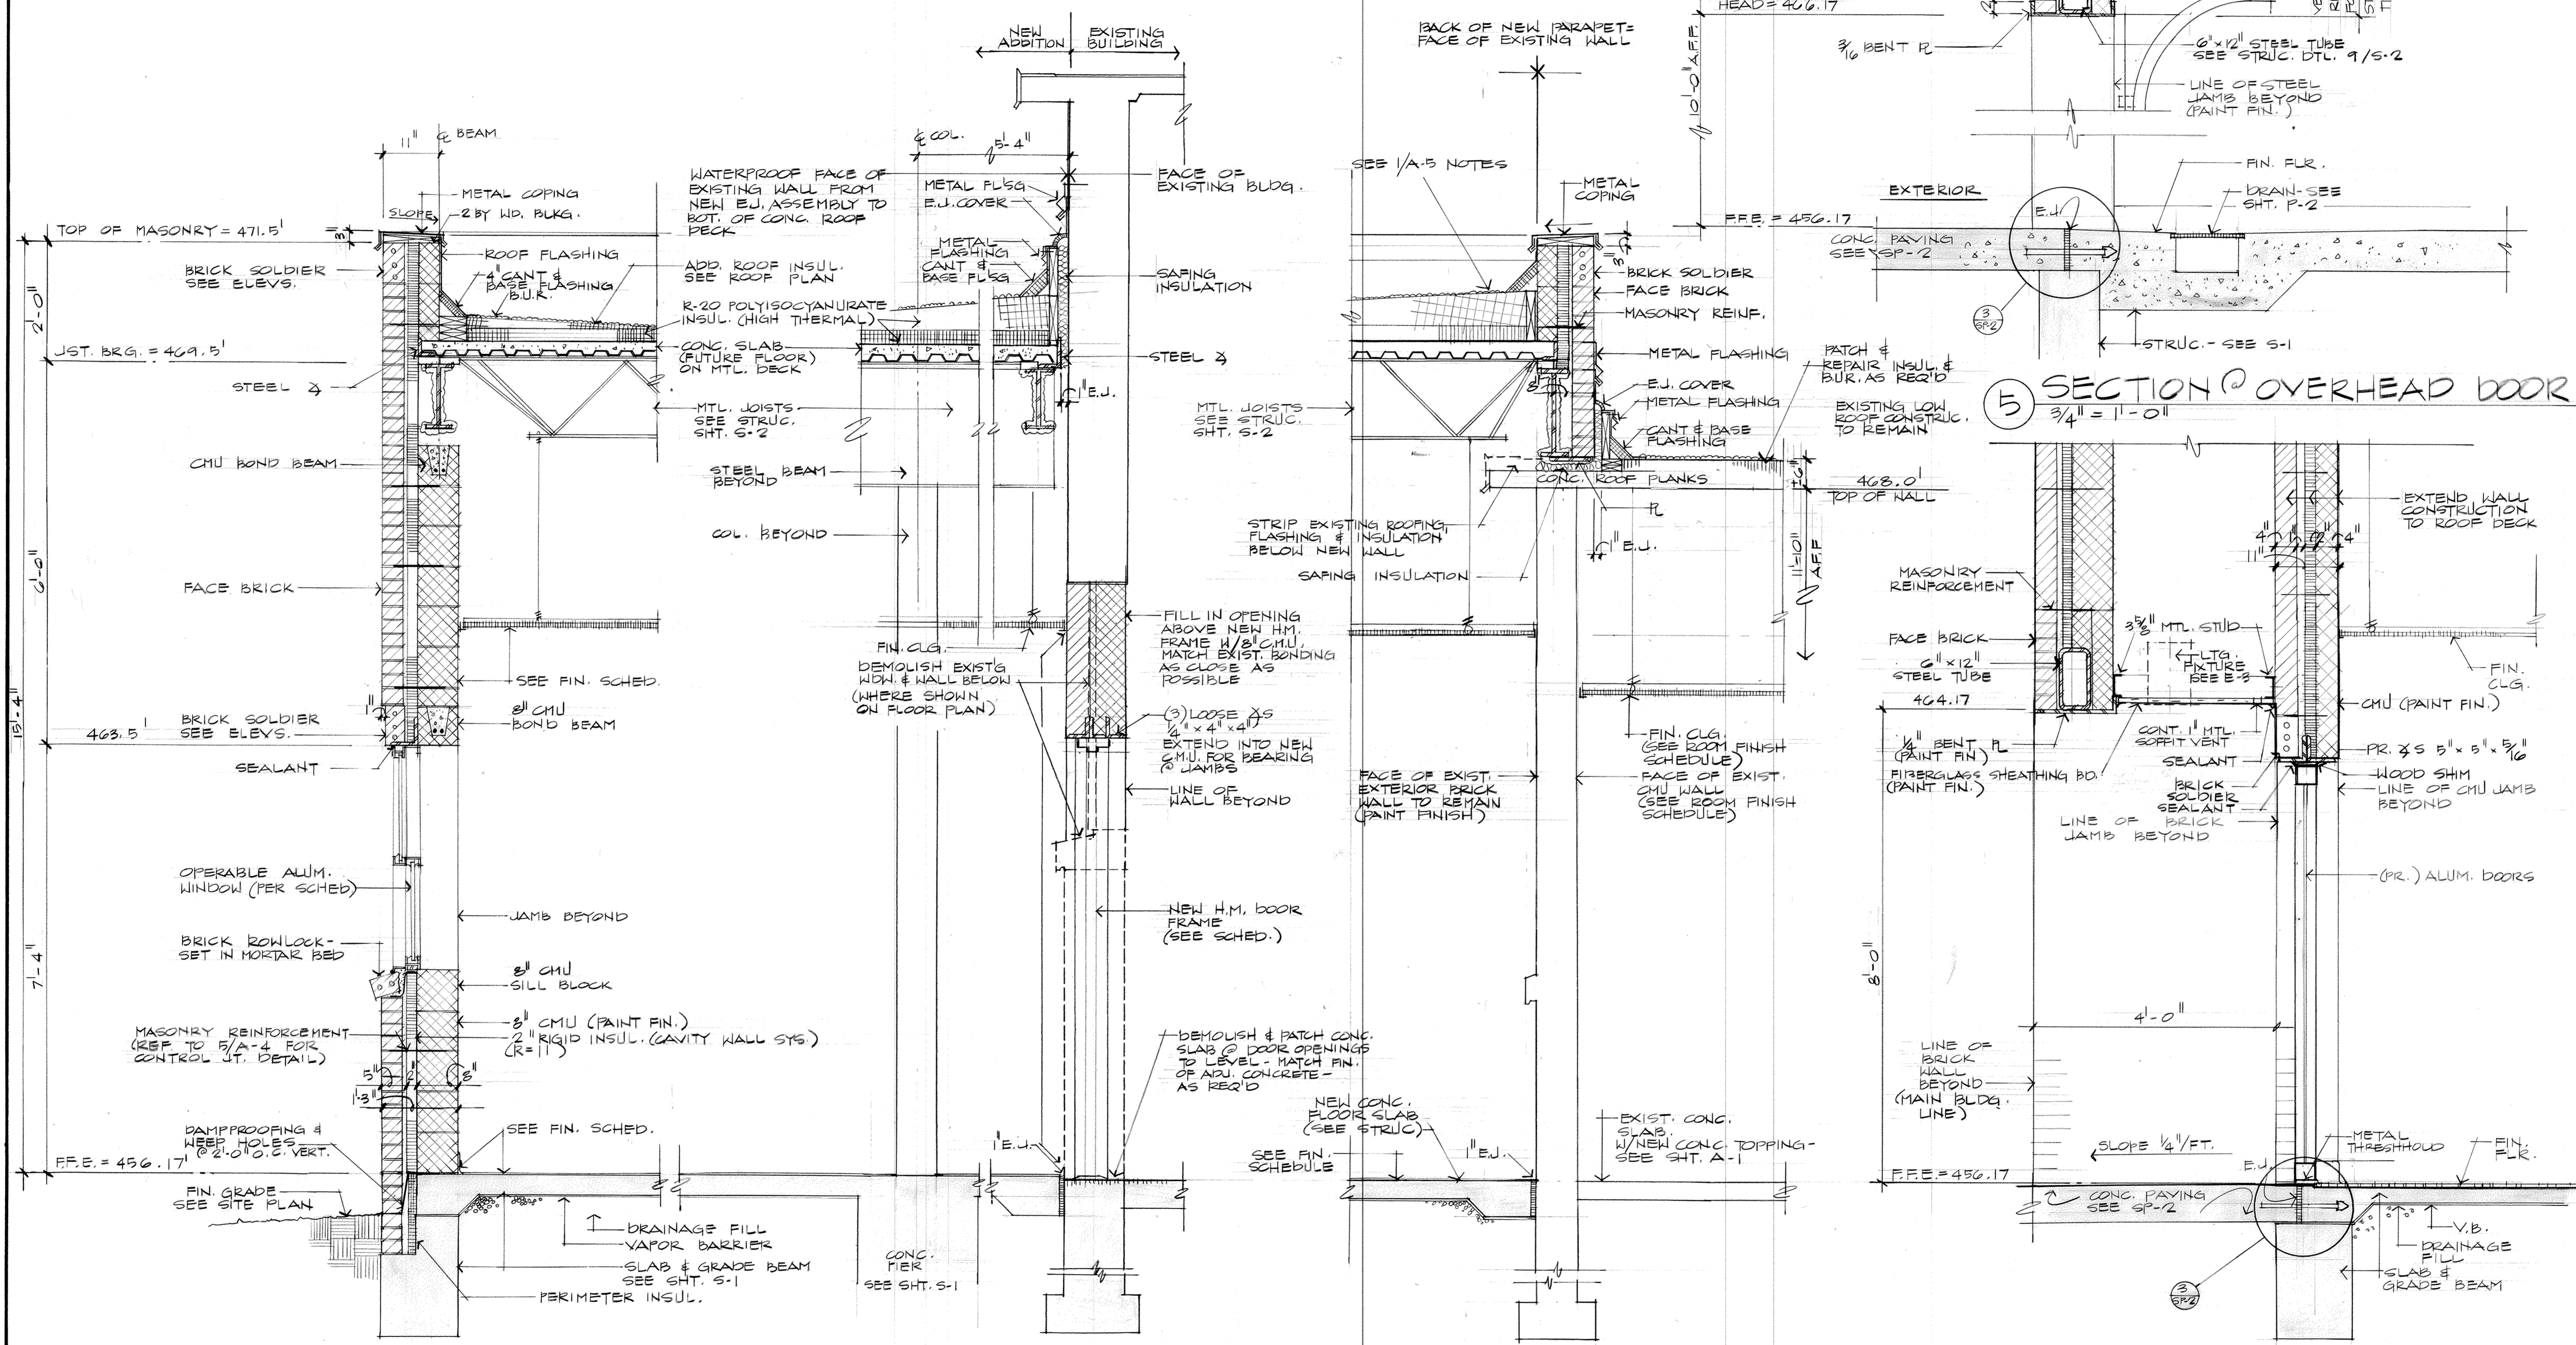

1 WALL SECTION (TYP.)
 3/4" = 1'-0"

2 SECTION @ HIGH ROOF
 3/4" = 1'-0"

3 SECTION @ LOW ROOF
 3/4" = 1'-0"

4 SECTION @ ENTRY
 3/4" = 1'-0"

NOTES: 1. REFER TO SHT. A-4 FOR LINTEL SCHEDULE.

at architecture plus
 120 North 9th Street • Fort Smith, Arkansas • 501/783-8395

REVISIONS:
 NO CHANGES FOR
 AS-BUILTS

PROJECT: 88-18

DATE: 7-24-89

SHT. A-5 OF 7

