



ELEVATION - C
SCALE 1/8"=1'-0"

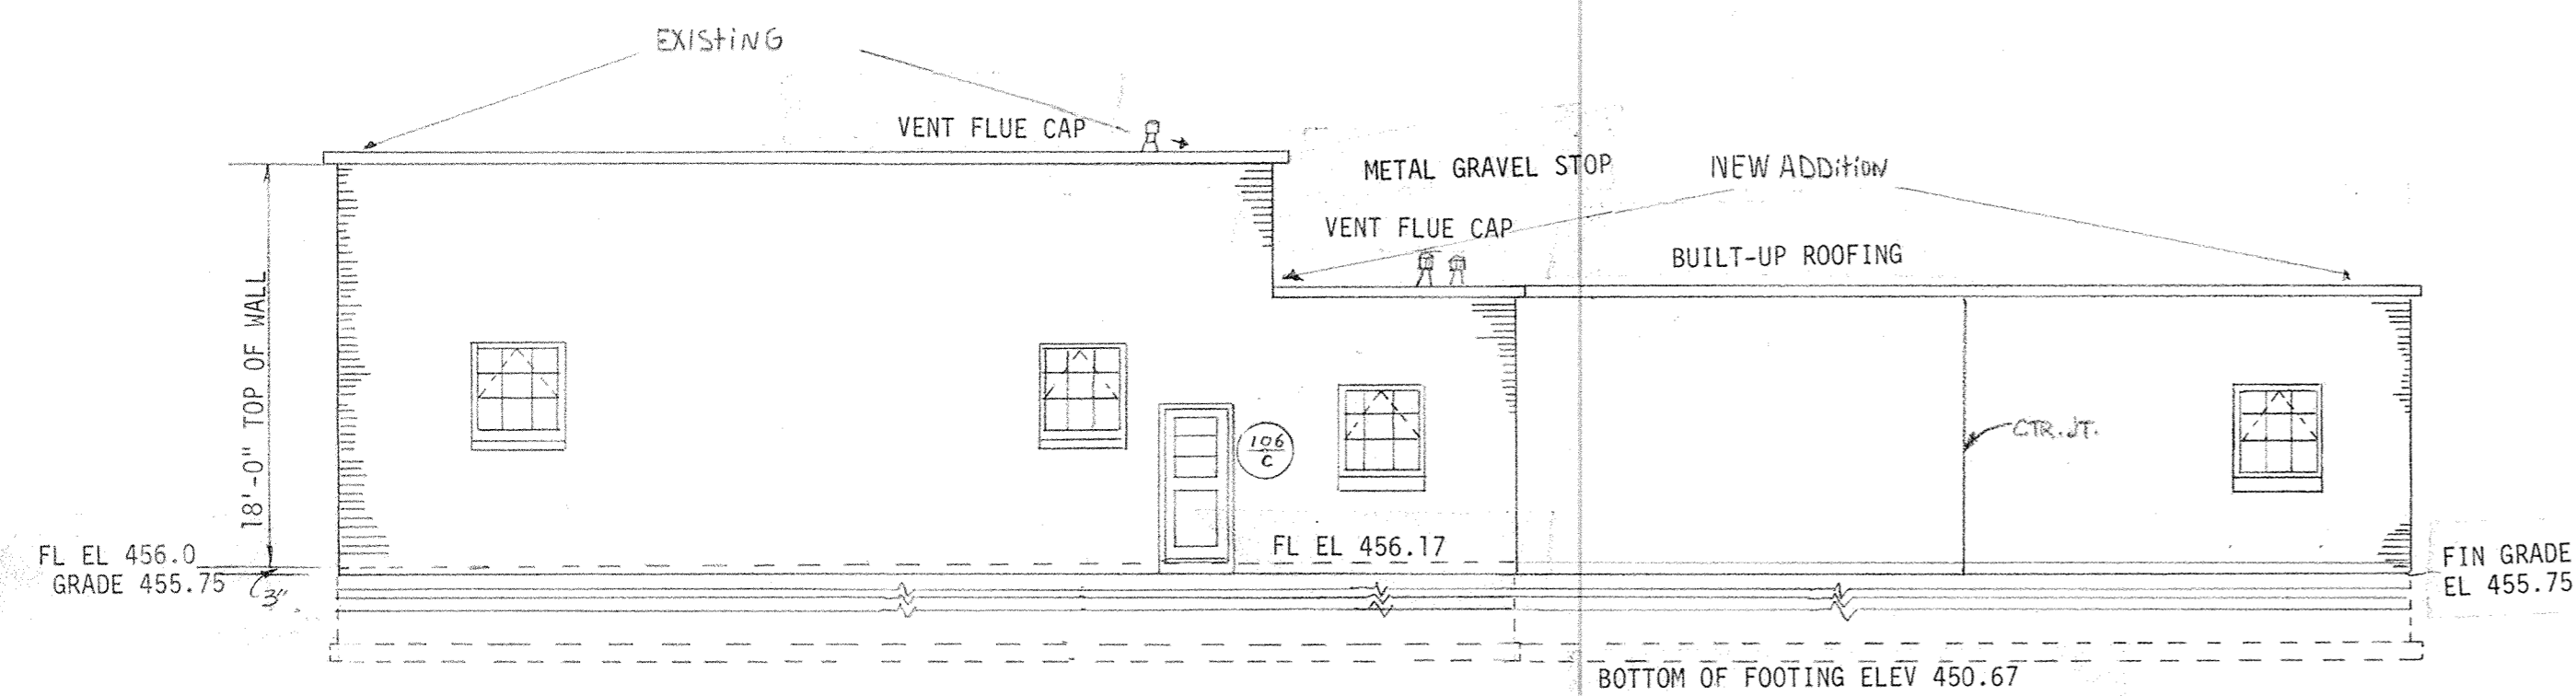

ELEVATION - B
SCALE 1/8"=1'-0"

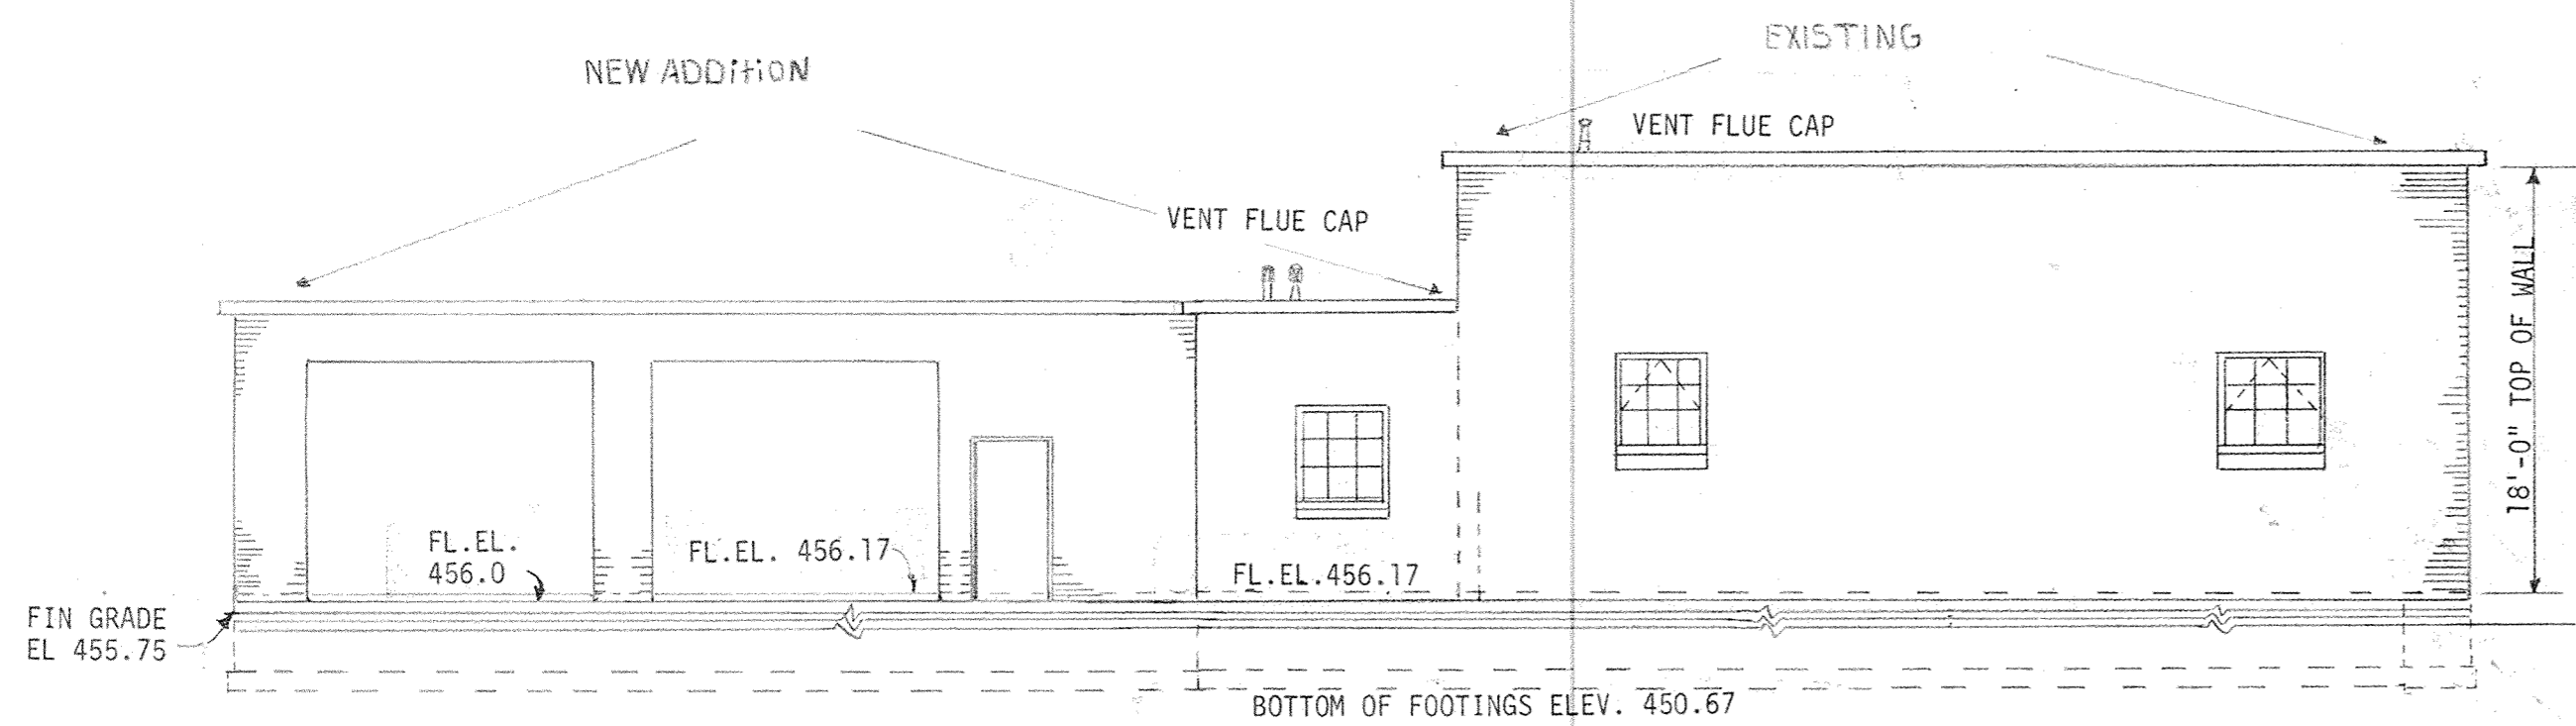

ELEVATION - D
SCALE 1/8"=1'-0"

ROOM FINISH SCHEDULE							
ROOM NO.	ROOM NAME	FLOOR	WALLS		CEILING		REMARKS
			Materials	Finish	Materials	Finish	
1	Apparatus Room	*Conc	LWC BLK/GYP BD	PAINT B&D	NONE	PAINT	NONE
2	Training Office	V.A.T.	" " " "	" " " "	AC TILE	"	VINYL (1) & (2)
3	Chief Office	V.A.T.	" " " "	" " " "	AC TILE	"	"
4	Training Room	V.A.T.	" " " "	" " " "	AC TILE	"	"
5	Men Latrine	V.A.T.	BLK/CER. TILE	" " " "	AC TILE	"	Cer Tile to 4'-0" AFF
6	Alarm Room	V.A.T.	BLK/GYP BD	" " " "	AC TILE	"	"
7	Ladies Latrine	V.A.T.	BLK/CER. TILE	" " " "	AC TILE	"	Cer Tile to 4'-0" AFF
8	Work Room	*Conc	BLK	NONE	AC TILE	"	NONE
9	Storage Room	*Conc	BLK/GYP BD	NONE	NONE	PAINT	NONE (1)
10	Mech. Room	*Conc	" " " "	NONE	NONE	PAINT	NONE (1)
	Hallway	*Conc	GYP BD	PAINT D	NONE	PAINT	VINYL (1)

*NOTE All exposed conc floor slabs to have hardner coat.
 (1) Paint all exposed interior structural steel and misc. metal items with paint "C".
 (2) Paint floor trench grating and frame black enamel.

DOOR SCHEDULE								
ROOM NO.	ROOM NAME	DOOR NO.	HDWR SET	DOOR OPNG.		TYPE	PAINT	
				WIDTH	HIGHT		EXT.*	INT.**
1	APPARATUS ROOM	101		12'	10'	OVERHEAD ELEC. OPR., WEATHERPROOF	*	**
1	"	102		12'	10'	" " " "	*	**
1	"	103	1	3'-0"	6'-8"	1 3/4" METAL HALF GLASS WIRE	*	**
1	"	104	1	"	"	RENIF	*	**
2	TRAINING OFFICE	201	2	"	"	1 3/4" FLUSH METAL WITH 10"x10" VISION LINE		C
2	"	202	2	"	"	" " " "		"
3	CHIEFS OFFICE	301	3	"	"	" " " "		"
4	TRAINING ROOM	401	3	"	"	" " " "		"
4	"	402	3	"	"	" " " "		"
5	MENS LATRINE	501	4	"	"	1 3/4" FLUSH METAL		"
6	ALARM ROOM	601	2	"	"	" " " " HALF GLASS		"
7	LADIES LATRINE	701	5	"	"	1 3/4" FLUSH METAL		"
8	WORK ROOM	801	6	"	"	" " " "		"
9	STORAGE ROOM	901	6	"	"	" " " "		"
10	MECH. ROOM	1001	6	"	"	LOUVERED METAL		"

NOTES; * EXTERIOR ENAMEL PAINT
 ** PAINT C

QTY REQD	SYM	NOMENCLATURE	CODE IDENT	IDENTIFYING NO.	SPECIFICATION	MATERIAL	UNIT WT.	ZONE	FIND NO.
LIST OF MATERIALS									
UNLESS OTHERWISE SPECIFIED DIMENSIONS ARE IN INCHES				DRAFTSMAN		DATE			
TOLERANCES ON DECIMALS				CHECKER		U.S. AIR FORCE			
FRACTIONS .XX ±				ENGINEER		TITLE P341 PROJECT 78-1 ADD TWO BAYS AND TRAINING SPACE TO FIRE STATION ELEVATIONS ROOM FINISH AND DOOR SCHEDULE AIR NATIONAL GUARD TNG FACILITY 188 th CEF MUNICIPAL AIRPORT FORT SMITH, AR 72406			
ANGLES ±				A.F. PROJ. ENGR.					
MATERIAL				CONTRACT NUMBER					
NEXT ASSY				A.F. DESIGN ACTIVITY AUTHENTICATION					
APPLICATION		QTY. REQD		SIZE		A.F. CODE IDENT NO.		DRAWING NUMBER	
				E				SHEET 6	