


A MECHANICAL DEMOLITION PLAN **B**

SCALE: 1/8" = 1'-0"

NORTH

MECHANICAL DEMOLITION NOTES

- EXIST'G ITEMS OF VALUE TO BE REMOVED AND NOT RELOCATED ARE TO BE DELIVERED TO THE BASE CIVIL ENGR FOR DISPOSAL. THOSE OF NO VALUE TO BE DISPOSED OF BY CONTRACTOR. DISPOSAL OF ANY ITEMS IN QUESTION TO BE DETERMINED BY BASE CIVIL ENGR.

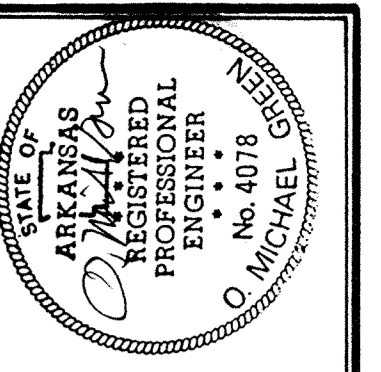

ADDITION / ALTERATION OF
FIRE STATION
 ARKANSAS AIR NATIONAL GUARD
 FORT SMITH, ARKANSAS

a+ architecture plus
 120 North 9th Street • Fort Smith, Arkansas • 501.783-8395

OMG O. MICHAEL GREEN ENGINEERING INC.
 SUITE 610 FIRST PLAZA • FAYETTEVILLE ARKANSAS • (501) 442-4682

MECHANICAL DEMOLITION PLAN

REVISIONS:

PROJECT: **88-18**

DATE: **7-24-89**

SHT. **M-1** of **3**

