
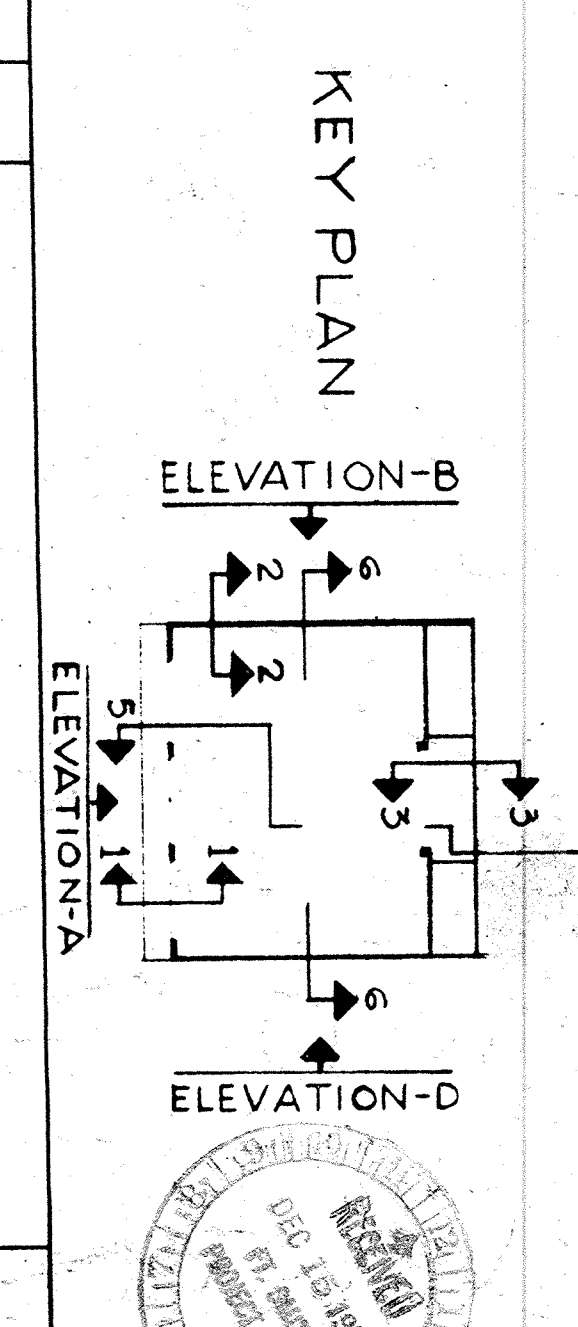
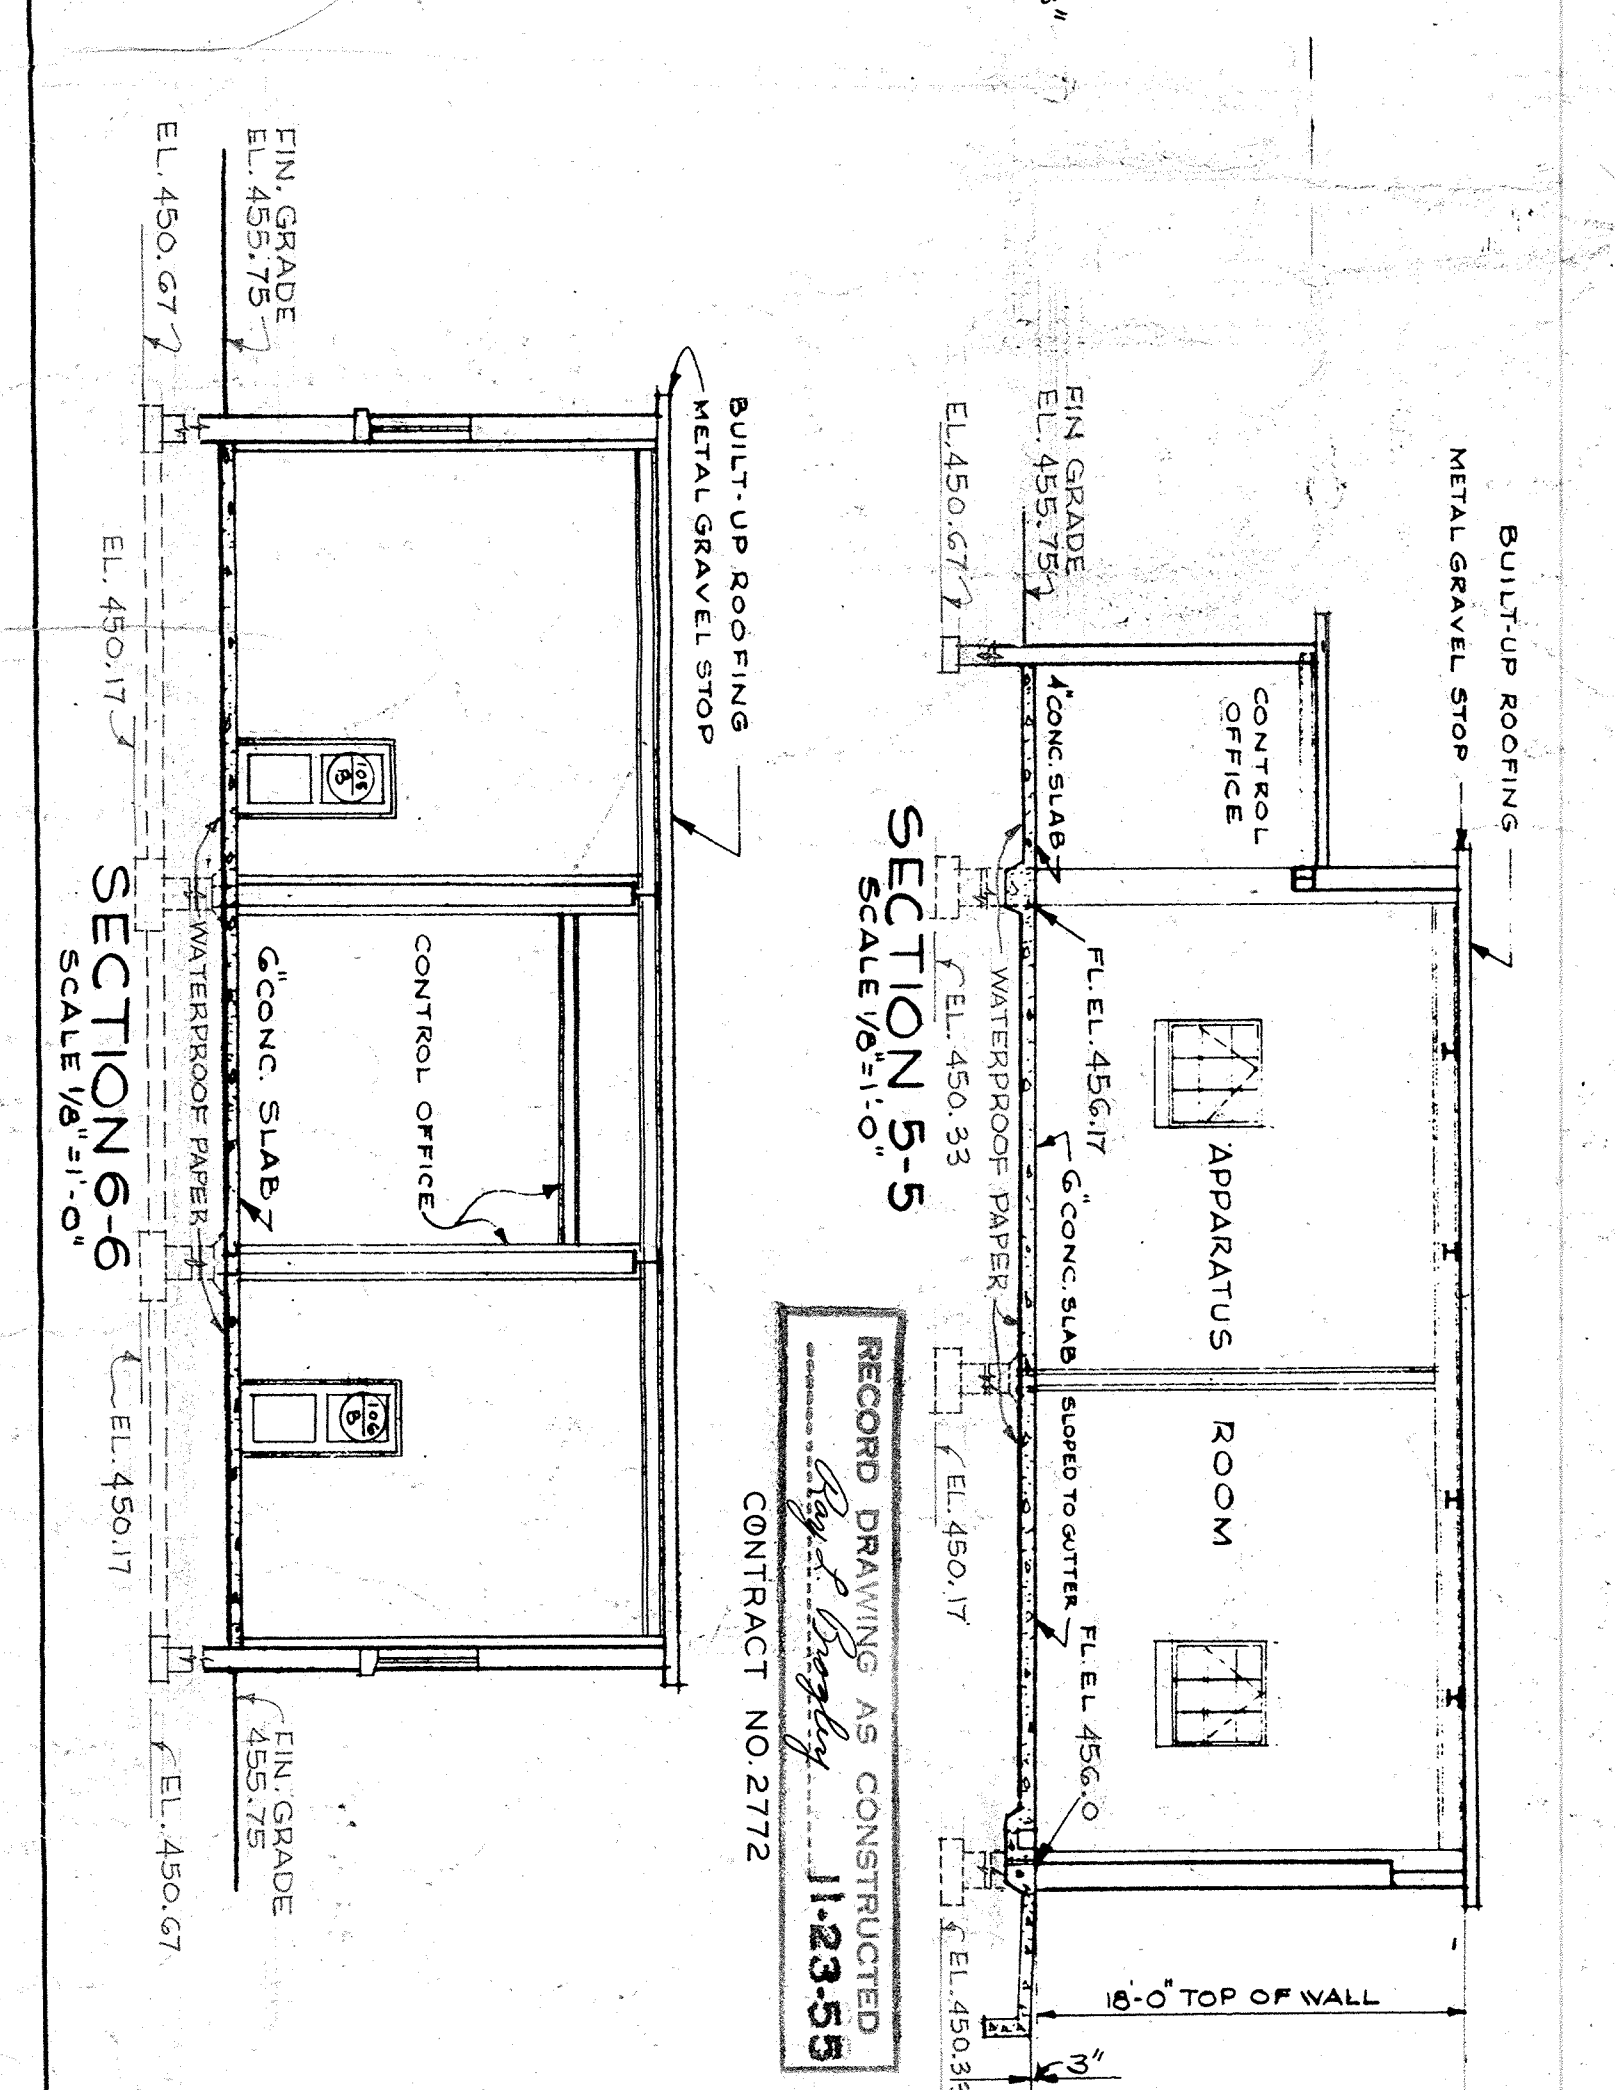
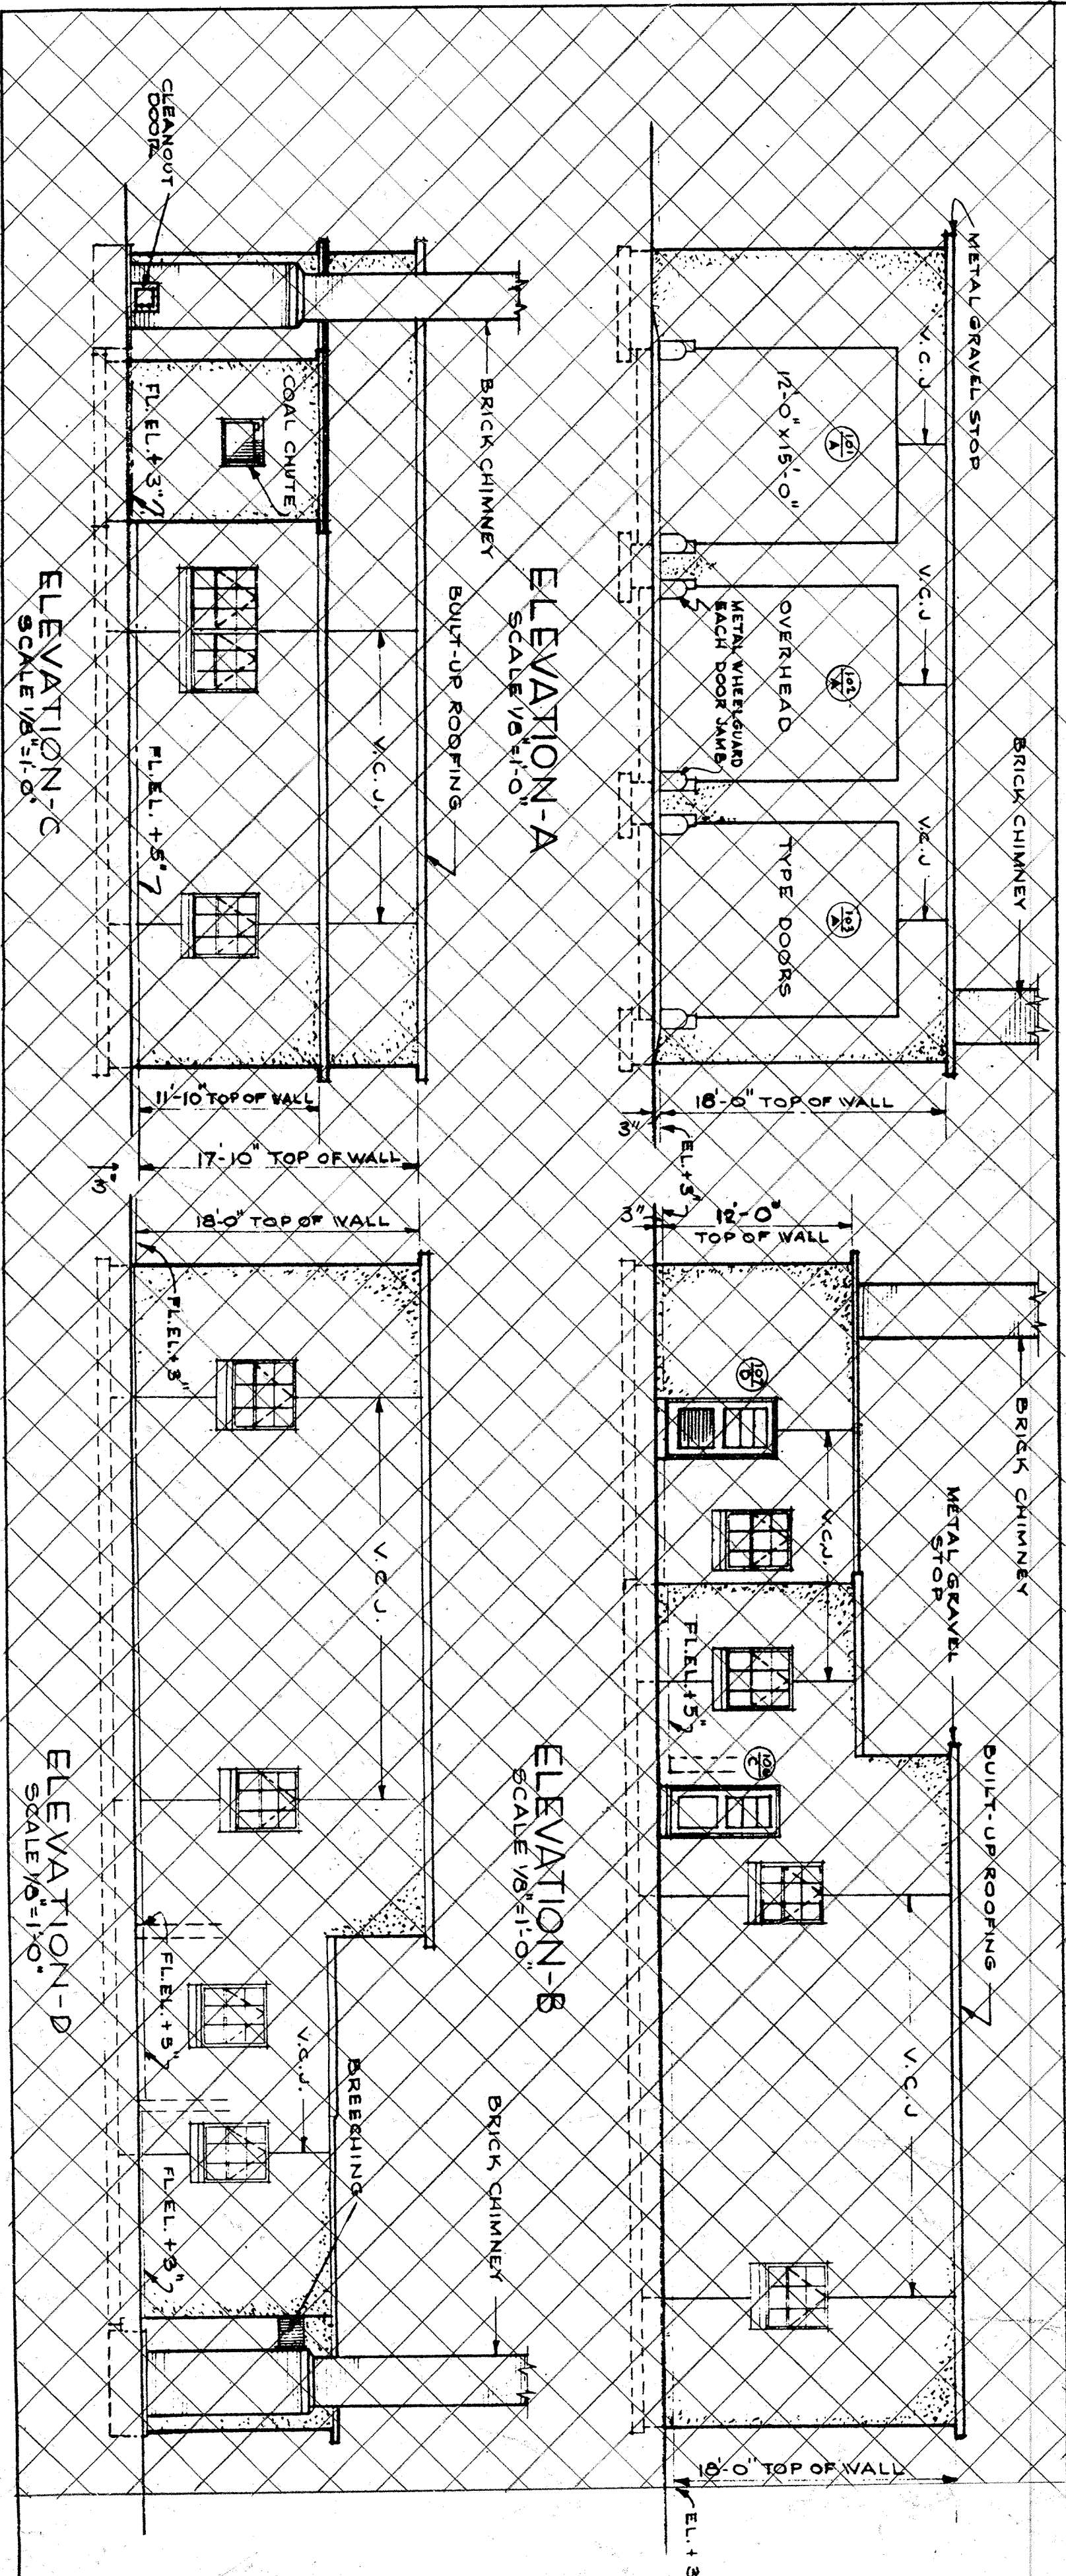


CONSTRUCT THIS BUILDING  
OPPOSITE HAND

ISSUED FOR USE AT  
FORT SMITH MUNICIPAL AIRPORT  
AUTHORIZED BY  
JOB NO. LITTLE ROCK DIST. 54-98AF-AREC

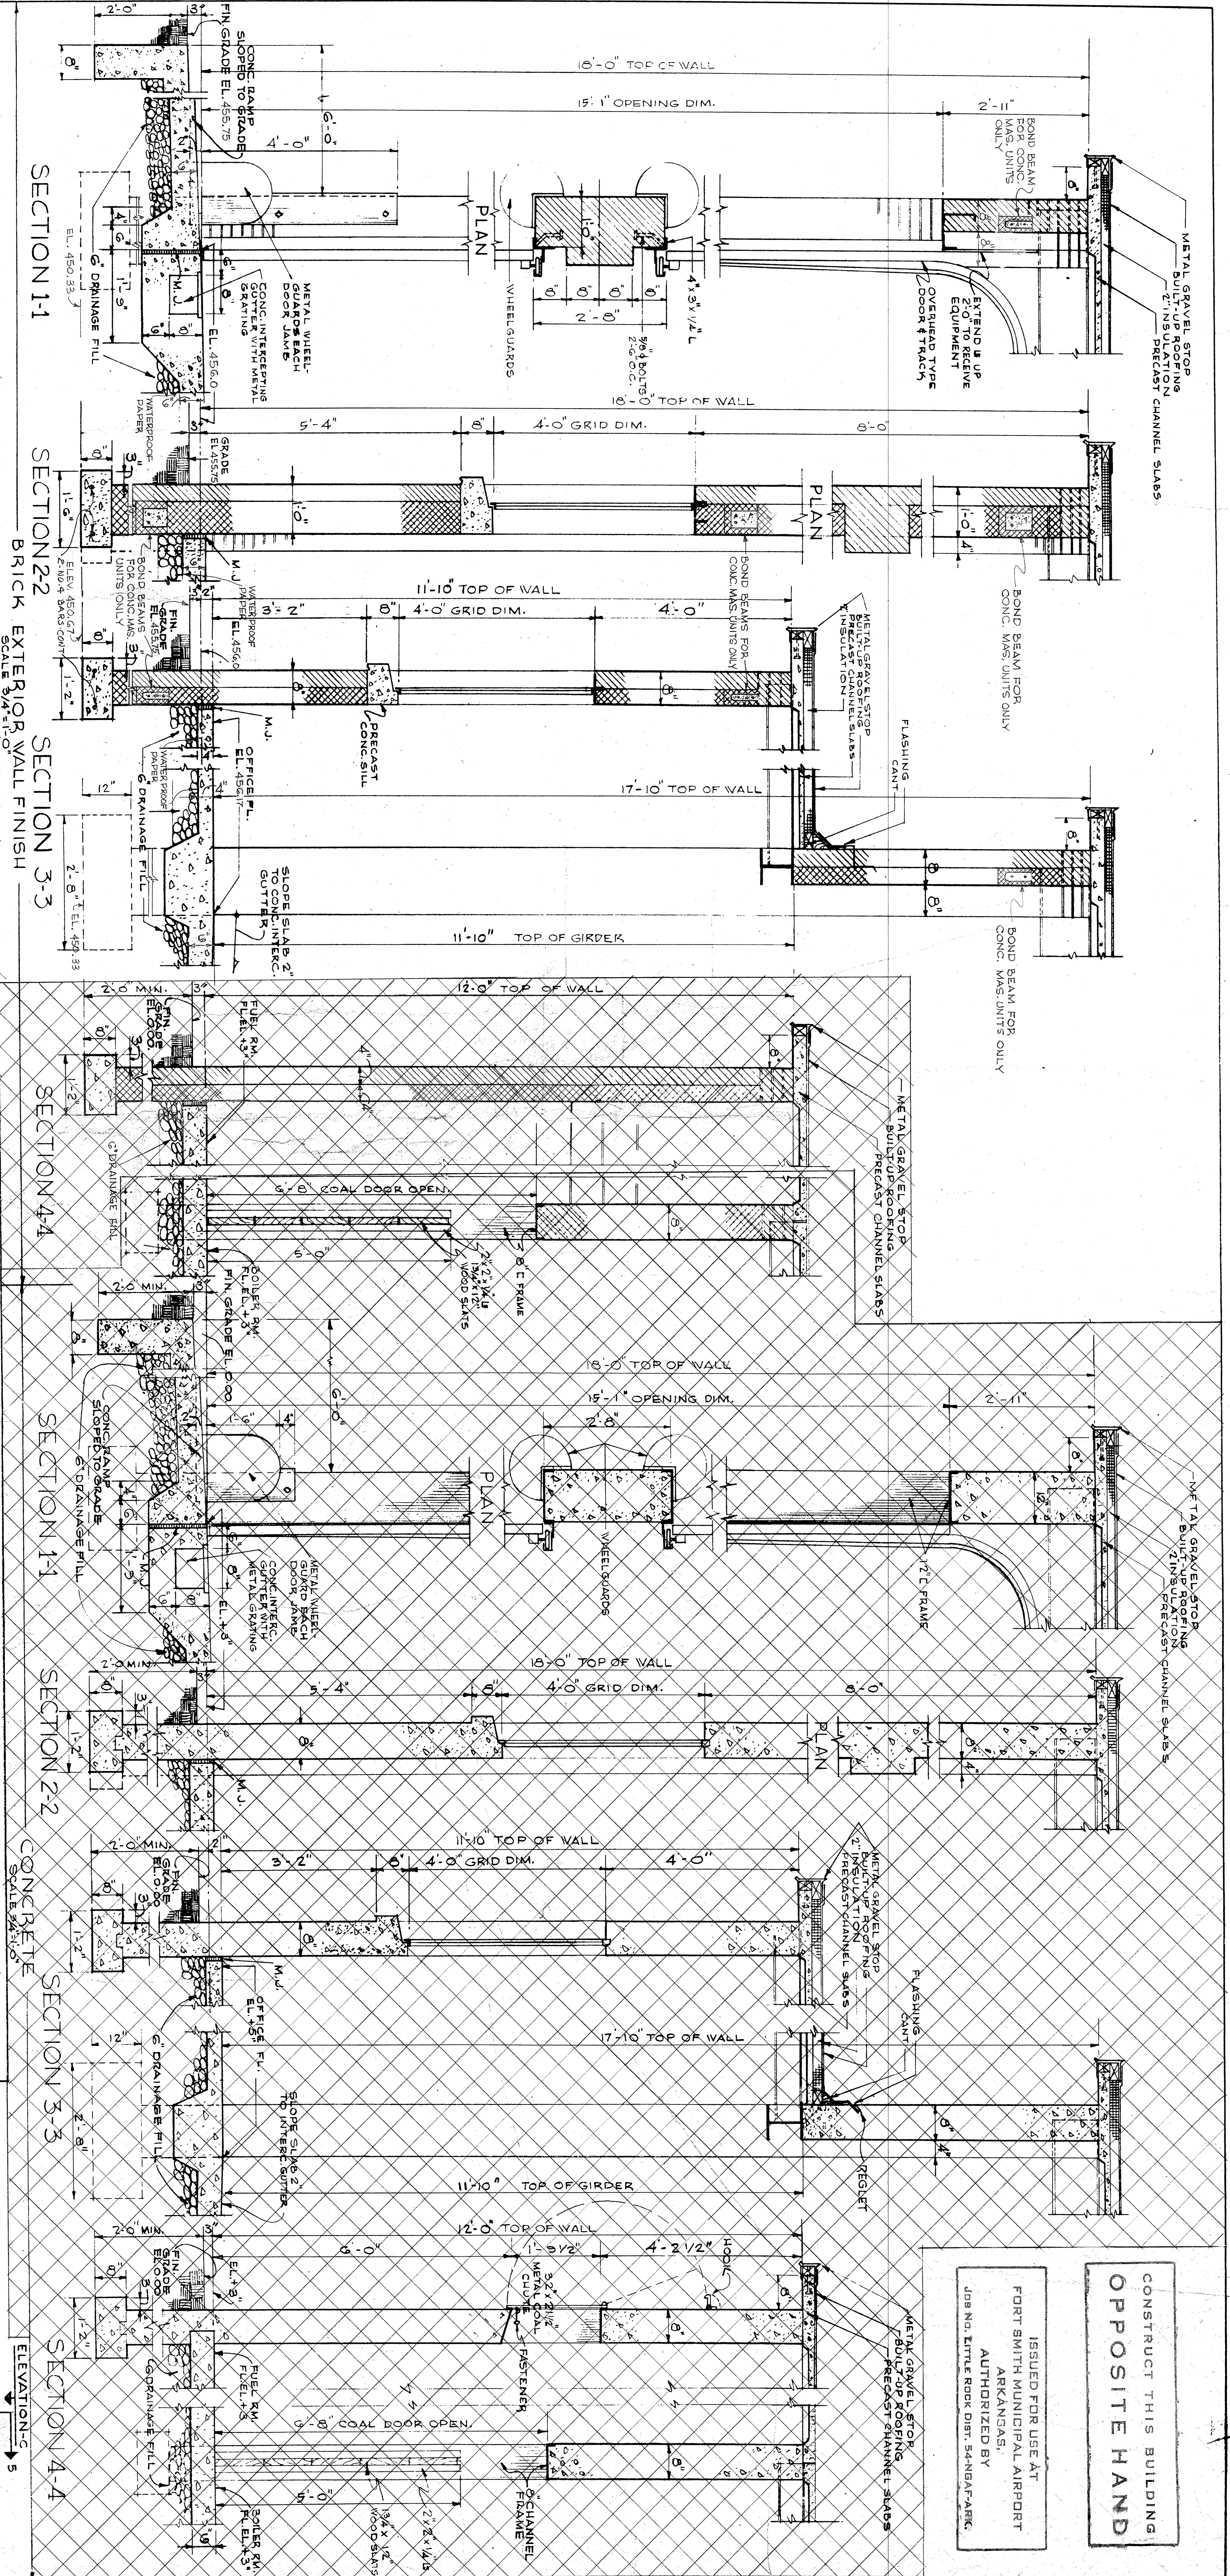

**REVISION**

NO.	DATE	DESCRIPTION
1		AS NOTED

DEPARTMENT OF THE ARMY AND THE AIR FORCE  
NATIONAL AERONAUTICS AND SPACE ADMINISTRATION  
WASHINGTON, D. C. AIR FORCE DIVISION, NATIONAL GUARD BUREAU  
PREPARED UNDER DIRECTION  
OF THE NATIONAL GUARD BUREAU

**CRASH TRUCK STATION  
WALL SECTIONS**

DESIGNED BY: R.L.G.  
CHECKED BY: R.L.G.  
DRAWN BY: D.W.V.

DATE: 9 OCT 1951  
SCALE: AS NOTED  
SHEET 2 OF 5  
DRAWING NO. AFD-51-501  
FS-6724M-302/143