


**SYMBOLS LEGEND**

	REINFORCED CONCRETE PIPE (UNDERGROUND) OR CORRUGATED PLASTIC PIPE (UNDERGROUND)
	WATER (UNDERGROUND SERVICE)
	SANITARY SEWER (UNDERGROUND SERVICE)
	GAS (UNDERGROUND SERVICE)
	TELEPHONE (U.G. INDICATES UNDERGROUND SERVICE)
	POWER POLE
	ELECTRIC & TELEPHONE (OVERHEAD SERVICE)
	SPOT ELEVATION (RELATIVE TO FINISH FLOOR ELEVATION)
	FIRE HYDRANT
	VALVE
	STRAIGHT "T" FITTING
	CLEAN OUT
	AREA INLET
	INLET BOX
	MAN HOLE
	EXISTING TREE
	ASPHALT PAVING
	CONCRETE PAVING
	GRAVEL PAVING
	LAWN (GRASS)
	BUILDING LINE

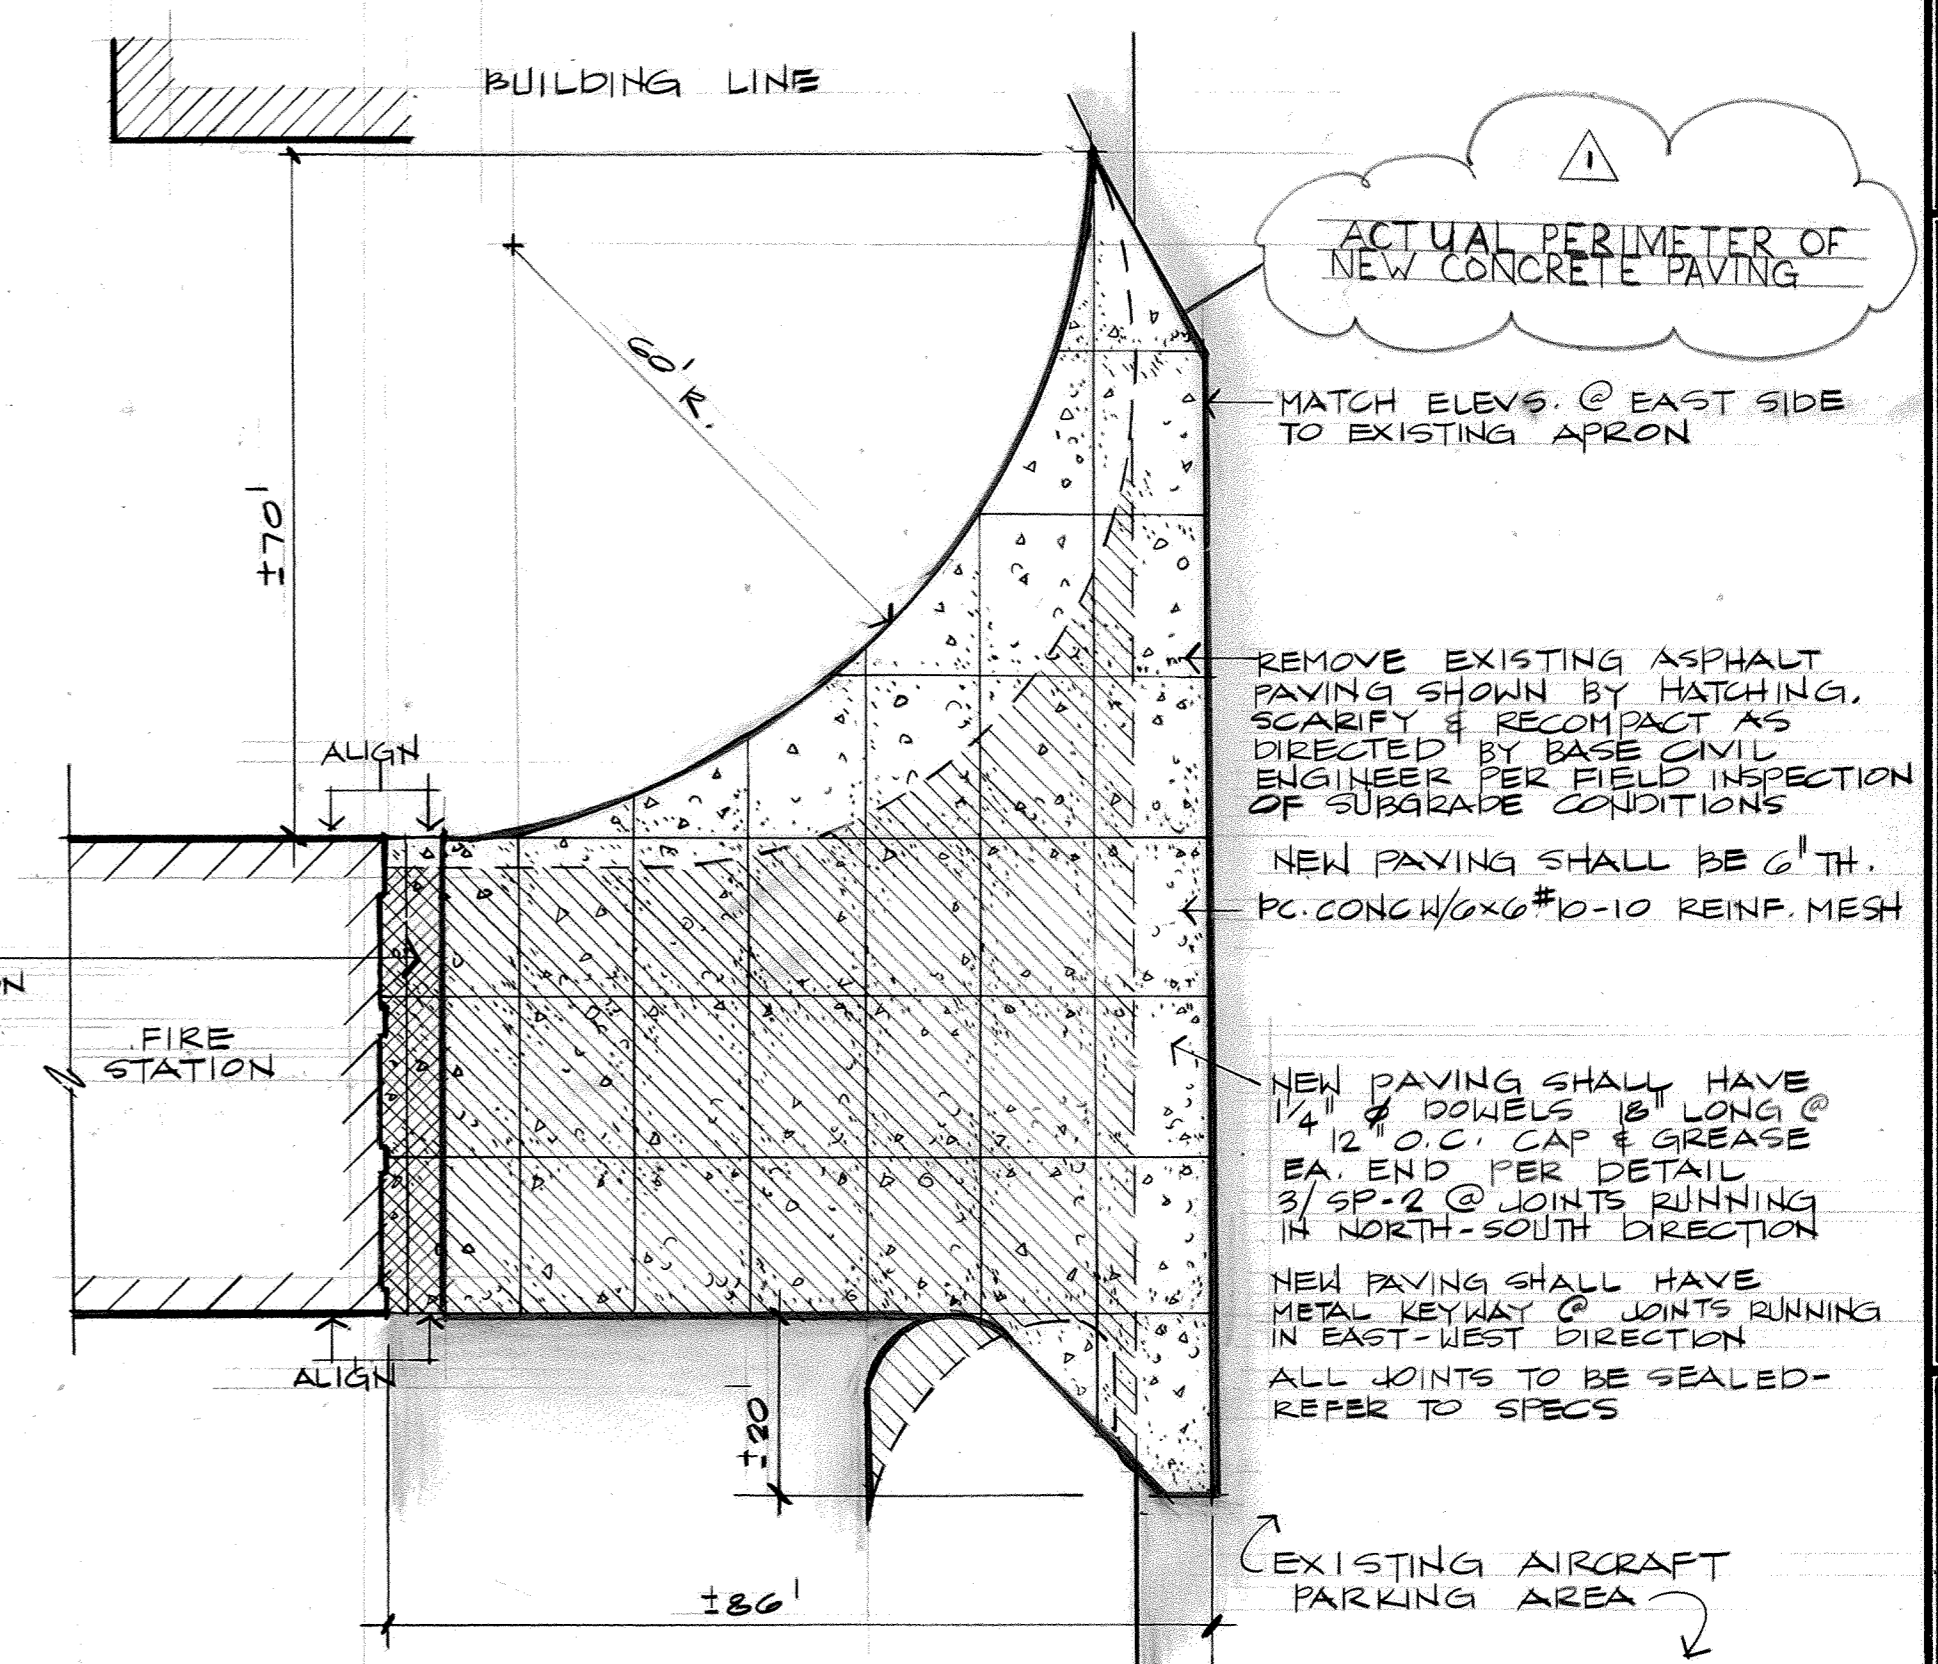


**① CONCRETE APPROACH APRON**  
1" = 20'

NOTE: EXACT LOCATIONS OF THE INTERFACE OF NEW CONCRETE PAVING & EXISTING PAVED AREAS TO BE DETERMINED IN FIELD BY BASE CIVIL ENGINEER.

**TOPOGRAPHIC SURVEY**  
1" = 20'

ADDITION / ALTERATION OF  
**FIRE STATION**  
ARKANSAS AIR NATIONAL GUARD  
FORT SMITH, ARKANSAS

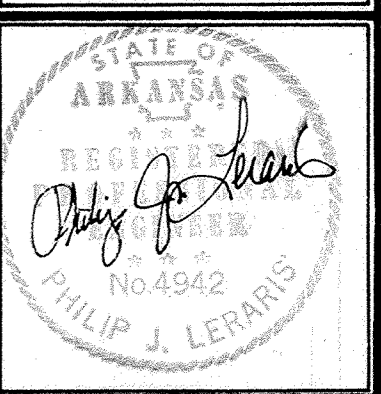

**a+** architecture plus  
120 North 9th Street • Fort Smith, Arkansas • 501/783-8395  
TOPOGRAPHIC SURVEY

REVISIONS:  
ASBUILT

PROJECT: 88-18

DATE: 7-24-89

SHT. NO. SP-1 OF 2

