




Ö

1/2

2 SCALE:

°ọ

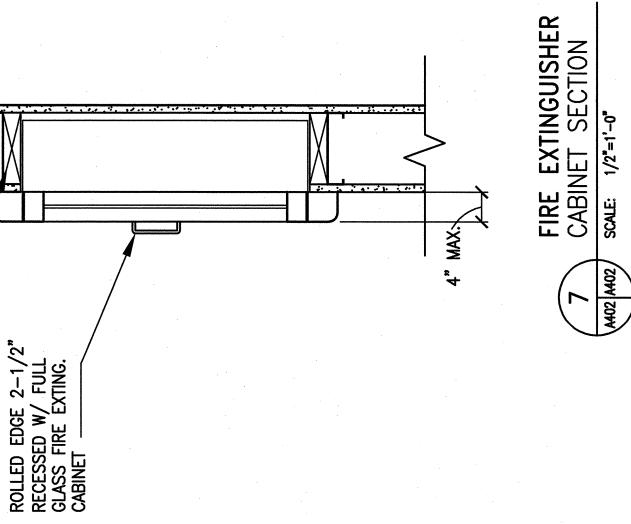

5/8" GYPSUM BD. METAL STUD ------

2X FRTW BLOCKING

THICK TOP

PAN

Н Н Н


NKS

ELEVATION

**ASE** 

BINS

RECYCLING

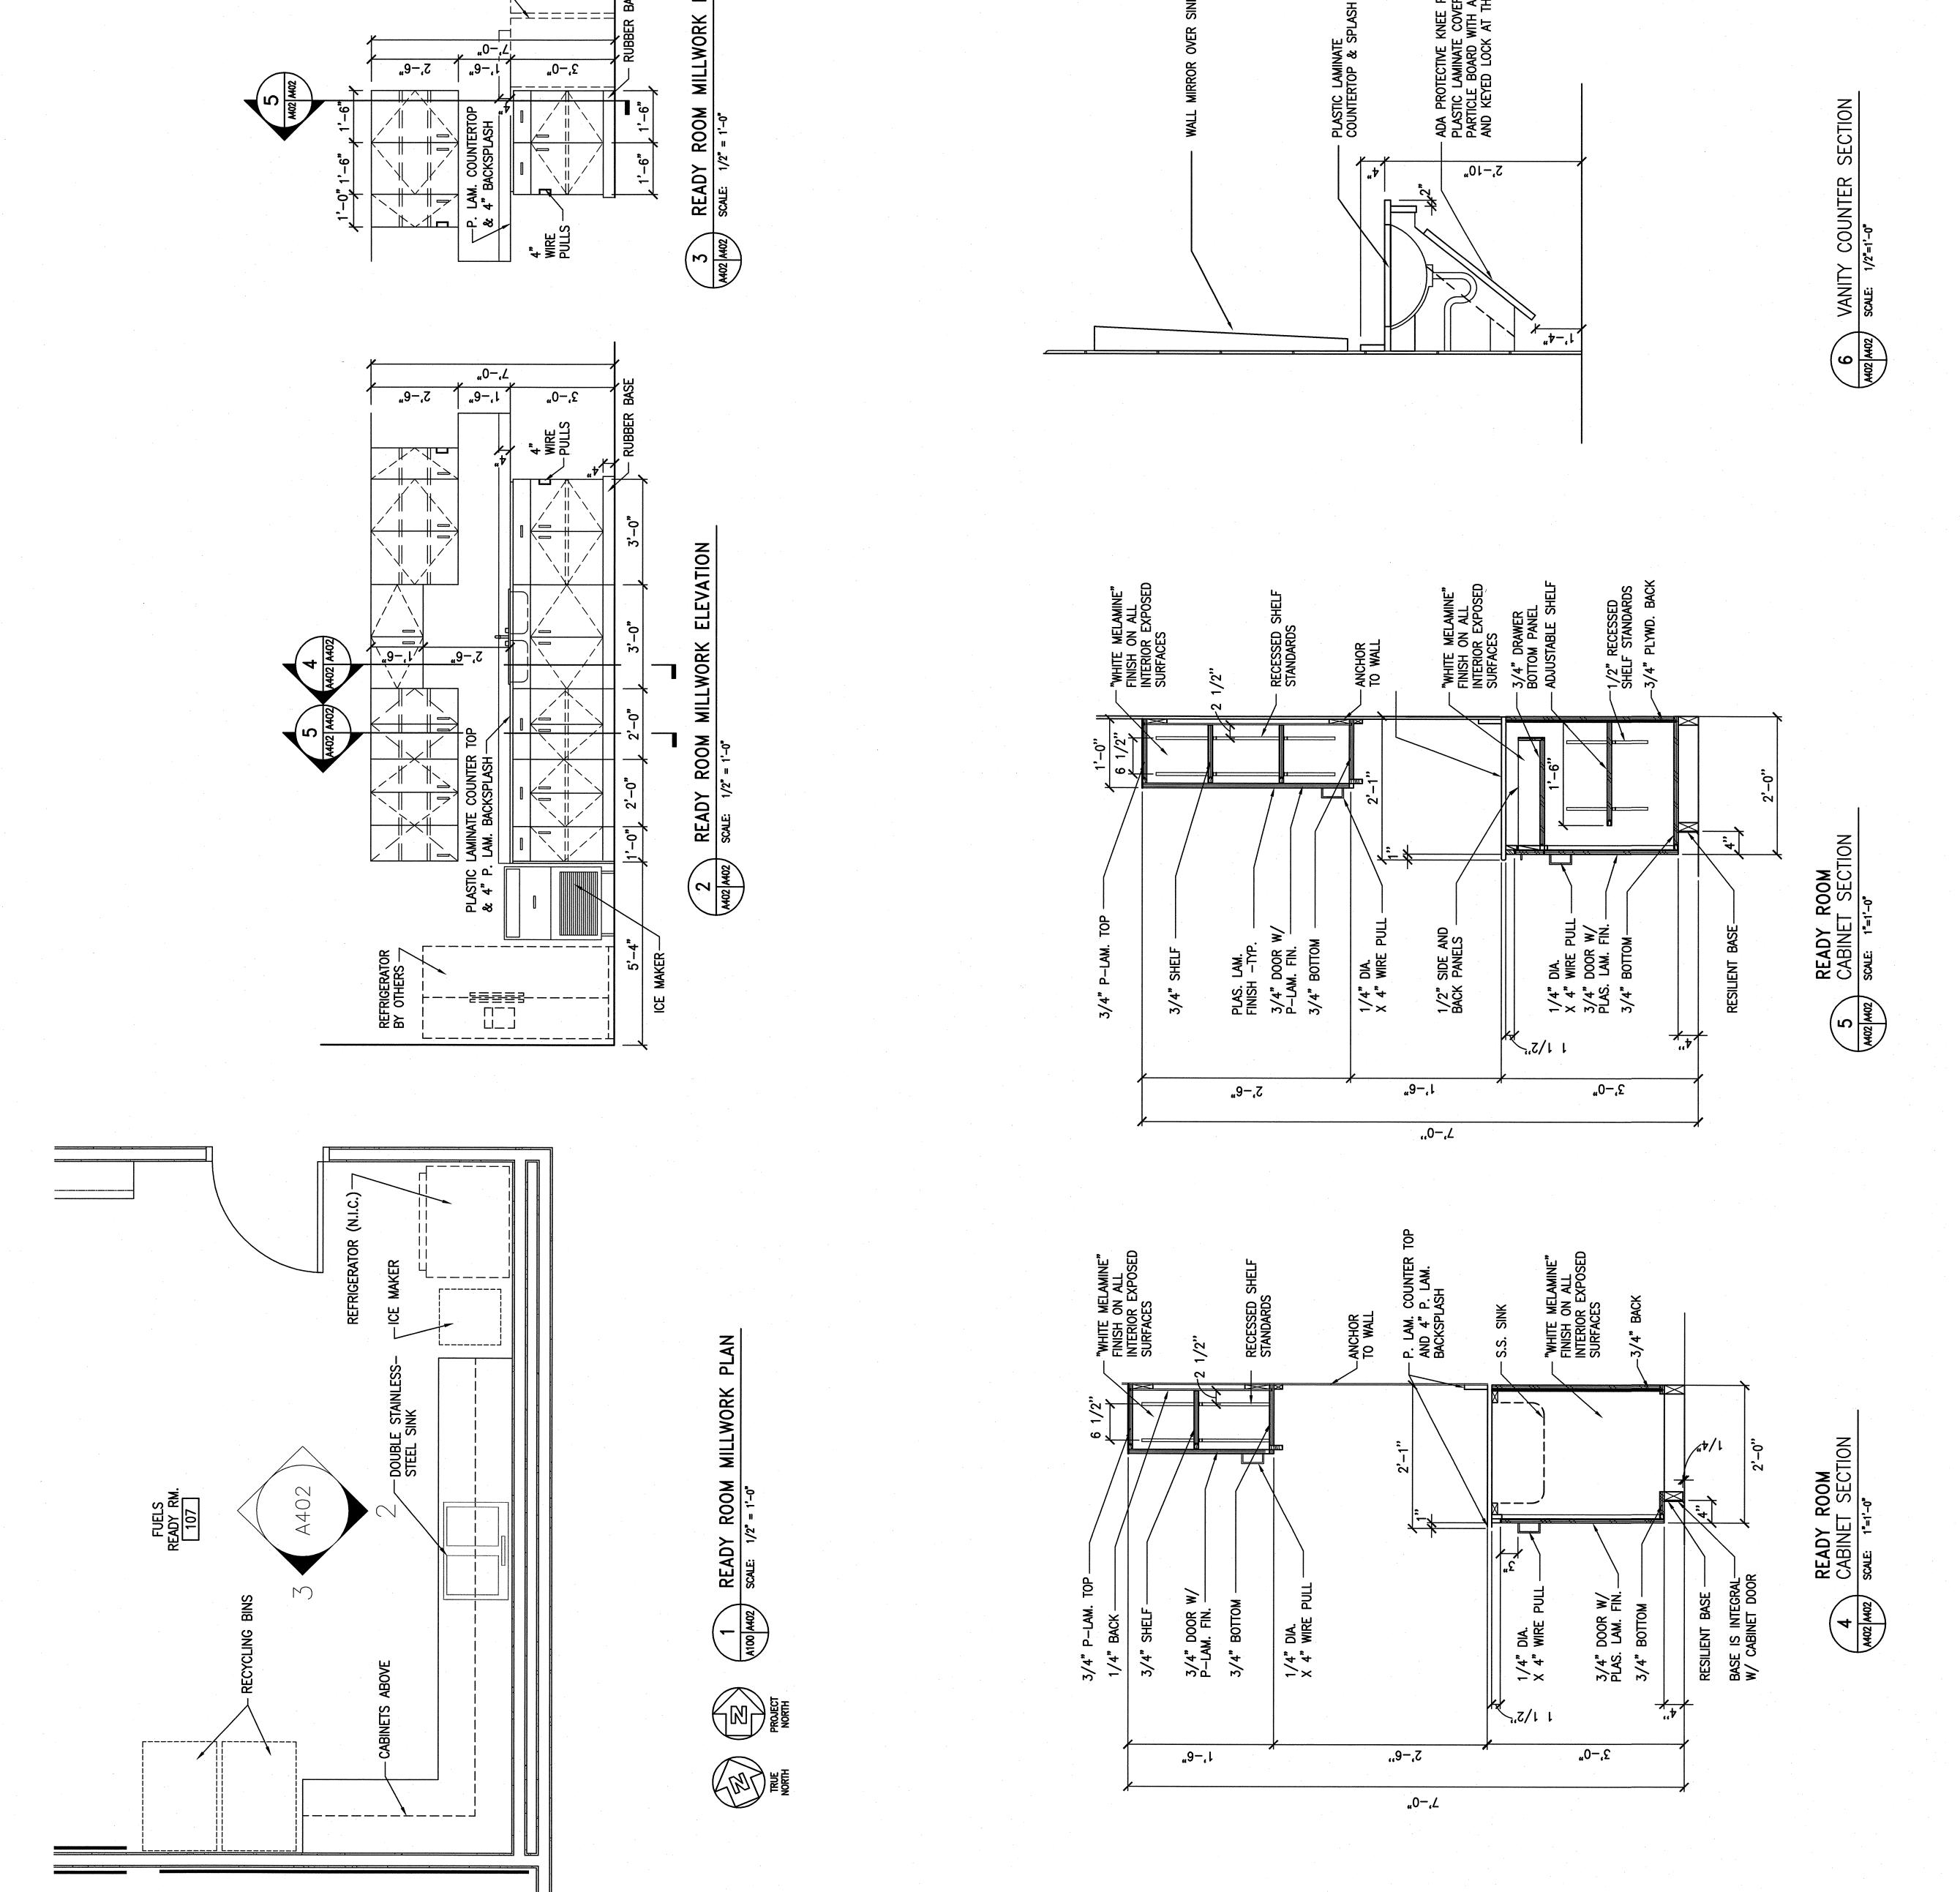

M:\SSI

- 3:06

04/10/08

bakerm

-A10\_Aircraft Maint\_Hanger\A402.dwg