603 MATERIA ARKANSAS AIR NATIONAL GUARD COMPOSITE A-10 AIRCRAFT MAINTENANCE FACILITY | Des

·	
80-11-4	
ate:	Кеv.
KEZ ceniewed ph:	
MLB SH	5
wu ph: CKG	pλ:
Sezigned by:	. 5


Mai	_	80-11-
	Rev.	:6
		:C iewed py:
	SHR	8
	CKq ph:	ph:
	SRG	igned by:

ISSUED FOR CONSTRUCTION

	·_	80)-11-
	Rev.		ıfe:
		pλ:	(E2
	2H<i>K</i> (q p)):		NTB Nu ph:
-	SRG	pλ:	pəubise

S	80-11-4	
"5	Dafe:	Rev.
	KEZ Keviewed p	:/
	MFB Dwu pk:	CHK CKQ PX:
,		SRG

-11-+	COPOR SELECTIONS
Dafe:	IALS, DESCRIPTIONS,
KEZ Kenjewed	NIZH ZCHEDNFE'
WFB Dwu pk:	FT. SMITH, ARKANSAS

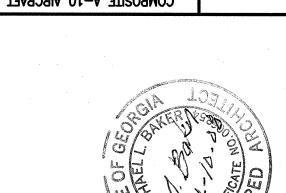

NOTE 1: CERAMIC TILE FLOOR PATERN TO BE STANDARD AMERICAN OLEAN PATTERN #SP-8207, 2X2, OVERALL PATTERN- CT-1 TO BE 74%; CT-2 TO BE 13%; CT-3 TO BE 1 NOTE 2: WELDING RODS ARE TO BE USED AT JOINTS IN SHEET VINYL FLOORING TO MATCH SURROUNDING SHEET VINYL COVER.

NOTE 3: BETWEEN 18005 JUTE AND EITHER 19004 OR 19005 USE WELDING ROD 416148. BETWEEN 19004 MARINA PEARL AND 19005 AMERICAN RED, USE WELDING ROD 415148.

BETWEEN JUTE AND JUTE USE WELDING ROD 415148.

I Construction\08004.001-A10_Aircraft Maint_Hanger\A603.dwg bakerm 04/10/08 - 3:36 P

ANGLED TEGULAR— WHITE USE PRELUDE CERAMIGUARD UNPERFORATED USE PRELUDE

2' SQ. DUNE 2' SQ. FINE FISSURED

ARMSTRONG
ARMSTRONG
CECO
FEDERAL STD. 595B

CEILING MATERIAL

ACT-1 ACOUSTICAL CEILING SYSTEM

ACT-2 ACOUSTICAL CLG. SYSTEM W/ CERAMIGUARD

EXP

EXP

MRGWB MOISTURE RESISTANT GYPSUM WALLBOARD

LIGHT BEIGE

20460

SATIN FINISH

FINISH		MANUFACTURER	PATTERN/ NAME/ NUMBER	COLOR/ NUMBER	REMARKS
MILLWORK	MATERIAL				
PL-1	- USE AWI PREMIUN	FORMICA	7814–58	CHALK SOLIDZ MATTE FINISH	EXPOSED TO VIEW
I	CABINETS, DRAWERS & SHELVES	CUSTOM	MELAMINE	WHITE	NOT EXPOSED TO VIEW
1	CABINET HARDWARE	•	CONCEALED HINGES	STAINLESS STEEL	
1	CABINET HARDWARE	1	DRAWER SLIDES	STAINLESS STEEL	
•	CABINET HARDWARE	1.	1/2" RECESSED STDS.	STAINLESS STEEL	
l	CABINET HARDWARE	1	CONCEALED HINGES	STAINLESS STEEL	•
1	CABINET HARDWARE	1	4" WIRE PULLS	STAINLESS STEEL	
PL-2	COUNTERS AND SPLASHES	CUSTOM	NEVAMAR	Textured Mr3005T	NAVY MATRIX
PL-2	TOILET PARTITIONS	ACCURATE	NEVAMAR	Textured Mr3005T	NAVY MATRIX- FLOOR MTD./ OVERHEAD BRACED
WINDOW	W TREATMENTS				
ı	HORIZONTAL BLINDS— INTERIOR	HUNTER-DOUGLAS	1" LIGHTLINES	820 UMBER	7/8" X 1 3/4"
INTERIOR	JR DOORS AND WINDOWS				
ı	CURTAINWAL	VISTAWALL	RELIANCE		1
	SOLID- CORE WOOD DOORS	MOHAWK	ROTARY CUT, 7- PLY	STAINED & CLEAR SEALED	MATCH
1	HOLLOW METAL DOORS AND FRAMES	STEELCRAFT	L-20 SERIES	FIELD PAINT	1
1	OVERHEAD COILING DOORS	NOSX000	TYPE FMWI	FIELD PAINT	MOTORIZED
1	UPWARD ACTING DOORS	MEGADOOR	1	# 5 7628	MOTORIZED
ı		ı	1	IKANSLUCENI WHIIE #5/62090	-
1	AINWALL GLAZIN	ЬРС	SOLARBAN 60	BRONZE & CLEAR	- PROOF GLAZING
	FIRE EXTINGUISHER CABINETS	LARSON'S	AMPRO	#2409-6R	FULL TEMPERED GLASS DOOR
D00R	HARDWARE:				
ı	SEE SHEET A-601	l	I		
PERMA	PERMANENT INTERIOR FURNISHINGS OR EQUIPMENT				20/10/10/10/10/10
3	INTERIOR CORNER GUARDS	INPRO CORPORALION	081	SIAINLESS SIEEL	1 1/2 X 1 1/2 X 00
M C	KIM CASS	AARCO	SERIES 10-120 IRIM	Γ	#0/ 7 OF 7117 1117 110000 110110 70
Σ Ω	אָם אָ אָם אָל	AARCO	SERIES 10-008	WHILE— VZ	<u>ا</u> ک
<u>n</u> 2	TACK BOAKUS - 0 A4 , 20 A4	AARCO	SERIES 10-032	I/O PEBBLE GRAIN CURN	LAMINATED TO 3/8 FIBERBOARD
3	JECTION SCREEN	EINVOT	AV	70	1
ı	ICE MAKER- 26"W X 26.5" DP., 80# CAP.	MANITOWOC	STAND ALONE		3
	LOCKERS	PENCO	SINGLE TIER	TAWNY TAN #012	2" X 12" X
1	- 1	VANGUARD	BACKGROUND COLOR =	BM 2063-10 OLD NAVY; LETTERS	ERS = DEVOE 2M42D
ı	1	ARDEN			
ı	RECYCLING BINS	RUBBERMAID		1	PLACED IN READY ROOM
		1	1	1	-
EXIERIOR	IIEMS				
1	- S	MBCI	16" BATTENLOK		COATED WITH VALSPAR 437R743
1	ROOF, TRIM, DOWNSPOUTS	CECO		MEDIUM BRONZE	1
1					
1	METAL WALL PANELS	METL— SPAN	CF	MATCH "FASHION GRAY"	-
l	LOUVERS AND VENTS	GREENHECK	ЕНН	MATCH "FASHION GRAY"	
1	STEEL COLUMNS	CECO		GRAY	
	FACE BRICK	ACME	STANDARD MODULAR	RAZORBACK BLEND	
I	CMU	ı	1	1	1
ı	CMU REINFORCEMENT	DURO-0-WALL	1	-	•
.	WALL FLASHING	PERMA- BARRIER	0.060" EPDM		
	FIBERGLASS TRANSLUCENT WALL PANELS	KALWALL	U= 50	CRYSTAL	
1	MECHANICAL YARD FENCING	GREENCHECK	舌	DARK BRONZE	6" WIDTH

GWB MRGWB EP CT PT

ACP EXP PMT

		MATERIAL AND CO	COLOR SCH	SCHEDULE		
REMARKS	FINISH	MATERIAL DESCRIPTION	MANUFACTURER	PATTERN/ NAME / NI IMBER	COLOR/ NUMBER	REMARKS
RECESSED WALK-OFF MAT	MILLWORK	1				
	PL-1	CABINETS- USE AWI PREMIUM STDS.	FORMICA	7814–58	CHALK SOLIDZ MATTE FINISH	EXPOSED TO VIEW
	•	CABINETS, DRAWERS & SHELVES	CUSTOM	MELAMINE	WHITE	NOT EXPOSED TO VIEW
		CABINET HARDWARE	49	CONCEALED HINGES	STAINLESS STEEL	1
	1	CABINET HARDWARE	I	DRAWER SLIDES	STAINLESS STEEL	1
	1	CABINET HARDWARE	1	1/2" RECESSED STDS.	STAINLESS STEEL	1
	1	CABINET HARDWARE	1	CONCEALED HINGES	STAINLESS STEEL	1
	1	CABINET HARDWARE	1	4" WIRE PULLS	STAINLESS STEEL	Ī
	PL-2		CUSTOM	NEVAMAR	TEXTURED MR3005T	NAVY MATRIX
	PL-2	TOILET PARTITIONS	ACCURATE	NEVAMAR	TEXTURED MR3005T	NAVY MATRIX- FLOOR MT
	WINDOW	W TREATMENTS				
	1	HORIZONTAL BLINDS— INTERIOR	HUNTER-DOUGLAS	1" LIGHTLINES	820 UMBER	7/8" X 1 3/4"
SEE INTERIOR FI EVATIONS						
	INTERIOR	IOR DOORS AND WINDOWS				
מאסידאים ים מסומידואו דומי	ı	CURTAINWALL	VISTAWALL	RELIANCE		
SEE INTERIOR ELEVATIONS		SOLID- CORE WOOD DOORS	MOHAWK	ROTARY CUT, 7- PLY	STAINED & CLEAR SEALED	MATCH
KECESSED WALK-OFF MAI	1	HOLLOW METAL DOORS AND FRAMES	STEELCRAFT	L-20 SERIES	FIELD PAINT	ı
71477	ı	OVERHEAD COILING DOORS	COOKSON	TYPE FMWI	FIELD PAINT	MOTORIZED
KECESSED WALK-OFF MAI	1	UPWARD ACTING DOORS	MEGADOOR	-		MOTORIZED
	1	•	1	1	TRANSLUCENT WHITE #5762090	1
	ı	CURTAINWALL GLAZING	ЭН	SOLARBAN 60	BRONZE & CLEAR	BLAST - PROOF GLAZING
	1	FIRE EXTINGUISHER CABINETS	LARSON'S	AMPRO	#2409-6R	FULL TEMPERED GLASS D
	D00R	품				
ECESSED WALK-OFF MAT; MEGADOOR	1		1	1	1	1
	PERM/	PERMANENT INTERIOR FURNISHINGS OR EQUIPMENT				
	ප	INTERIOR CORNER GUARDS	INPRO CORPORATION	180	STAINLESS STEEL	1 1/2" X 1 1/2" X 60"
00000000 Fire Fire Fire	WB WB	MARKER BOARD TRIM	AARCO	SERIES 10-120 TRIM	CLEAR ANODIZED-204R1 FINISH	1
ECESSED WALK-OFF MAI; MEGADOOK	WB	MARKER BOARDS- 6'X4', 8'X4', 10'X4'	AARCO	SERIES 10-008	WHITE- V2	24 GUAGE PORCELAIN LA
	2	TACK BOARDS- 8'X4', 20'X4'	AARCO	SERIES 10-032	1/8" PEBBLE GRAIN CORK	LAMINATED TO 3/8" FIBEI
	PS	PROJECTION SCREEN	ENVOY	AV	20,	1
		ICE MAKER- 26"W X 26.5" DP., 80# CAP.	MANITOWOC	STAND ALONE		
	1	LOCKERS	PENCO	SINGLE TIER	TAWNY TAN #012	12" X 12" X 60"; DUST
	1	SIGNAGE	VANGUARD	BACKGROUND COLOR =	BM 2063-10 OLD NAVY; LETTERS	ERS = DEVOE 2M42D
	I	WALK-OFF MATS	ARDEN			
	i	RECYCLING BINS	RUBBERMAID	1	1	PLACED IN READY ROOM
		- 1	ı	1	1	1
	EXTERIOR	IOR ITEMS		I		
		CTANIDINIO CEAN METAL DONE DANIELS	IJON	18" DATTENI OK	MENITIM DECNIZE	COATED WITH VAI COAD AT

SCHEDULE

FINISH

ROOM

Copyright 2008 by Pond & Company. All rights reserved This document is the property property of Pond & Company. It is to be used only for the specific project identified or referred to herein and is not not to be used on other projects, in whole or part, except by the express written or part, except by the express written

NOCO			DACE				יייי		לטוובה	EACT		CEII INC	/SOFFIT	
NO.	ROOM NAME	E S	FIN.	MAT'L.	FIN.	MAT'L.	3 -	MAT'L.	FIN.	MAT'L.		MAT'L.	\	REMARKS
100	MAIN ENTRY VESTIBULE	* (82 8	GWB	PT-1	MRGWB/GL	L PT-1	СМО	PT-1	MRGWB/GL	- .	MRGWB	8,-9,	*RECESSED WALK-OFF MAT
101	CORR. "A"	VFC-1	88 8	GWB	PT-1	GWB/GL GWB		CMC	PT-1	CMU	- -	ACP) () () ()	1
103	JANITOR	SC	2 82	GWB	PT-1	GWB	PT-1	CMC	PT-1	GWB	- -	ACP ACP	1	1 1
104	LAUNDRY	VFC-1	RB BB	GWB	PT-1	GWB	PT-1	CMU	PT-1	СМО	l	ACP	φ 1	
105	CORROSION CONTROL OFFICE	CPT-1	88	GWB	PT-1	CWB/GL	PT-1	GWB	PT-5	GWB	1 1	ACP	ω	
106	- 1	CPT-1	88	GWB	PT-2	CWB/GL	PT-1	GWB	PT-1	GWB		ACP	8,	
107	FUELS READY ROOM	CPT-1	RB	GWB	PT-3	GWB/GL	PT-1	GWB	PT-1	GWB		ACP	, w	
2 1 3	CORR. "C"	VFC-2	æ æ	GWB	PT-1	GWB	PT-1	GWB	PT-1	CWC	PT-1	ACP		-
110	FILE CELL DEFICES		2 8	GWB	PT-1-	GWB/ GL	- I - I - I - I - I - I - I - I - I - I	GWB	PT_5	GWB		ACP OD	ά	1
= =====================================	COOR "D"		S R	CMC	PT-1	GWB/GI	- - -	GWB	- L-G	GWB	- 1	ACP ACP		1
112	WEAPONS EQUIPMENT STORAGE	SC	82	СМО	PT-1	CMU	PT-1	CMU	PT-1	CMU		1	12,	
113		CT-1,2,3	CT-1	MRGWB	CT-4/P-1*	MRGWB	CT-4/P-1*	MRGWB	P-1*		CT-4/P-1*	* MRGWB	1 1 1	*SEE INTERIOR ELEVATIONS
114	NOT USED	1 7	1 5	1 000	1.	I ONCO	1 7 7	I OM			١.	1	1 1	
116	WOMEN S VESTIBULE "B"	* * * * * * * * * * * * * * * * * * *	- B	MRGWB	CI-4/P-1* PT-1	MKGWB GWB/GI	CI-4/P-1*	MRGWB	P-1*	MRGWB	CI-4/P-1* PT-1	MRGWB	8, -6 "0-%	*RECESSED WALK-OFF MAT
117		SC	8	CMU	PT-1	CMU	PT-1	GWB/CMU	PT-1	CMU	PT-1	EXP	1 1	
118		VFC-1	RB	СМО	PT-1	CMU	PT-1	СМО	PT-1	1	PT-1	+	â	*RECESSED WALK-OFF MAT
119	FUEL STORAGE BAY	SC	88 8	CMU	PT-1	CMU	PT-1	CMU	PT-1	СМО	PT-1	CXP (S	12'-0"	1
121	CTK STORAGE	کی کر	5 g	CMC	PT-1	OMO	7 7 1-1	CMO	PI-17	CMO	PI-I		12 -0	1
122	FUEL CELL	SPC	8 8	CWC	PT-1	OWO	PT-1	CMC	PT-1	*	PT-1		0- 71	*MEGADOOR
123	WEAPONS LOADING	SPC	RB BB	СМО	PT-1	CMU	PT-1	СМО	PT-1	*	PT-1	EXP	1	*RECESSED WALK-OFF MAT; MEG
124	WEAPONS STORAGE	SC	88	CMU	PT-1	CMU	PT-1	СМО	PT-1	СМО	PT-1	EXP	12'-0"	
125	STORAGE	SC	-+	CMU	PT-1	CMU		СМО	PT-1	СМО	PT-1	EXP	12'-0"	
126	WASH AREA	သ င		CMU/PMIL	PI-1	CMU/PIML CMI/MPGW				1 2	PT-1	EXP FXP	1 1	
128	CORROSION CONTROL	SPC	8 8	CMU/PMTL	PT-1	CMU/PTML		CMU/PTML		*	PT-1	Z Z		 *RECESSED WALK-OFF MAT; MEG
129		SC	RB	СМО	PT-1	CMU/GWB		CMU/GWB	PT-1	CMU/GWB	PT-1	EXP	1	
130	FLAMMABLE STORAGE, BLASTING AND PAINT	SC	88	СМО	PT-1	CMU/GWB		CMU/GWB		CMU/GWB	PT-1	EXP	•	1
131	NOT USED	1 8	1 6	1	1 2	- 0,1170		- 1	1 2	- CMO/ 1110	1 2	ı	•	
133	FIRE PUMP)))	2 2	CMU/GWB	PI-1	CMU/GWB	PT-1	CMU/GWB	PI-1	CMU/GWB	PI-I		1 1	-
134	MECHANICAL	SC	88	CMU/GWB		CMU		CMU	PT-1	СМО	PT-1	EXP	ı	
135	ELECTRICAL	SC	RB RB	СМО	PT-1	CMU/CWB	PT-	CMU/GWB	PT-1	СМО	PT-1	EXP	-	
136	COMMUNICATIONS	SC	RB B	CMU/GWB	PT-1	CMU/GWB		CMU/GWB	PT-1	CMU/GWB	PT-1	EXP	1	1
·			·										ſ	
	MATERIAL AND CO	OLOF OLOF	2 2 3	E E E	DULE									
FINISH			MANI IFACTI IPEP		PATTERN/		COLOR/							
ABBV.		MAINO	raciore.		AME/ NUMBE	٦. -	NOMBE	, K	REMAR	RKS				
FLOOKING PPT-1	MAIERIAL CARPET TILE 18"	MANIA	MOTON		PRAN DECICA	_	NAMOOOD	2						
CT-1	TILE 2"	AMERIC	AN OLEA		MOSAIC TILE		A-21 DRIFT	DRIFTWOOD	GROUT LIN	INE TO BE 1/16	WIDE-	NOTE 1		
CT-2	CERAMIC TILE 2" SQUARE	AMERIC	AMERICAN OLEAN		MOSAIC TILE		121	HT BLUE					T	
CT-3	TILE 2"	AMERIC	AN OLEA		MOSAIC TILE		A-13 WF	# # #	SEE NOTE	1 & 2 BELOW	W.			
VFC-1	SHEET VINYL	MAN	INCTON	Ž	GNA MULTIFLE	ပ္ပ	#18005 JUTE	JE J	SEE NOTE	& -	M			
VFC-2	1 1	MANN	MANNINGTON	MA	MAGNA MULTIFLEC		#19004 MARINA	A PEARL	1 1	1 & 2	OW.			
VFC-2	SHEET VINYL	MANN	MANNINGTON	MA	MAGNA MULTIFLEC		#19005 AFRICAN	AN RED	SEE NOTE	1 & 2 BEL	OW.			
SPC	SPECIAL FLOOR COATING FOR HANGARS		bb _C		AQUAPON 35		95-3 LIGHT	GRAY						
8	מיויסט דדימטווסס				1 1			1 1						
န္က <u>ရ</u>	GROUT	CUSTOM BLDG. PROD.	3LDG. PR	OD.	EPOXY		LIGHT SMOKE	: #145	GROUT LINE	TO BE 1/4"	WIDE			
MAT-1	AT	ARDEN AF	CHITECT		QUIETFLEX M-650	n-	ULTRASORB 307	7 BLACK	AANG LOGO	TO BE EMBE	DDED IN MAT			
TRANSITION	ON MATERIAL													
TS-1	TRANSITION STRIP- RUBBER	NHOP	JOHNSONITE				63- BURNT	UMBER						
TS-2	STRIP-						WHITE/ G	RAY	AT RESTROOM	OM DOORS				
BASE M	ATERIAL ATERIAL			-					5					
RB-1	RUBBER BASE	NHOC	SONITE	TIGHTLOCK	-114X2	2860MM	63- BURNT	UMBER	4.5" X 75°	*			1	
	CERAMIC TILE COVE BASE	AMERICAN	AERICAN OLEAN		TILE N	-6A	-21	DRIFTWOOD		: TO BE 1/16"	WIDE			
	TEDIAL												TT	
WALL M.	CHEDWIN	CENEDAL	CTD 50				CW7036 ACECCIBI E	אוב סבוטב						
PT-2	PAINT BENJAMIN MOORE	FEDERAL	STD. 59		SATIN FINISH		C-77 ALEXANDRIA	OCL BEIGE						
PT-3	- BENJAMIN	FEDERAL	STD. 59					OLD NAVY					T	
PT-4		FEDERAL	STD. 59					DISTANCE						
PI-5	SOUND BATT	FEDERAL	SID. 38		SATIN FINISH BLANKET FIBER		SW6321 RED) BAY						
CT-4		AMERIC	AN OLEAN	WOS/			A-21 DRIFT	WOOD	GROUT LINE	TO BE 1/16"	WIDE			