
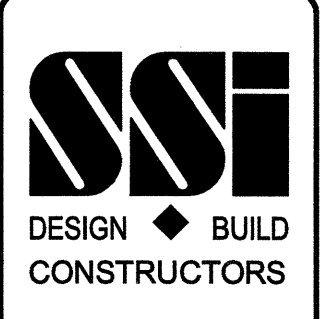


**NOTES**


- SEE C-001 FOR GENERAL NOTES, DEMOLITIONS NOTES, ABBREVIATIONS AND LEGENDS.
- CONTRACTOR TO FIELD VERIFY ALL EXISTING UTILITIES, AND NOTIFY CONTRACTING OFFICER OF ANY DISCREPANCIES.
- ALL DIMENSIONS MEASURED FROM FACE OF CURB TO FACE OF CURB, WHERE CURB IS PRESENT, UNLESS NOTED OTHERWISE.
- CONTRACTOR TO ENSURE POSITIVE DRAINAGE AWAY FROM BUILDINGS AND TO DRAINAGE STRUCTURES. CONTRACTOR SHALL ENSURE NO PONDING OCCURS.

**KEYED NOTES**

- CONTRACTOR TO PLUG CONCRETE BOX CULVERT AND PROVIDE ACCESS MANHOLE COVER.
- CONTRACTOR TO GRADE AS NECESSARY TO ENSURE POSITIVE DRAINAGE TO STRUCTURE. CONTRACTOR TO ENSURE NO PONDING OCCURS.

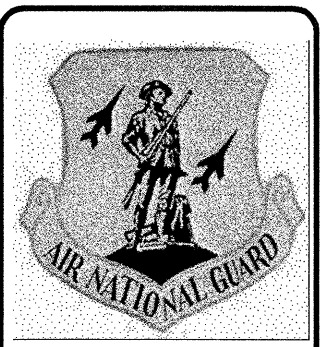

Copyright 2007 by Pond & Company. All rights reserved. This document is the property of Pond & Company. It is to be used only for the specific project identified or to be used on other projects, in whole or in part, except by the express written agreement of Pond & Company.

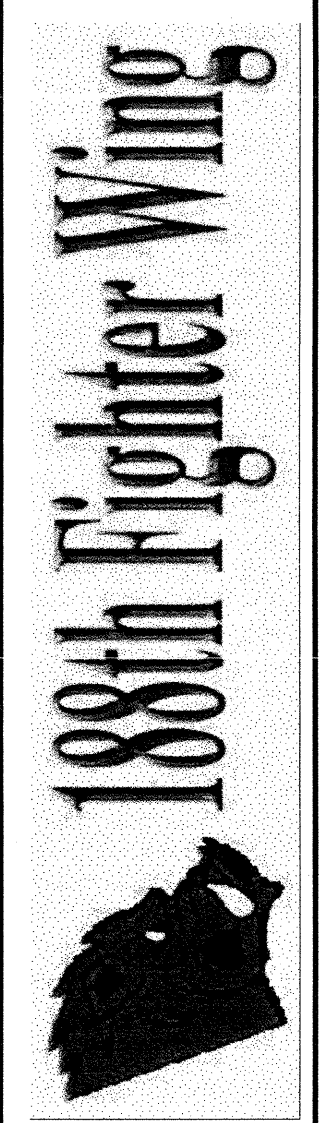

Date	By	Description
11/14/07		

Designed by: RMS	Drawn by: JPC	Reviewed by: RMS	Date: 11/14/07	Rev: 0
------------------	---------------	------------------	----------------	--------

COMPOSITE A-10 AIRCRAFT MAINTENANCE FACILITY  
 ARKANSAS AIR NATIONAL GUARD  
 CIVIL/SITE PACKAGE  
**GRADING AND DRAINAGE PLAN**

