

REV	DESCRIPTION	DATE	APPROVED
A	GRANGE SHOWERS AND F.D.	1/12/72	Handwritten
B	DWG. CORRECTED TO AS-BUILT	7-24-73	H.W.M.

**FINISH SCHEDULE**

NO.	ROOM	REMARKS
101	SHOP AREA	C/D/N/N
102	OFFICE	H/F/B/A
103	MECHANICAL ROOM	C/D/N/N
104	BEARING INSPECTION	H/E/B/O
105	PARTS CLEANING	C/E/N/N
106	LATRINE	C/D/N/N
107	TOOL CRIB	C/D/N/N
108	WELDING	C/D/N/N

**MATERIAL KEY**

- A LAY - N GRD CEILING TYPE I
- B VINYL BASE
- C CONCRETE
- D LIGHT WEIGHT CONCRETE BLOCK-LWC (UNPAINTED)
- E LIGHT WEIGHT CONCRETE BLOCK-LWC-W/EPXY PAINT
- F LIGHT WEIGHT CONCRETE BLOCK-LWC (PAINTED)
- G METAL LINER PANEL (8'-0")
- H VINYL ACESBOS TILE
- N NO FINISH
- O GYPSUM BOARD

**DOOR LEGEND**

- EXTERIOR DOORS**
- DOOR A - CRNG. (C)
  - DOOR B - CRNG. (C)
  - DOOR C - CRNG. (C)
  - DOOR D - CRNG. (C)
  - DOOR E - CRNG. (C)
  - DOOR F - CRNG. (C)
- INTERIOR DOORS**
- DOOR G - CRNG. 100 & 103
  - DOOR H - CRNG. 101, 102 & 104

**GENERAL NOTES**

1. ALL INTERIOR BLOCK WALLS SHALL BE 8"x8"x16" LIGHT WEIGHT CONCRETE BLOCK WITH MASONRY REINF. AT 16" O.C. VERTICAL. ALL HALF-LAND BEARING WALLS SHALL CONTINUE TO BOTTOM OF ROOF DECK W/AIR TIGHT SEAL AT DECK, BETWEEN RIES OF METAL DECK, & AROUND EAR JOISTS WHERE THEY CUT THRU WALLS.
2. SCORE SIDEWALKS @ 4'-0" O.C. EXCEPT @ CORNER 6'-0"
3. THE PLAN SECTION AS DRAWN IS CUT 10'-0" ABOVE FLOOR LEVEL IN LOW BUILDING & IMMEDIATELY ABOVE FLOOR IN METAL BUILDING.
4. RAMPS @ ALL EXTERIOR DOORS EXCEPT WHERE SIDEWALK OCCURS. CONCRETE @ DOORS A & B. ASPHALT @ ALL OTHER DOORS.

RECORD DRAWING  
DATE: 8 JUL 1973

NOTE: DO NOT SCALE DRAWINGS

MANAFFEY & ASSOC. - ENGINEERS  
FAYETTEVILLE, ARKANSAS

DEPARTMENT OF THE NAVY - NAVAL FACILITIES ENGINEERING COMMAND  
SOUTHERN DIVISION  
CHARLESTON, S.C.

AIR NATIONAL GUARD - MUNICIPAL AIRPORT FT. SMITH, ARKANSAS  
AIRCRAFT ENGINE INSPECTION  
AND REPAIR SHOP


FLOOR PLAN & SCHEDULES

DATE: 1/12/72


CONSTR. CONTR. NO. 80091

SCALE: AS SHOWN

SHEET 3 OF 13

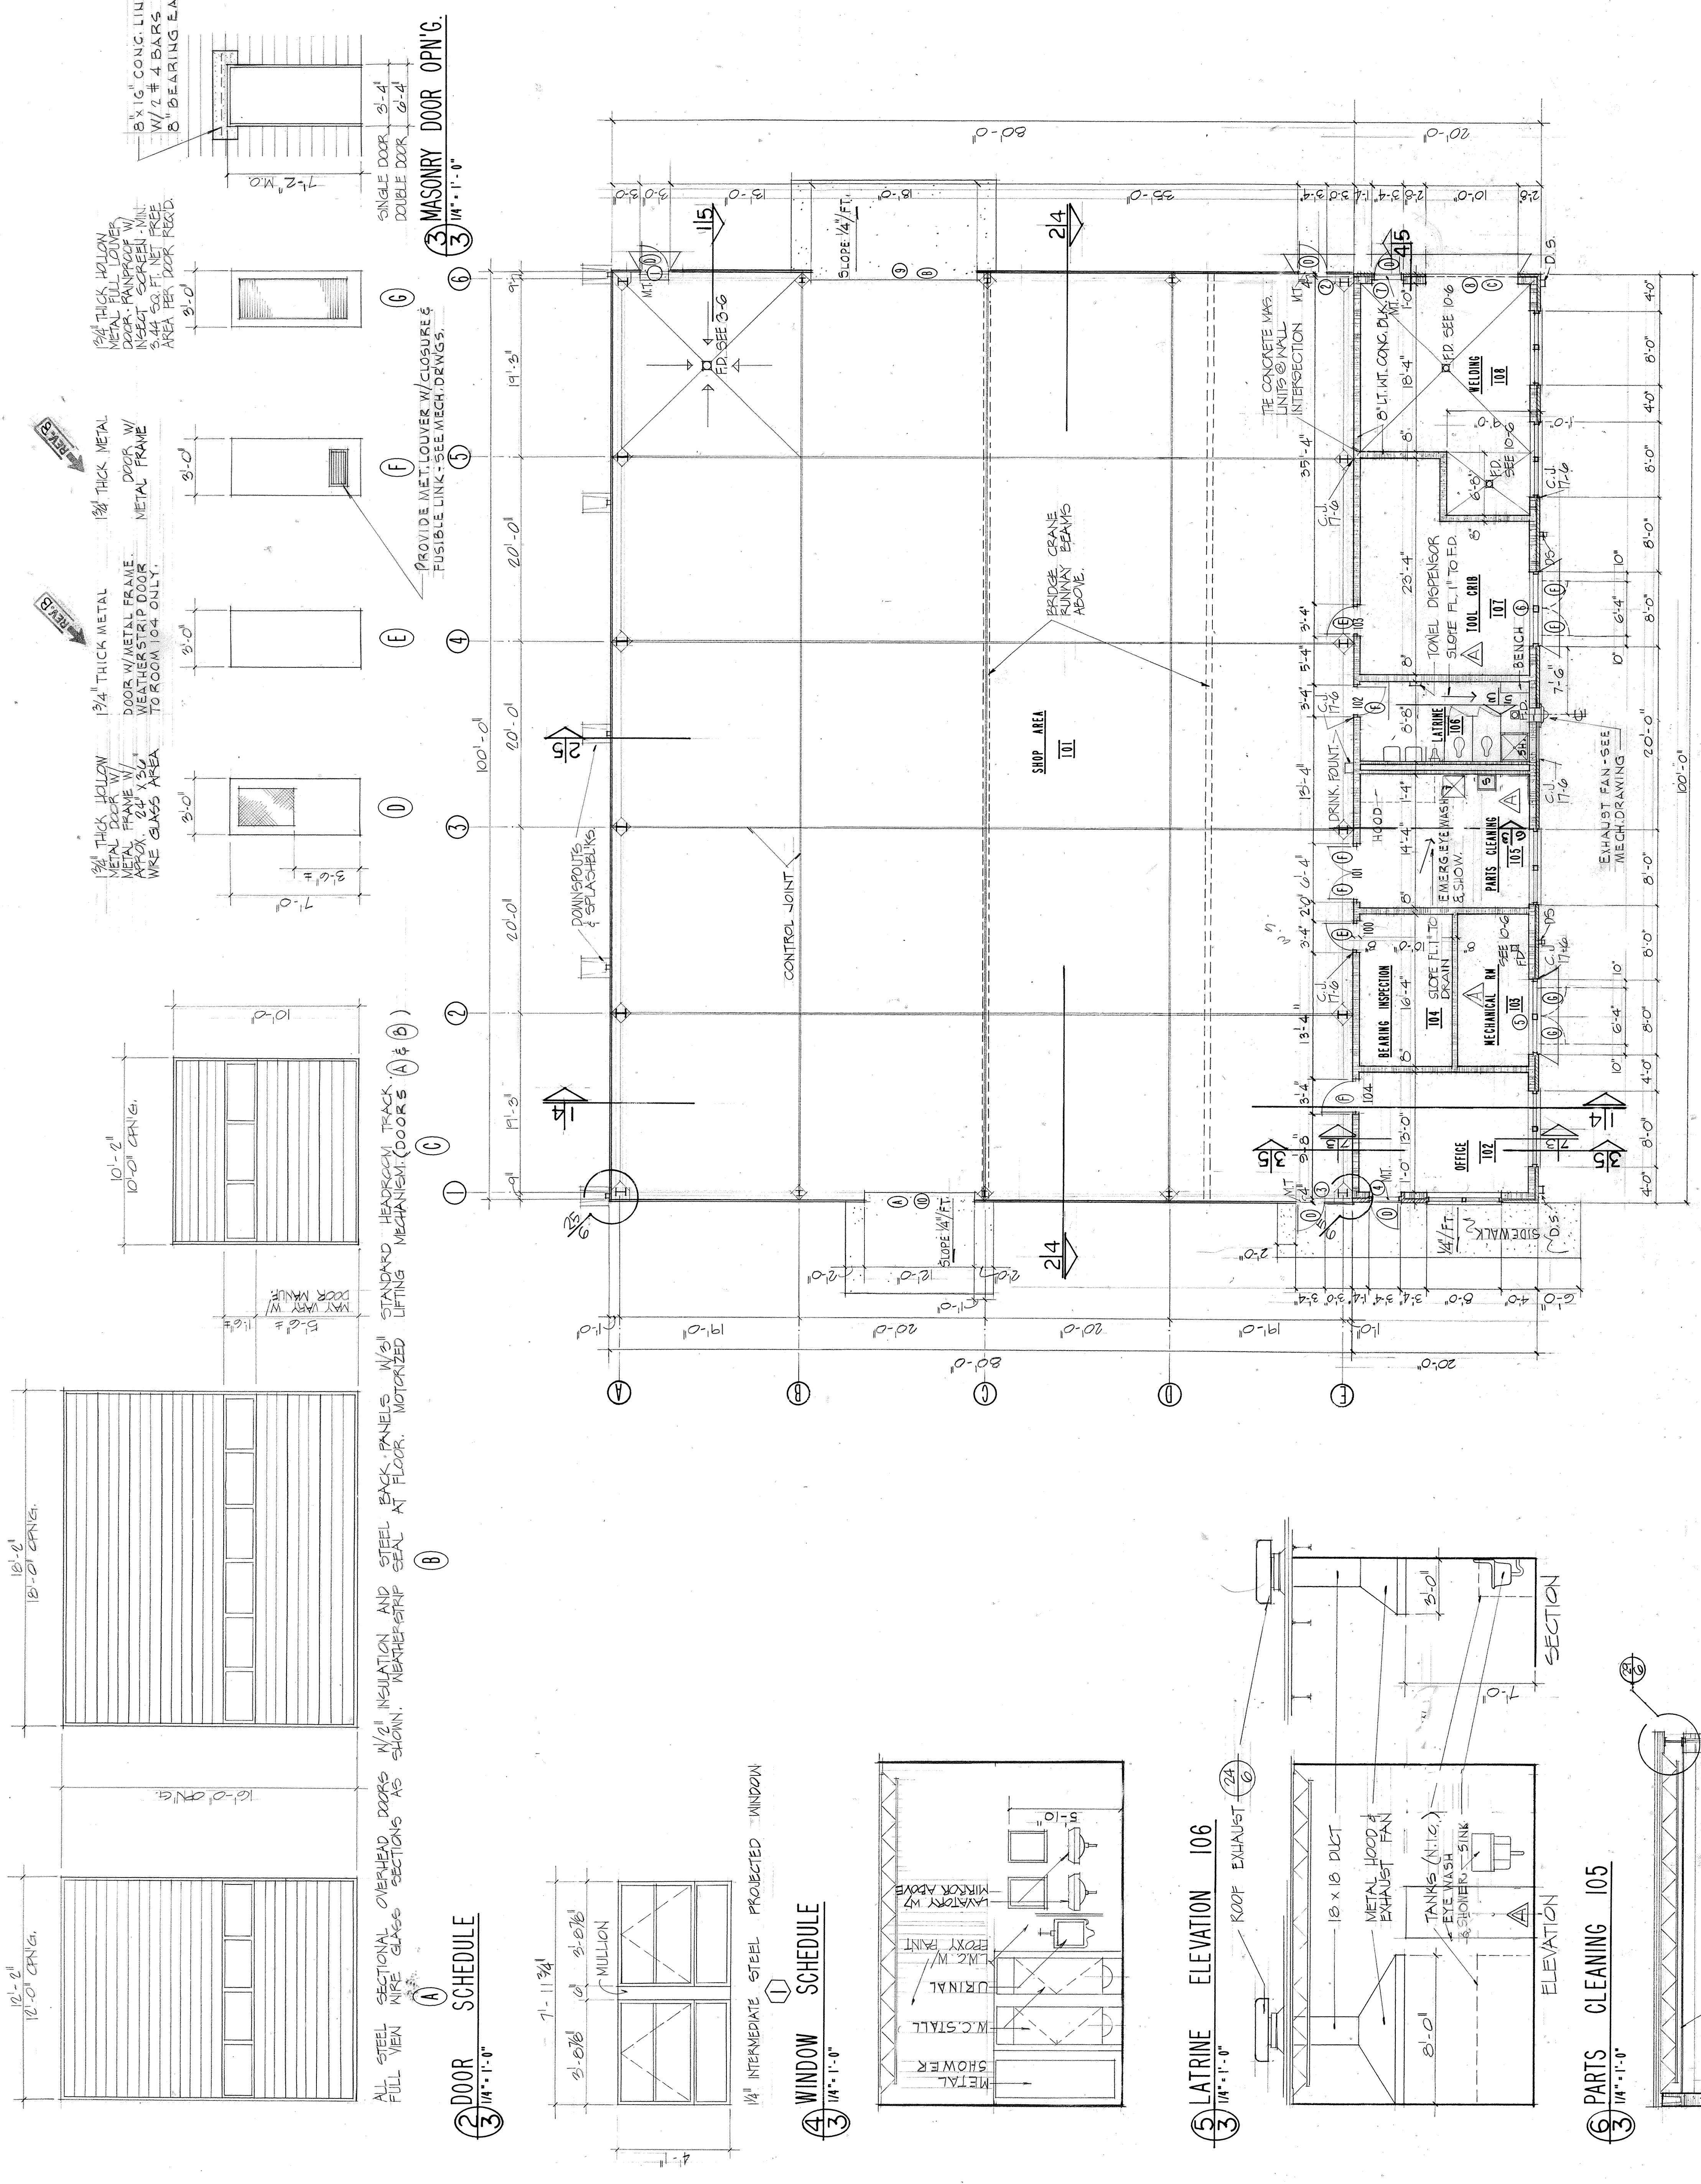

1 FLOOR PLAN  
3 1/4" = 1'-0"

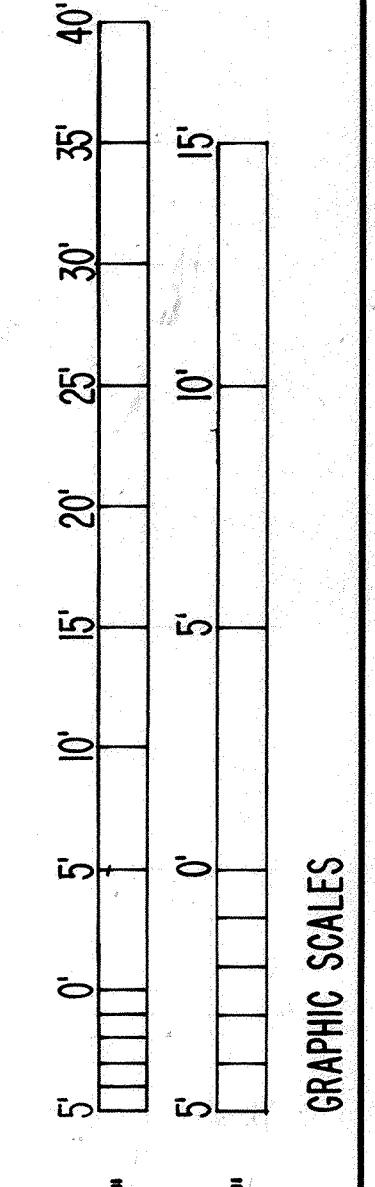

**DOOR SCHEDULE**

NO.	ROOM	REMARKS
101	SHOP AREA	C/D/N/N
102	OFFICE	H/F/B/A
103	MECHANICAL ROOM	C/D/N/N
104	BEARING INSPECTION	H/E/B/O
105	PARTS CLEANING	C/E/N/N
106	LATRINE	C/D/N/N
107	TOOL CRIB	C/D/N/N
108	WELDING	C/D/N/N

**WINDOW SCHEDULE**

NO.	ROOM	REMARKS
101	SHOP AREA	C/D/N/N
102	OFFICE	H/F/B/A
103	MECHANICAL ROOM	C/D/N/N
104	BEARING INSPECTION	H/E/B/O
105	PARTS CLEANING	C/E/N/N
106	LATRINE	C/D/N/N
107	TOOL CRIB	C/D/N/N
108	WELDING	C/D/N/N