


REVISIONS	DATE	APPROVED
LET	7/24/73	RJS
SEE NOTE BEHIND CONCERNING AS BUILT CONDITION		

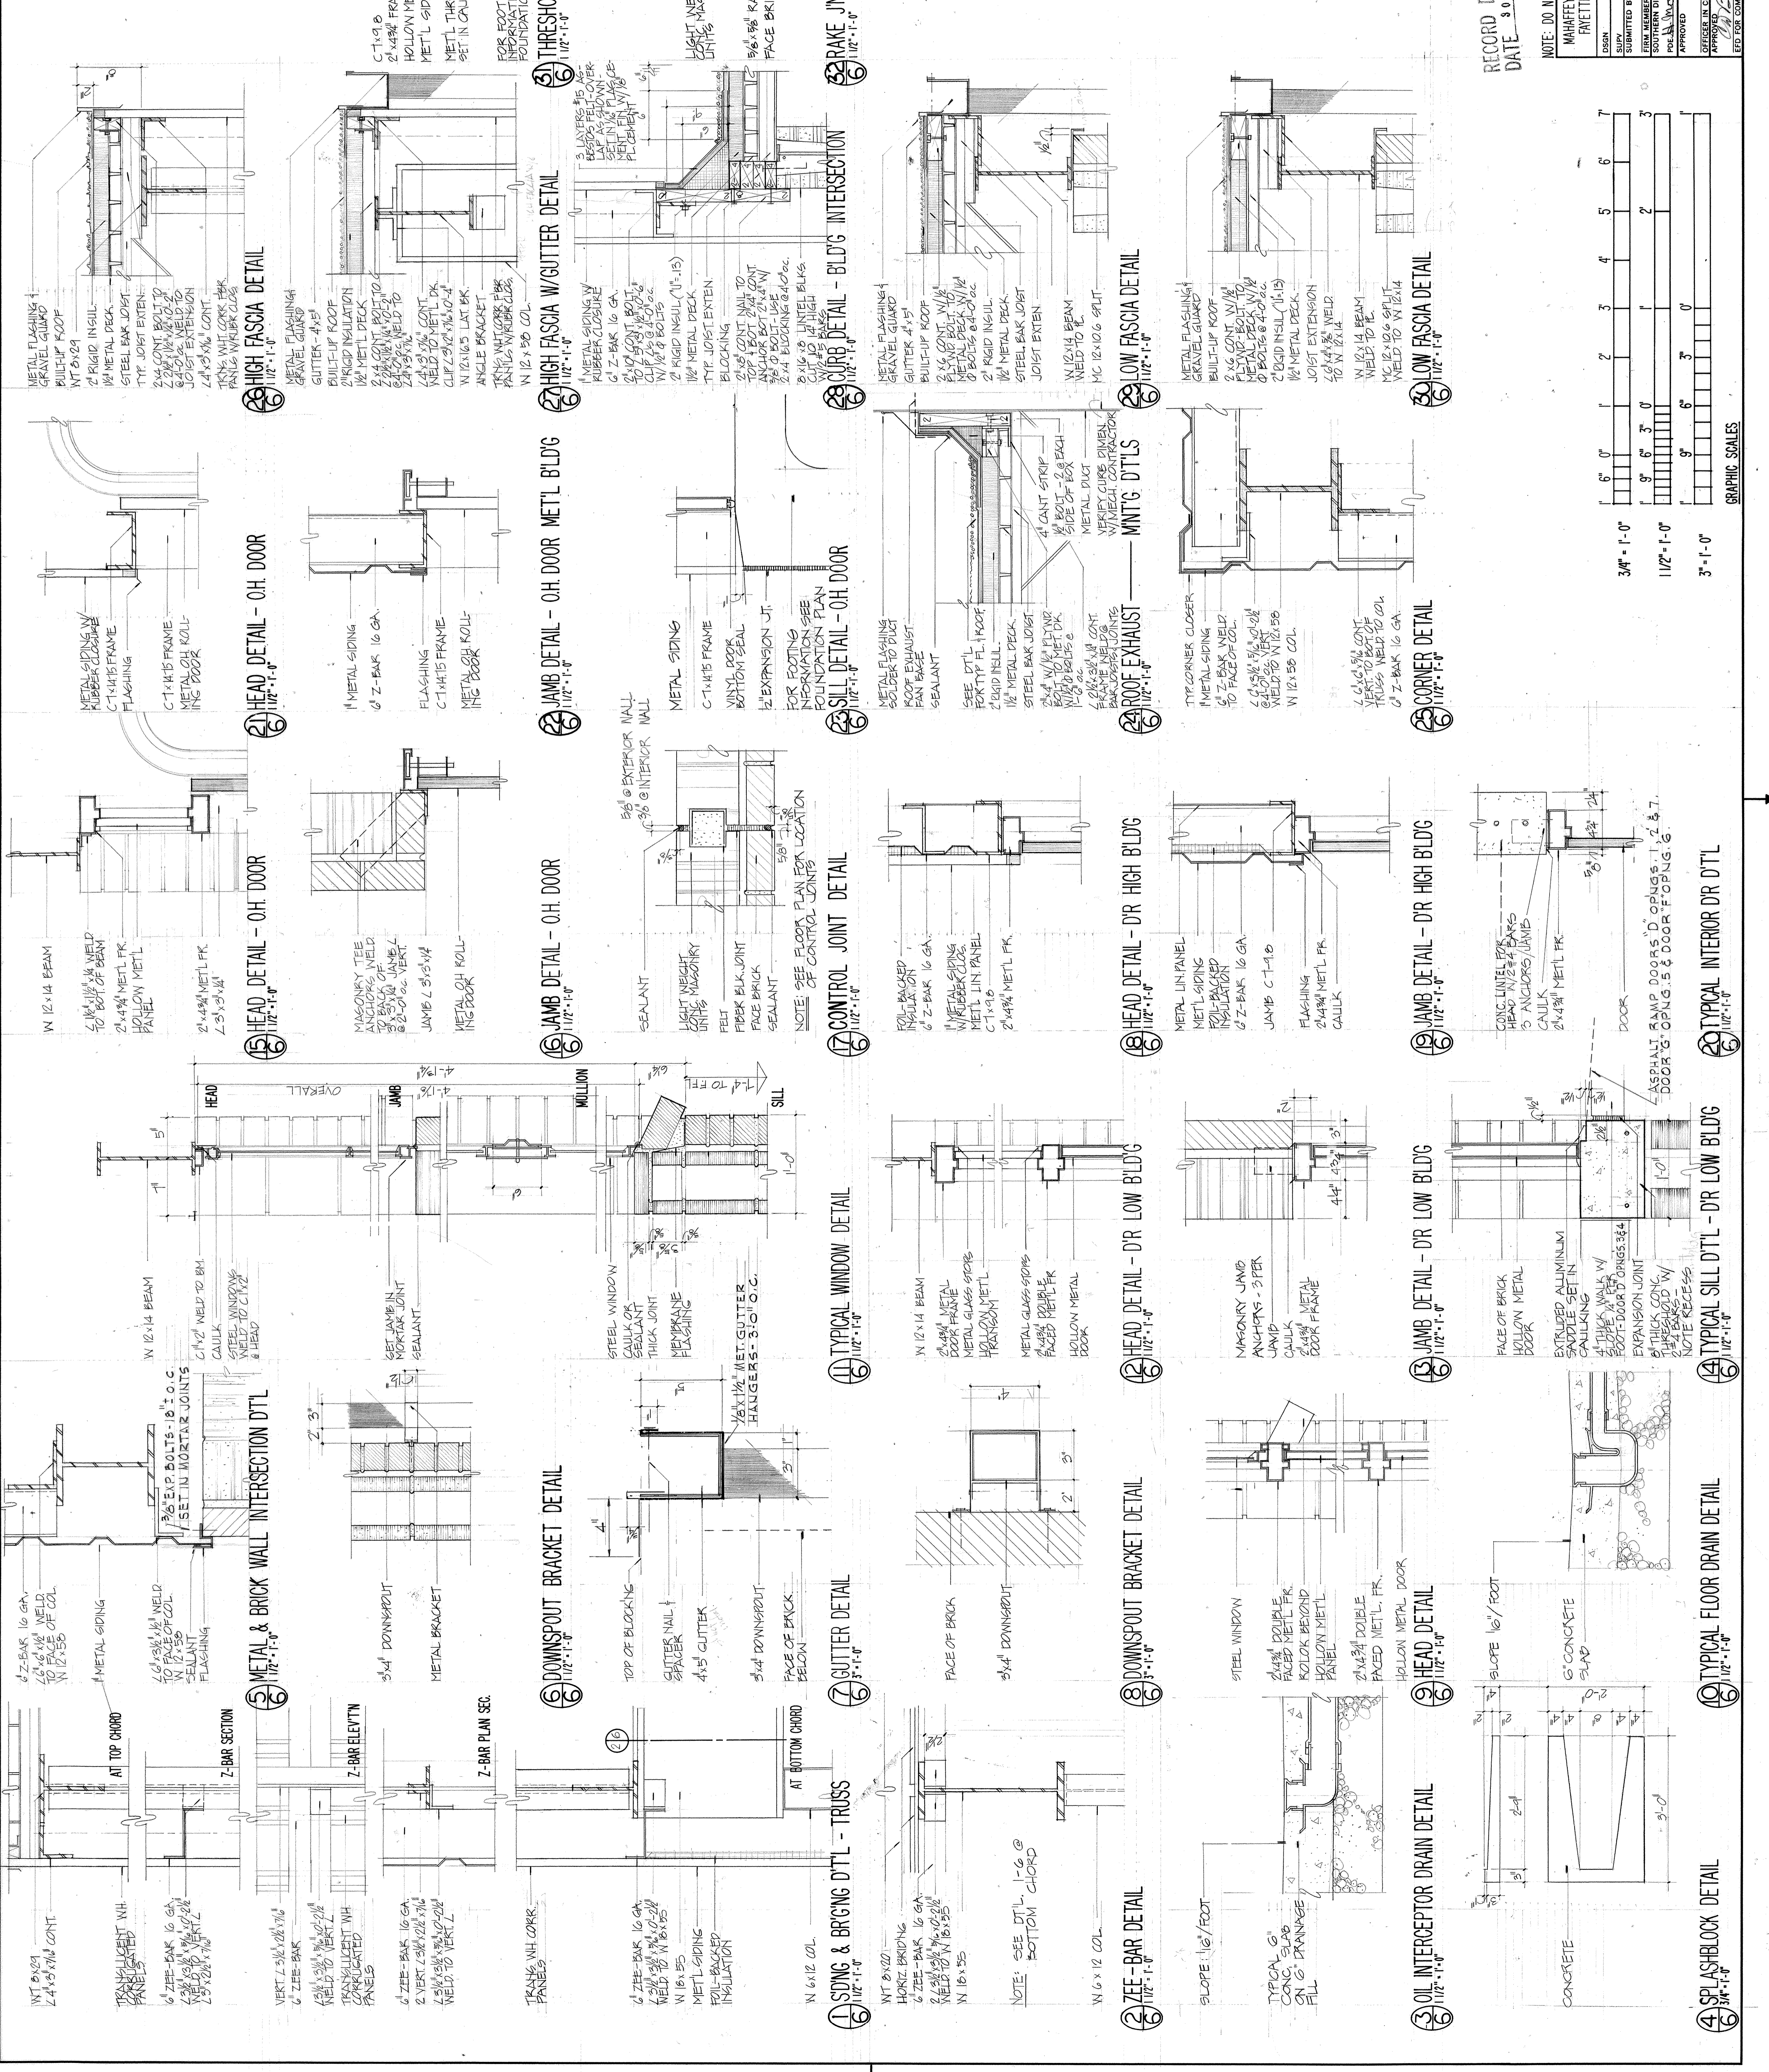

THIS DRAWING NOT CORRECTED TO AS-BUILT SINCE CONTRACTOR ELECTED TO EXERCISE OPTION TO PROVIDE PRE-ENGINEERED METAL BUILDING

RECORD DRAWING DATE 8 0 JUL 1973

NOTE: DO NOT SCALE DRAWINGS

MAHAFFEY & ASSOC. - ENGINEERS  
FAYETTEVILLE, ARKANSAS

DESIGN BY: MAHAFFEY & ASSOC.  
CHECKED BY: MAHAFFEY & ASSOC.  
SUBMITTED BY: MAHAFFEY & ASSOC.

SOUTHERN DIVISION  
AIR NATIONAL GUARD - MUNICIPAL AIRPORT FT SMITH, ARKANSAS  
AIRCRAFT ENGINE INSPECTION AND REPAIR SHOP

DETAILS

SIZE: CODE IDENT NO. 155047  
F 80091  
CONST. CONTR. NO. 152427-10-C-0586  
DATE 11/16/71  
SCALE: AS SHOWN  
SHEET 6 OF 13

