



NORTH ELEVATION
1/8" = 1'-0"

5
A4.1

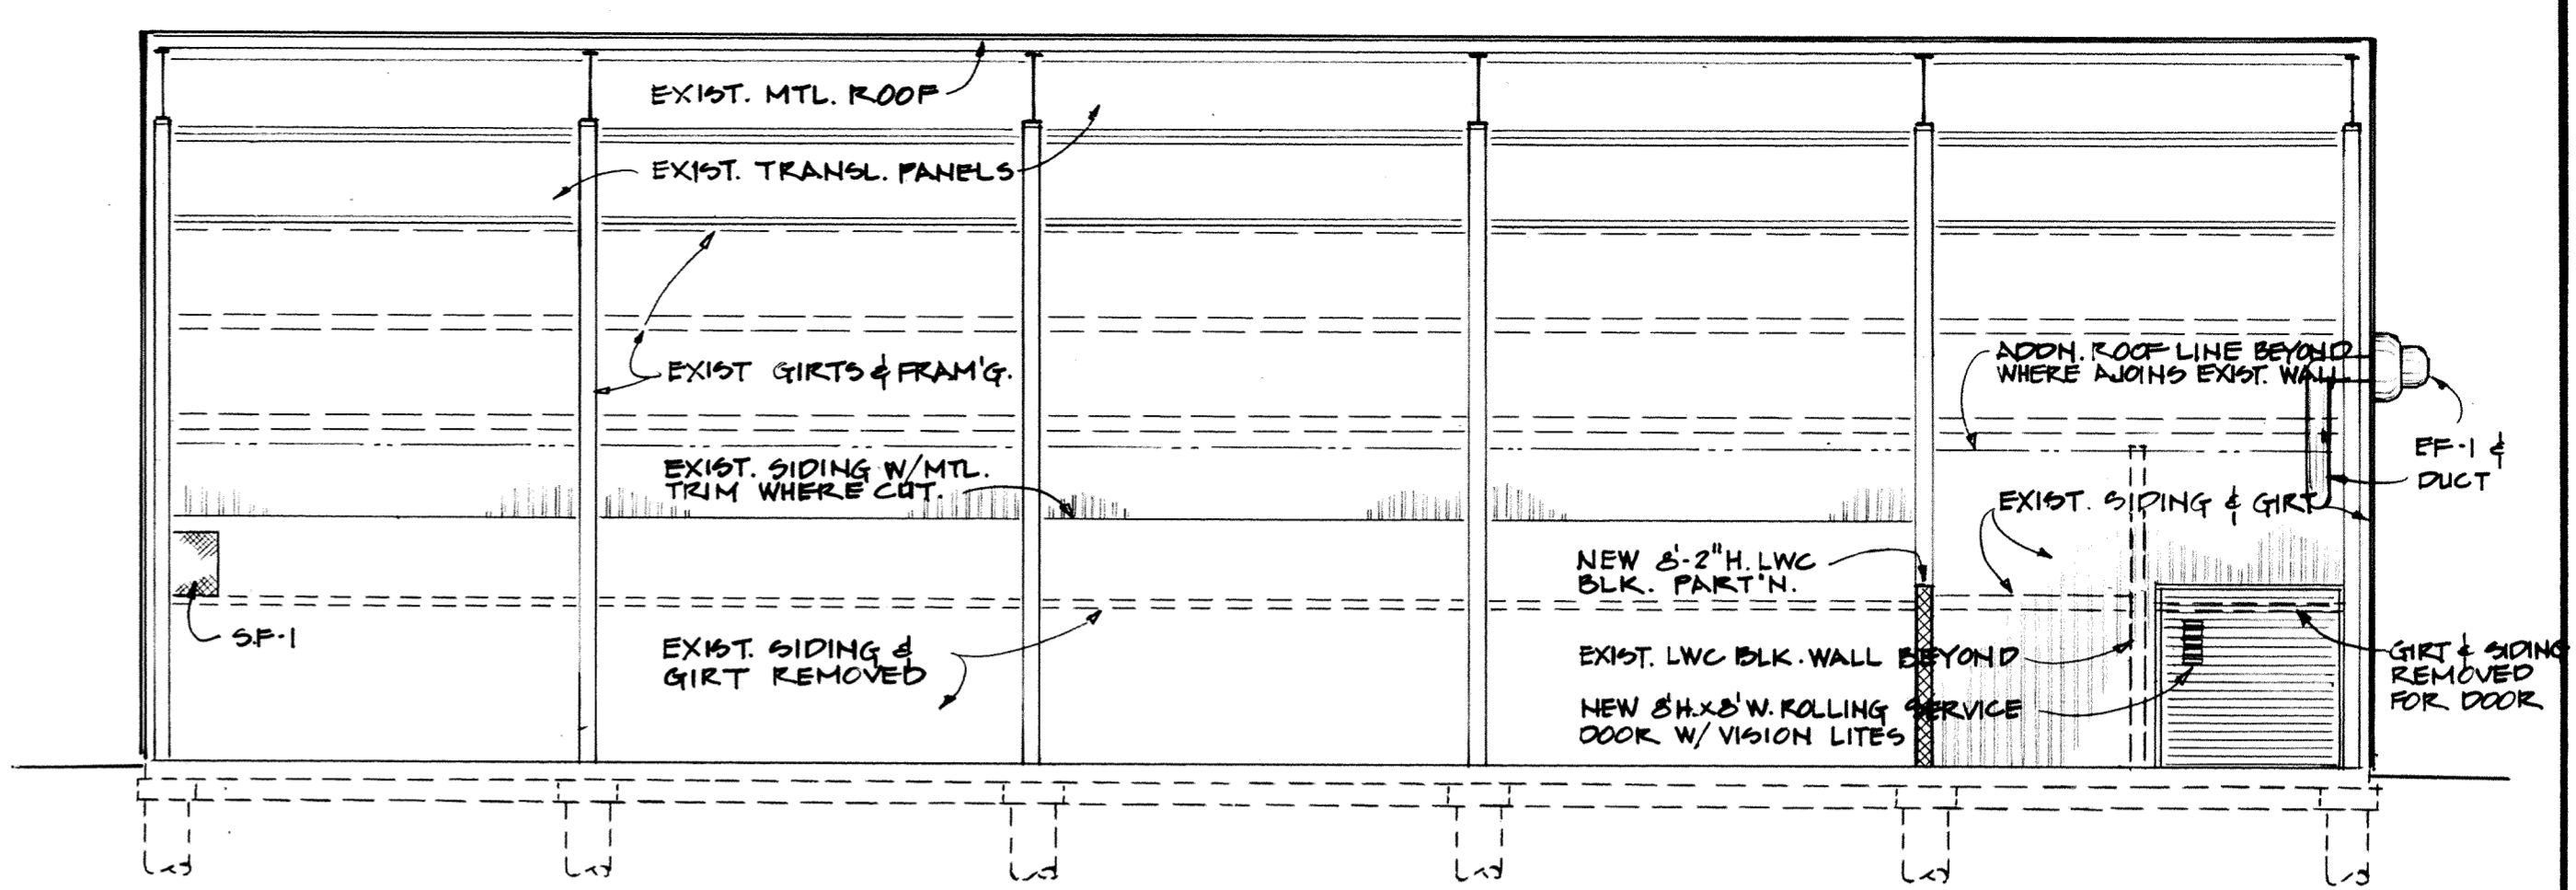


LONGITUDINAL SECTION
1/8" = 1'-0"

1
A4.1

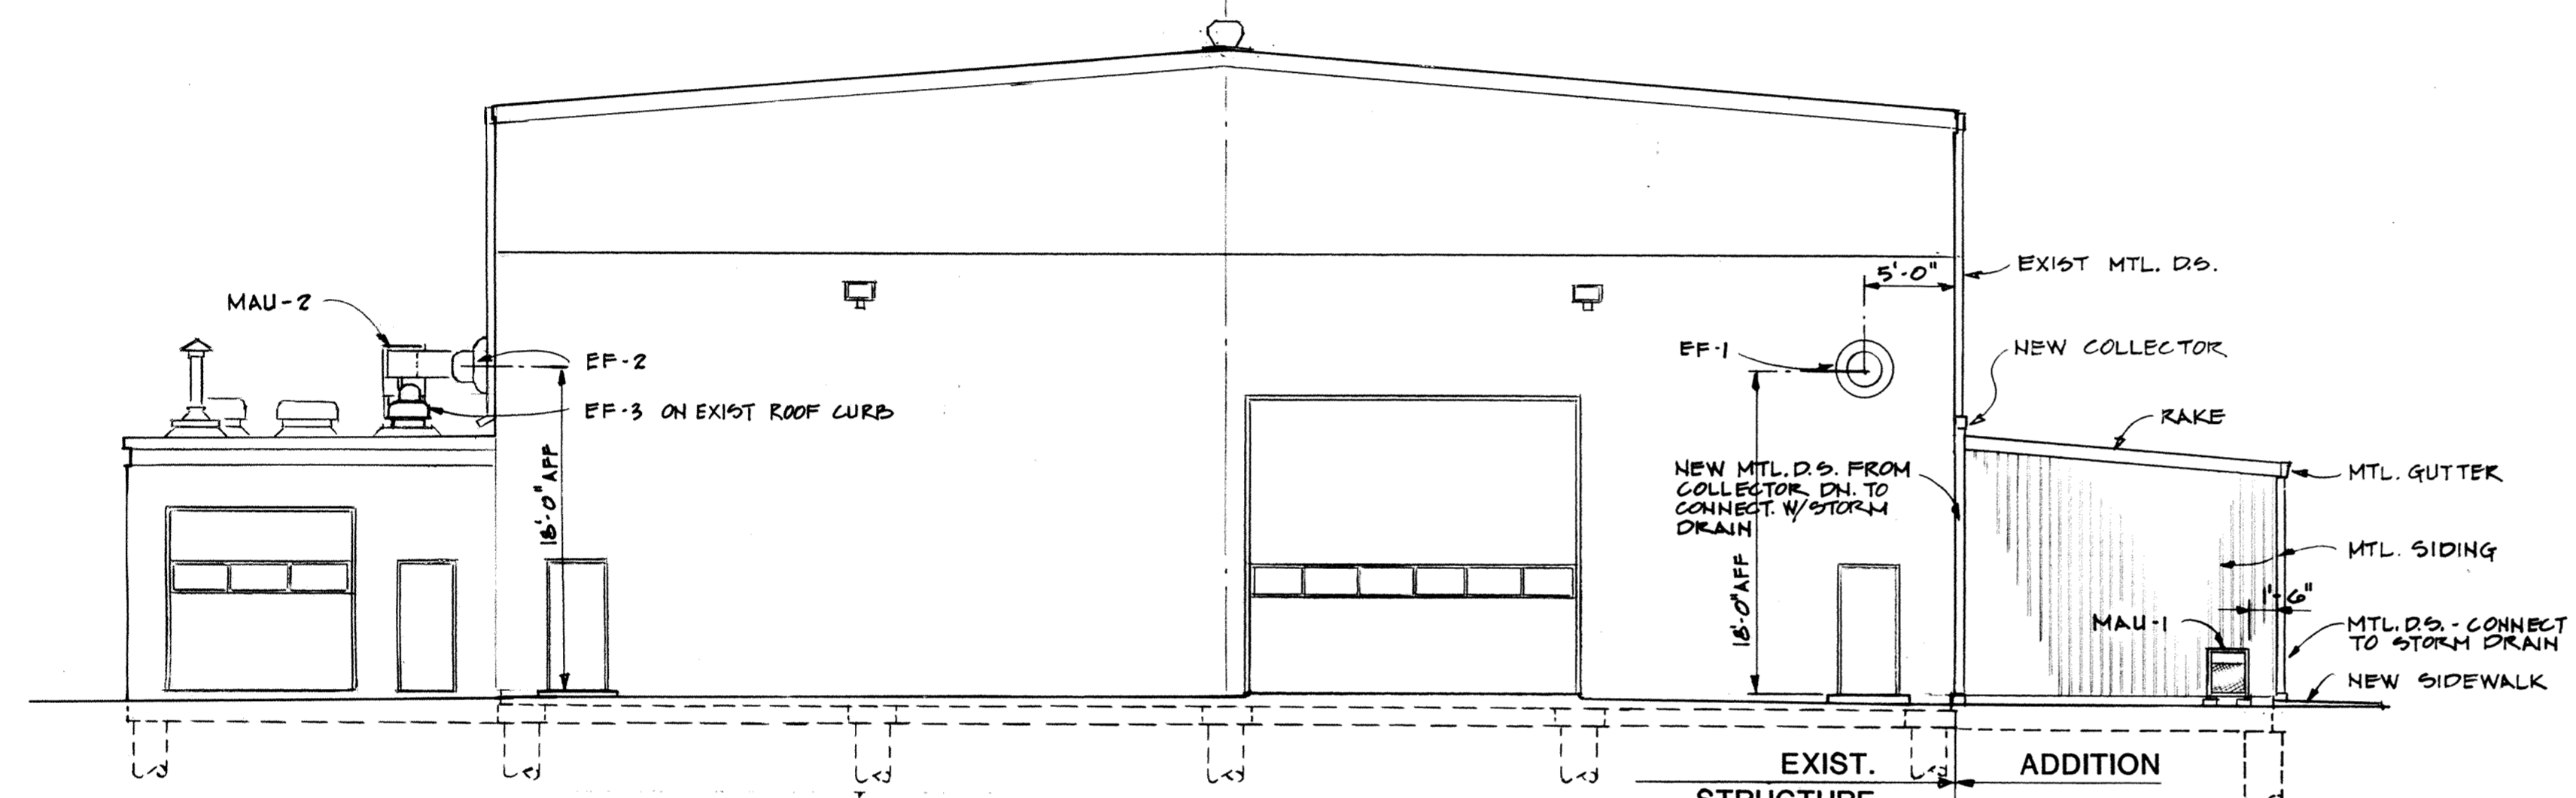


EAST ELEVATION
1/8" = 1'-0"

4
A4.1

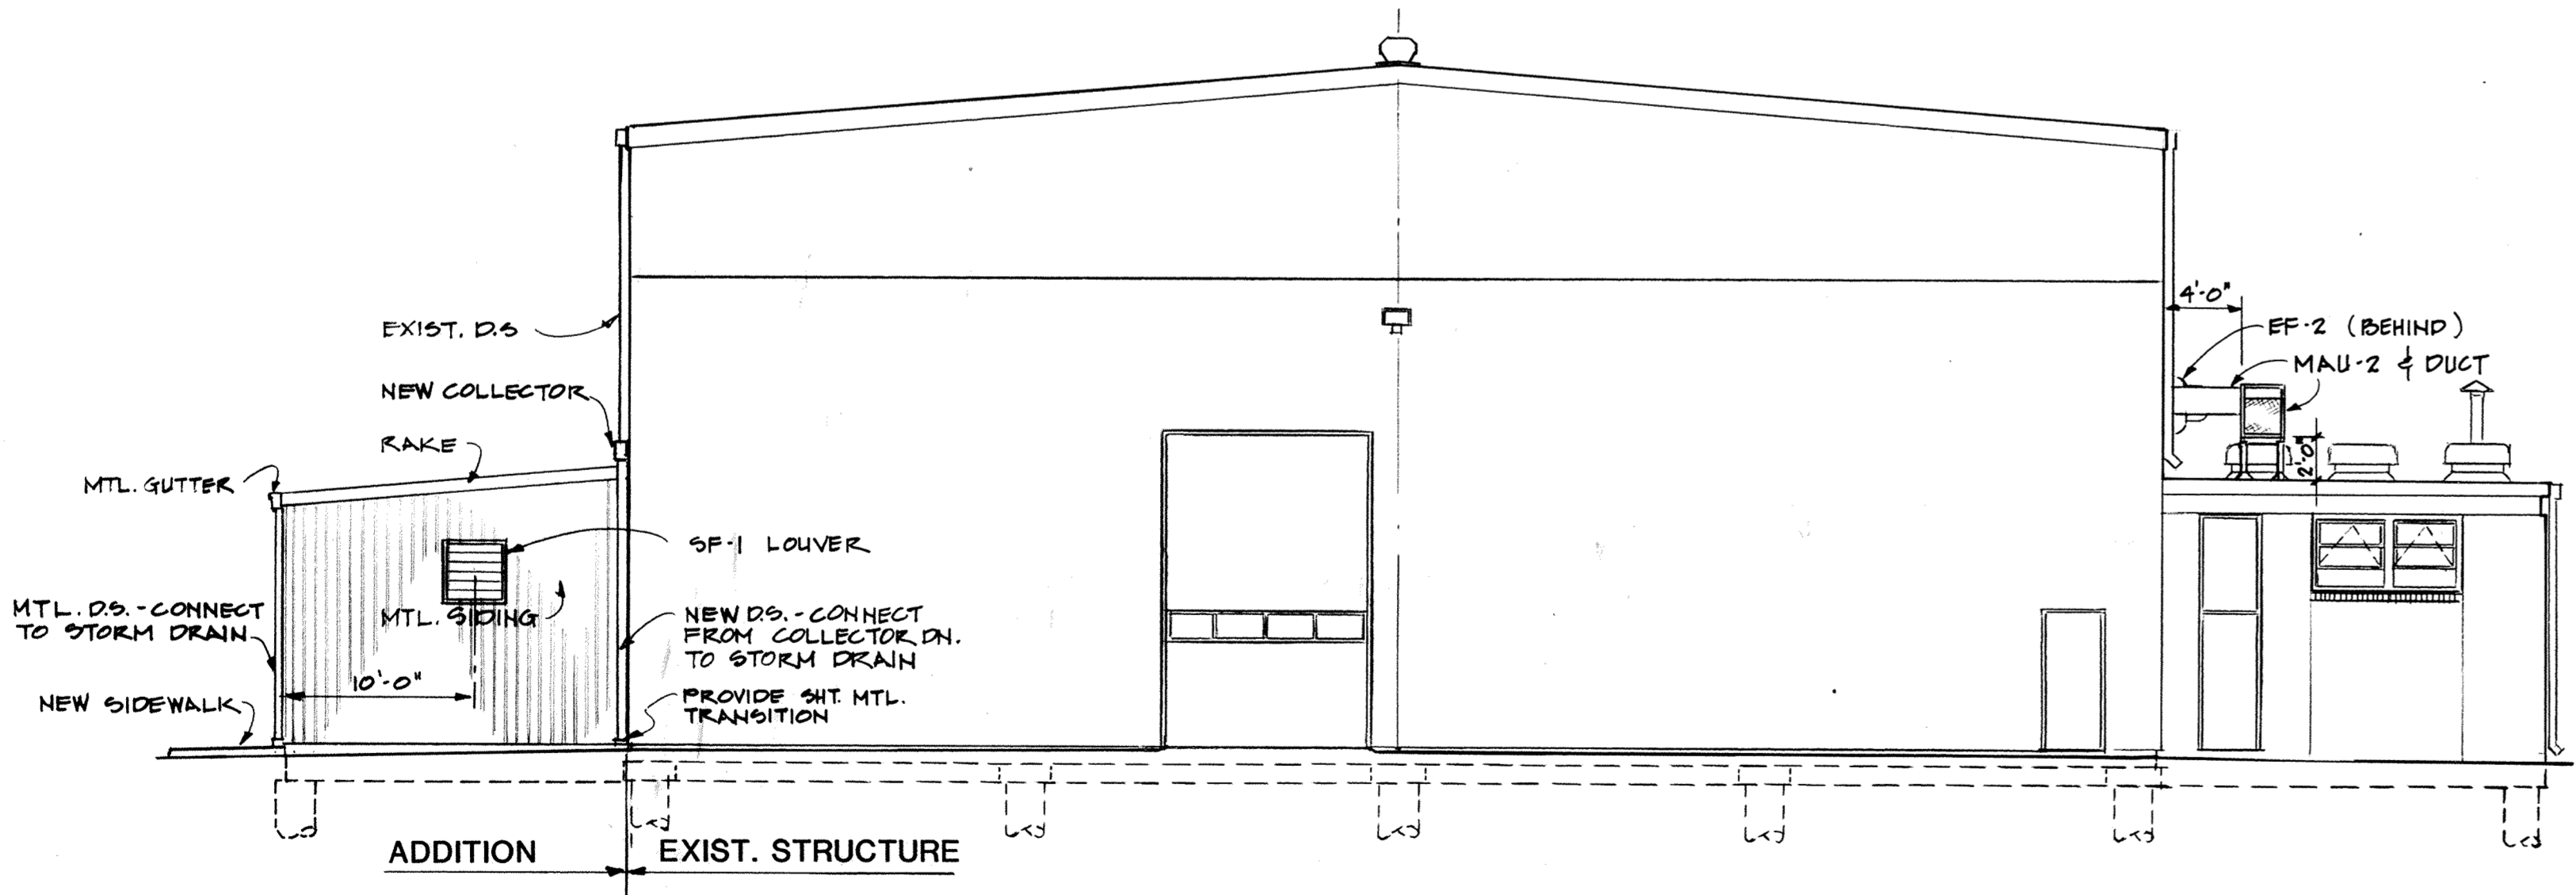


WEST ELEVATION
1/8" = 1'-0"

3
A4.1

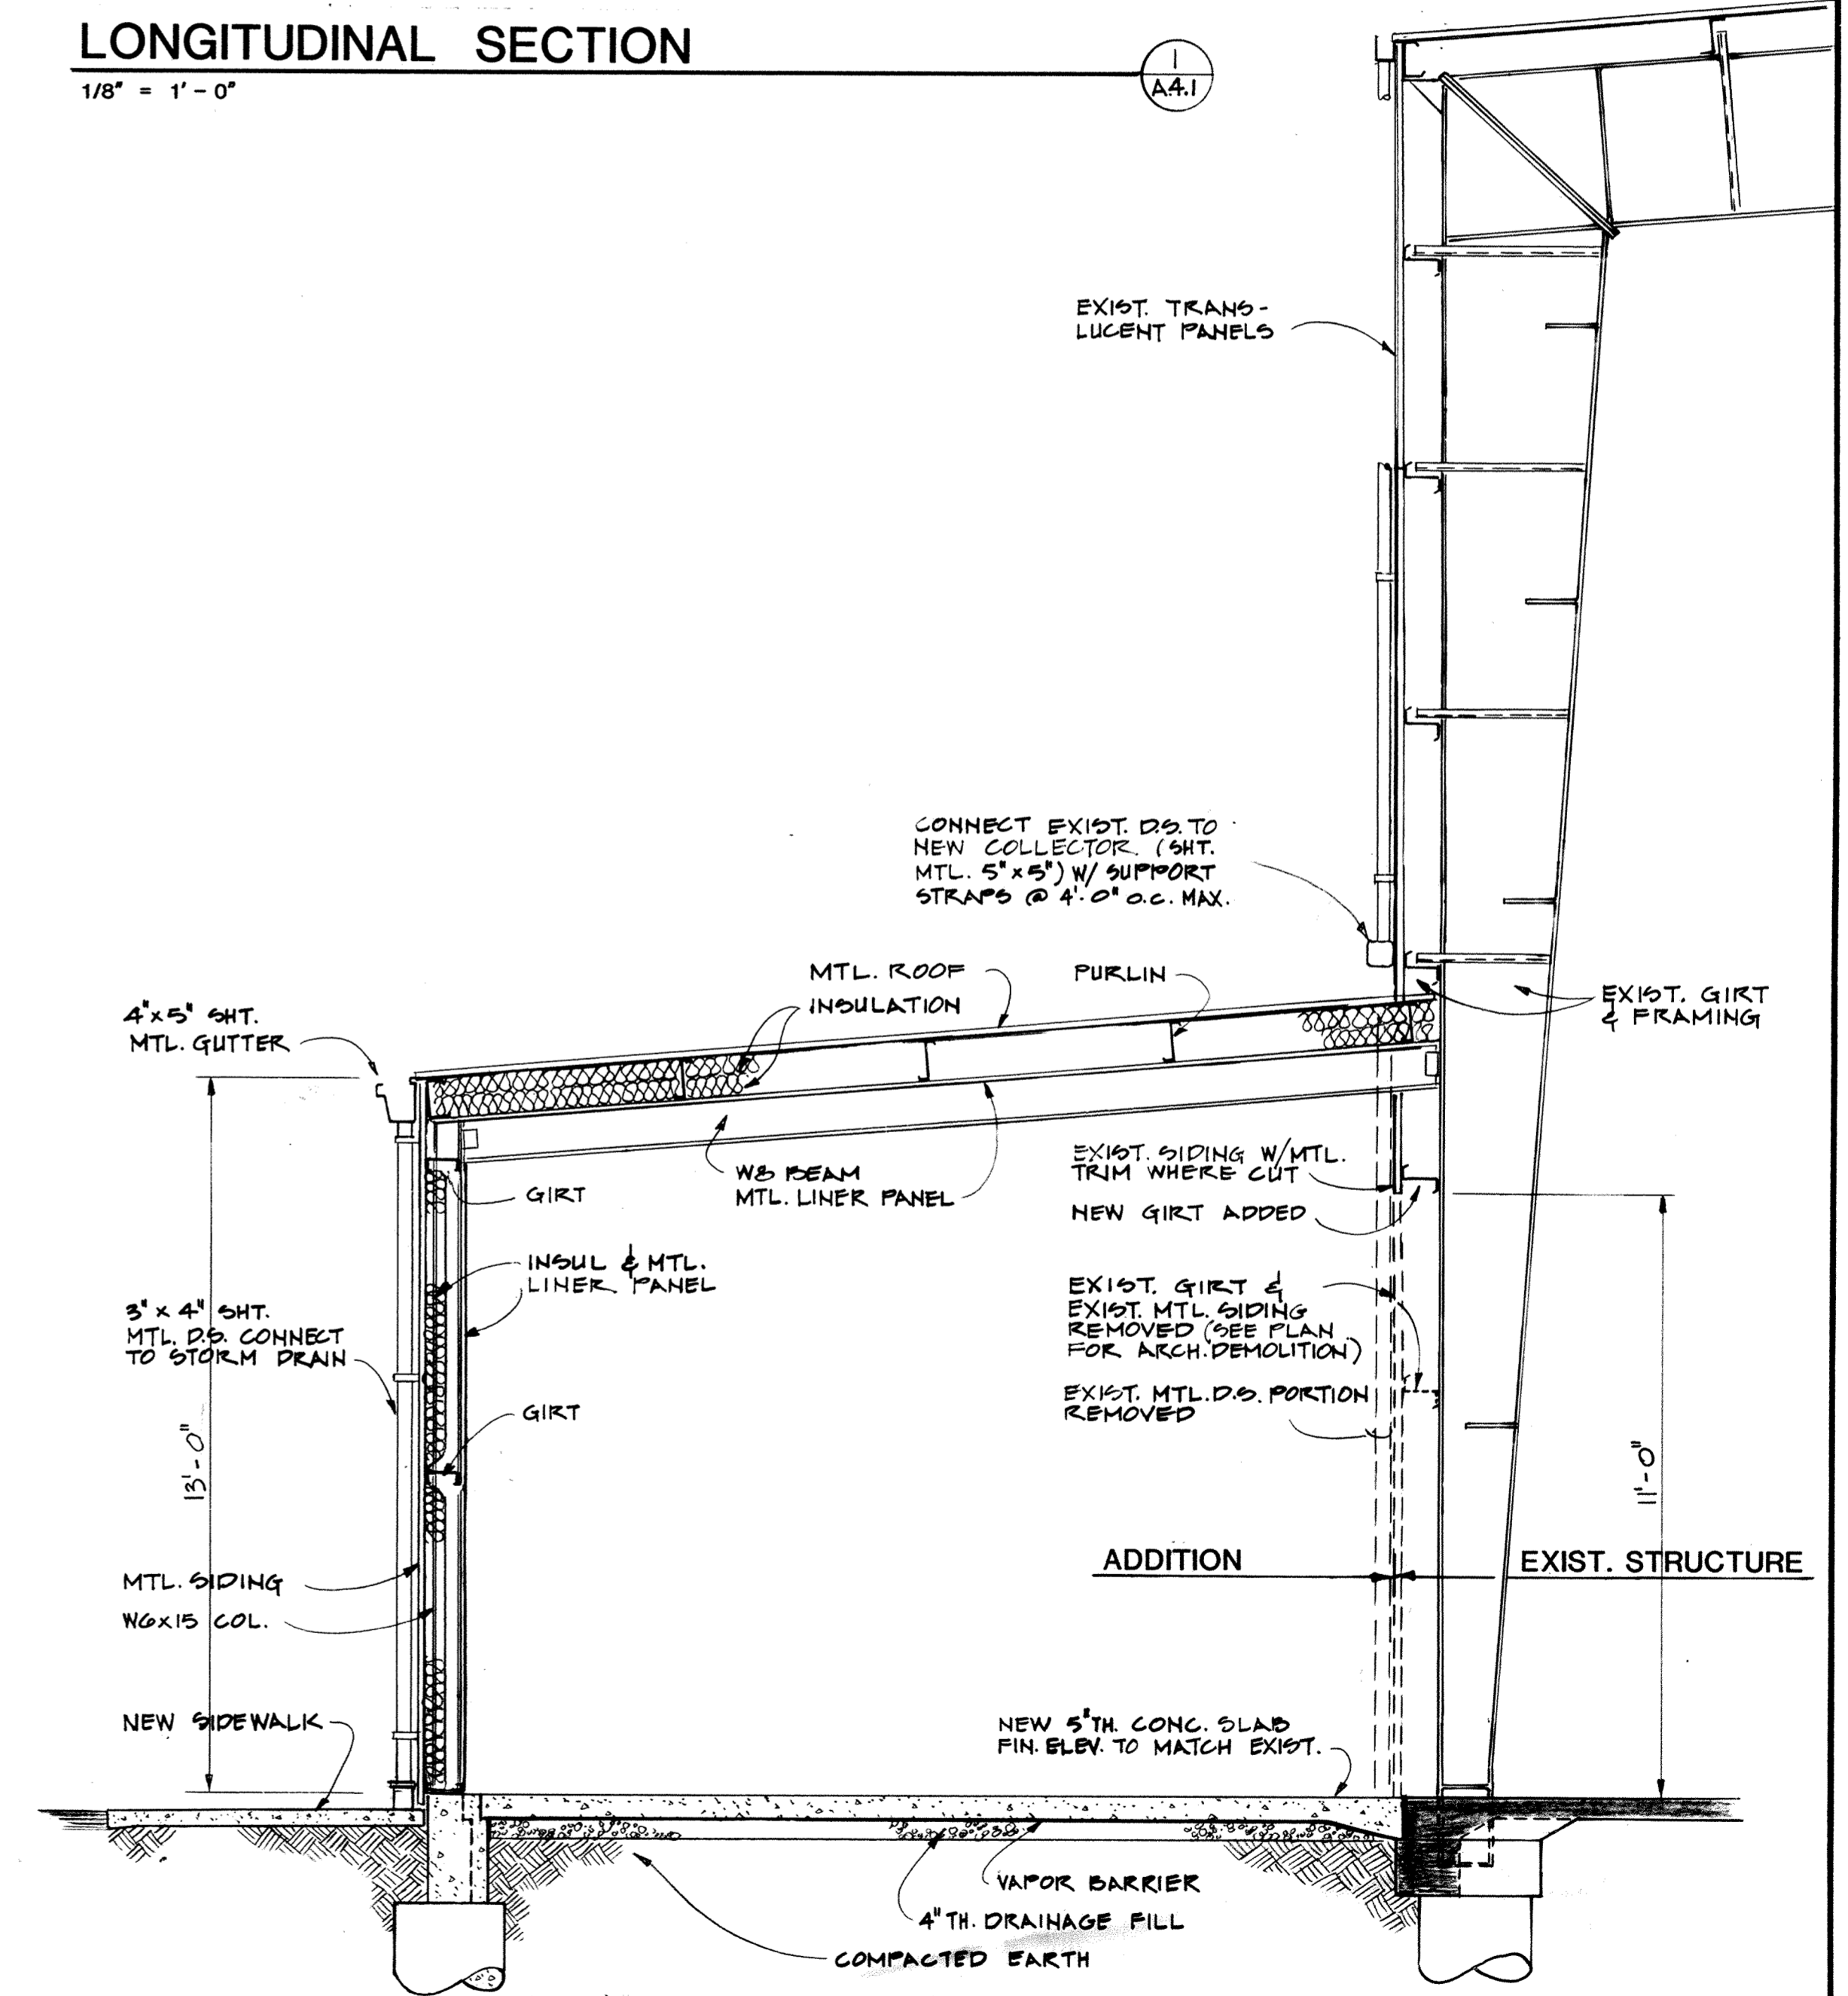

SECTION THRU ADDITION
3/8" = 1'-0"

2
A4.1

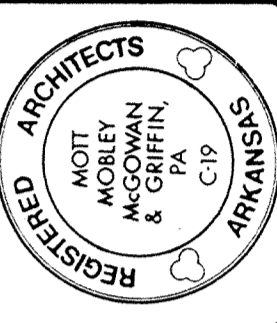

MM MG
Mott Mobley McGowan & Griffin, P.A.: Architects
302 North Sixth Street
Fort Smith, Arkansas 72901

CONTRACT NO. DAH408-87-D-0011 / 800Z

PROJECT NO. HKRZ - 001274
ADAL ENGINE I & R SHOP
AIR NATIONAL GUARD TRAINING FACILITY
MUNICIPAL AIRPORT - FT. SMITH, ARKANSAS

BLDG. ELVS. & THRU-SECTS.

| | |
|-------------|------|
| Revisions | |
| 1370A | A4.1 |
| Plan Number | |
| 11-2-88 | |
| Date | |