
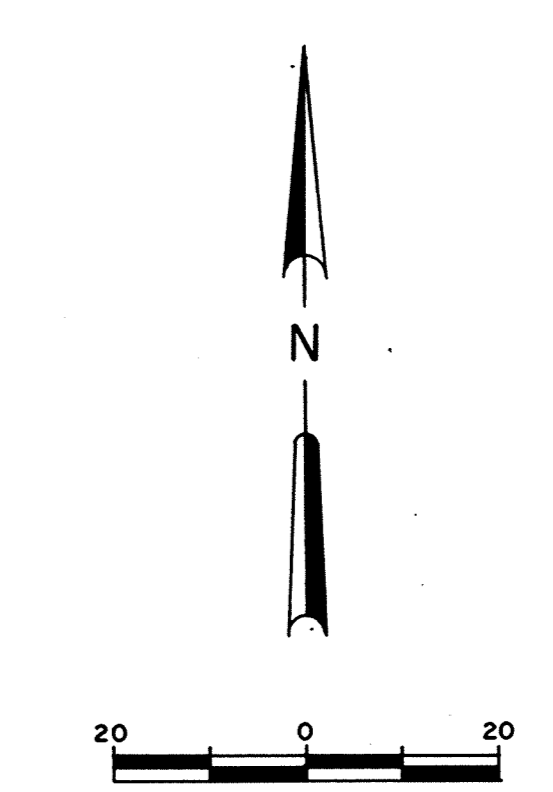




T.B.M. EL=60.85. SET NAIL ON EAST SIDE OF POWER POLE 1'-0" ABOVE GRADE

LIMITS OF PAVEMENT REMOVAL & REPLACEMENT

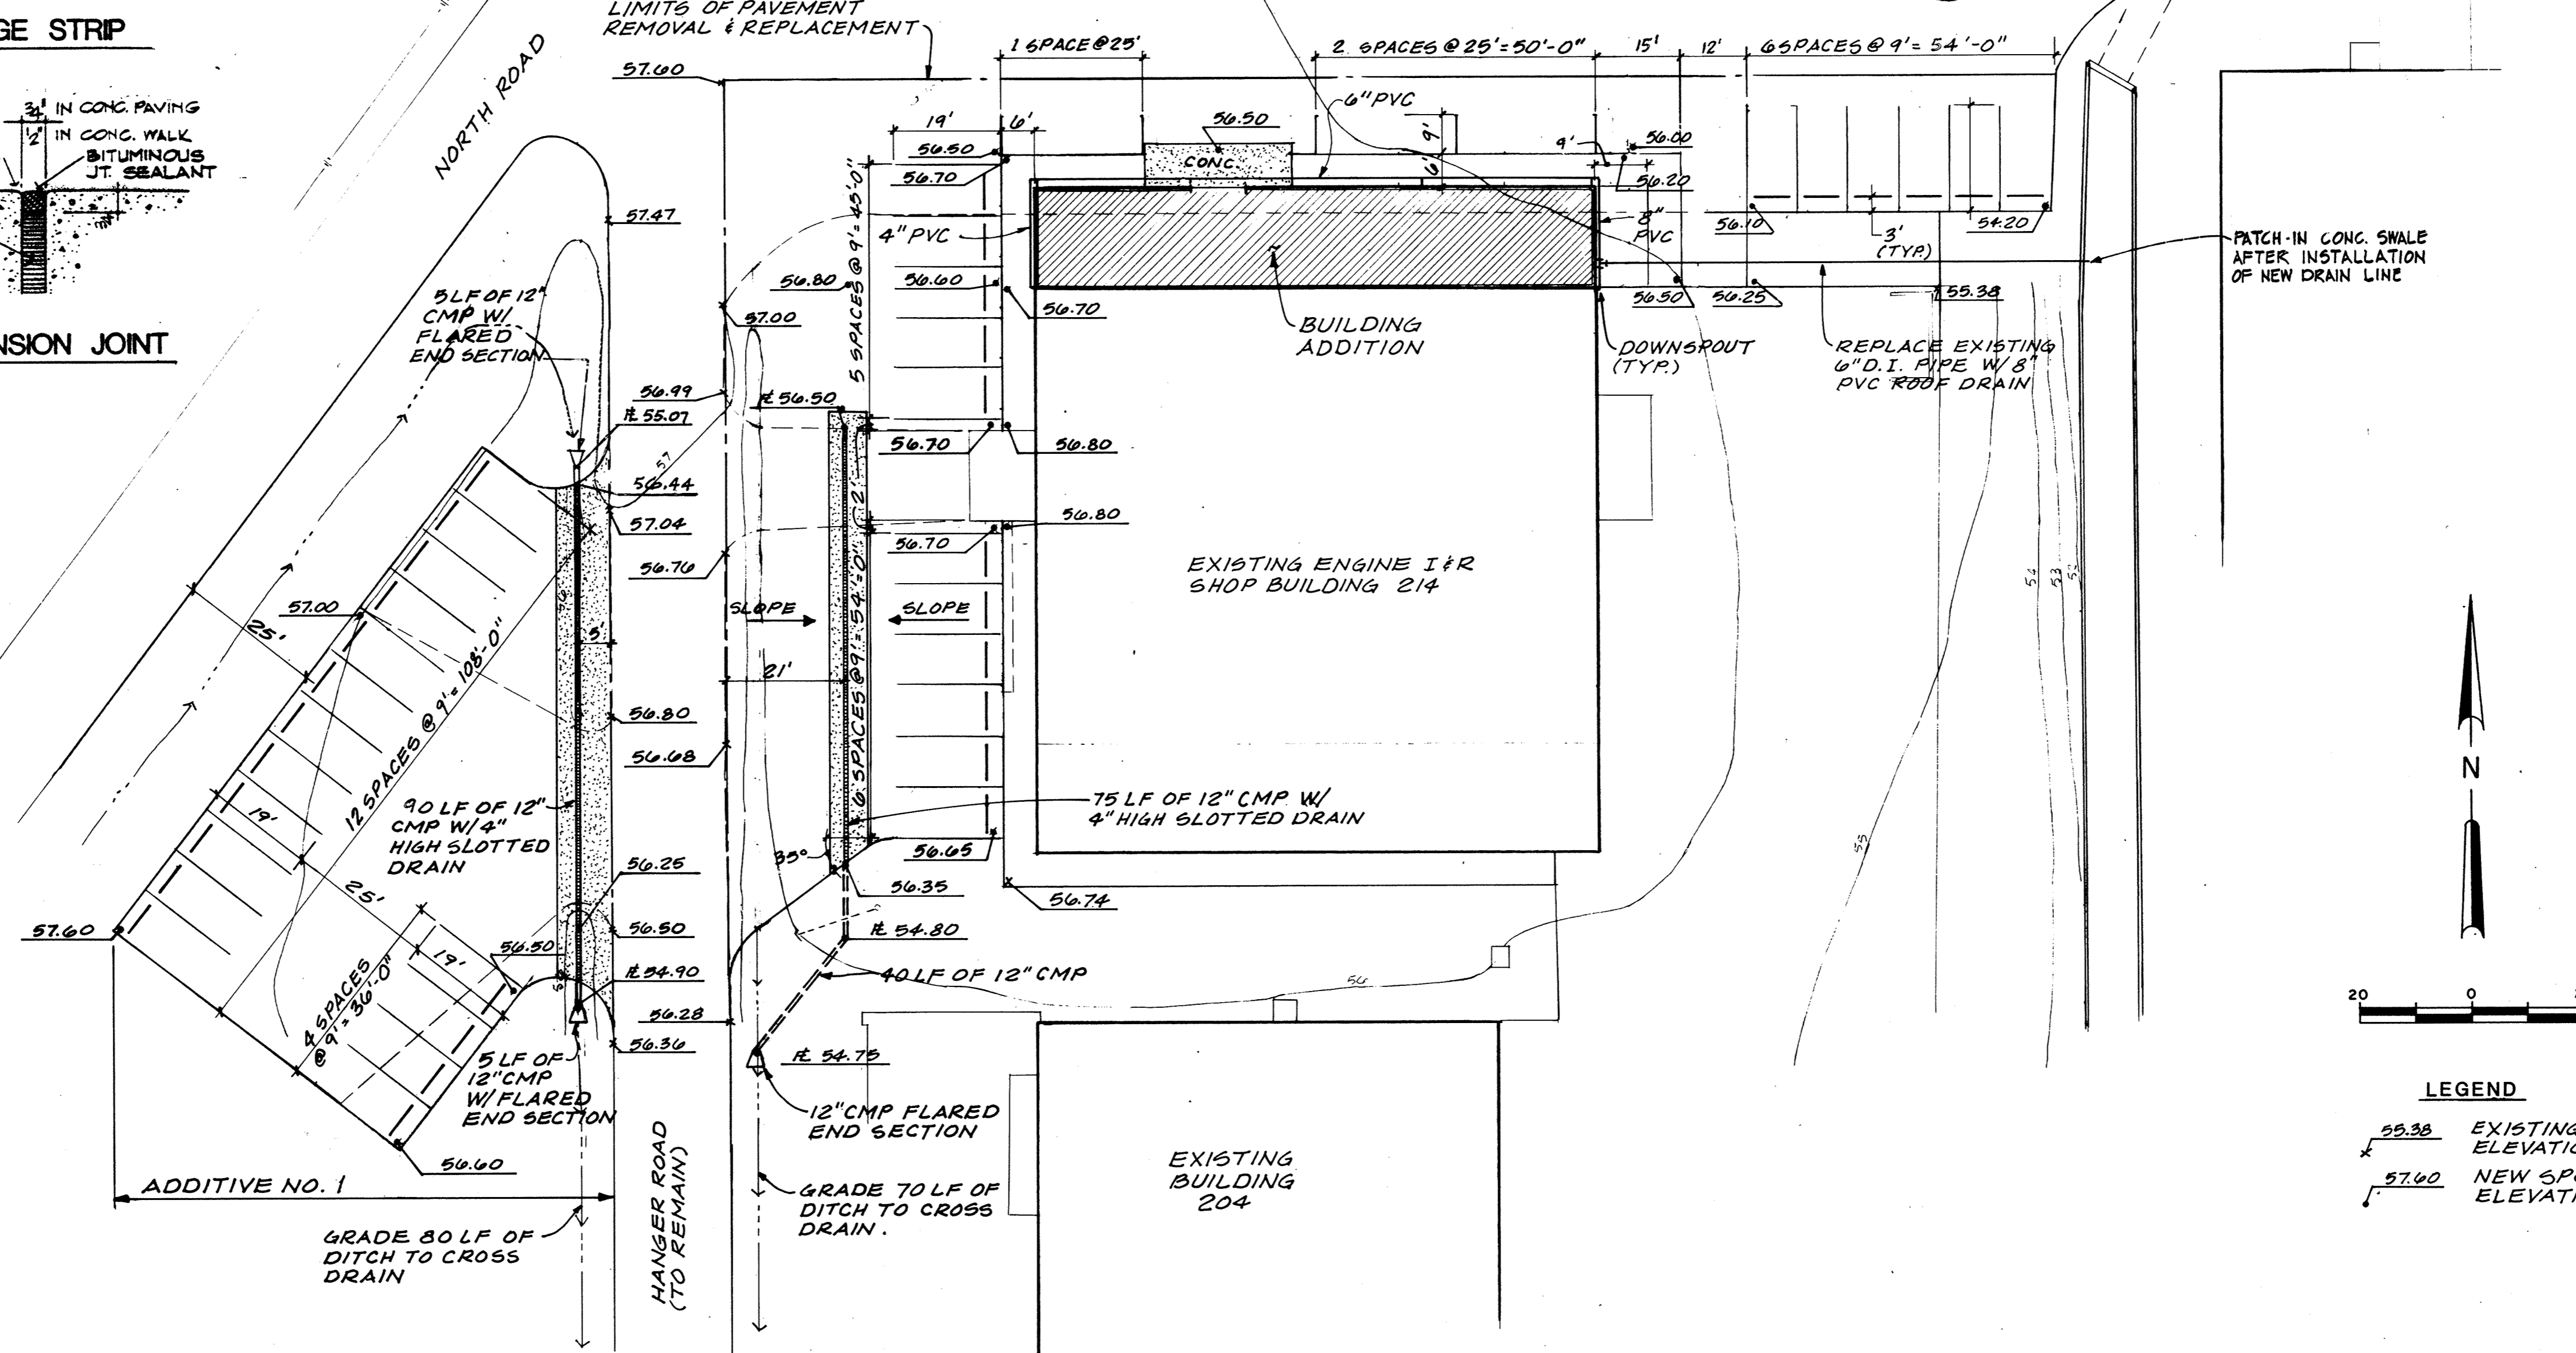

SITE PLAN
 1" = 20'-0"

MM MG
 Mott Mobley McGowan & Griffin, P.A.: Architects
 302 North Sixth Street
 Fort Smith, Arkansas 72901

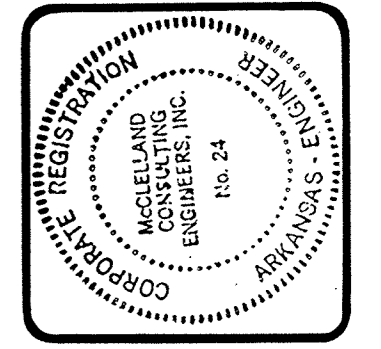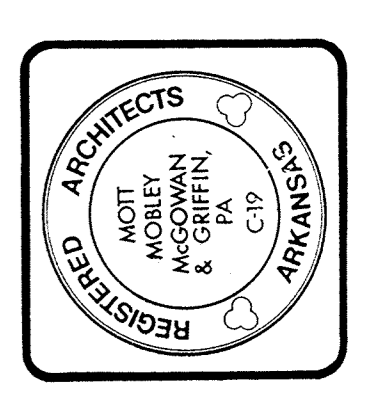

CONTRACT NO. DAH403-87-D-0011 / 9802

PROJECT NO. HKRZ - 001274

ADAL ENGINE I & R SHOP

AIR NATIONAL GUARD TRAINING FACILITY

MUNICIPAL AIRPORT - FT. SMITH, ARKANSAS

CIVIL SITE PLAN

Revisions	
1370A	C1.1
11-2-88	
Date	Of