

SYMBOLS LEGEND


- FLUORESCENT LIGHT FIXTURE
- INCANDESCENT LIGHT FIXTURE
- SUPPLY AIR GRILLE
- RETURN AIR GRILLE
- FIXTURE OR GRILLE TO BE REMOVED OR RELOCATED
- SPRINKLER HEAD

NOTE 1) NEW STUD PARTITIONS SHALL EXTEND FROM FLOOR TO CEILING ONLY WITH TOP RUNNER SECURED TO SUSPENDED CEILING GRID.


NOTE 2) NO ADDITIONAL CEILING WORK IS REQ'D IN EXISTING SPACES 1, 4, 5, 6, 7, 8, 9, 10, 15, 16, 23, 24, 25, 26, & 29.

REFLECTED CEILING PLAN

1/8" = 1'-0"

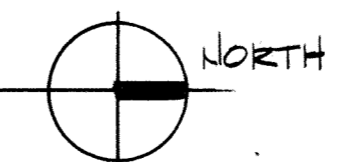

1 CEILING DETAIL AT ELEC. BUS SUPPORT
FULL SCALE

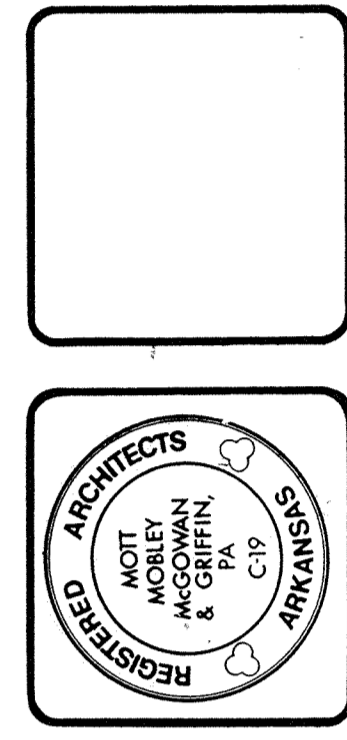

CONTRACT NO. DAHAG3 - 87 - C - 0007
PROJECT NO. FSM-40997
ADD./ALTER AVIONICS/ECM POD SHOP/STORAGE
AIR NATIONAL GUARD TRAINING FACILITY
MUNICIPAL AIRPORT - FT. SMITH, ARKANSAS

REFLECTED
CEILING PLAN

As-built info: 4-12-90 ①	A5.1
Revisions	
1357 Plan Number	or 28
11-16-88 Date	