




EAST ELEVATION
1/8" = 1'-0"

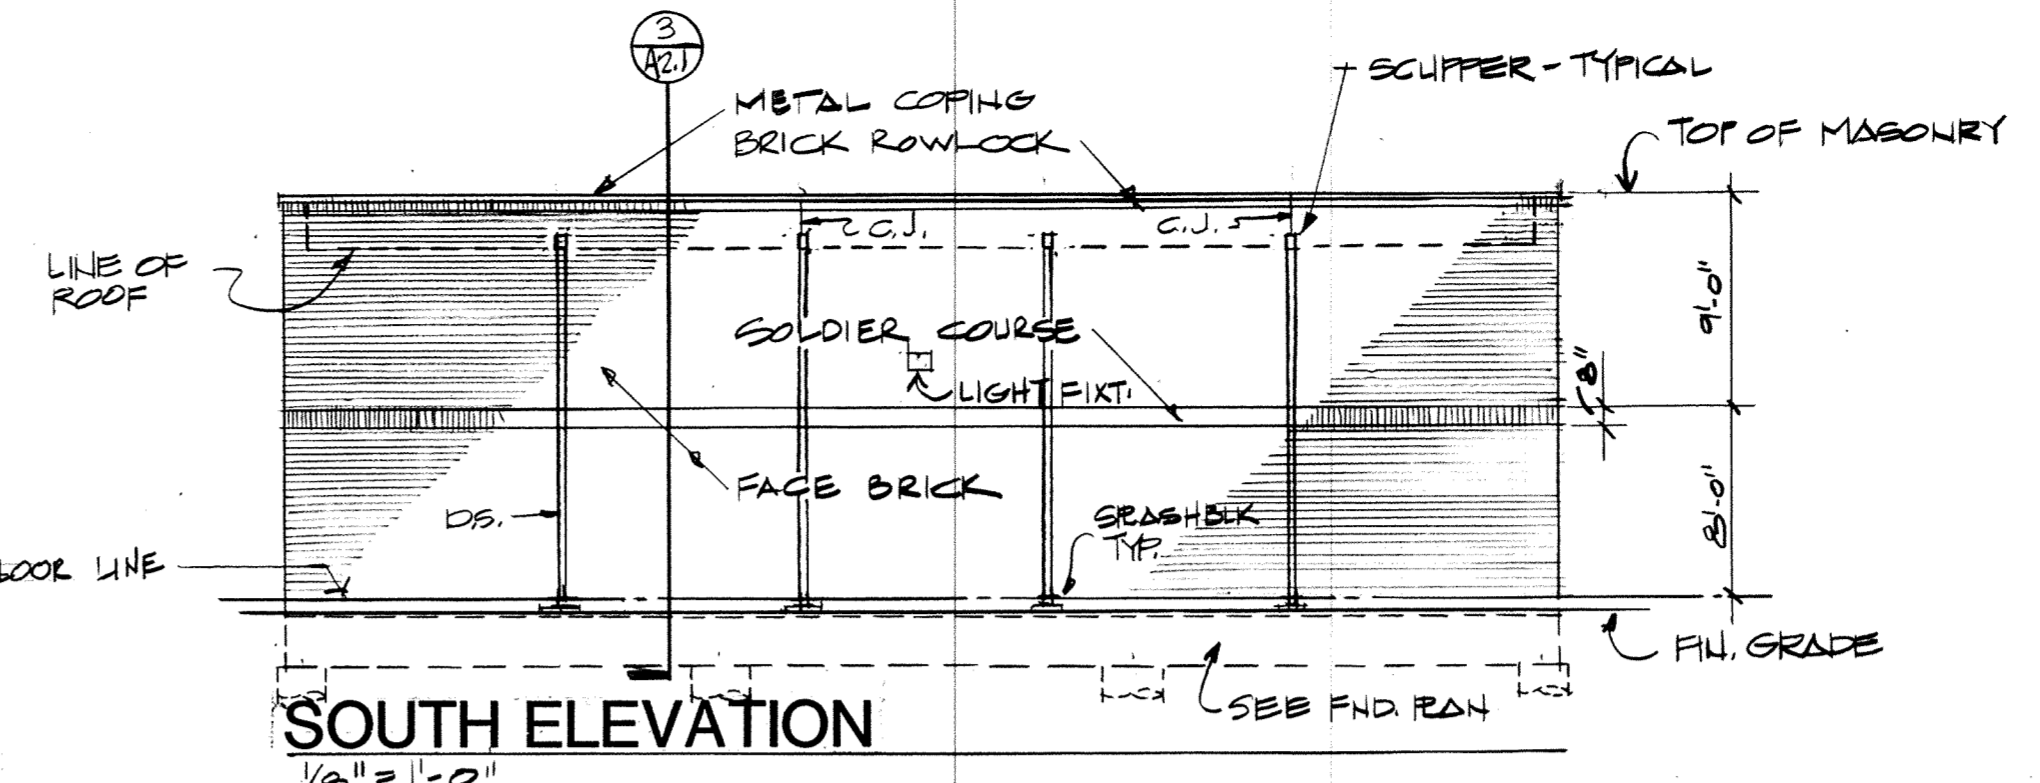


SOUTH ELEVATION
1/8" = 1'-0"

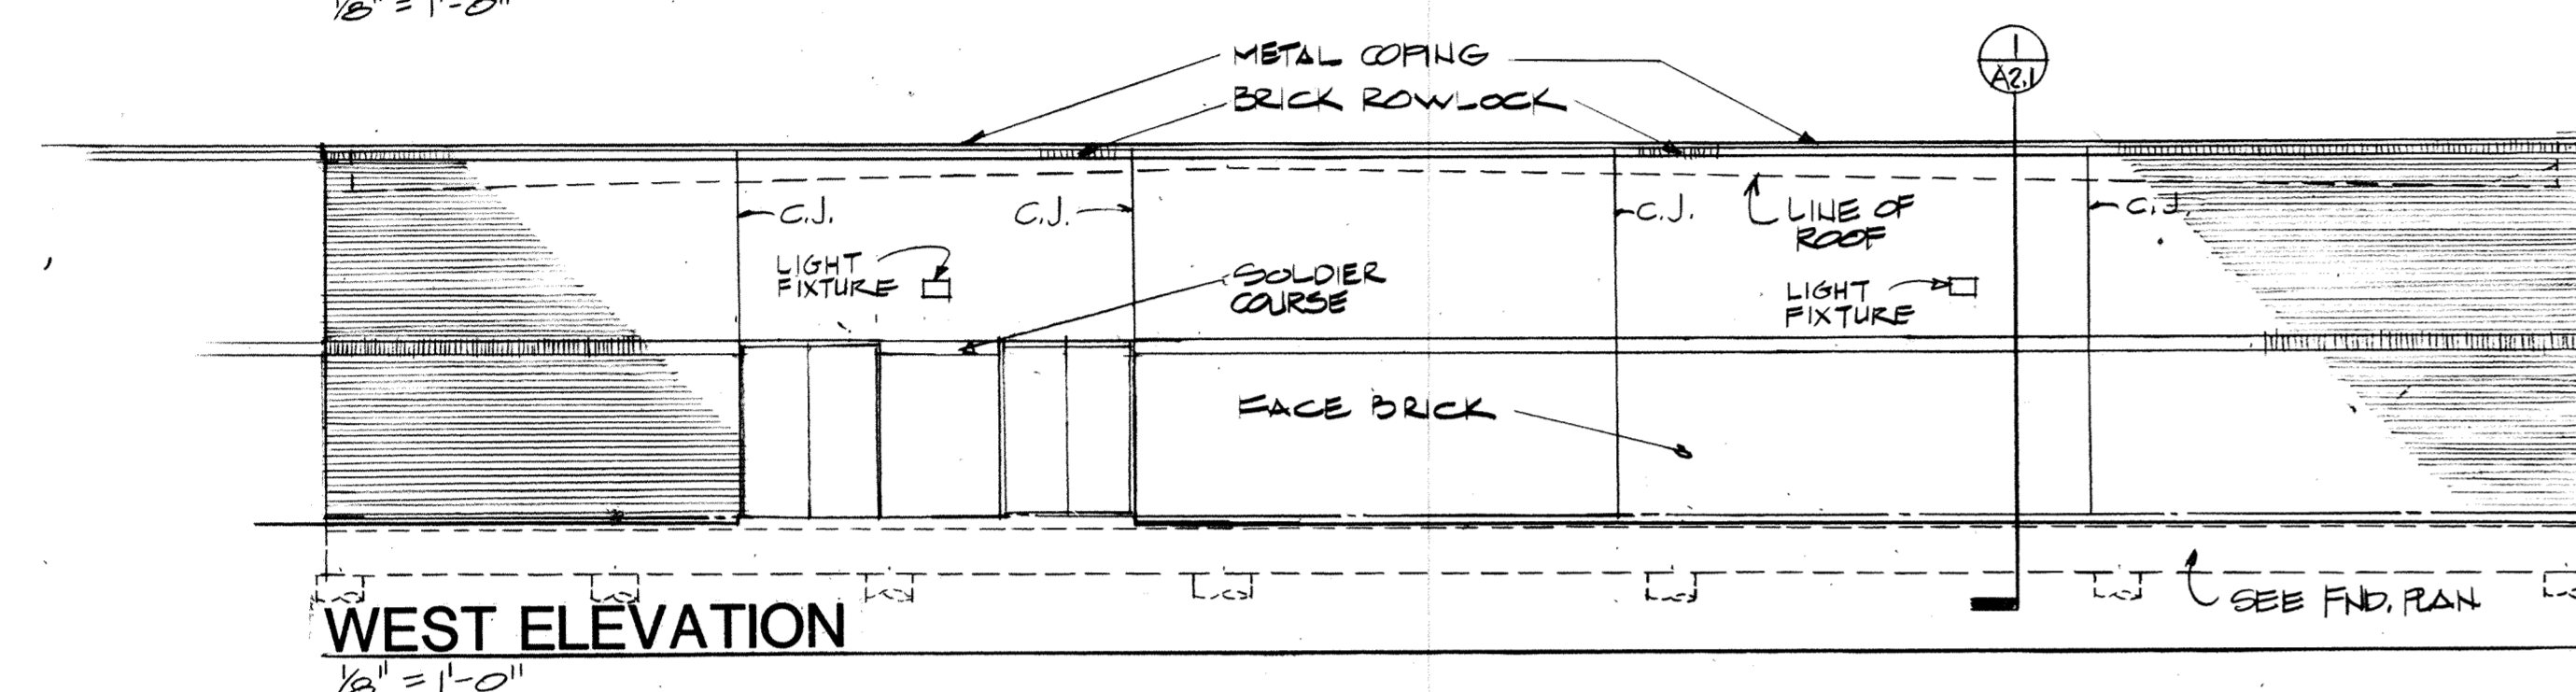


WEST ELEVATION
1/8" = 1'-0"

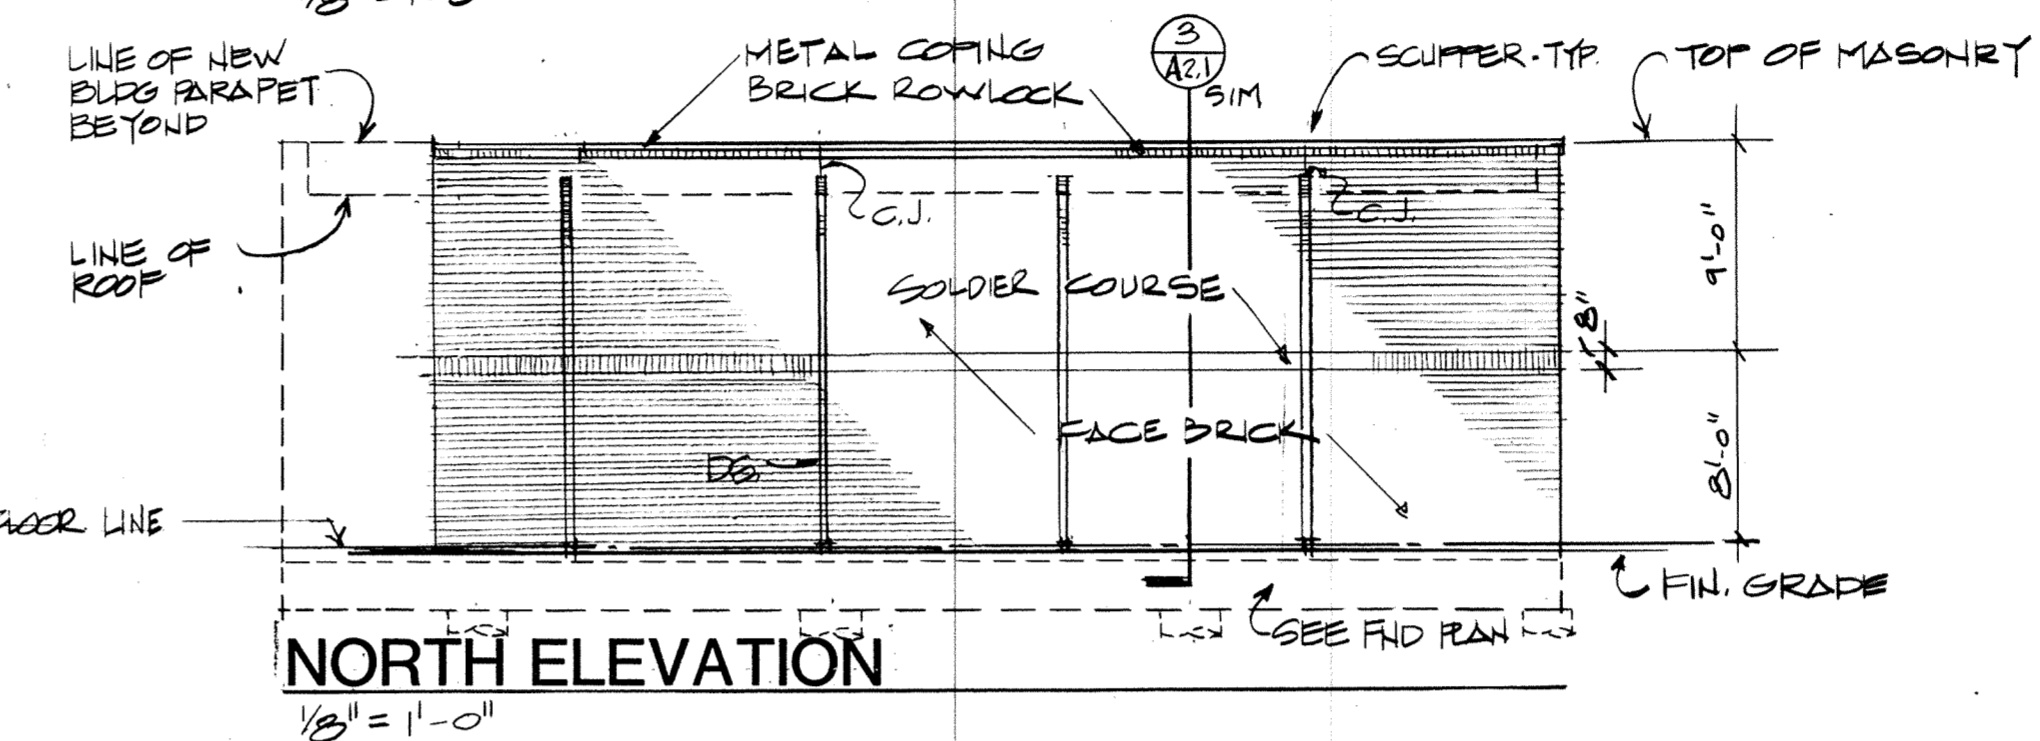


NORTH ELEVATION
1/8" = 1'-0"

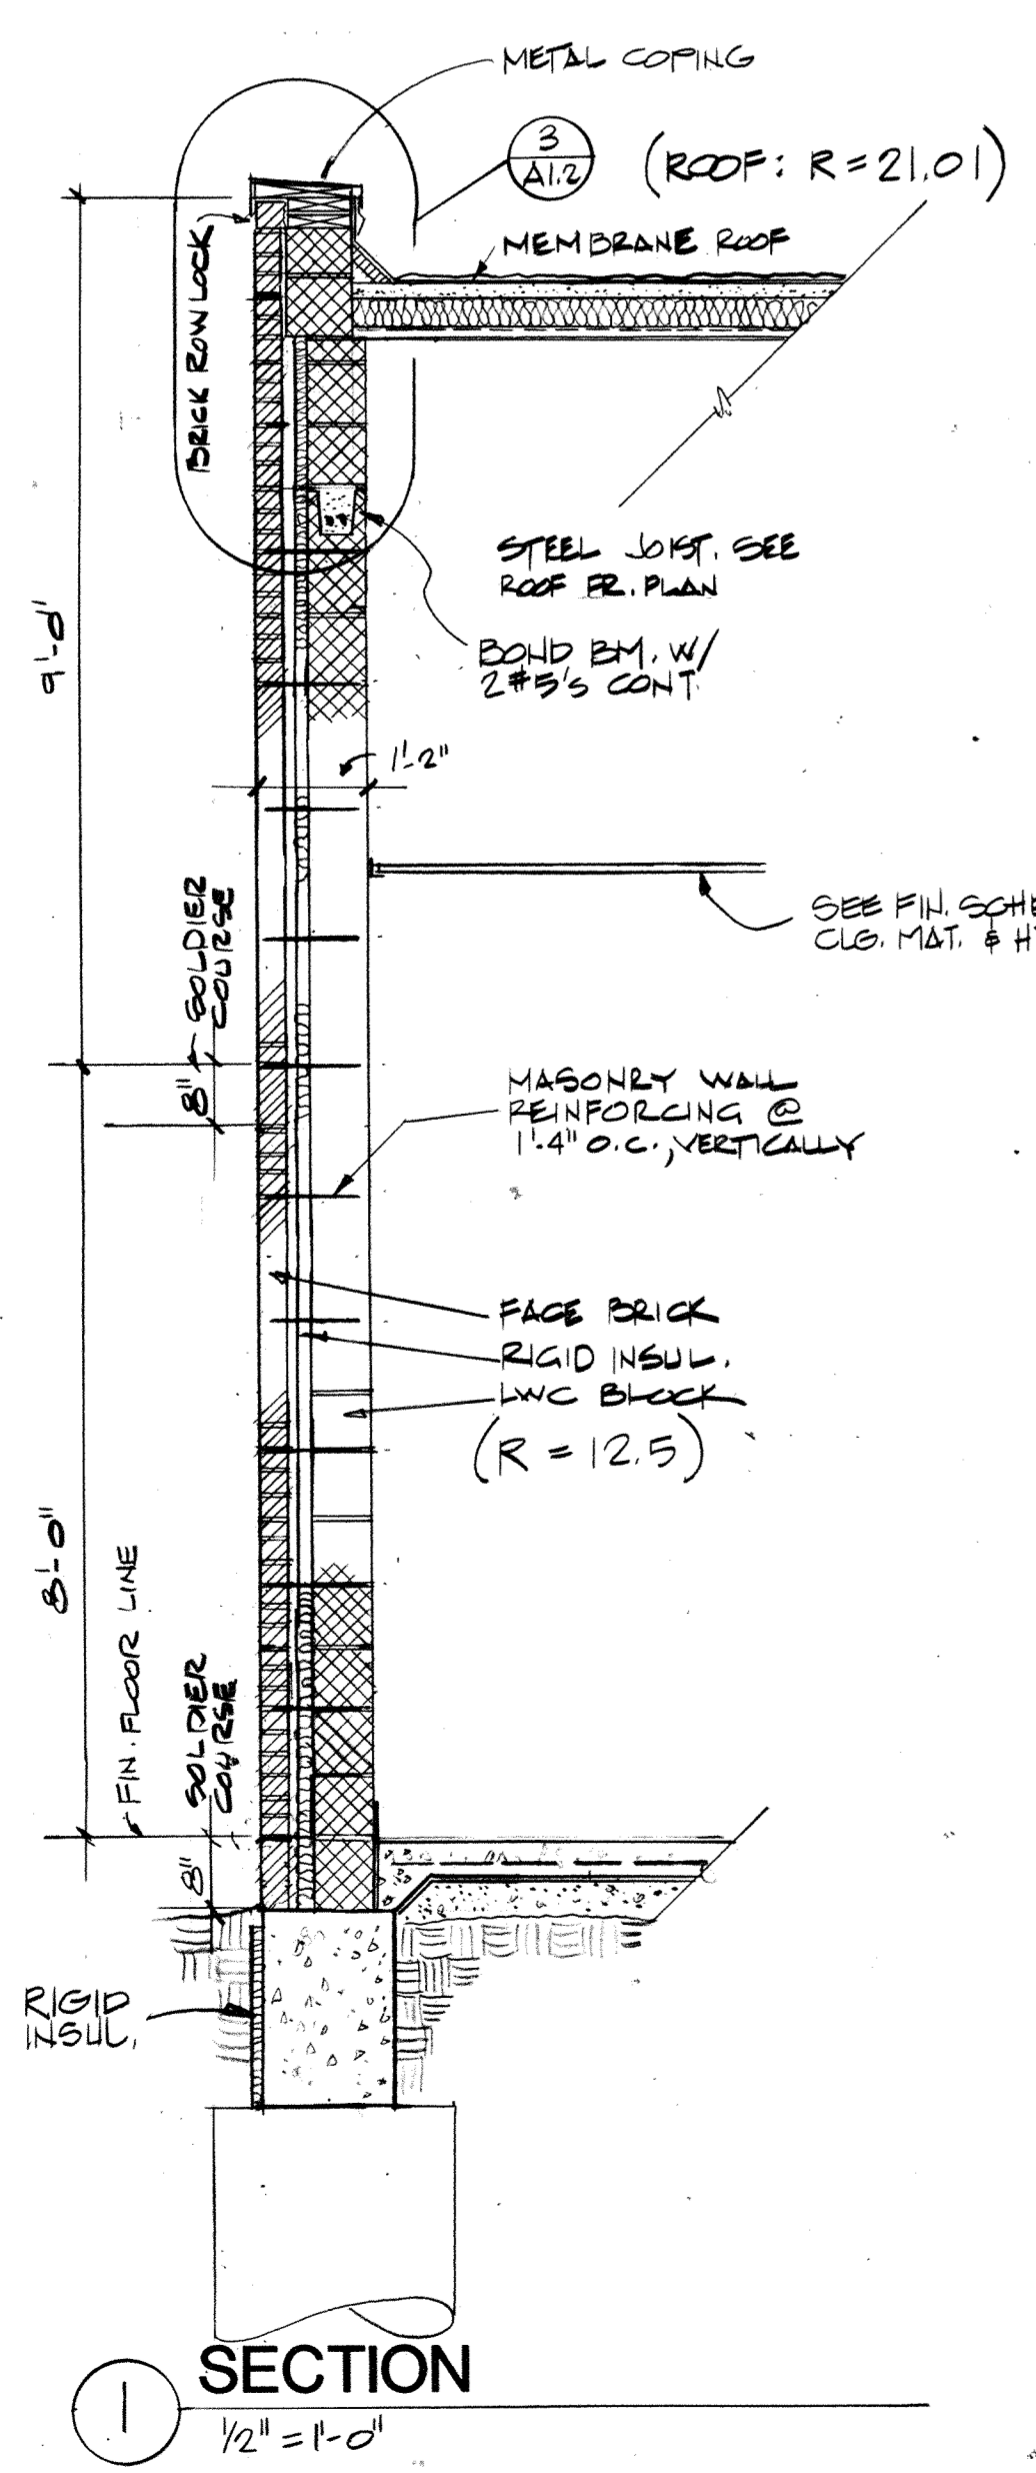


SECTION 1
1/2" = 1'-0"

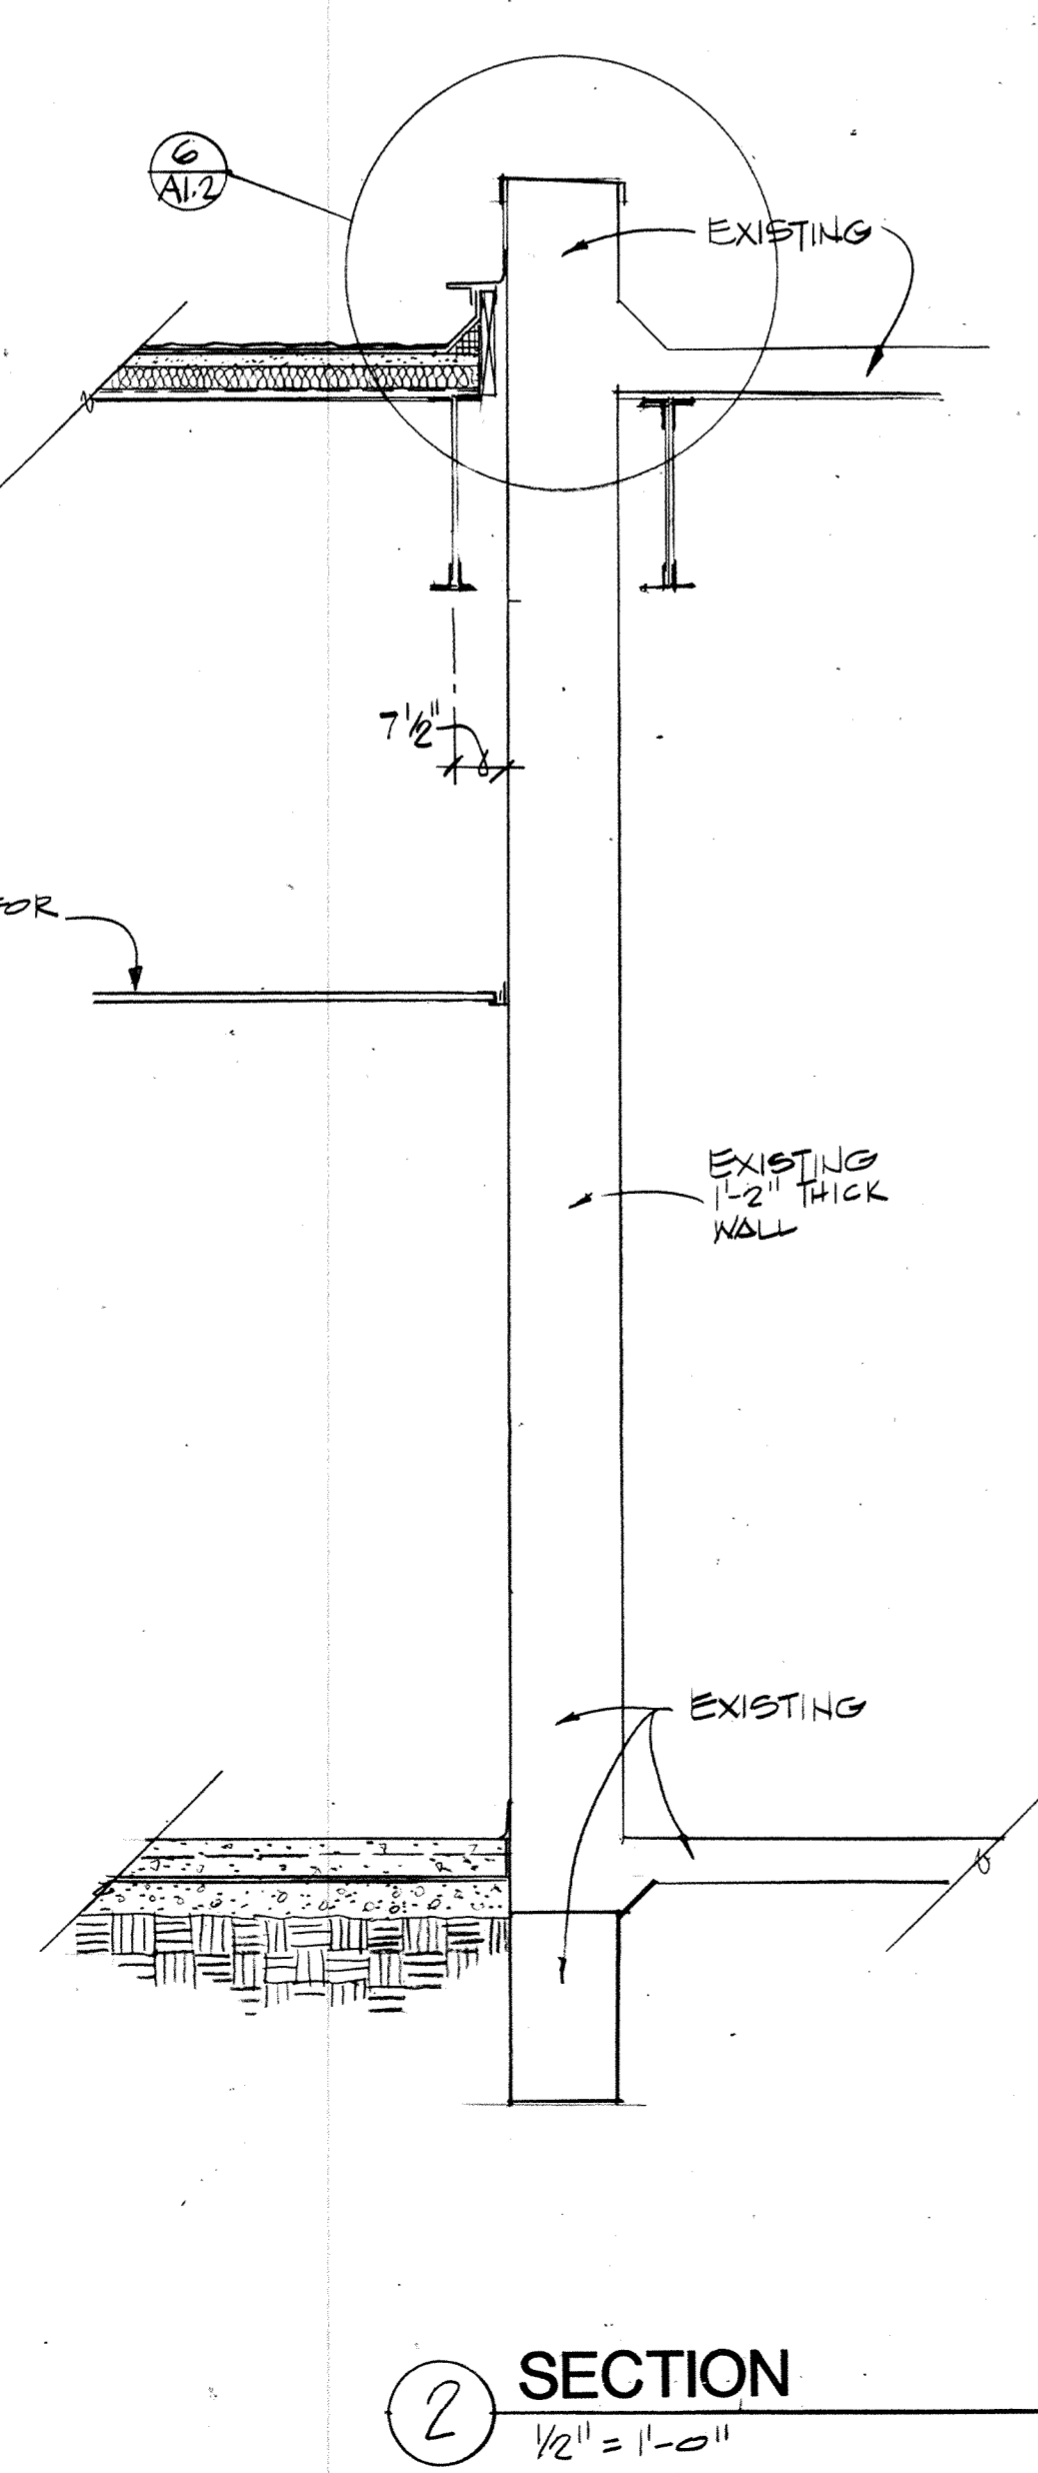

SECTION 2
1/2" = 1'-0"

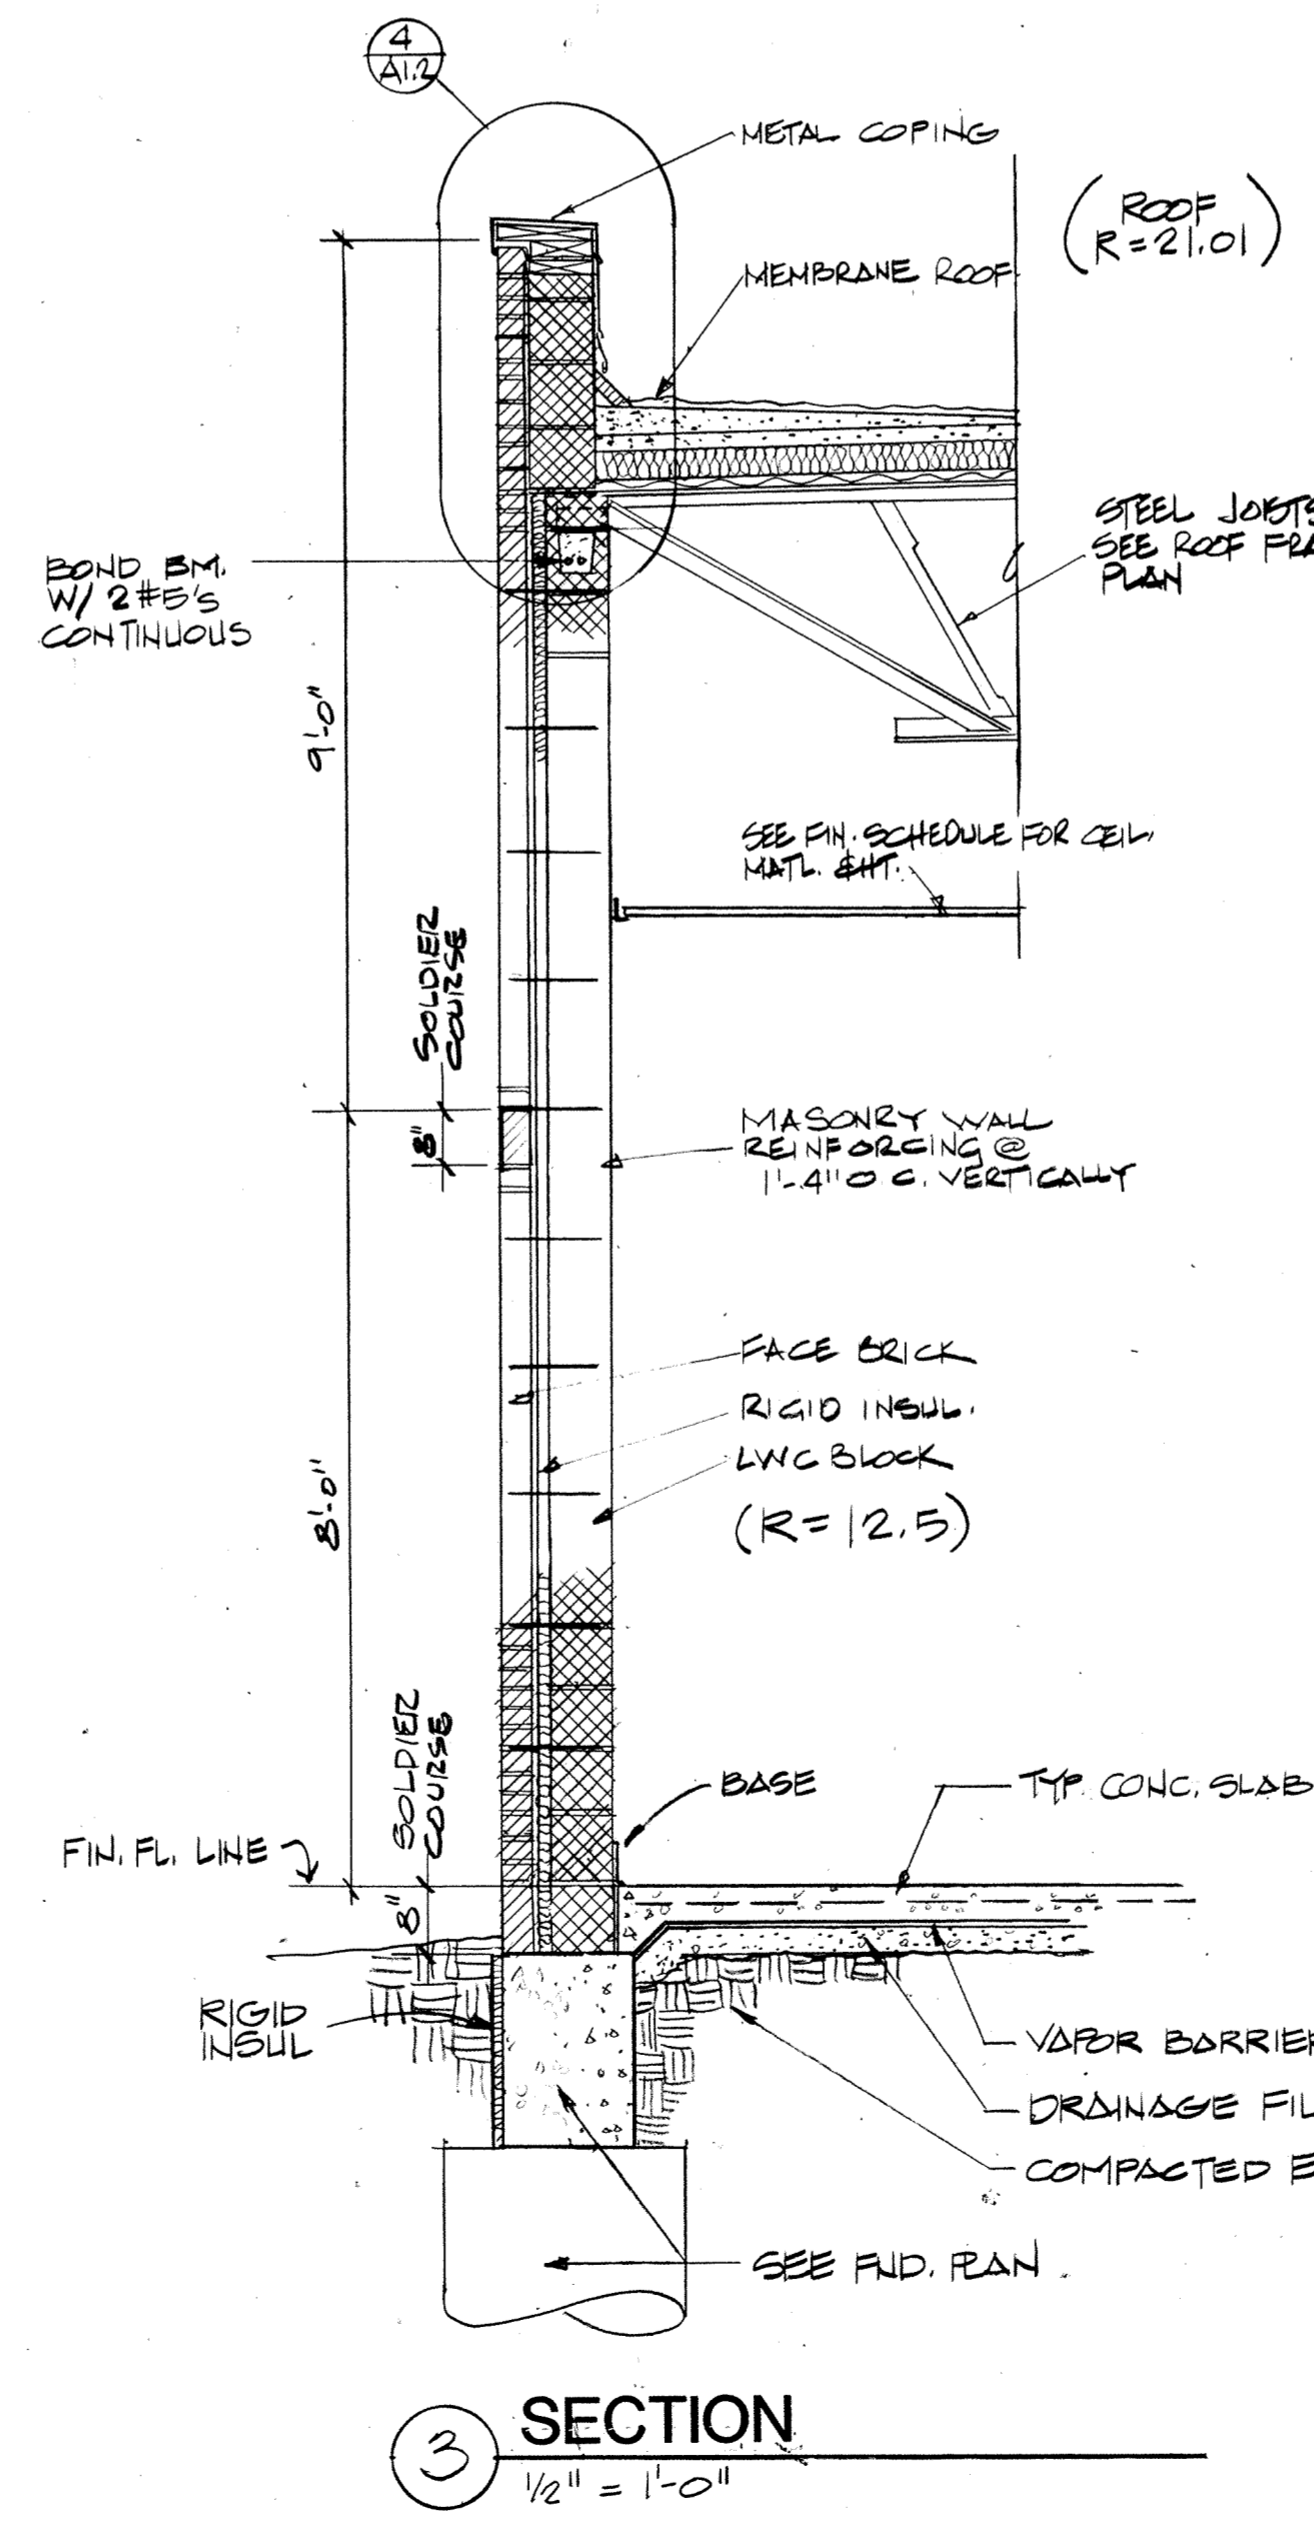


SECTION 3
1/2" = 1'-0"

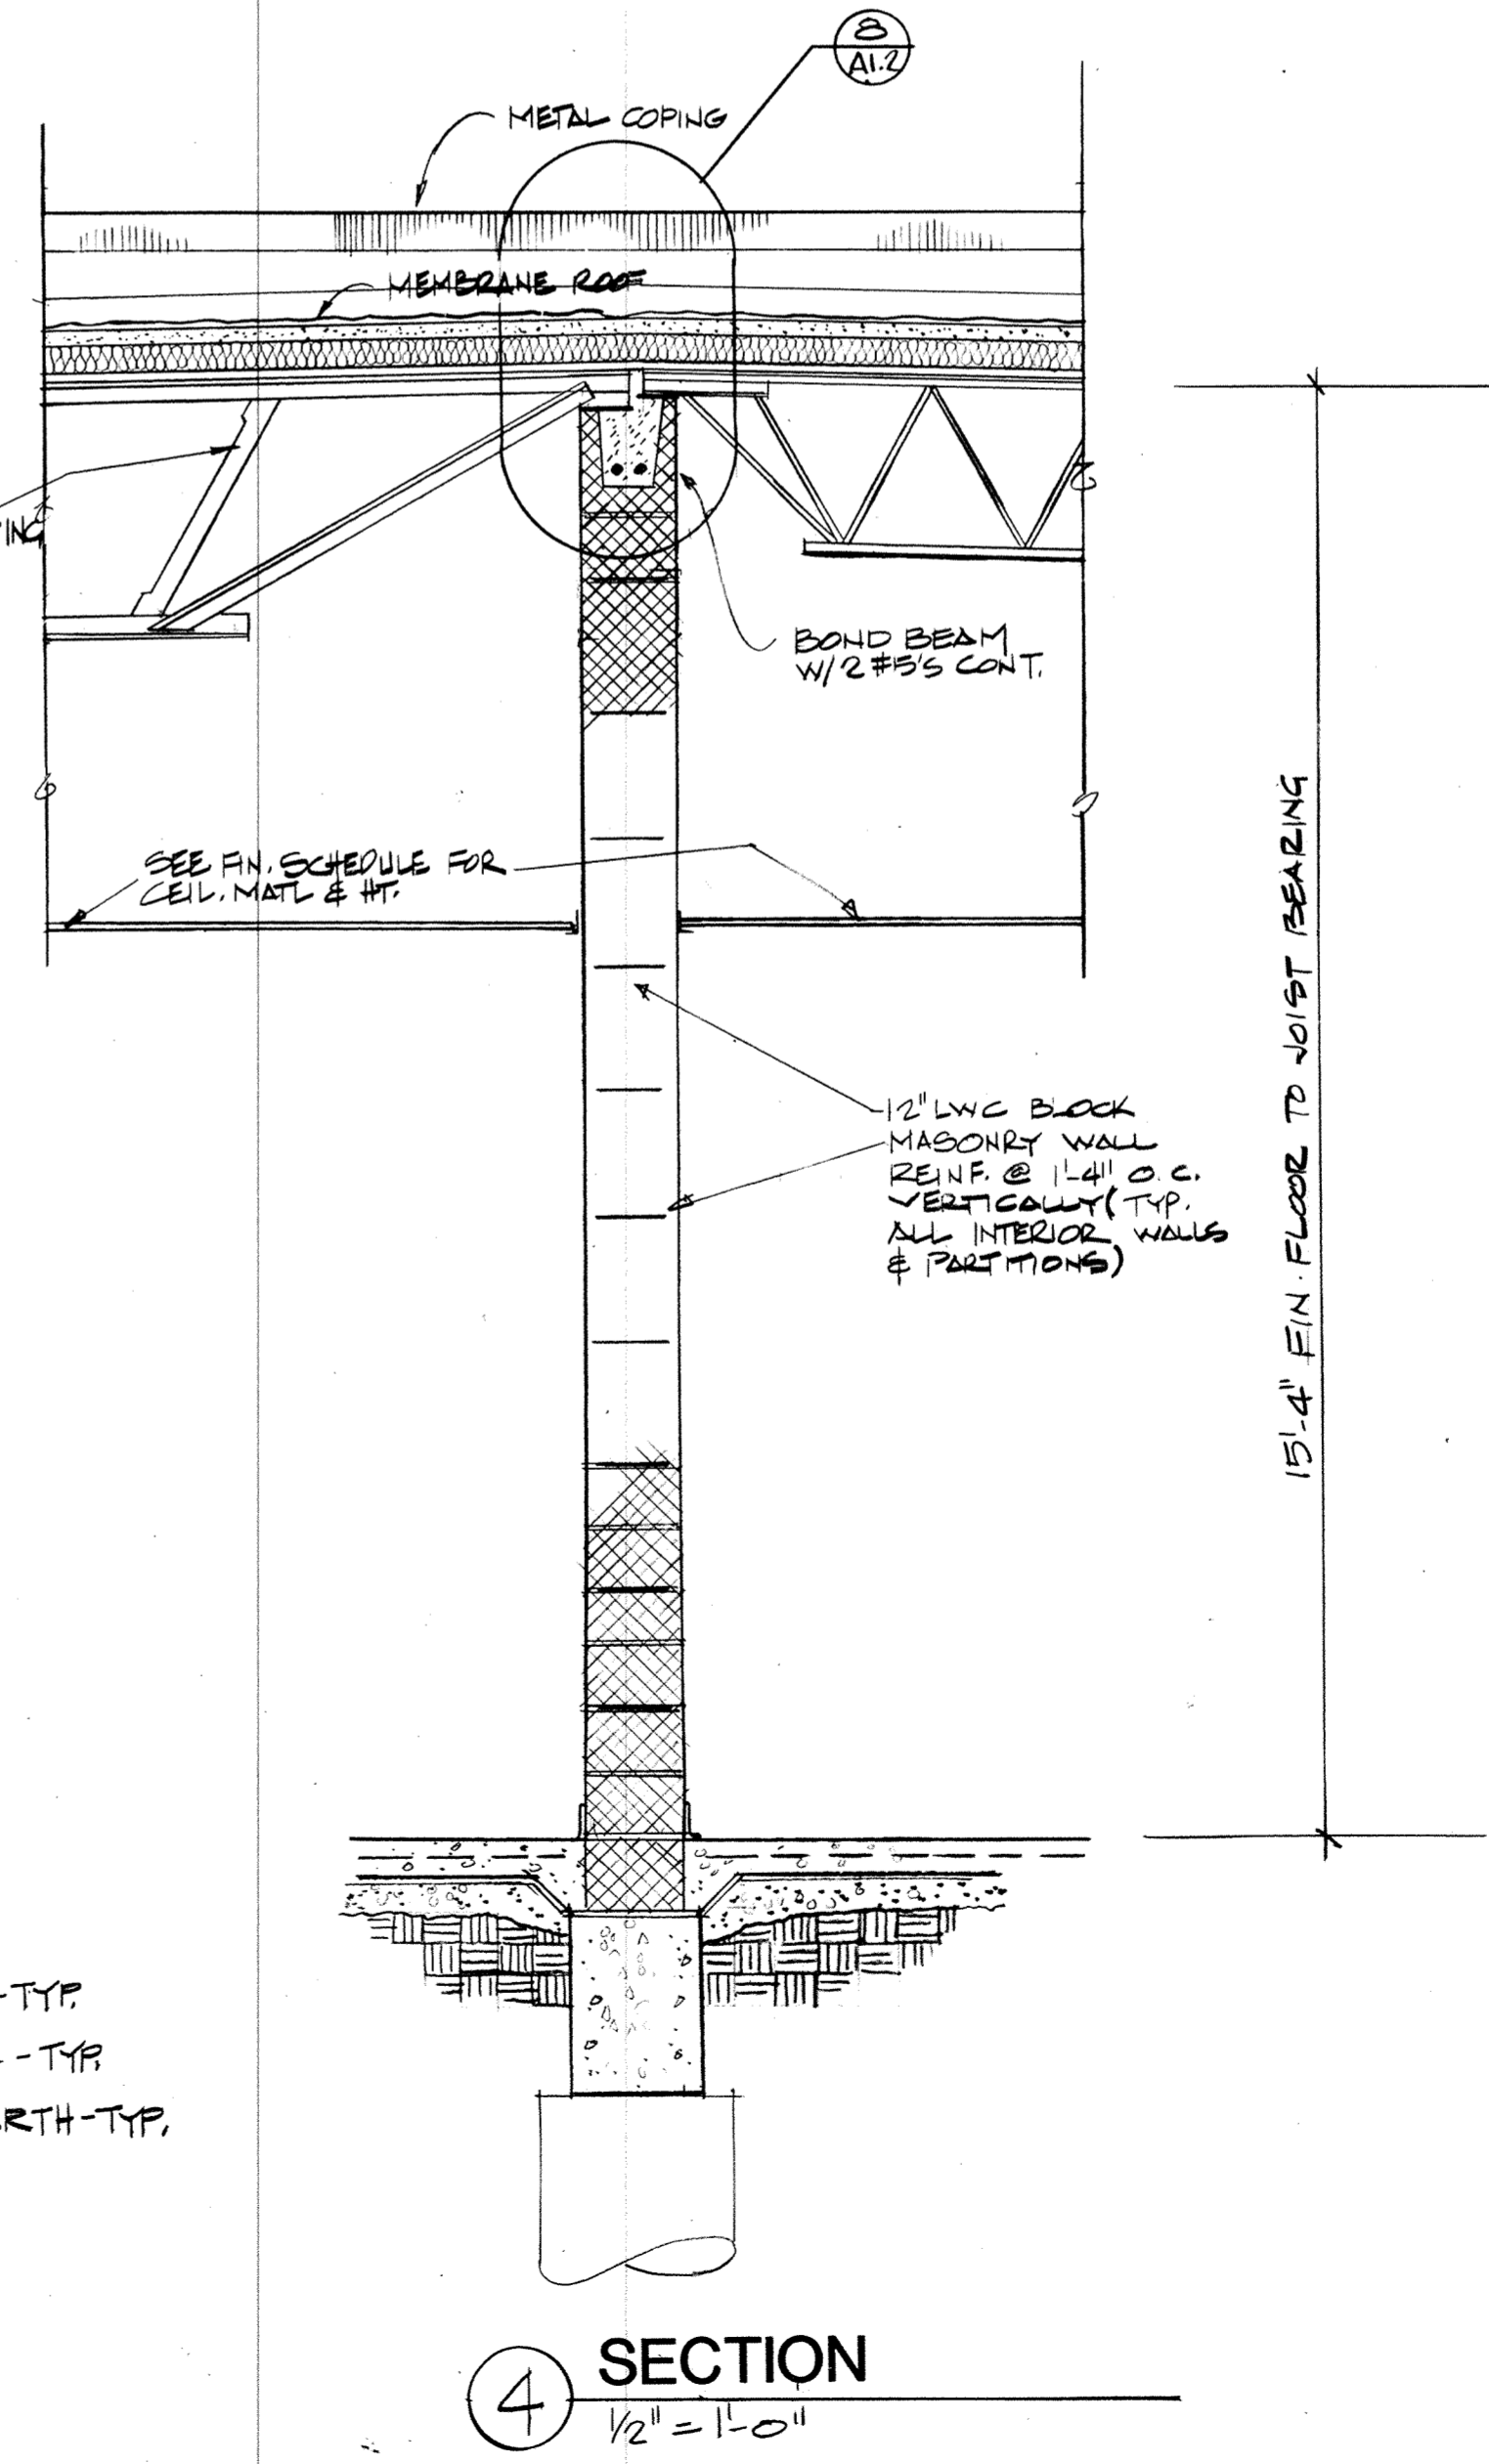

SECTION 4
1/2" = 1'-0"

DRAWING 40-27 85501

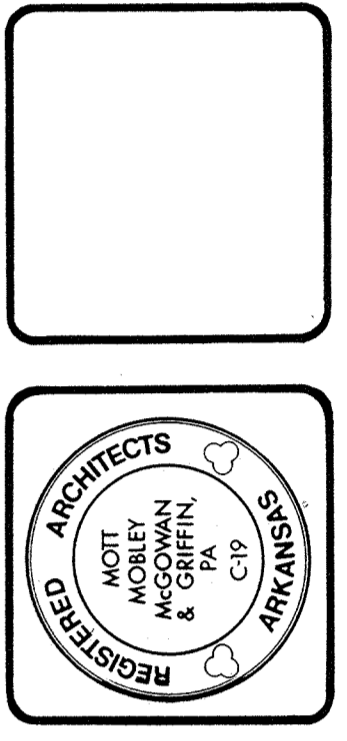

CONTRACT NO. DAH403-87-C-0007
PROJECT NO. FSM-40997
ADD./ALTER AVIONICS/ECM POD SHOP/STORAGE
AIR NATIONAL GUARD TRAINING FACILITY
MUNICIPAL AIRPORT - FT. SMITH, ARKANSAS

ELEVATIONS & SECTIONS

Revisions	
1357	A2.1
11-16-88	Or 2B
Date	