





LKHG

LASER KNIGHT HATHAWAY & GUEST, P.A.
ARCHITECTS • ENGINEERS • HEALTH CARE PLANNERS
800 FIRST NATIONAL BANK • FORT SMITH, ARKANSAS

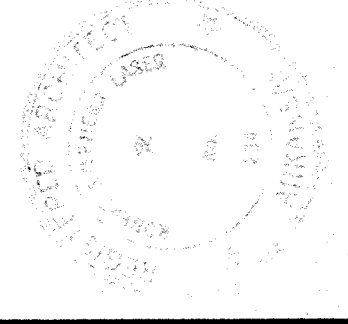


AVIONICS FACILITY
ARKANSAS AIR NATIONAL GUARD
FORT SMITH, ARKANSAS


ELEVATIONS, SECTIONS, DETAILS	
REVISIONS	
JOB NUMBER 1966	
DATE 2.9.77	
SHEET 3	CATEGORY A

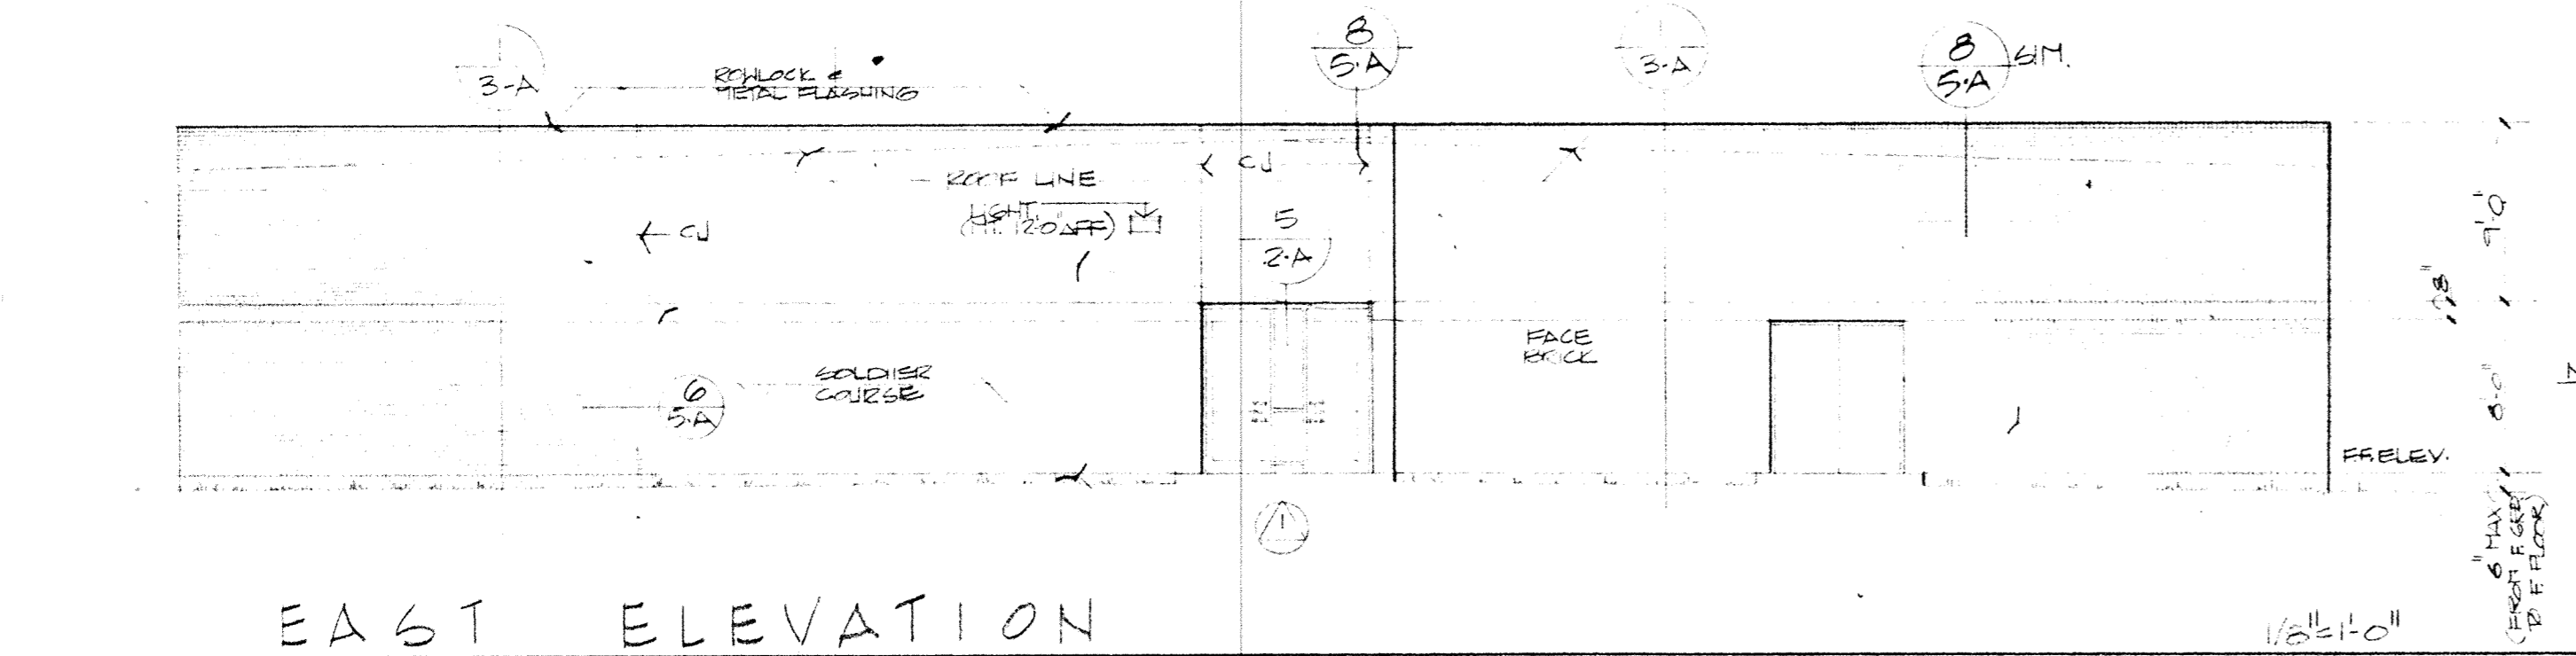


EAST ELEVATION 1/8"=1'-0"

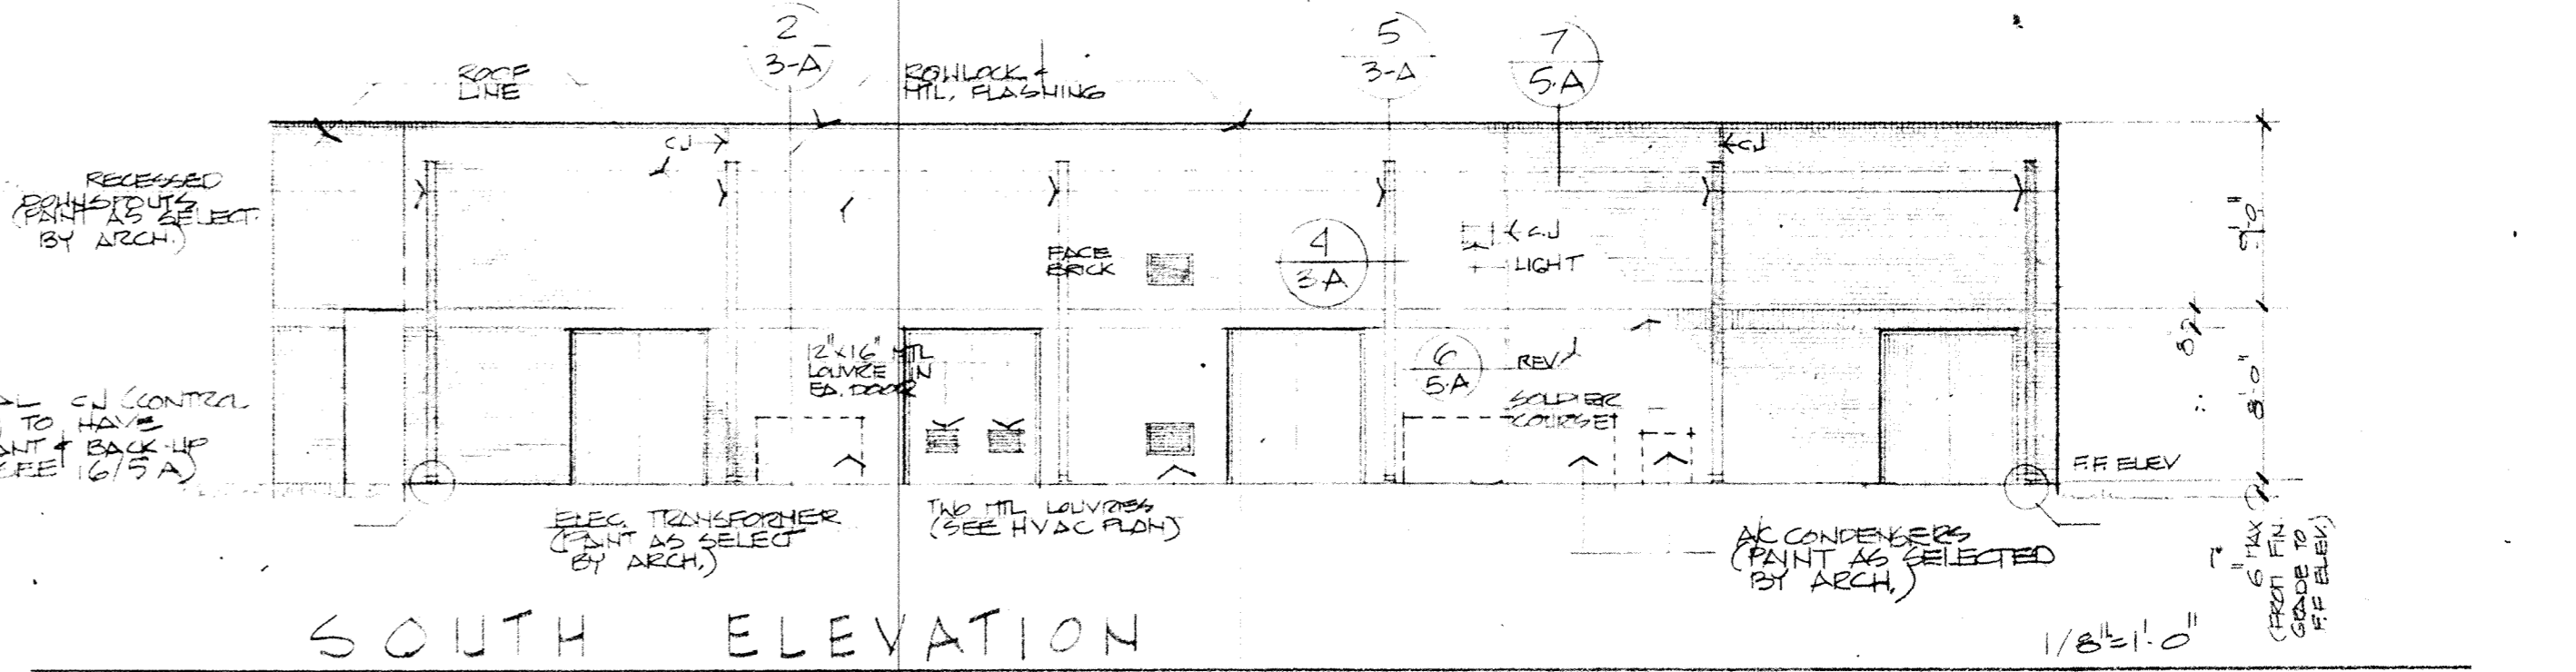


SOUTH ELEVATION 1/8"=1'-0"

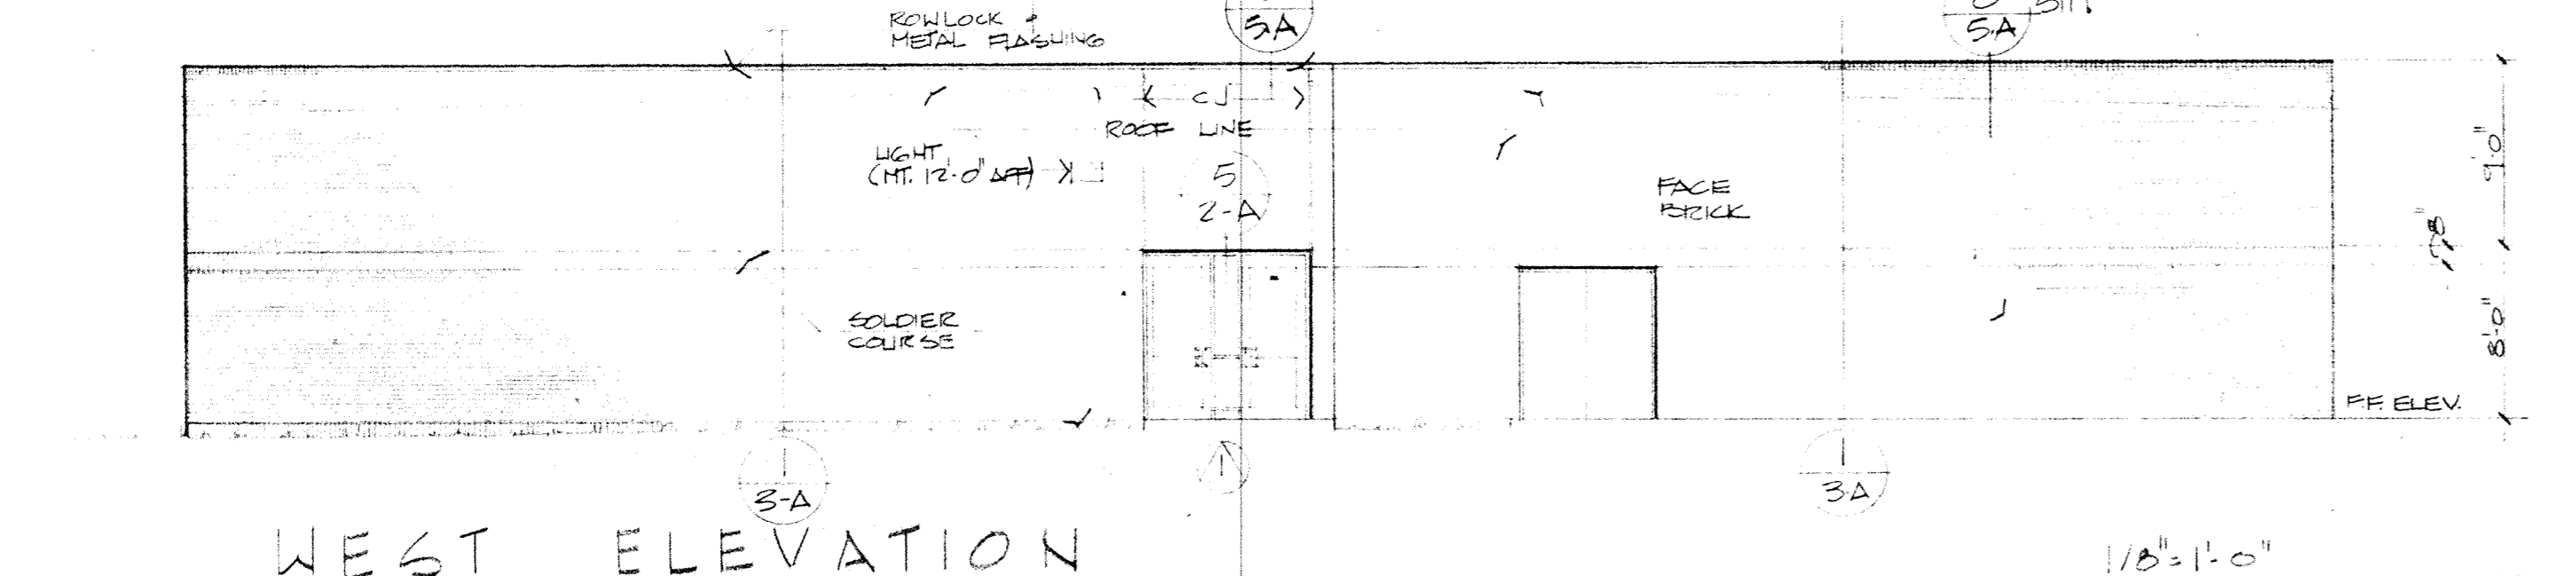

WEST ELEVATION 1/8"=1'-0"

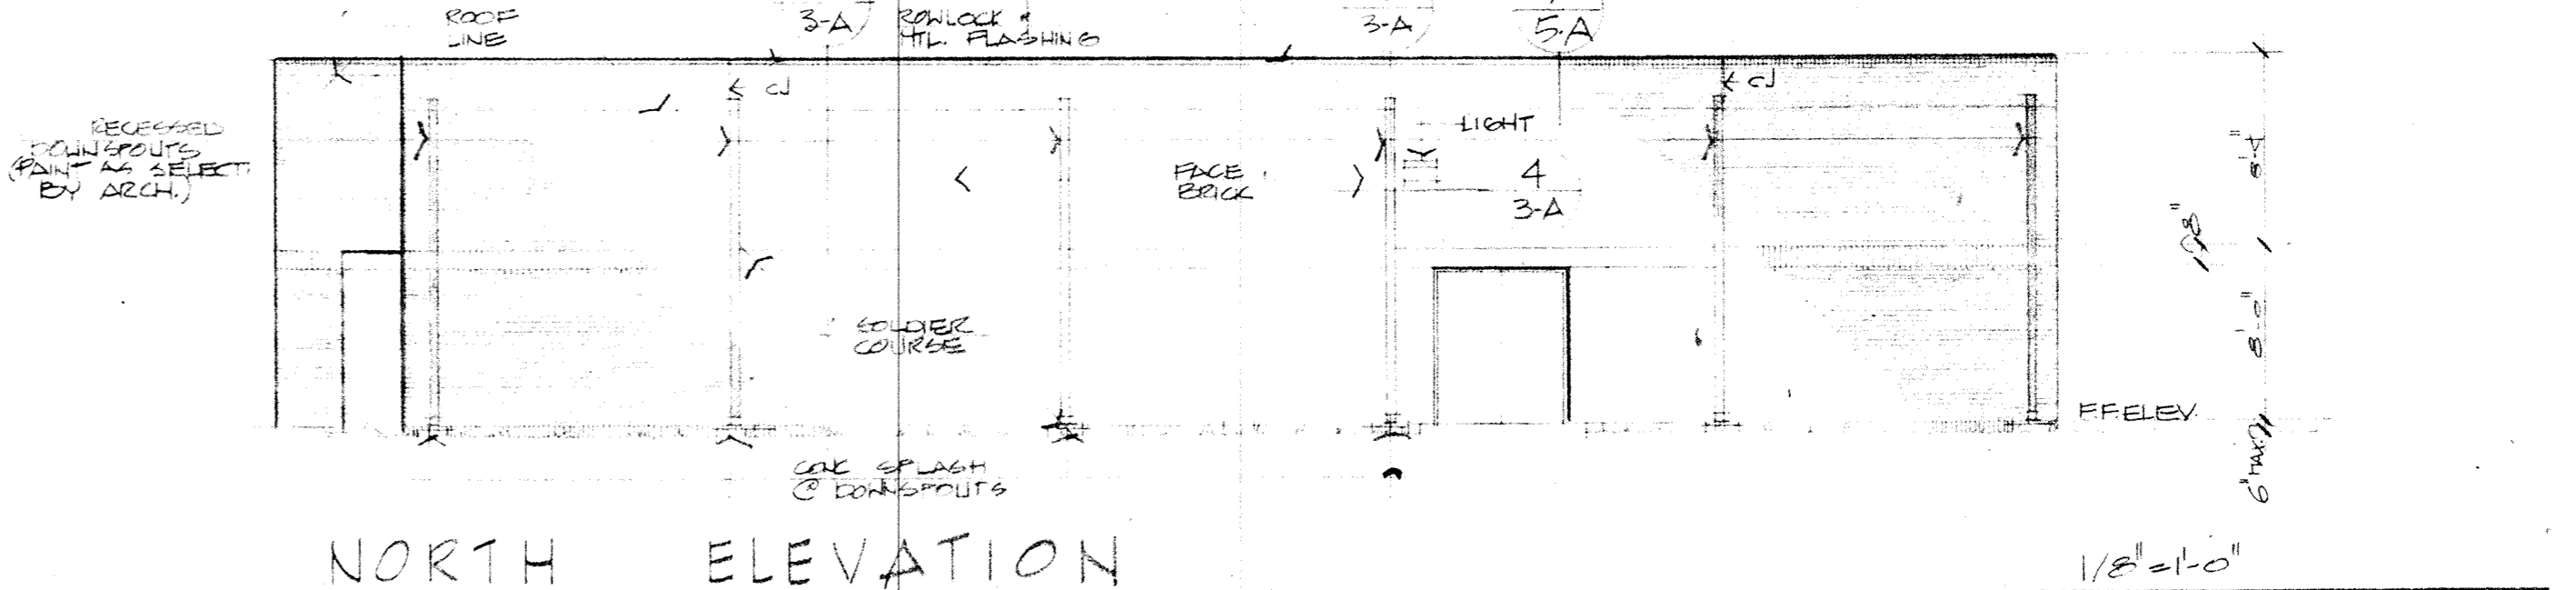


NORTH ELEVATION 1/8"=1'-0"

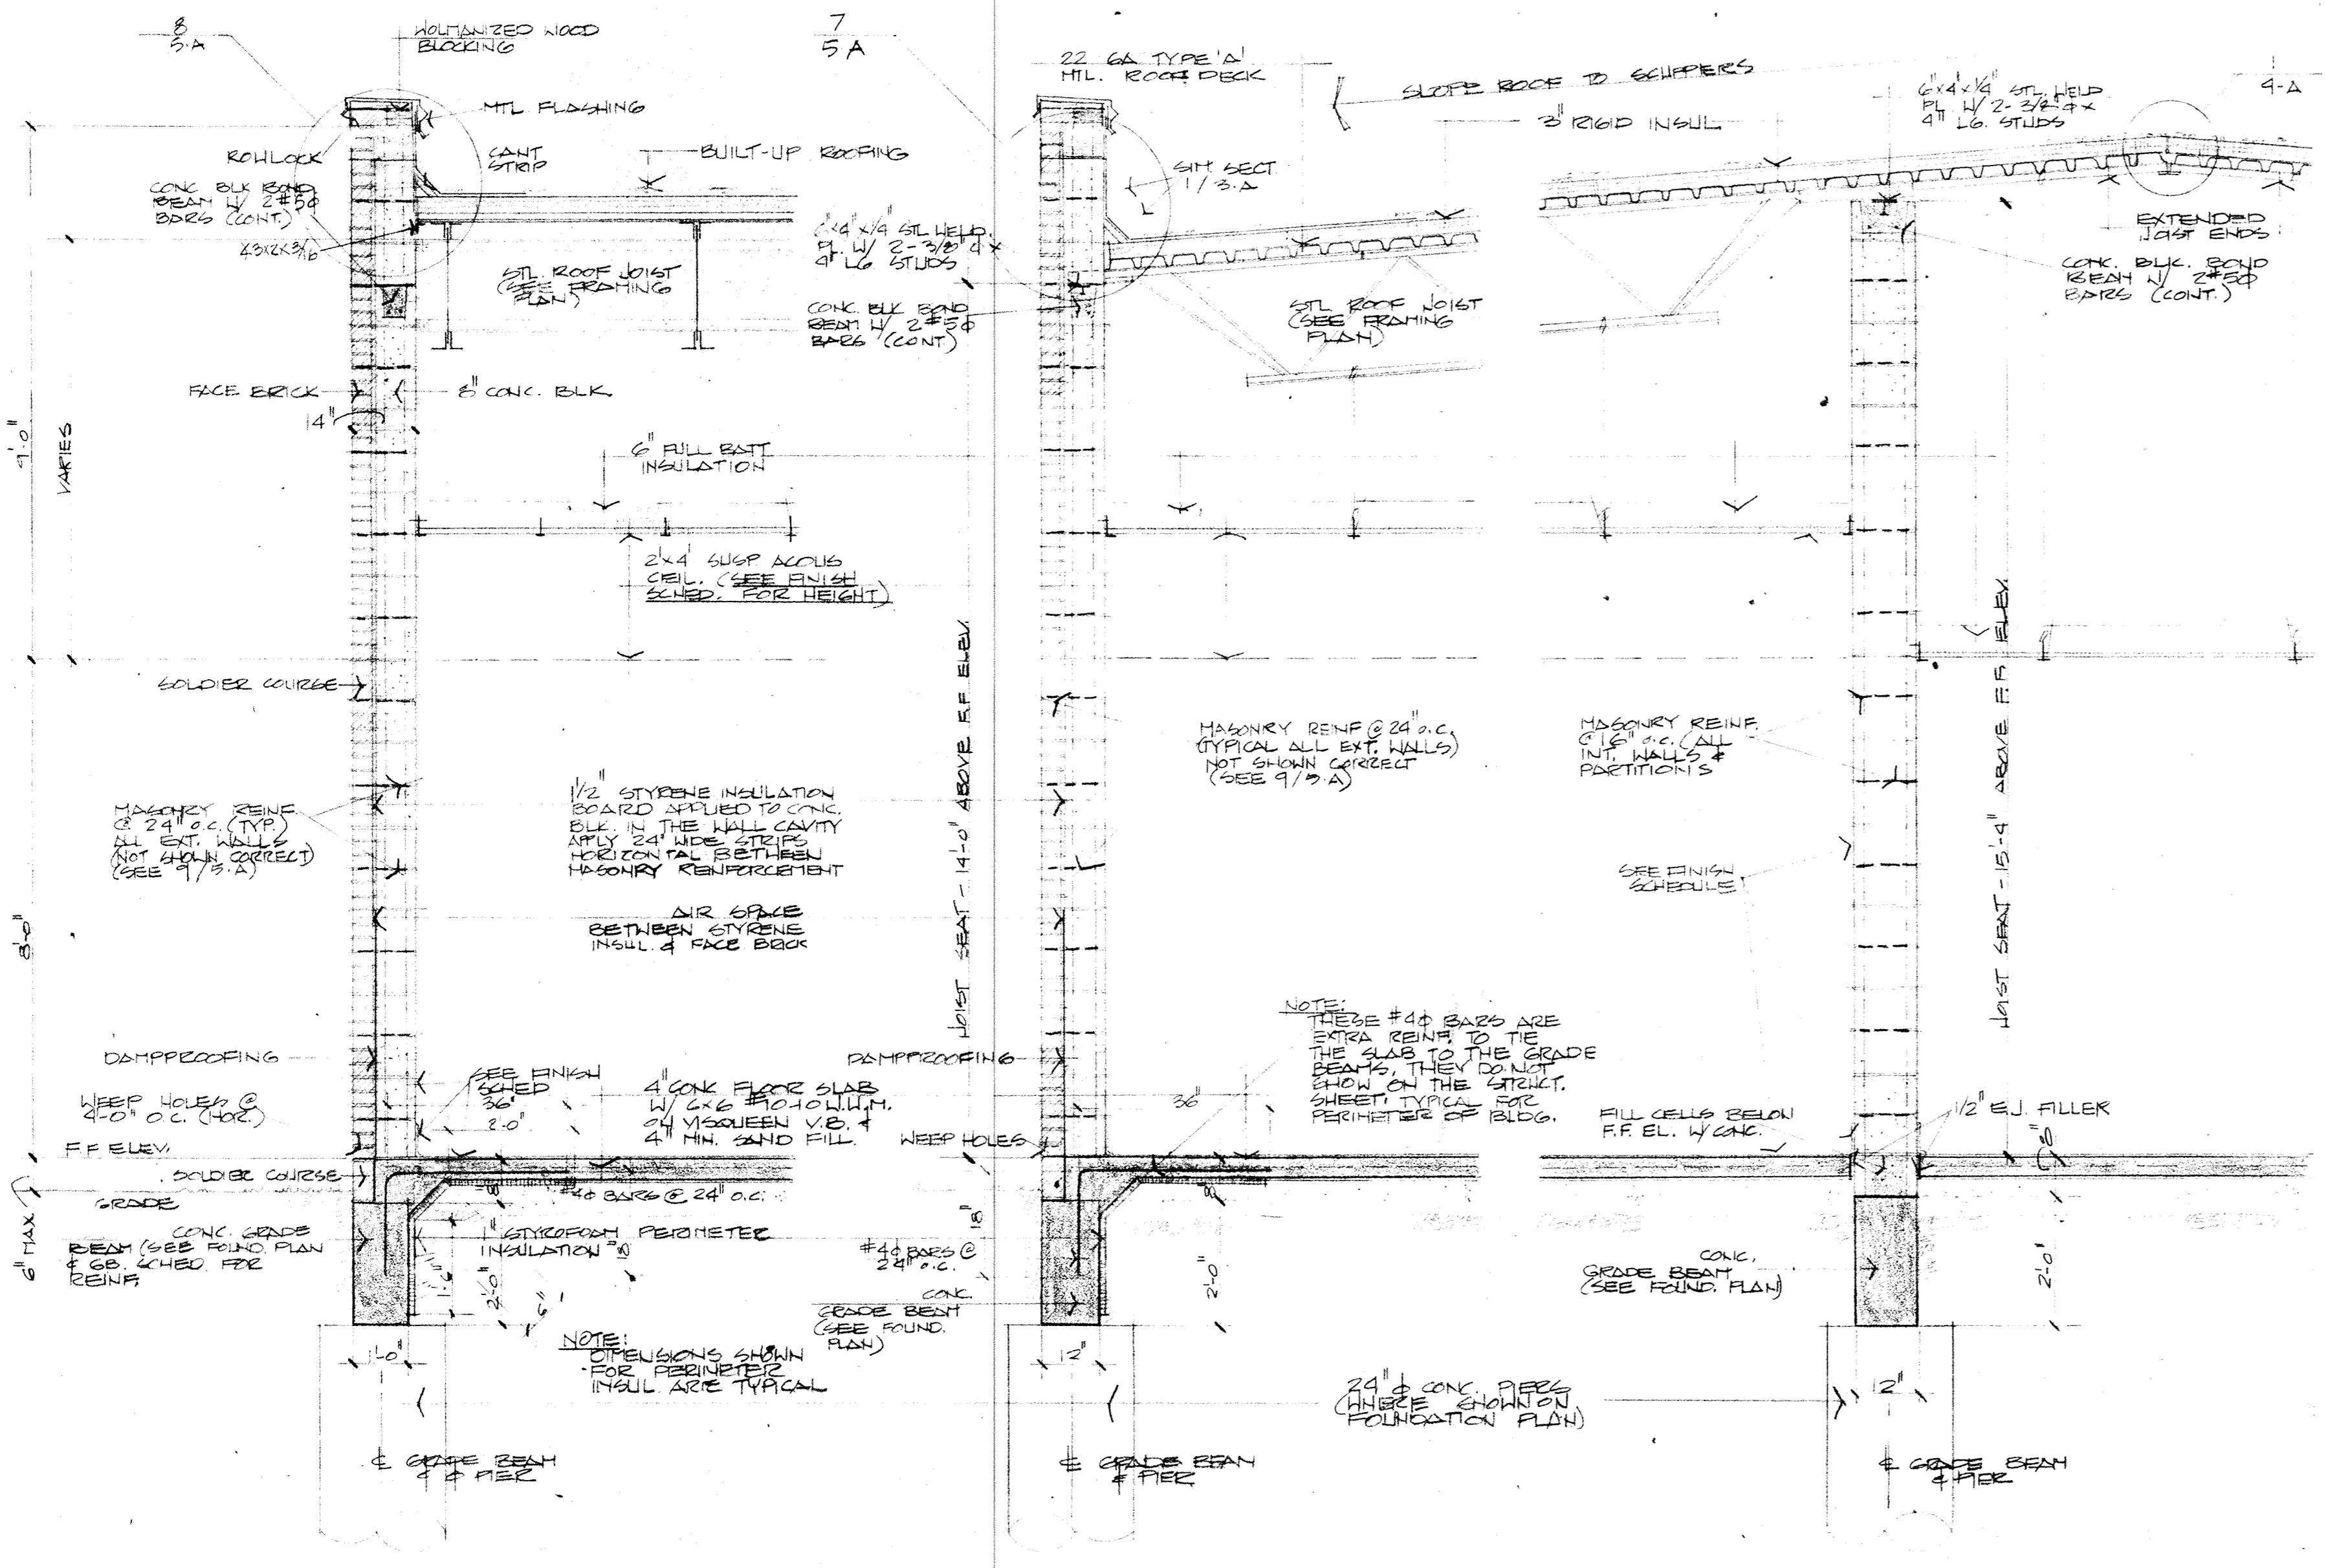


1 SECTION 1/2"=1'-0"

2 SECTION 1/2"=1'-0"

3 SECTION 1/2"=1'-0"

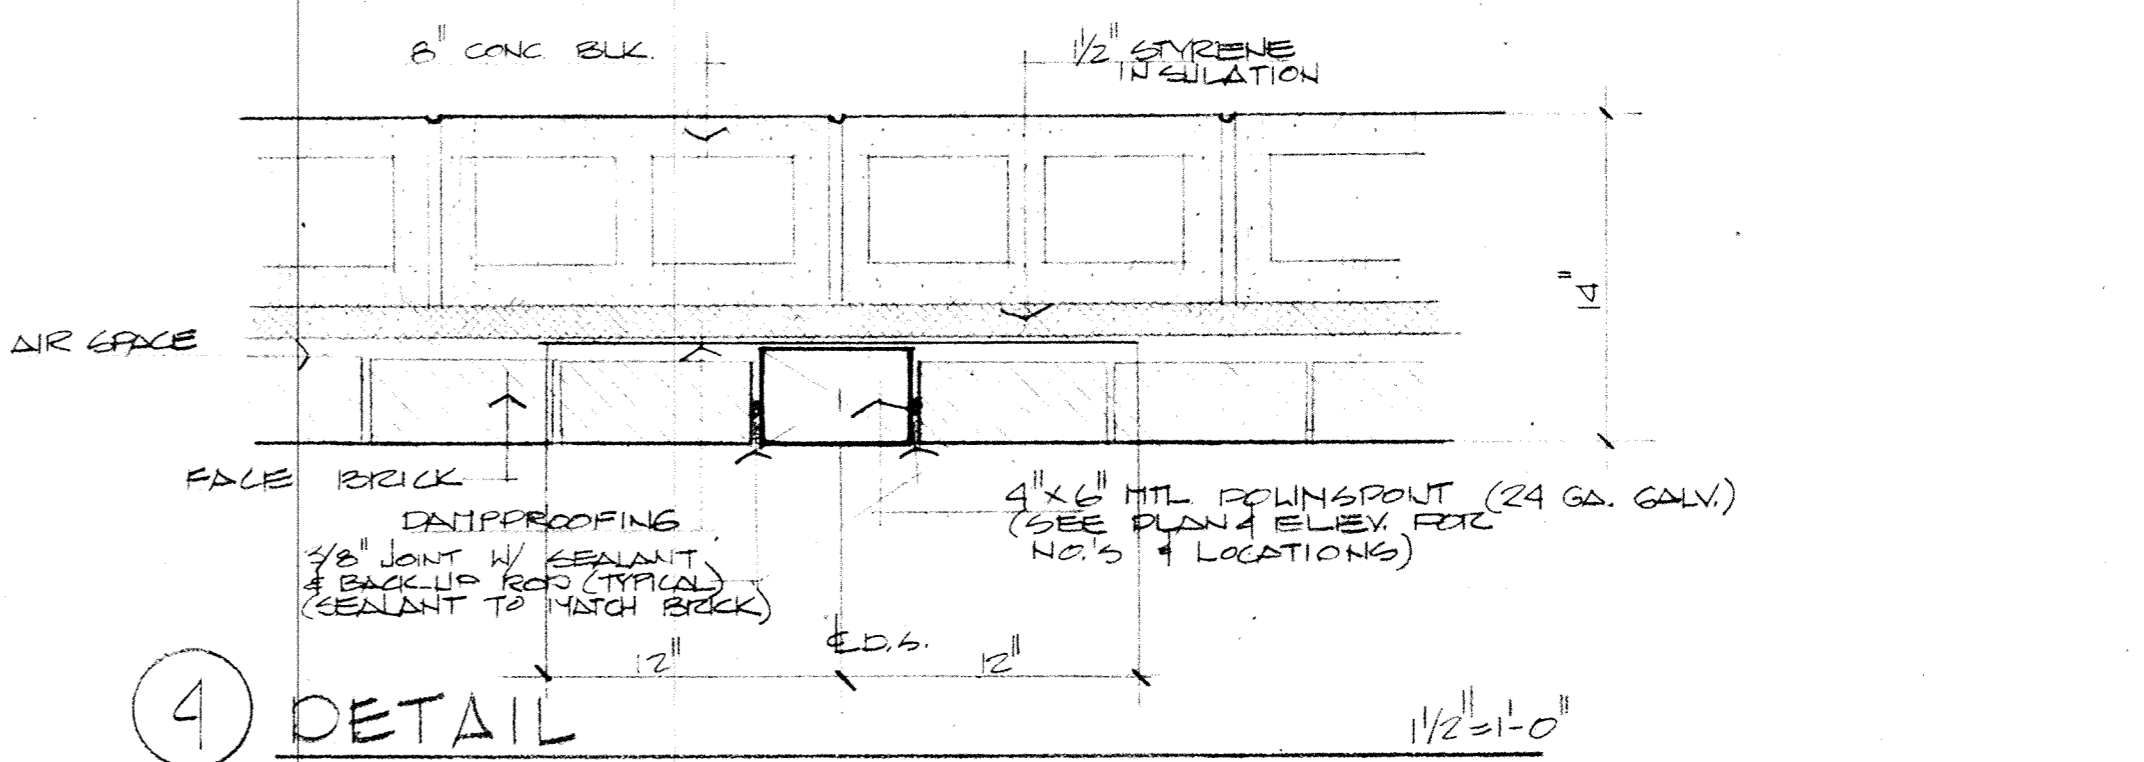

4 DETAIL 1/2"=1'-0"

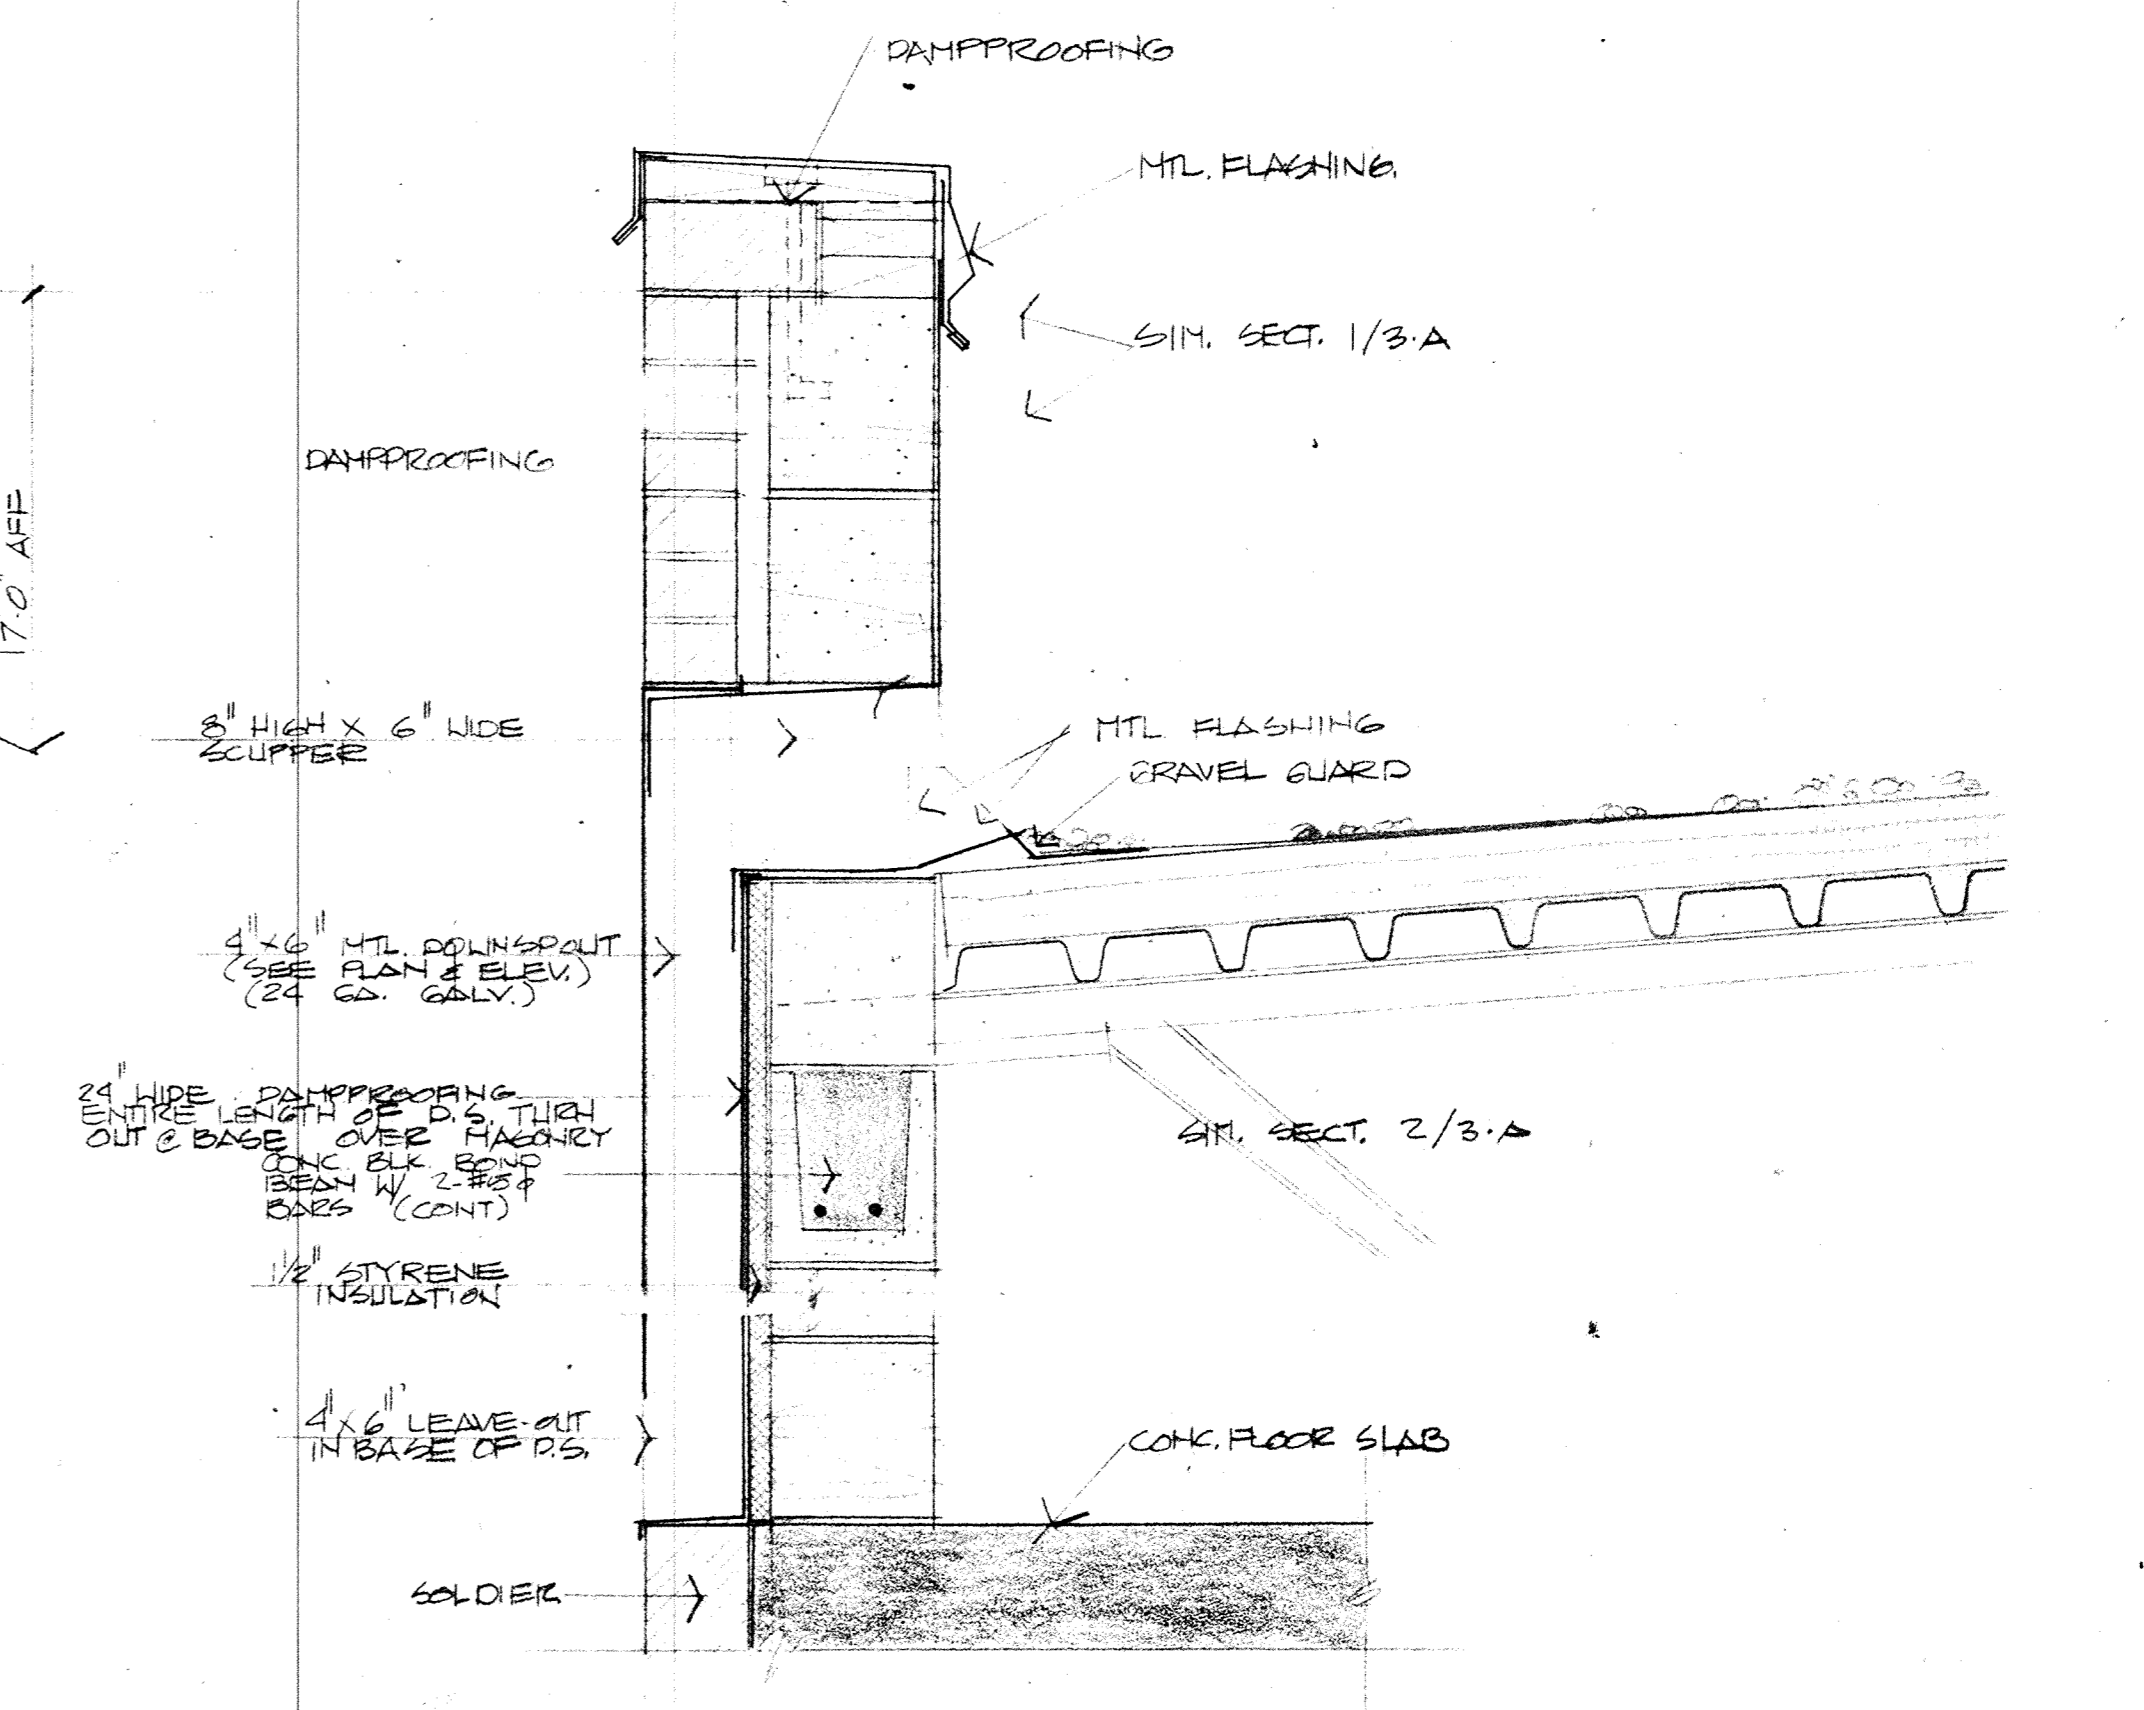

5 DETAIL 1/2"=1'-0"