

MATERIALS LEGEND

- EARTH
- CONCRETE
- CONCRETE BLOCK
- L.W. CONC. M.U.
- CLAY TILE
- GLAZED FACING TILE
- FACE BRICK
- COMMON BRICK
- FIRE BRICK
- CAST STONE
- CUT STONE
- MARBLE
- CERAMIC TILE
- QUARRY TILE
- TERRAZZO
- PLASTER, SAND OR L.W. CONC.
- GRAVEL
- WOOD (FINISH)
- WOOD (ROUGH)
- PLYWOOD
- METAL STUDS
- STEEL
- INSULATION


- (A) 1-3/4" H.M. flush door
- (B) Vault Door and Frame (See specs.)
- (E) Sound Door and Frame (See specs.)

SCHEDULE OF DOOR SIZES

NK	SIZE
1	6'0" x 7'2" PAIR
2	3'0" x 7'0"
3	3'0" x 7'2"
4	2'5" x 7'2"
5	3'4" x 6'6"

SCHEDULE OF DOOR GLASS

NK	TYPE
A	1/4" PLATE GLASS
B	1/4" TEMPERED GLASS



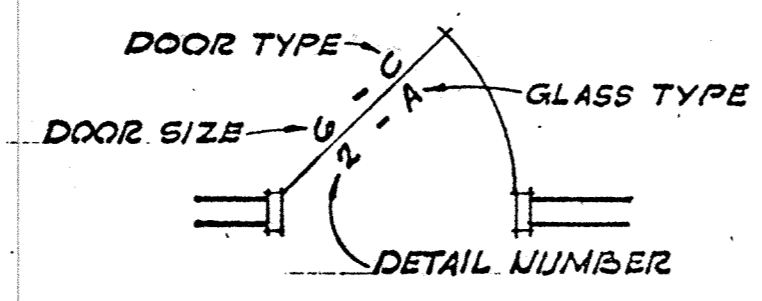


KEY TO DOOR SCHEDULES

LINTEL SCHEDULE

TYPE	WALL THICKNESS	OPENING WIDTH FROM UP TO	LINTEL SIZE	REMARKS	SHAPE
FACE BRICK	4"	0'-0"	3 1/2" x 3 1/2" x 1/4" STL. 4	LOOSE	1/2"
FACE BRICK	4"	3'-0"	3 1/2" x 4" x 1/4" STL. 2	LOOSE	1/2"
CLAY TILE, CONC. BLOCK OR L.W.C.M.U.	4"	0'-0"	3 1/2" x 1/4" PL. W/ 4" x 1/4" TEE	WELD PL. & TEE	1/2"
CLAY TILE	4"	3'-0"	3 1/2" x 1/4" PL. W/ 4" x 1/4" TEE	WELD PL. & TEE	1/2"
CLAY TILE OR BRICK	8"	0'-0"	7 1/2" x 1/4" PL. W/ 7 1/2" x 1/4" TEE	WELD PL. & TEE	1/2"
CLAY TILE OR BRICK	8"	3'-0"	7 1/2" x 1/4" PL. W/ 7 1/2" x 1/4" TEE	WELD PL. & TEE	1/2"
CONC. BLOCK OR L.W.C.M.U.	8"	0'-0"	10" LONG LINTEL BLOCK - 2 NO. 4 1 BAR TOP & 1 BOT.		1/2"
CONC. BLOCK OR L.W.C.M.U.	8"	3'-0"	10" LONG LINTEL BLOCK - 4 NO. 4 2 BARS TOP & 2 BOT.		1/2"
CONC. BLOCK OR L.W.C.M.U.	8"	6'-0"	10" LONG LINTEL BLOCK - 4 NO. 4 2 BARS TOP & 2 BOT.		1/2"
CONC. BLOCK OR L.W.C.M.U.	8"	12'-0"	10" LONG LINTEL BLOCK - 4 NO. 5 2 BARS TOP & 2 BOT.		1/2"
CONC. BLOCK OR L.W.C.M.U.	12"	0'-0"	10" LONG LINTEL BLOCK - 4 NO. 5 2 BARS TOP & 2 BOT.		1/2"
CONC. BLOCK OR L.W.C.M.U.	12"	3'-0"	10" LONG LINTEL BLOCK - 4 NO. 5 2 BARS TOP & 2 BOT.		1/2"
CONC. BLOCK OR L.W.C.M.U.	12"	6'-0"	10" LONG LINTEL BLOCK - 4 NO. 5 2 BARS TOP & 2 BOT.		1/2"

- NOTES:**
- PROVIDE LINTELS FOR ALL OPENINGS IN MASONRY WALLS FOR ALL TRADES INCLUDING MECH. & ELECT. IF NOT SHOWN OTHERWISE LINTELS SHALL BE AS SCHEDULED ABOVE.
 - USE COMBINATION OF 4" FACE BRICK & 8" BACK-UP LINTELS FOR 12" EXTERIOR WALLS.
 - ALL STEEL LINTELS TO LAP OVER EDGE OF OPENING A MIN. OF 8".
 - FILL ALL CONC. & L.W.C.M.U. LINTEL BLOCK JOISTS W/ CONCRETE.
 - L.W.C.M.U. = LIGHT WEIGHT CONCRETE MASONRY UNIT.

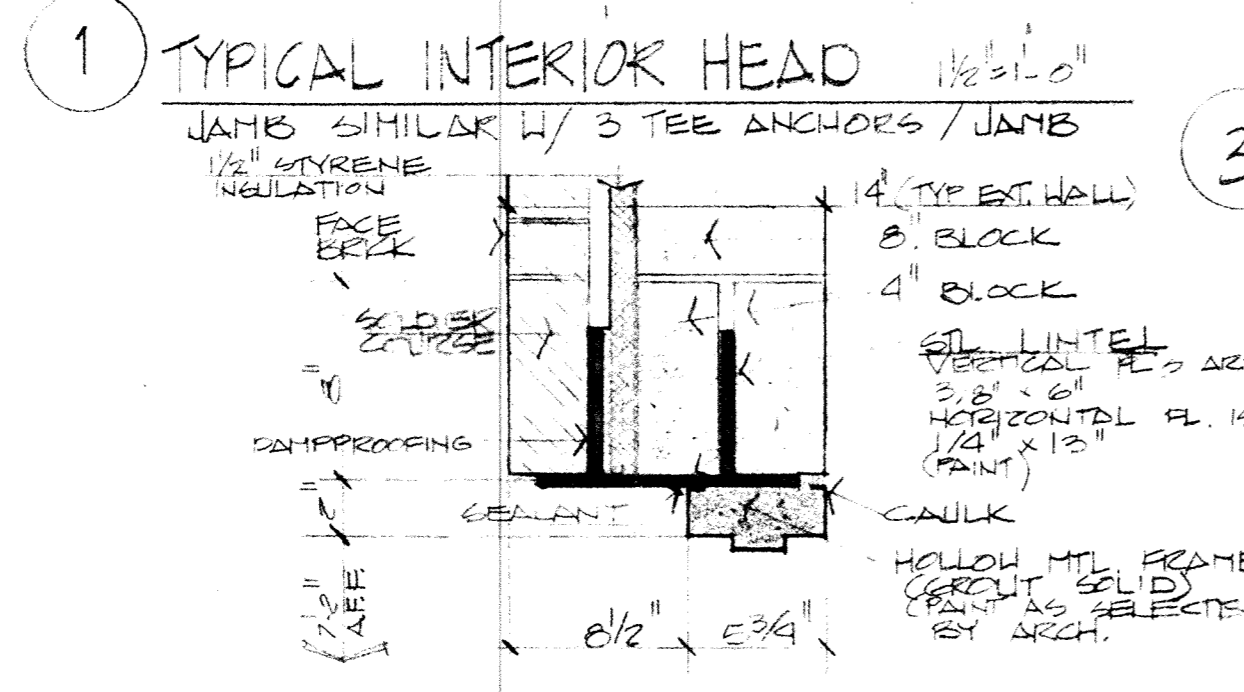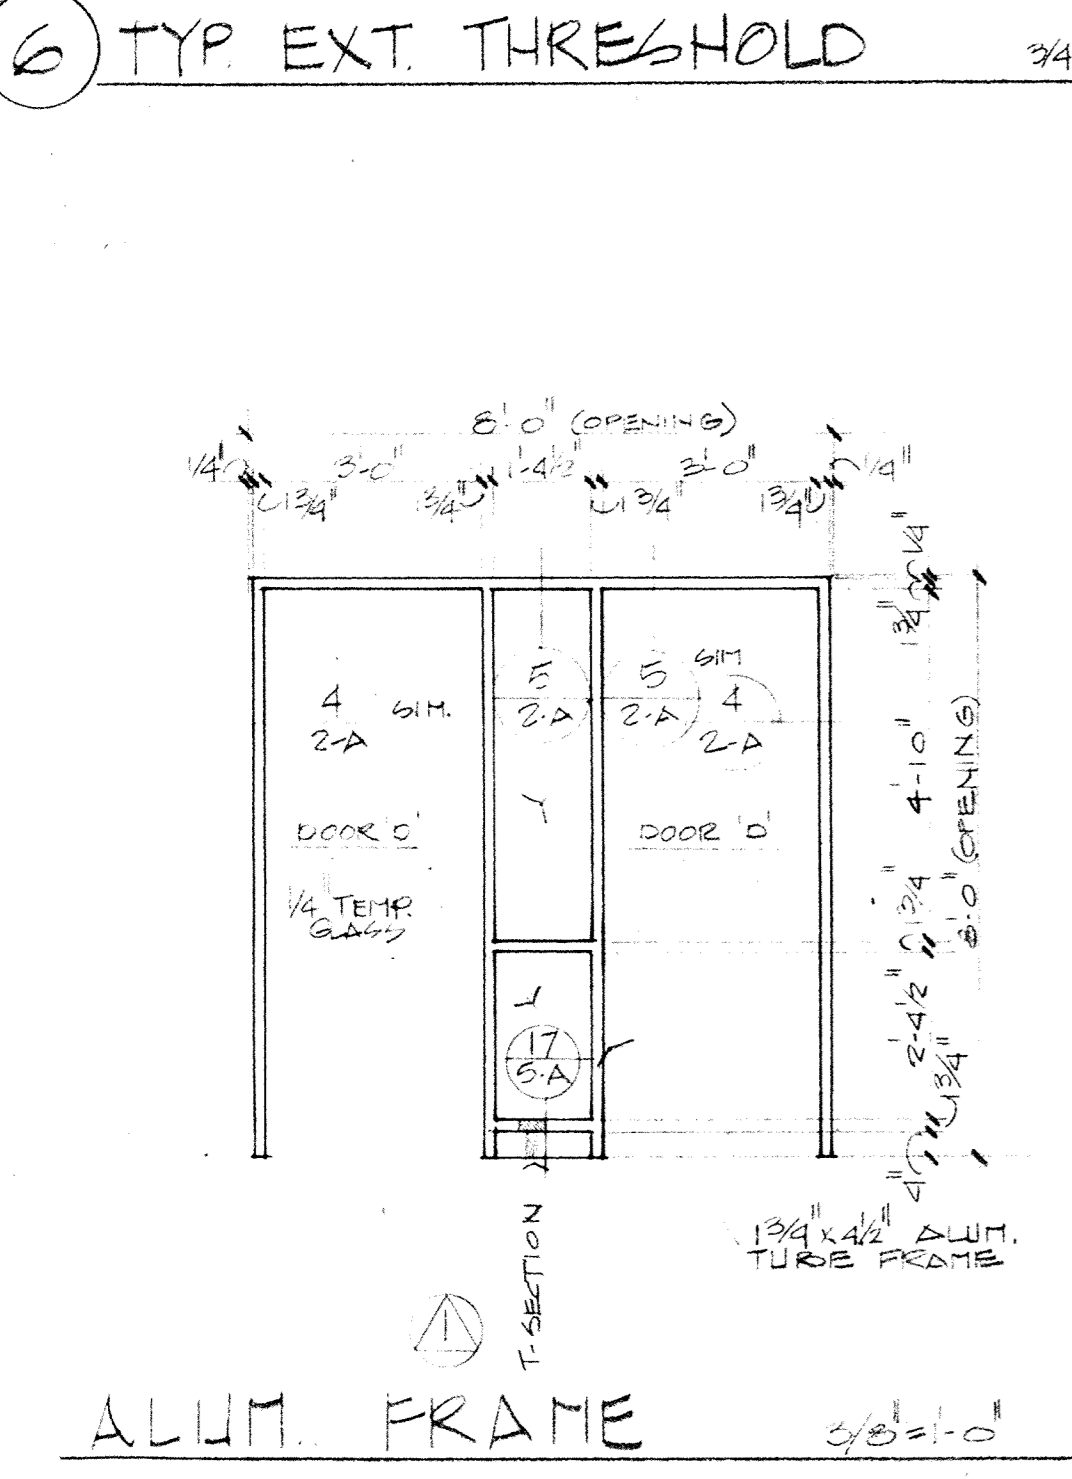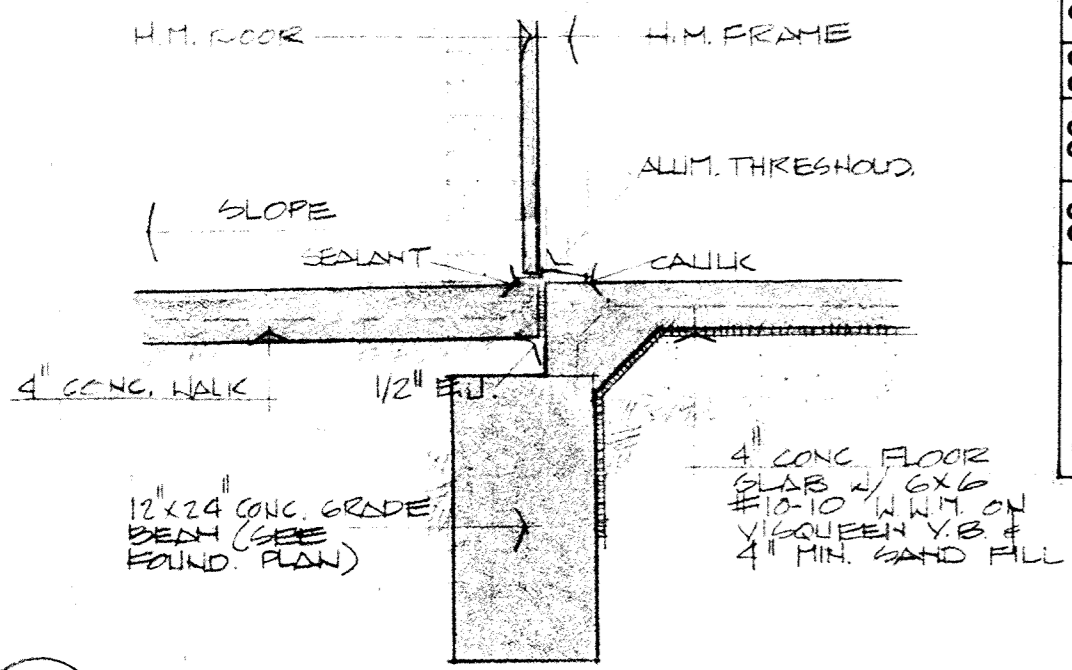

FLOOR PLAN

- FINISH NOTES:**
- DRYING AREA TO HAVE THE FOLLOWING FINISHES: FLOOR, BASE AND WALLS - CERAMIC TILE. CEILING - GYP. PL. (PAINTED) @ 8'0" HEIGHT. FLOOR OF SEWERAGE TO BE SEPARATED FROM THE FLOOR OF DRYING AREA. TOILET @ 4" HIGH CURB.
 - PROVIDE BULLNOSE CERAMIC TILE TRANSITION PIECE @ INTERFERENCE OF CERAMIC TILE FLOOR & 1/2" TILE FLOOR AND OF CERAMIC TILE WALL OR WAINSCOT 1" PAINTED BLOCK WALL.
 - DOORS 10, 11, AND 12 TO HAVE A 3'0" HIGH CERAMIC TILE WAINSCOT W/ PAINTED BLOCK ABOVE.

- ABBREVIATIONS**
- E.W.C. - Electric Water Cooler
 - F.B. - Fire Extinguisher
 - W.C. - Water Closet
 - Lav. - Lavatory
 - S.S. - Service Sink
 - N.I.C. - Not in Contract
 - E.J. - Expansion Joint
 - C.J. - Control Joint


ROOM FINISH SCHEDULE

FLOOR	BASE	WALLS	CEILING	HGT.
A VINYL-ASBESTOS TILE	1 6" VINYL	A CONC. BLK (PAINTED)	1 2 1/2" ACCOUST. SUB. CELL	A 10'-0"
B EXP. CONC.	2 GLAZED CERAMIC TILE	B GYP. PL. (PAINTED)	2 1/2" GYP. PL. GYPS. ECC'S @ 10' O.C.	B 8'-0"
C UNGLAZED CERAMIC TILE	3 NONE	C GLAZED CERAMIC TILE	3	C
D	4	D SEE NOTE (3)	4	D
E	5	E	5	E

FOR "N" IN BOX, SEE NOTE ON FLOOR PLAN

NUMBERS AND LETTERS APPEARING IN BOXES ON FLOOR PLANS REFER TO ROOM FINISH SCHEDULE IN THE FOLLOWING ORDER:

A 2 B 3 C

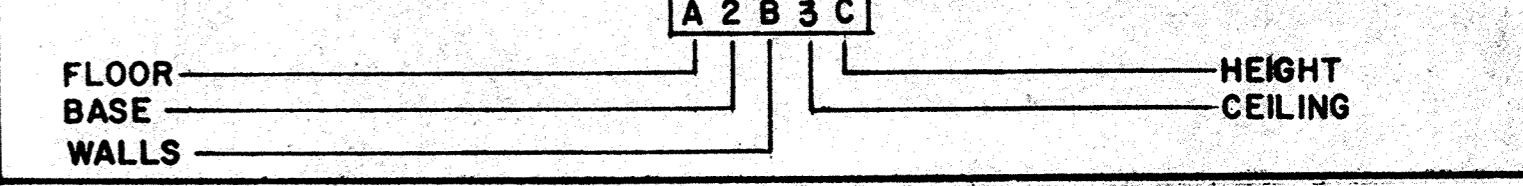

LKHG

HEALTH CARE PLANNERS
FORT SMITH, ARKANSAS

LASER KNIGHT HATHAWAY & GUEST, P.A.

ARCHITECTS • ENGINEERS • 800 FIRST NATIONAL BANK

AVONICS FACILITY

ARKANSAS AIR NATIONAL GUARD

FORT SMITH, ARKANSAS

REVISIONS

FLOOR PLAN, LEGEND, FINISH SCHEDULE, DOOR SCHEDULE & DETAILS

JOB NUMBER
1966

DATE
2-9-77

SHEET
2

CATEGORY
A