


HOLLOW METAL FRAME ELEVATIONS

1/4" = 1'-0"

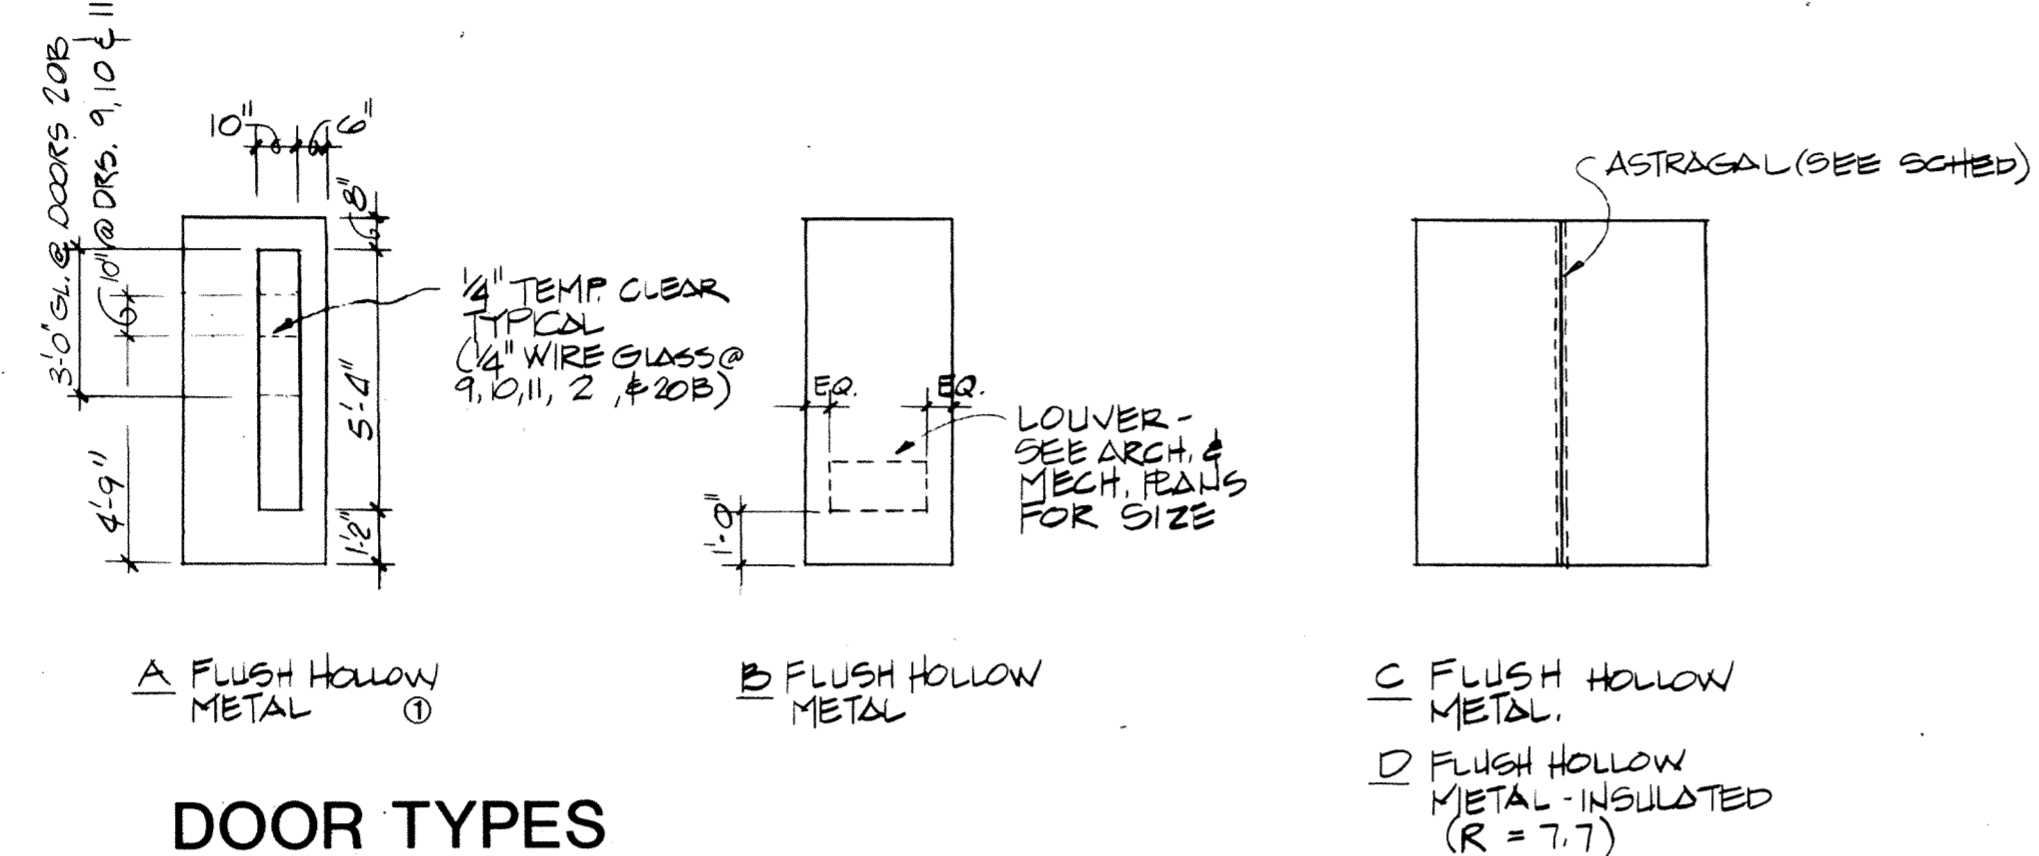


DOOR TYPES


1/4" = 1'-0"

| DOOR NO. | HOW SET NO. | DOOR | | | | | FRAME | | | FIRE RTG. | REMARKS |
|----------|-------------|------------------------|-----------|-----------------------------|------|-----------|--------------|-----------------------|--|-----------|---------|
| | | LOCATION OUT(KEY)/SIDE | DR. ELEV. | SIZE W H T | MATL | FR. ELEV. | TYPE | DETAILS HD. JB. SILL. | | | |
| 2 | 1 | 3A - SHOP | A | 3'-0" 7'-2" 1 3/4" | HM | HM-1 | 12 11 - - | - - | | | |
| 9 | 9 | 11 - HALL | A | 6'-0" 7'-2" 1 3/4" | HM | - | - - - | - - | "B" REUSE EXIST. FRAME PAIR W/ASTRAGAL | | |
| 10 | 8 | 11 - HALL | A | 3'-0" 7'-2" 1 3/4" | HM | HM-1 | 15 16 - - | - - | "B" | | |
| 11 | 6 | 30 - VEST. | A | 3'-0" 7'-2" 1 3/4" | HM | HM-1 | 7A+1 6/AA-1 | - - | "B" | | |
| 12 | 1 | A15 - SHOP | A | 3'-0" 7'-2" 1 3/4" | HM | HM-1 | 7 8 - - | - - | | | |
| 13 | 1 | A15 - SHOP | A | 4'-0" 7'-2" 1 3/4" | HM | HM-1 | 9 10 - - | - - | | | |
| 14A | 7 | 11 - HALL | B | 4'-0" 7'-2" 1 3/4" | H.M. | HM-1 | 9 10 - - | - - | | | |
| 14B | 3 | EXTERIOR | D | 6'-0" 7'-0" 1 3/4" | H.M. | HM-1 | 4 5 6 - - | - - | PAIR W/ASTRAGAL | | |
| 17 | 2 | EXTERIOR | D | 6'-0" 7'-10" 1 3/4" | H.M. | HM-1 | 4 5 6 - - | - - | PAIR W/ASTRAGAL | | |
| 18A | 2 | EXTERIOR | D | 6'-0" 7'-10" 1 3/4" | H.M. | HM-1 | 4 5 6 - - | - - | PAIR W/ASTRAGAL | | |
| 18B | | | | 2'-8 1/2" 2'-11 1/4" 1 3/4" | WD | - | - - - | - - | GATE-SEE MILLWK | | |
| 19 | 1 | ESS SHOP | A | 3'-0" 7'-2" 1 3/4" | HM | HM-1 | 7 8 - - | - - | | | |
| 20A | 5 | ESS SHOP | C | 6'-0" 7'-2" 1 3/4" | HM | HM-1 | 7 8 - - | - - | PAIR | | |
| 20B | 6 | 11 - HALL | A | 4'-0" 7'-2" 1 3/4" | HM | HM-1 | 9 10 - - | - - | 20MIN | | |
| 21A | 4 | 22 - HALL | A | 3'-0" 7'-2" 1 3/4" | HM | HM-1 | 12 13/2 - - | - - | | | |
| 21B | 4 | 22 - HALL | A | 3'-0" 7'-2" 1 3/4" | HM | HM-4 | 12 13/2 - - | - - | | | |
| 21C | 3 | EXTERIOR | D | 6'-0" 7'-10" 1 3/4" | HM | HM-1 | 15 16 17 - - | - - | PAIR W/ASTRAGAL | | |
| 22 | 1 | 22 - HALL | A | 3'-0" 7'-2" 1 3/4" | HM | HM-1 | 1 2/3 - - | - - | | | |
| 27 | 1 | B4C SHOP | A | 3'-0" 7'-2" 1 3/4" | HM | HM-1 | 12 11 - - | - - | | | |

NOTE: "B" LABEL = 112 HOUR U.L. LABEL

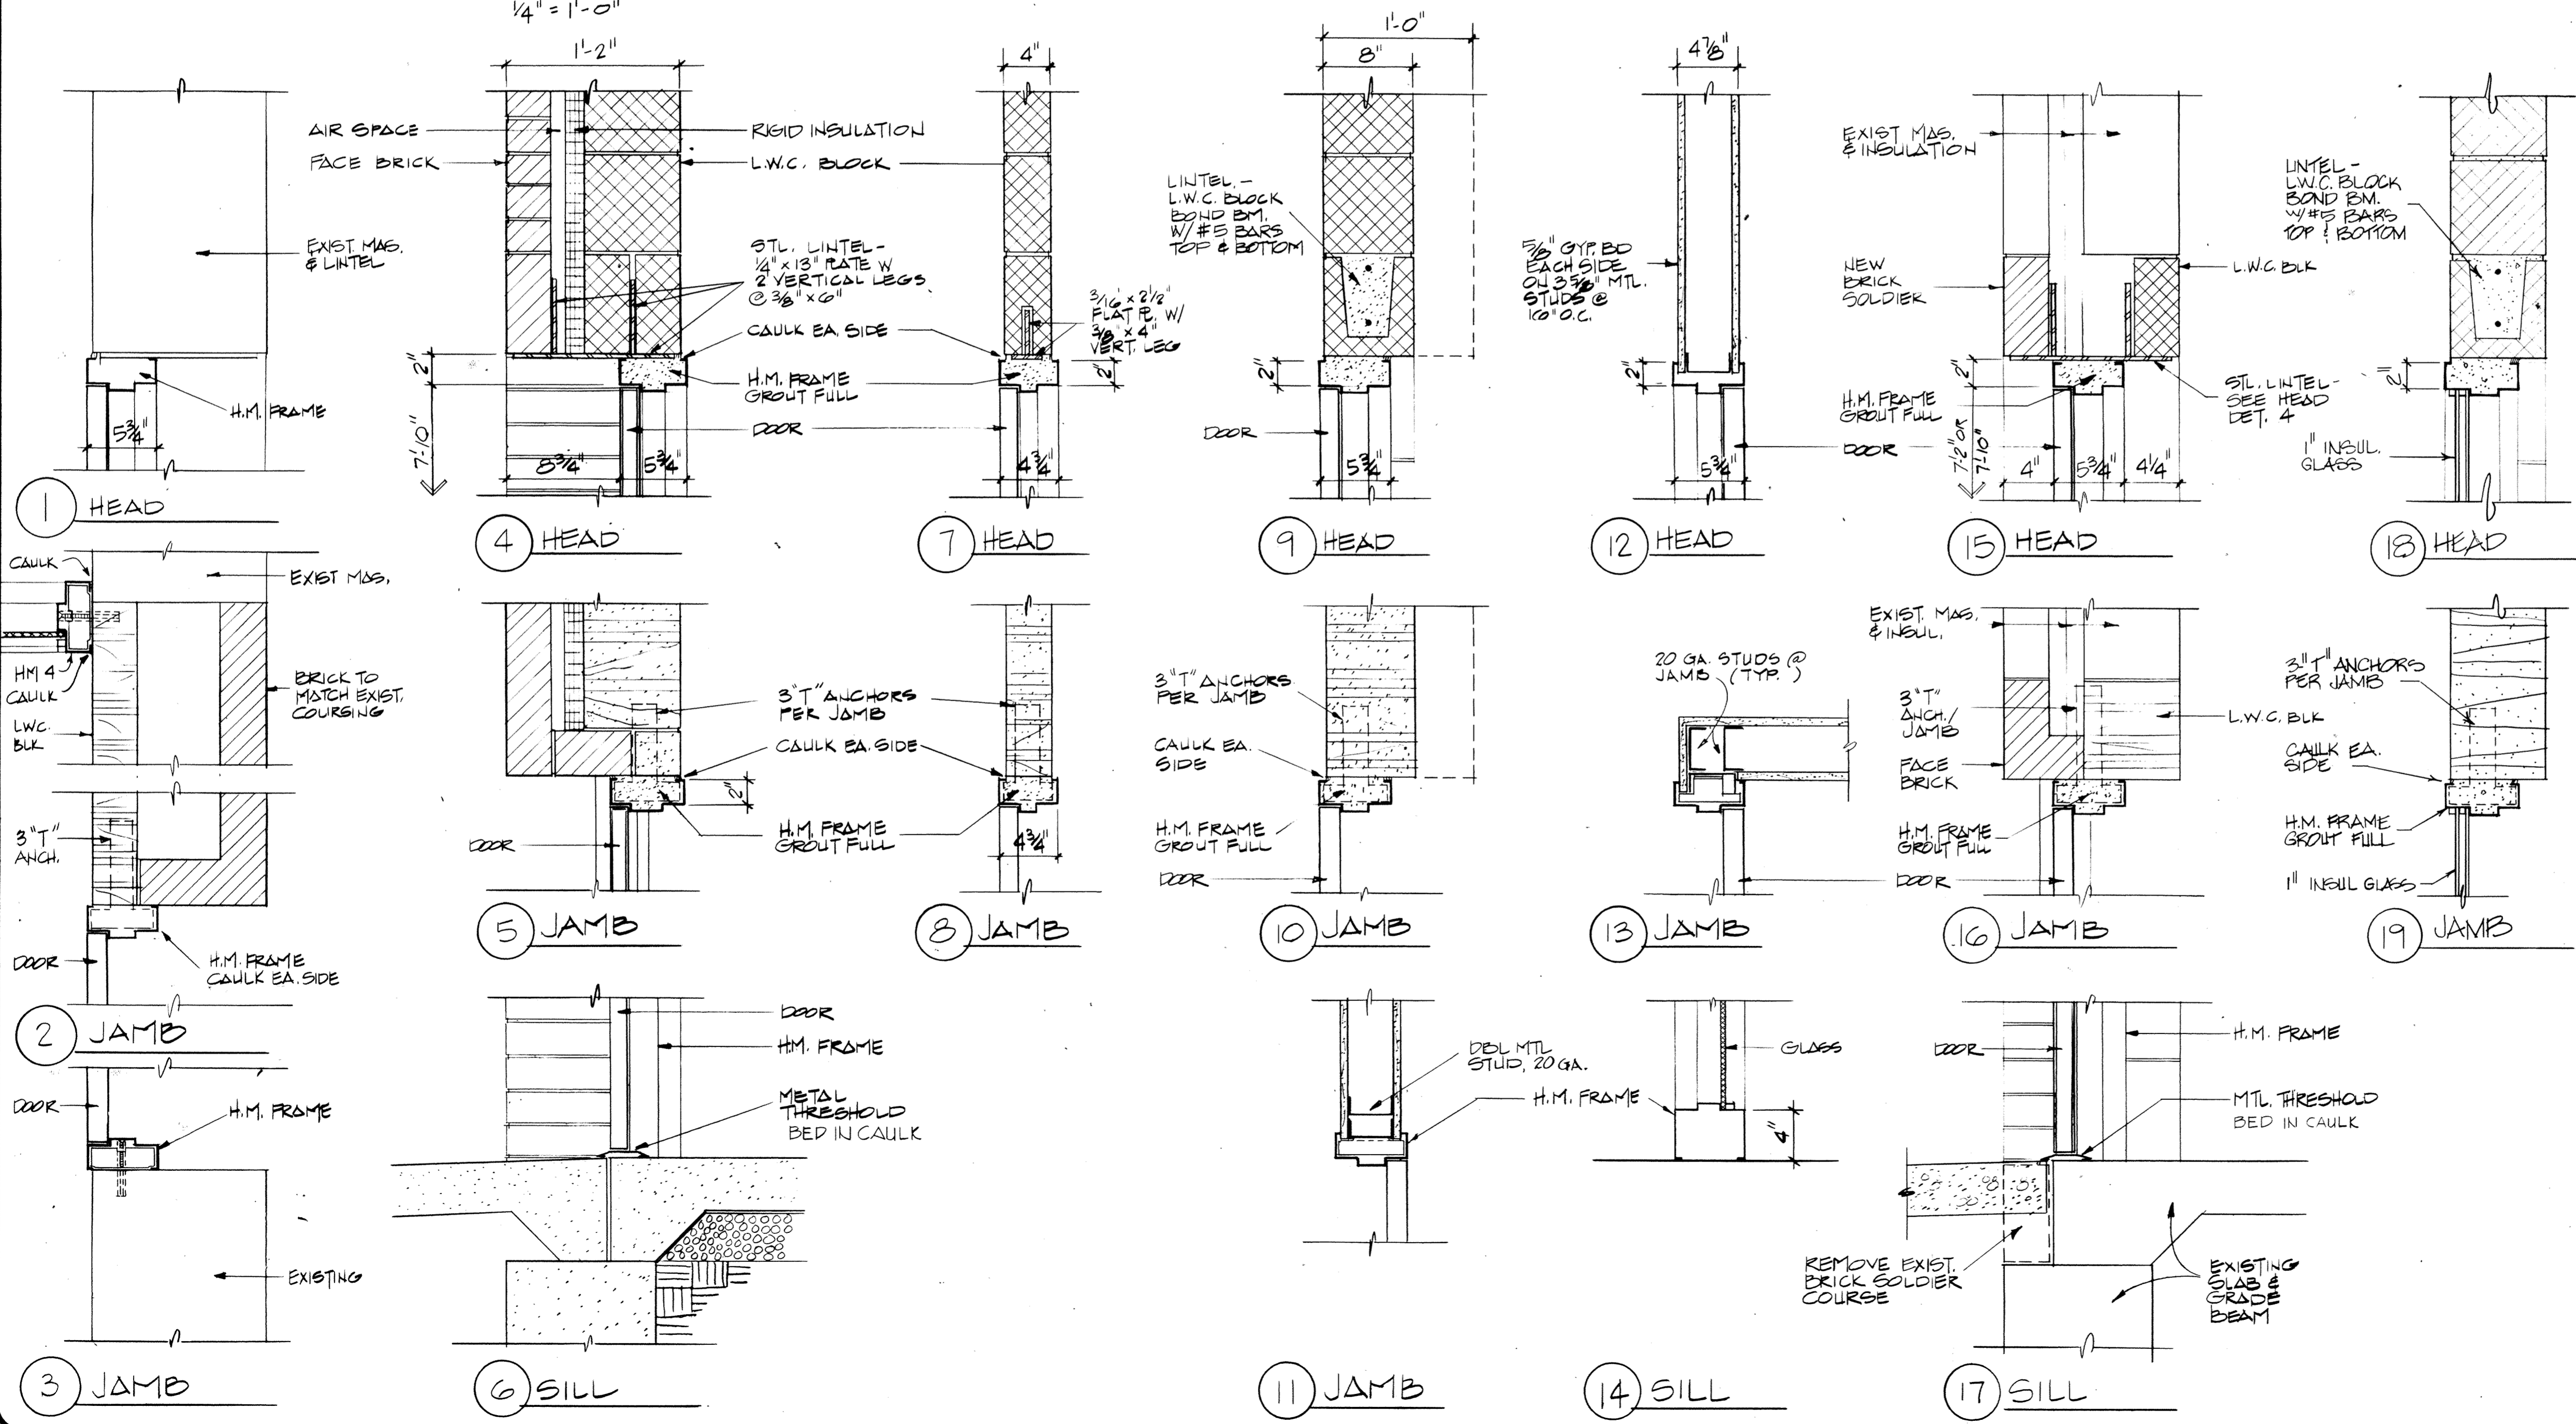

MM MG
Mott Mobley McGowan & Griffin, P.A.: Architects
302 North Sixth Street
Fort Smith, Arkansas 72901

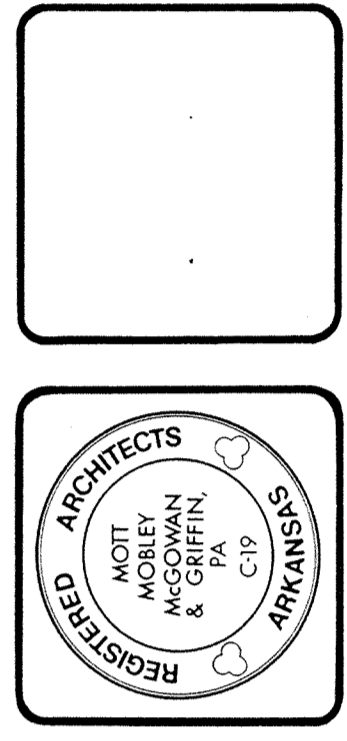

PROJECT NO. FSM-40997
ADD/ALTER AVIONICS/ECM POD SHOP/STORAGE
AIR NATIONAL GUARD TRAINING FACILITY
MUNICIPAL AIRPORT - FT. SMITH, ARKANSAS

DOOR SCHEDULE & DETAILS

As-built info:
4-12-90 ①
Revisions
1357
Plan Number:
11-16-88
Date
or **28**
A3.1

BRUNING 60 72 85321