
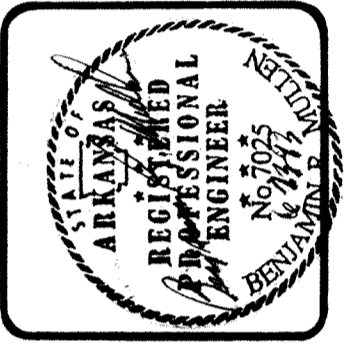



FIXTURE SCHEDULE				
TYPE	DESCRIPTION	LAMPS	REMARKS	VOLT
A	WILLIAMS # 8125 1/2 WIREGUARD REFLECTOR	4-F40 CWRS	8' FLOR. STRIP	277
A1	WILLIAMS # 8125 1/2 WIREGUARD REFLECTOR & EM. BAT. BACKUP	4-F40 CWRS	8' FLOR STRIP	277

FLOOR PLAN-LIGHTING

SCALE: 1/8"=1'-0"
(SEE ALSO DWG A+1 - REFL. CLG. PLAN)

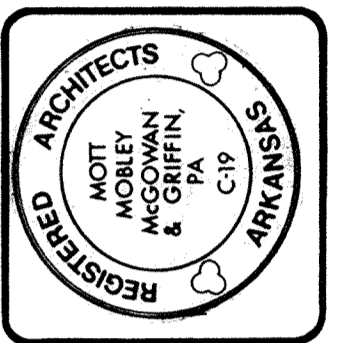

CONTRACT NO. DAH403-93-R-0001
PROJECT NO. HKRZ929948
ADD./ ALTER. ECM POD SHOP
AIR NATIONAL GUARD TRAINING FACILITY
MUNICIPAL AIRPORT - FT. SMITH, ARKANSAS

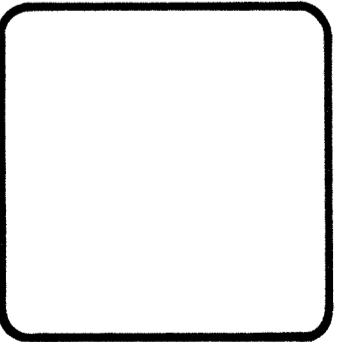

Revisions	
1440	E-2
7-30-93	
Date	Or