



FIRE ALARM RISER DIAGRAM

NTS

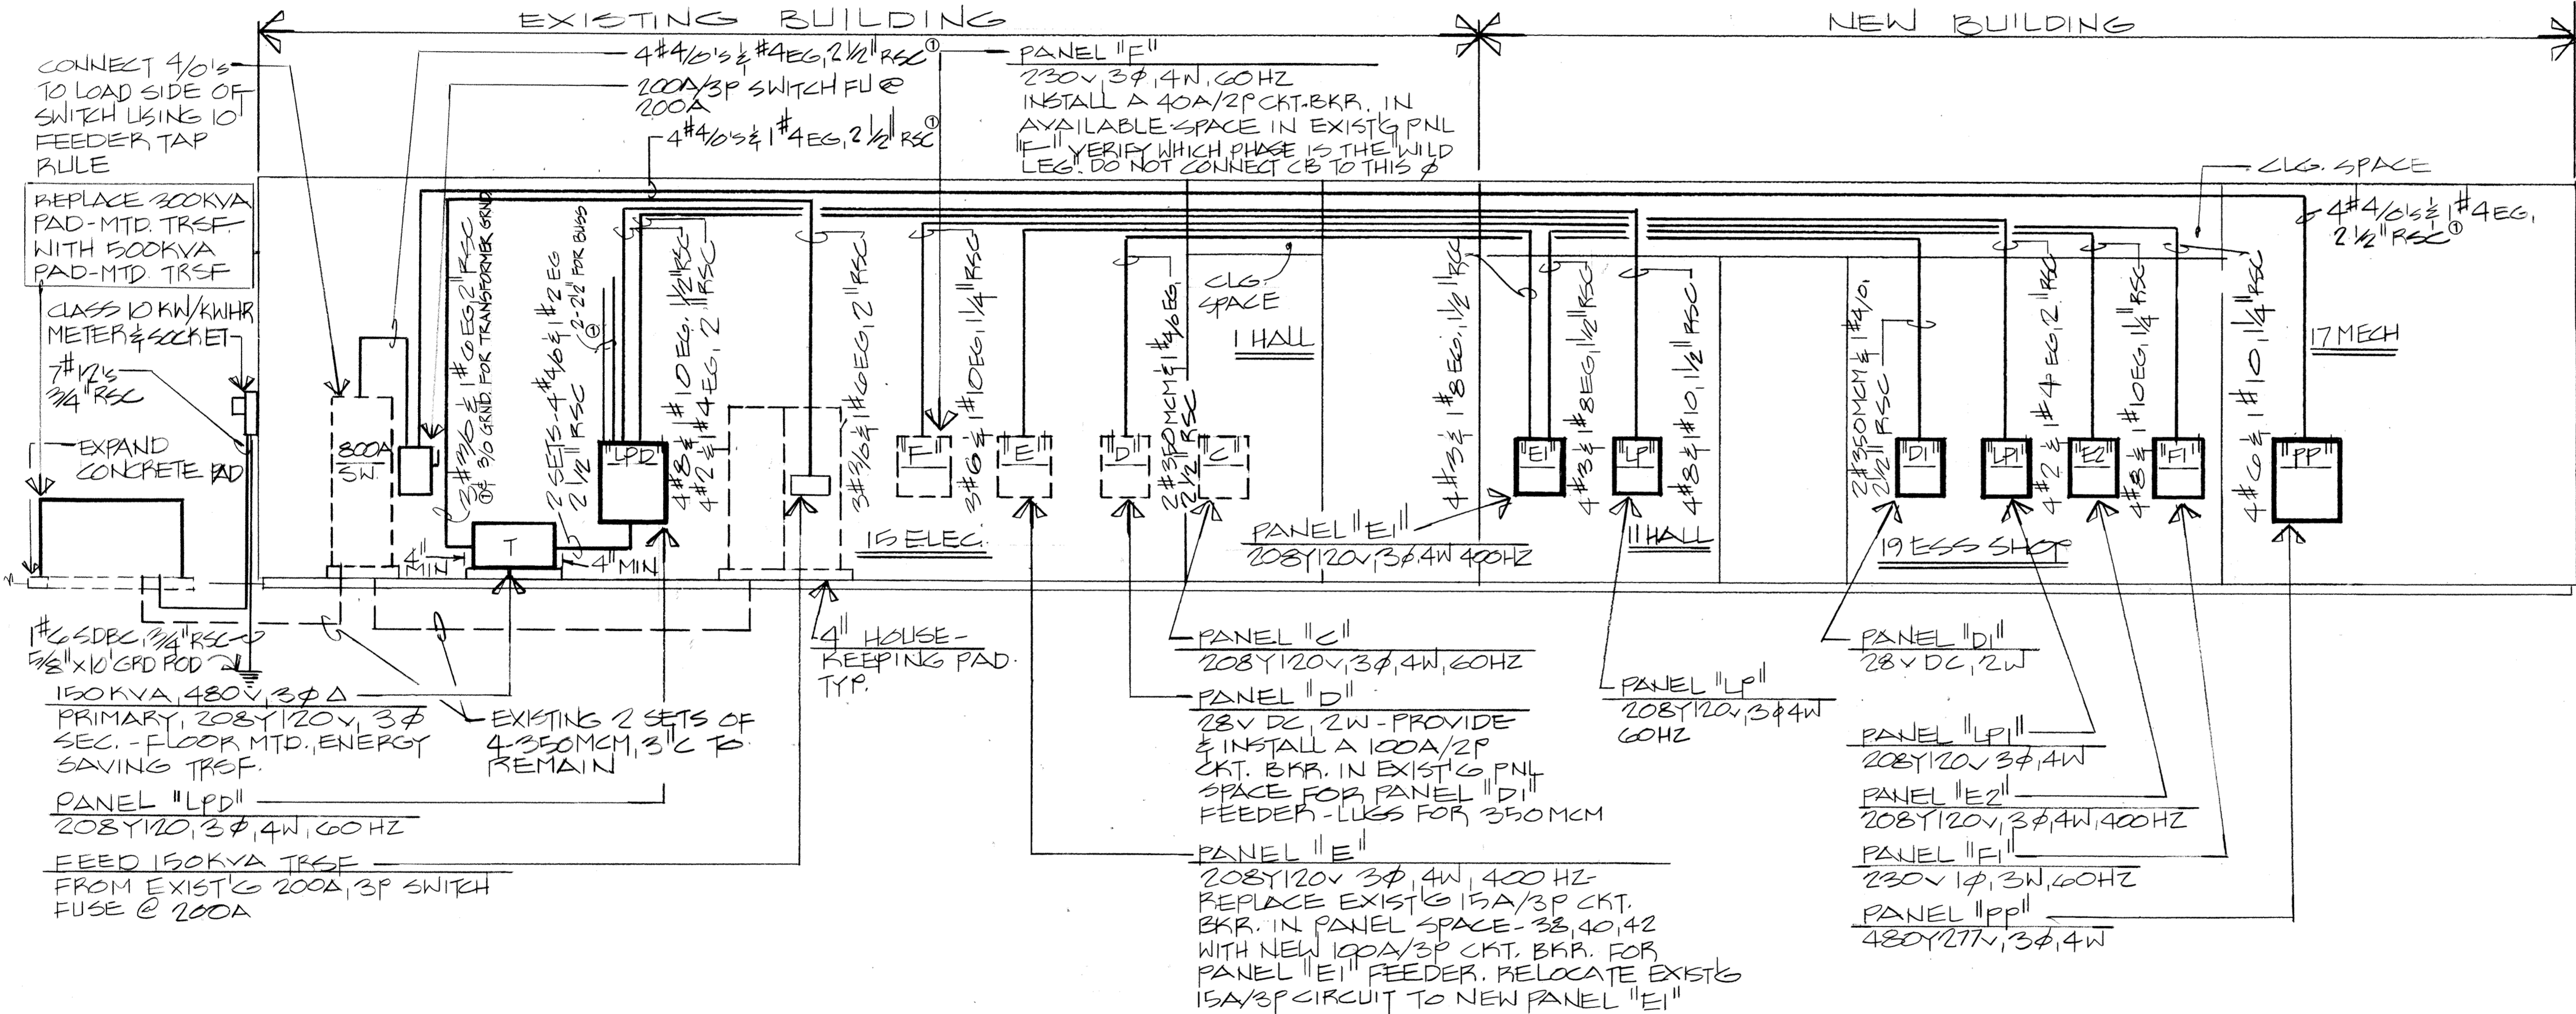

POWER RISER DIAGRAM



NTS

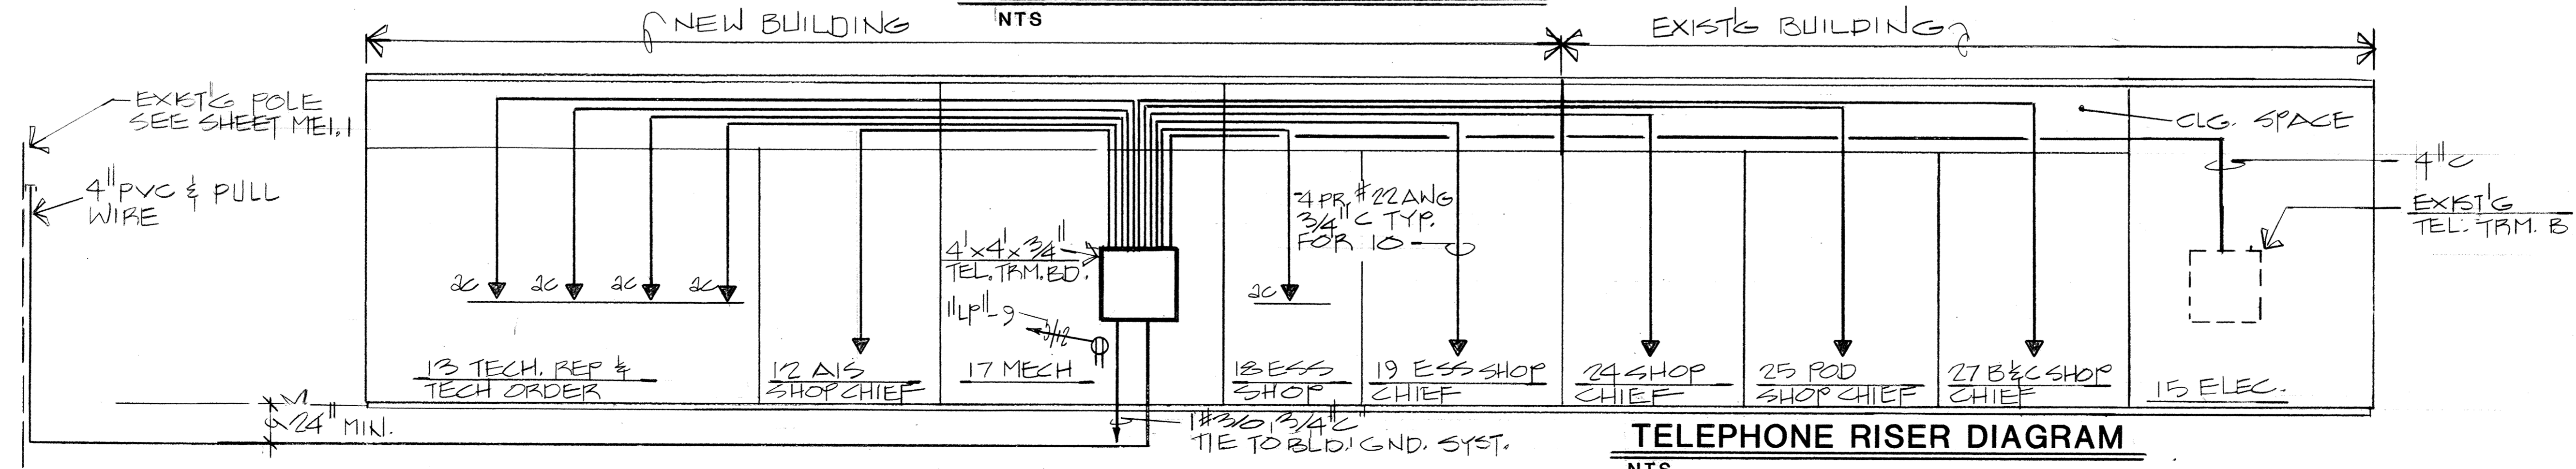

TELEPHONE RISER DIAGRAM

NTS

MM MG
Mott Mobley McGowan & Griffin, P.A.: Architects
302 North Sixth Street
Fort Smith, Arkansas 72901

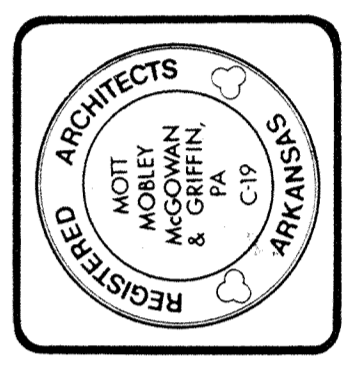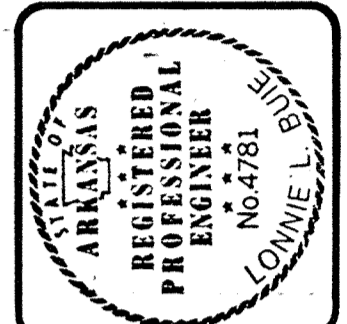

PROJECT NO. FSM-40997
ADD./ALTER AVONICS/ECM POD SHOP/STORAGE
AIR NATIONAL GUARD TRAINING FACILITY
MUNICIPAL AIRPORT - FT. SMITH, ARKANSAS

RISER DIAGRAMS

As-built info: 4-12-90 ①	E1.3
Revisions	
1357	Plan Number
11-16-88	Date

BRUNING 40 77 8331