

**ABBREVIATIONS**

- R.F. - RADIO FREQUENCY
- D.I. - DISPLAY ANALYZER
- P.P. - PROCESSORS / PNEUMATICS
- C.I. - COMPUTER / INFERTIAL TEST STATION


**EQUIPMENT**

- ① WORK BENCH
- ② CONTROL CONSOL
- ③ R.F. TEST STATION
- ④ RADAR ANTENNA HOLDING FIXTURE
- ⑤ ITA STORAGE CABINETS
- ⑥ D.I. TEST STATION
- ⑦ PHOTO ANALYZER SYSTEM
- ⑧ EPROM PROGRAMMER / VERIFYER
- ⑨ P.P. TEST STATION
- ⑩ C.I. TEST STATION
- ⑪ RATE TABLE
- ⑫ INU PEDESTAL
- ⑬ DISC STORAGE CABINET
- ⑭ NOT USED
- ⑮ NOT USED
- ⑯ COMPRESSED AIR BOTTLES
- ⑰ ROLL-AROUND WORK TABLES
- ⑱ STORAGE CABINETS

EQUIPMENT PLAN @ 1/8" = 1'-0"

**MM  
MG**

Mott Mobley McGowan & Griffin, P.A., Architects  
302 North Sixth Street  
Fort Smith, Arkansas 72901

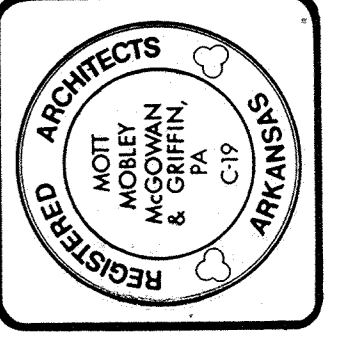

CONTRACT NO. DAH403 - 87 - C - 7 0007  
PROJECT NO. FSM-40997  
**ADD./ALTER AVONICS/ECM POD SHOP/STORAGE**  
AIR NATIONAL GUARD TRAINING FACILITY  
MUNICIPAL AIRPORT - FT. SMITH, ARKANSAS

EQUIPMENT  
PLAN

Revisions	
1357	F1.1
Plan Number	
11-16-88	Or 28
Date	