
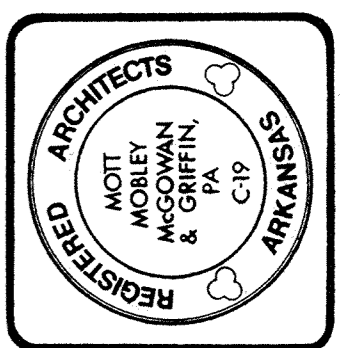


NOTES:

- EXISTING PNEUMATIC RELEASE & PIPING
- EXISTING SPRINKLER HEAD & PIPING
- NEW PNEUMATIC RELEASE & PIPING
- NEW SPRINKLER HEAD & PIPING

SPRINKLER PLAN @ 1/8" = 1'-0"

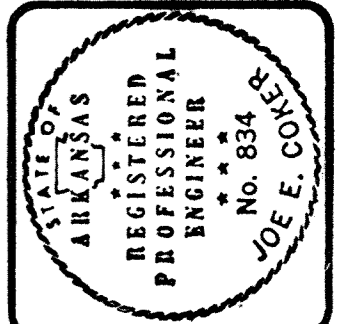

CONTRACT NO. D44A03 - 87 - C - 0007
 PROJECT NO. FSM-40997
ADD./ALTER AVONICS/ECM POD SHOP/STORAGE
 AIR NATIONAL GUARD TRAINING FACILITY
 MUNICIPAL AIRPORT - FT. SMITH, ARKANSAS

SPRINKLER PLAN

Revisions	
1357	M1.3
11-16-88	
Date	of 28