

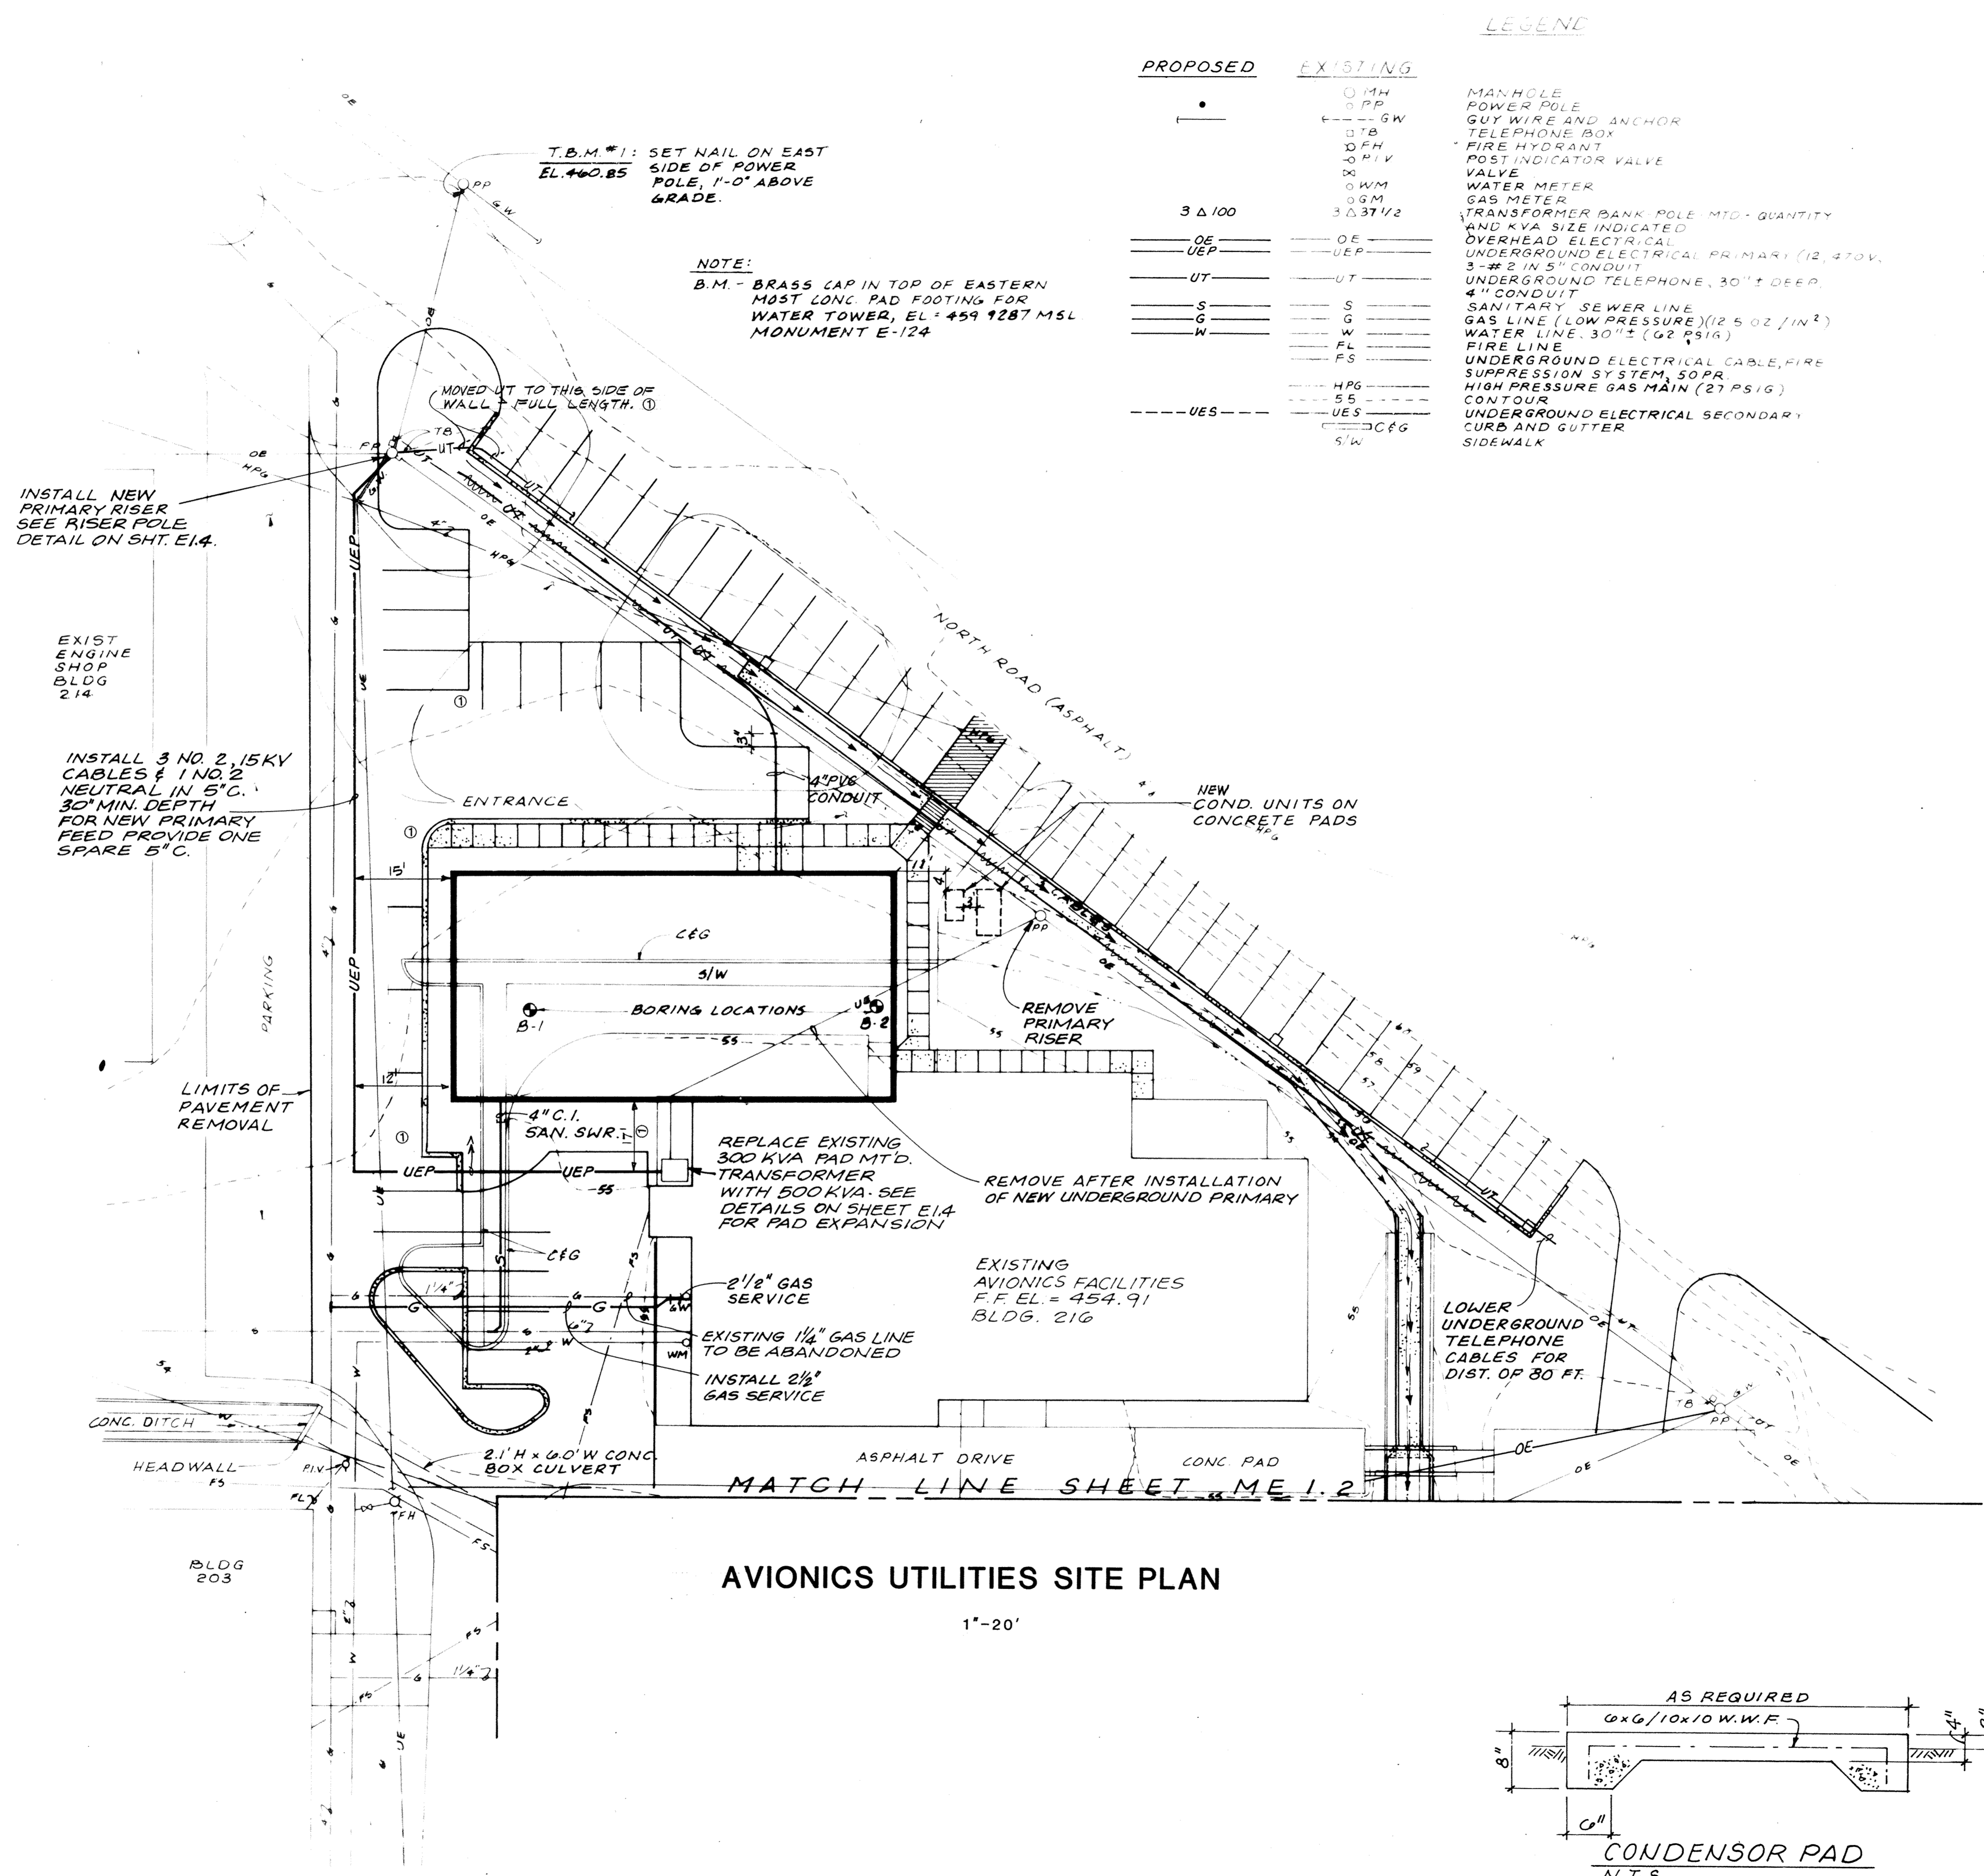


BRUNING 40 22 8537

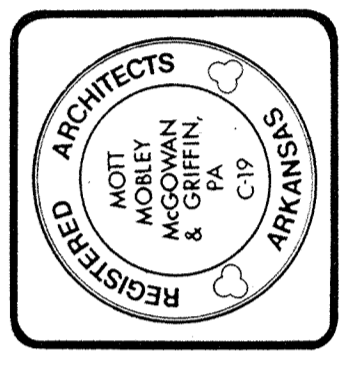

MM MG

Mott Mobley McGowan & Griffin, P.A.: Architects
Fort Smith, Arkansas 72901
302 North Sixth Street

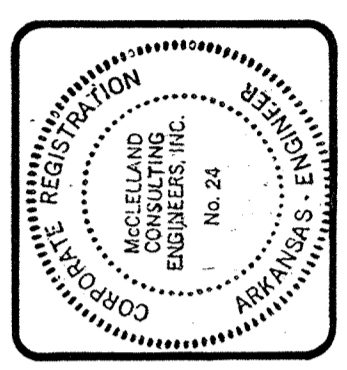


CONTRACT NO. DAH403 - 87 - C - 0007

PROJECT NO. FSM-40997

ADD./ALTER AVIONICS/ECM POD SHOP/STORAGE

AIR NATIONAL GUARD TRAINING FACILITY
MUNICIPAL AIRPORT - FT. SMITH, ARKANSAS

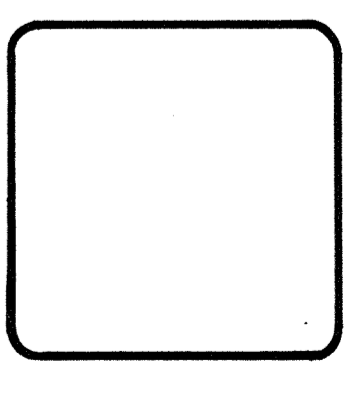

As-built info:
4-12-90 ①

Revisions

1357	ME1.1
11-16-88	
Date	Of