


MATCH LINE SHEET ME 1.1

**AIS/MF PAD AND PARKING LOT UTILITIES SITE PLAN**



SEE SHEET C1.2 FOR LEGEND

1"=20'

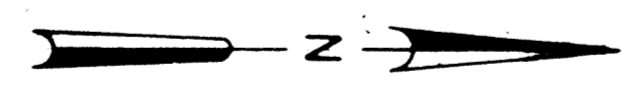

ADDITIVE #2: INCLUDES ALL ELECTRICAL WORK, GROUNDING, TRANSFORMER POLE, SHOWN FOR AIS/MF PAD.

- NOTES:**
1. REMOVE 35' CLASS 4 POLE, CROSSARMS, PRIMARY DEAD ENDS, NEUTRAL DEAD END, CUTOUPS, ARRESTERS, PIN INSULATOR, 3-37 1/2" KVA TRSFRS, DOWN GUY ANCHOR ROD, 60A/2P SWITCH & 100A/3P SWITCH. CUT ANCHOR ROD BELOW GRADE. KEEP THIS POLE IN SERVICE UNTIL NEW POLE IS CONSTRUCTED.
  2. INSTALL NEW TRANSFORMER POLE. SEE DETAIL ON SHEET E1.4

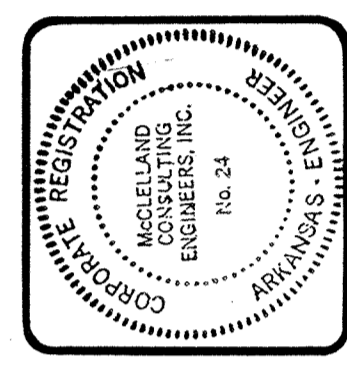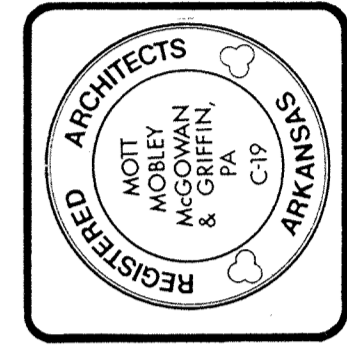

CONTRACT NO. DAHA03-87-C-10007  
 PROJECT NO. FSM-40997  
**ADD./ALTER AVIONICS/ECM POD SHOP/STORAGE**  
 AIR NATIONAL GUARD TRAINING FACILITY  
 MUNICIPAL AIRPORT - FT. SMITH, ARKANSAS

UTILITIES  
 SITE PLAN

As-built info: 4-12-90 ①	
Revisions	
1357 Plan Number	ME 1.2
11-16-88 Date	Or 28