


ELECTRICAL RM. 8

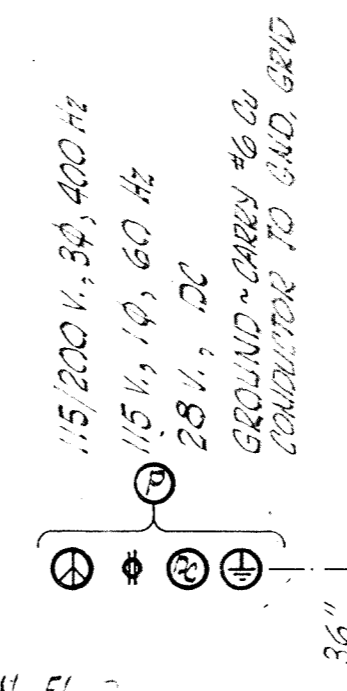

FIN. FL. 2

OUTLETS AS INDICATED BY SYMBOL "P" (TYP)

FLOOR PLAN 1/8" = 1'-0"

- NOTES:
1. CIRCUIT & SWITCH EXHAUST FAN WITH LIGHTS.
 2. THIS 115, 200V-30-400 Hz REVERTABLE TO BE NEMA 15-50R INSTEAD OF 15-15R
 3. THIS EQUIPMENT IS TO BE GOVERNMENT FURNISHED AND CONTRACTOR INSTALLED.
 4. MT. ALL DISCONNECT SW'S @ 4'-0" A.L.F.

