


SITE SYMBOLS & ABBREVIATIONS	
-56	EXISTING CONTOUR ELEVATION.
-50	NEW CONTOUR ELEVATION.
T.W. 55.0	TOP OF WALL ELEVATION.
E 56.90	EXISTING ELEVATION.
FL 52.90	NEW FLOW LINE ELEVATION.
T.O.W.	TOP OF WALL.
E FL	EXIST. FLOW LINE ELEVATION.

SITE PLAN N
1" = 1'-0"

MM MG
Mott Mobley McGowan & Griffin, P.A.: Architects
302 North Sixth Street
Fort Smith, Arkansas 72901

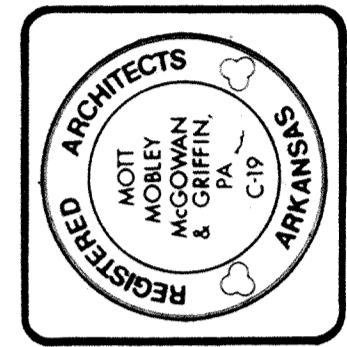

PROJECT NO. HRFZ929948
ADD./ ALTER. ECM POD SHOP
AIR NATIONAL GUARD TRAINING FACILITY
MUNICIPAL AIRPORT - FT. SMITH, ARKANSAS

SITE PLAN
(1" = 10')
& DETAILS

Revisions	1440	A1.1
Plan Number	7-30-93	
Date		