
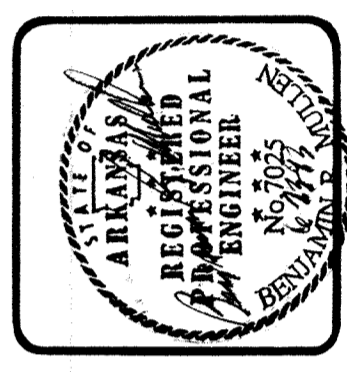



| FIXTURE SCHEDULE | | | | |
|------------------|--|------------|-----------------|------|
| TYPE | DESCRIPTION | LAMPS | REMARKS | VOLT |
| A | WILLIAMS # 8125 1/2 WIREGUARD REFLECTOR | 4-F40 CWRS | 8' FLUOR. STRIP | 277 |
| A1 | WILLIAMS # 8125 1/2 WIREGUARD & REFECTOR & EM. BAT. BACKUP | 4-F40 CWRS | 8' FLUOR STRIP | 277 |

FLOOR PLAN-LIGHTING

SCALE: 1/8"=1'-0"
(SEE ALSO DWG A-1 - REFL. CLG. PLAN)

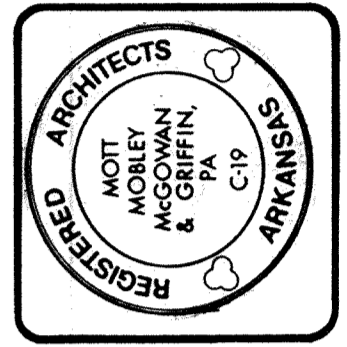

CONTRACT NO. DAHA03-93-R-0001
PROJECT NO. HKRZ929948
ADD./ ALTER. ECM POD SHOP
AIR NATIONAL GUARD TRAINING FACILITY
MUNICIPAL AIRPORT - FT. SMITH, ARKANSAS

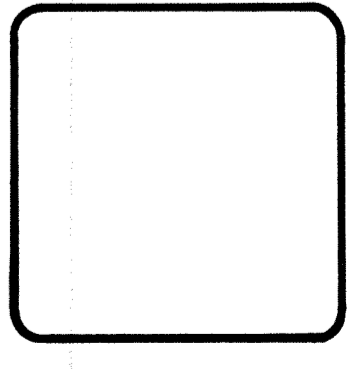

| | |
|-------------|------------|
| Revisions | |
| Plan Number | E-2 |
| Date | 7-30-93 |