



1 DETAIL
1 1/2" = 1'-0"

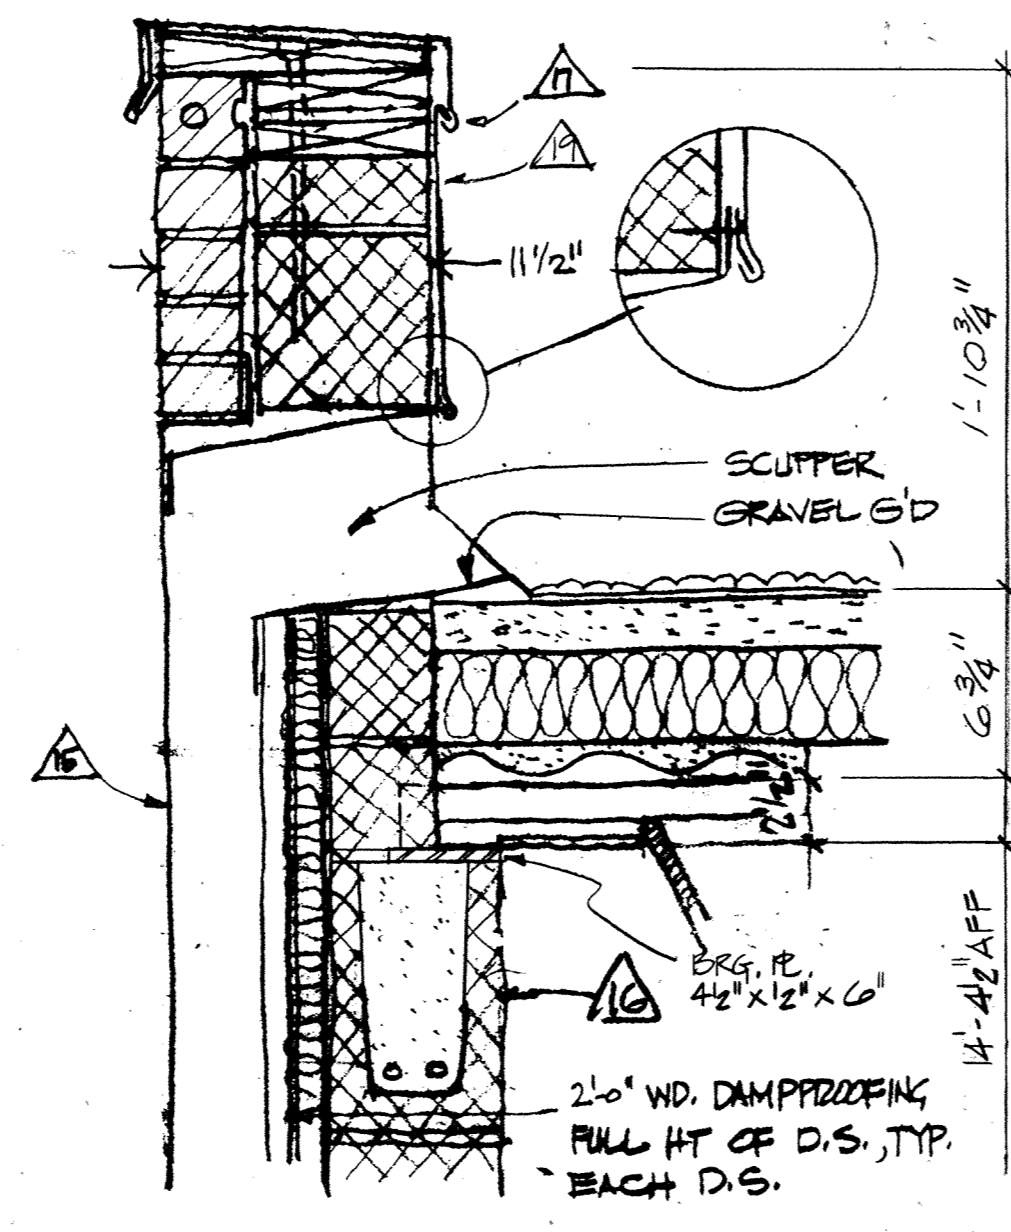


2 DETAIL
1 1/2" = 1'-0"

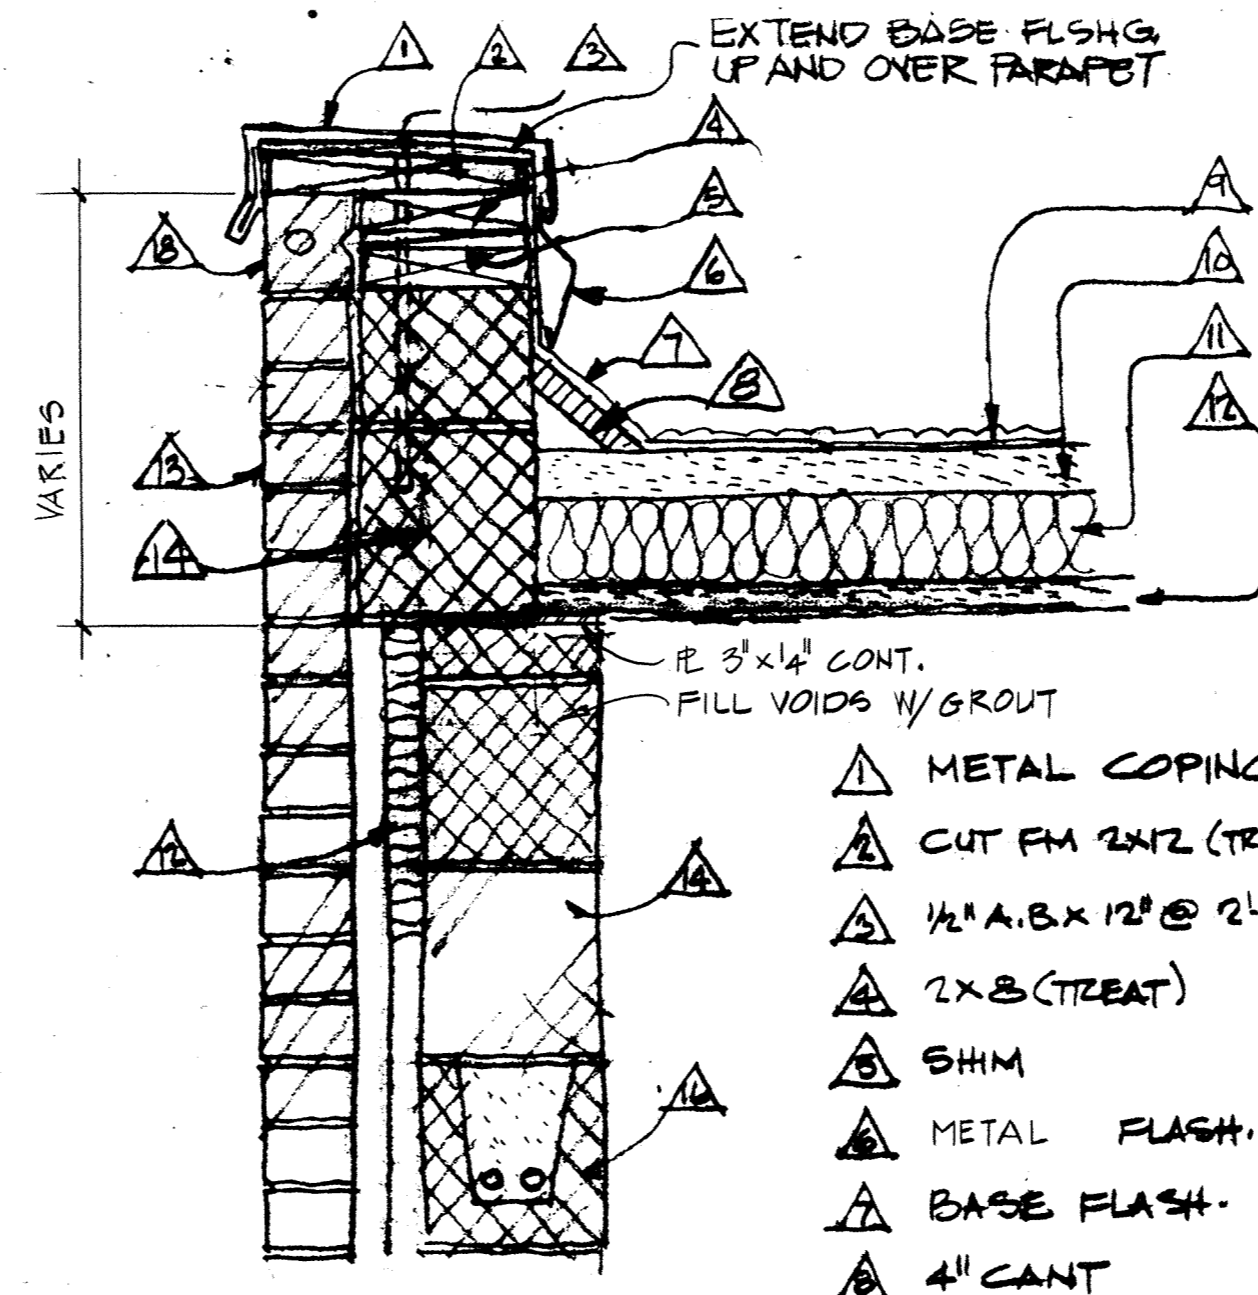


3 DETAIL
1 1/2" = 1'-0"


- ▲ METAL COPING
- ▲ CUT FM 2x12 (TREAT)
- ▲ 1/2" A.B. x 12" @ 2'-8" O.C.
- ▲ 2x2 (TREAT)
- ▲ SHM
- ▲ METAL FLASH
- ▲ BASE FLASH
- ▲ 4" CANT
- ▲ MEMBRANE ROOF
- ▲ INSUL. CONC. (2" MIN.)
- ▲ RIGID INSUL (3 1/2")
- ▲ MTL CENTERING
- ▲ FACE BRICK
- ▲ LWC BLOCK
- ▲ DOWNSPOUT
- ▲ CONT. BOND BEAM W/ 2x5
- ▲ SCREENS W/ NEOPRENE WASHERS @ 1'-0" O.C.
- ▲ BRICK RONALOCK
- ▲ STANDING SEAM MTL. P&H @ 8" TO 10" O.C. MAX. (COPPER)

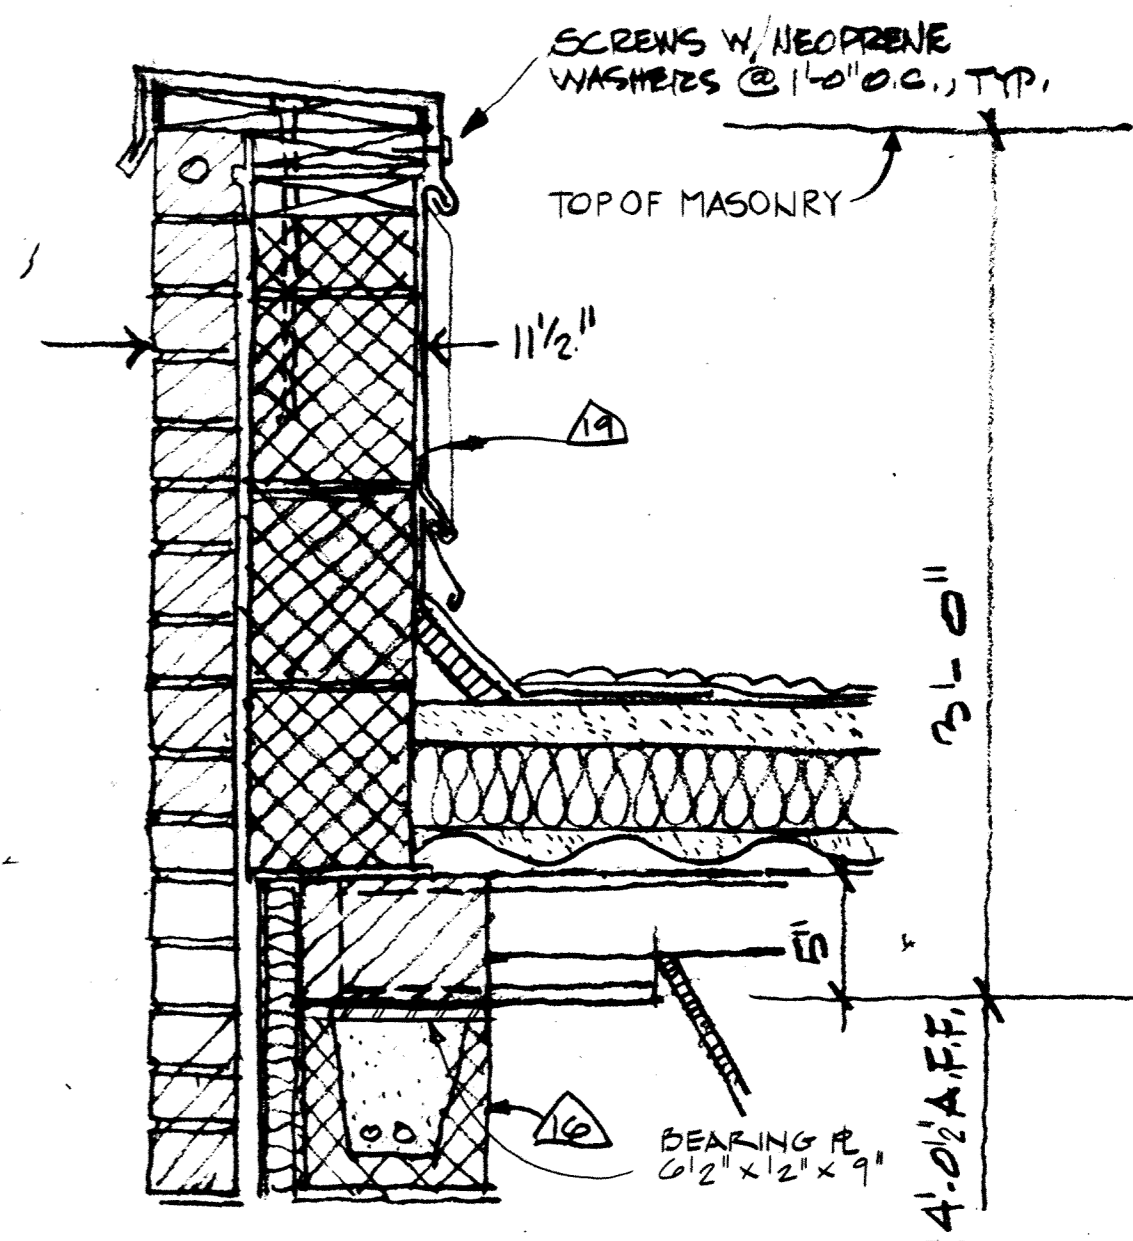


4 DETAIL
1 1/2" = 1'-0"

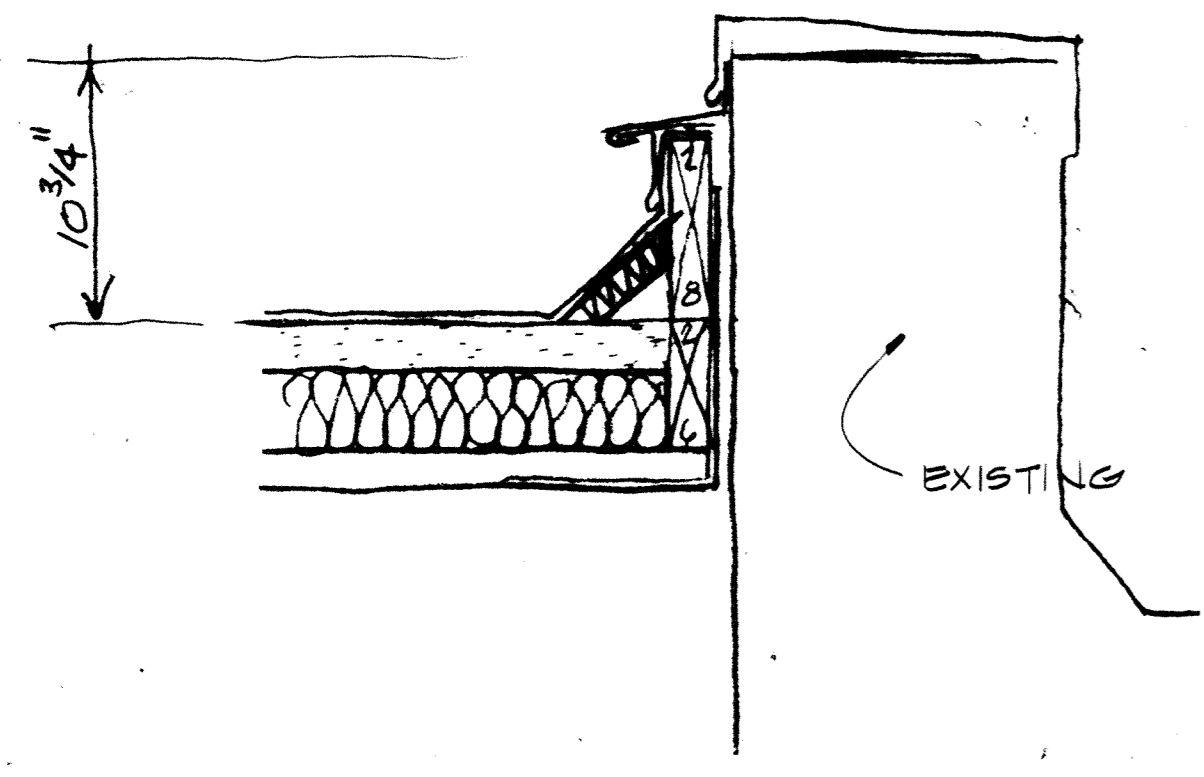


5 DETAIL
1 1/2" = 1'-0"

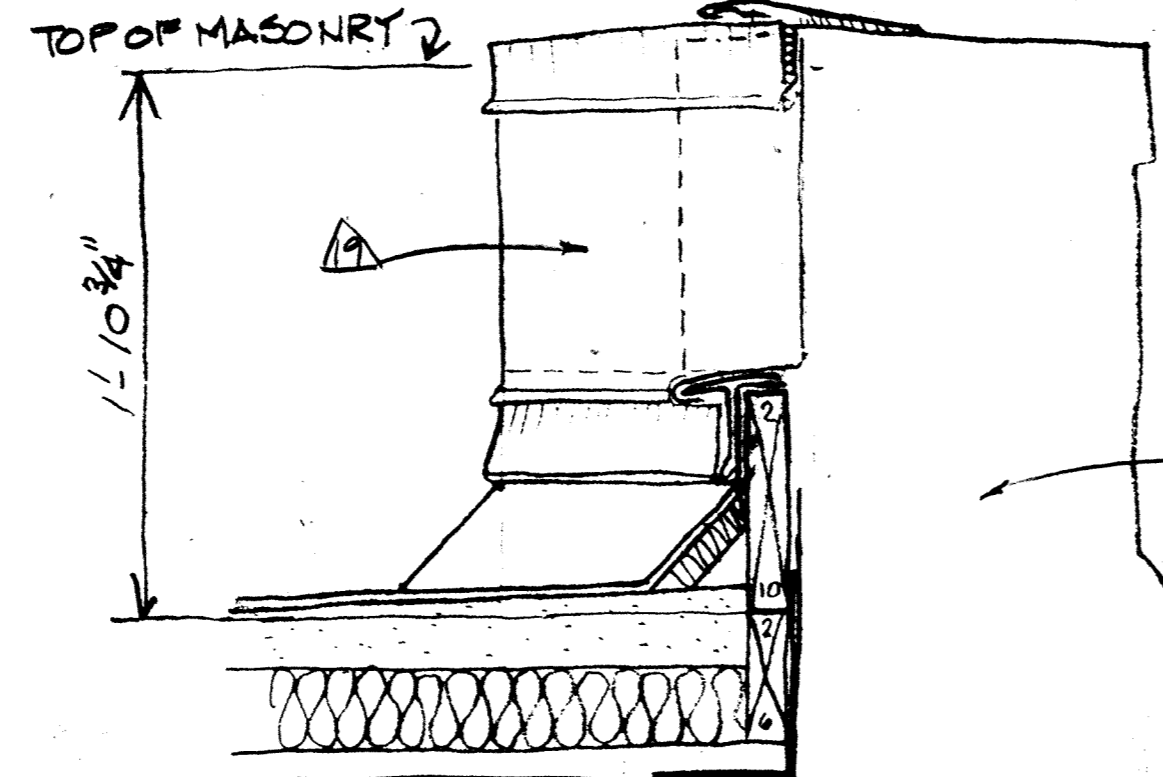


6 DETAIL
1 1/2" = 1'-0"

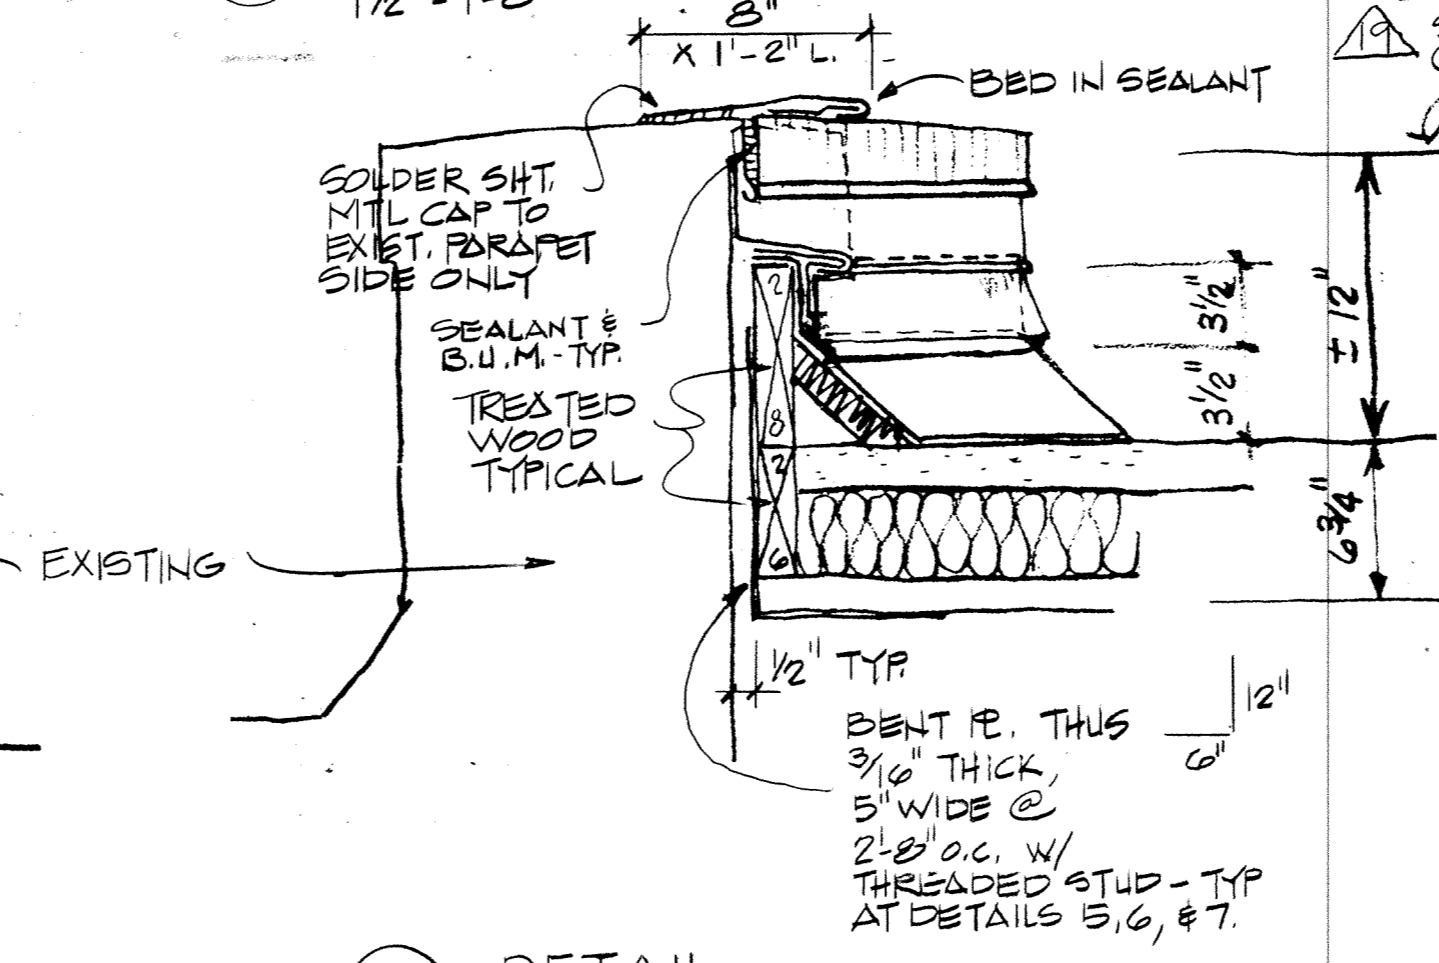


7 DETAIL
1 1/2" = 1'-0"

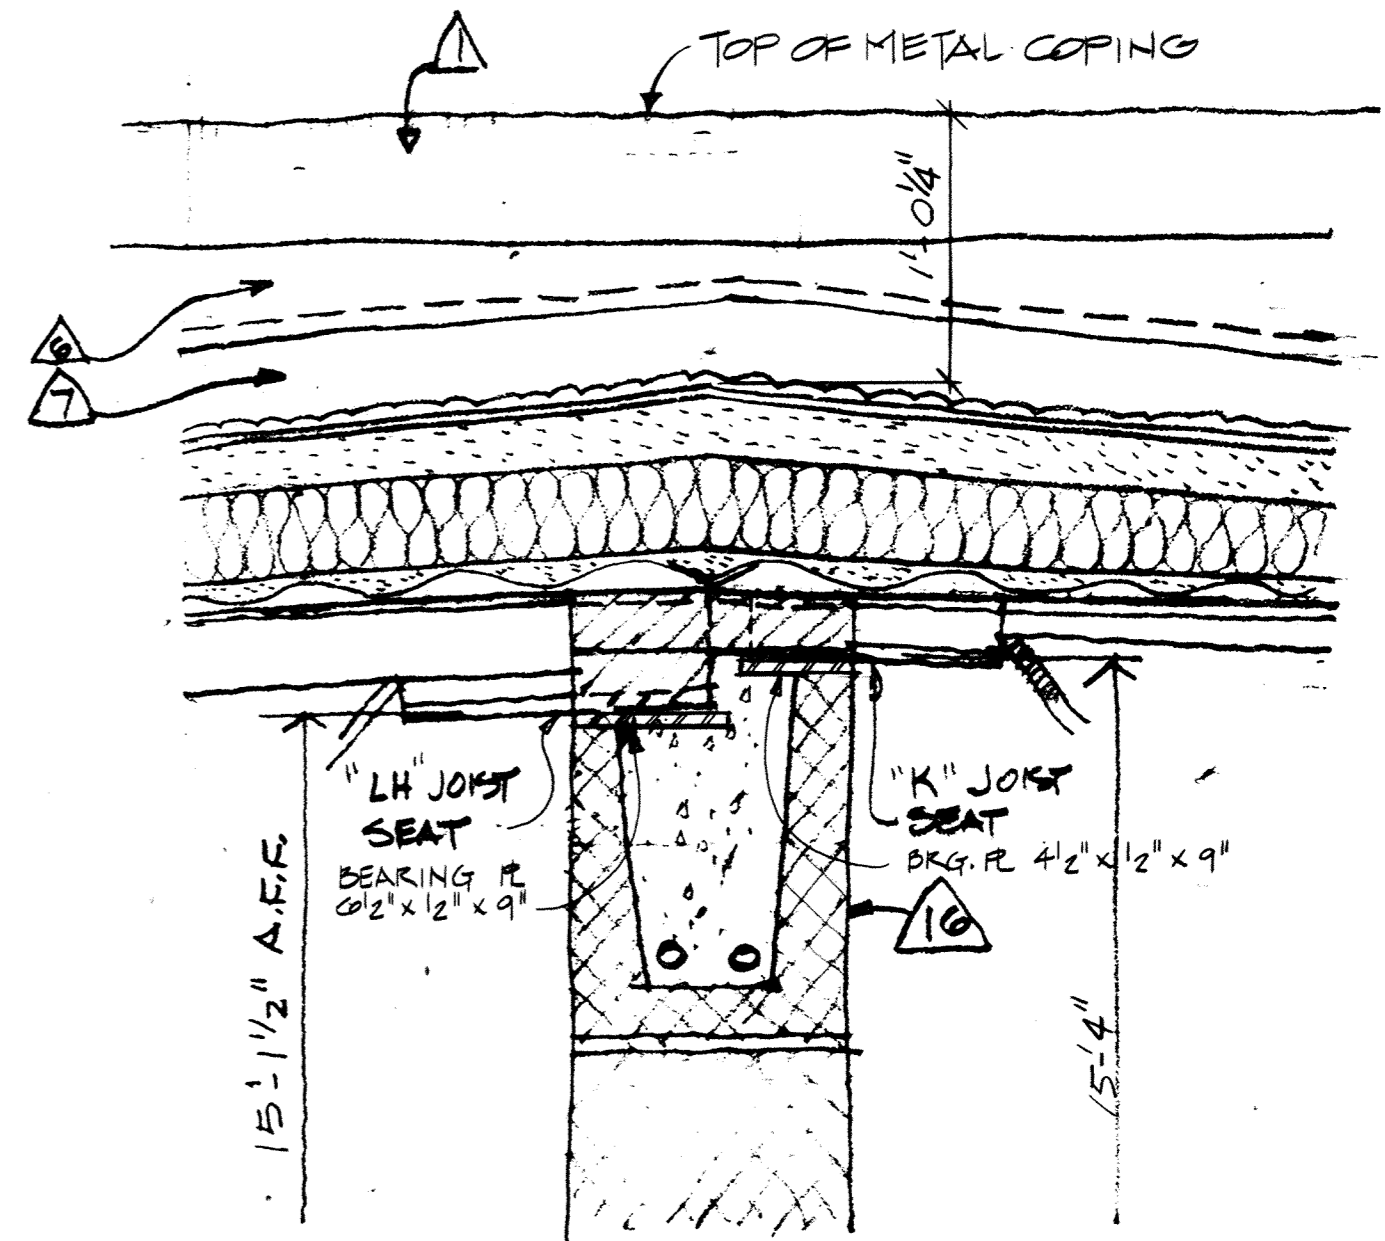


8 DETAIL
1 1/2" = 1'-0"

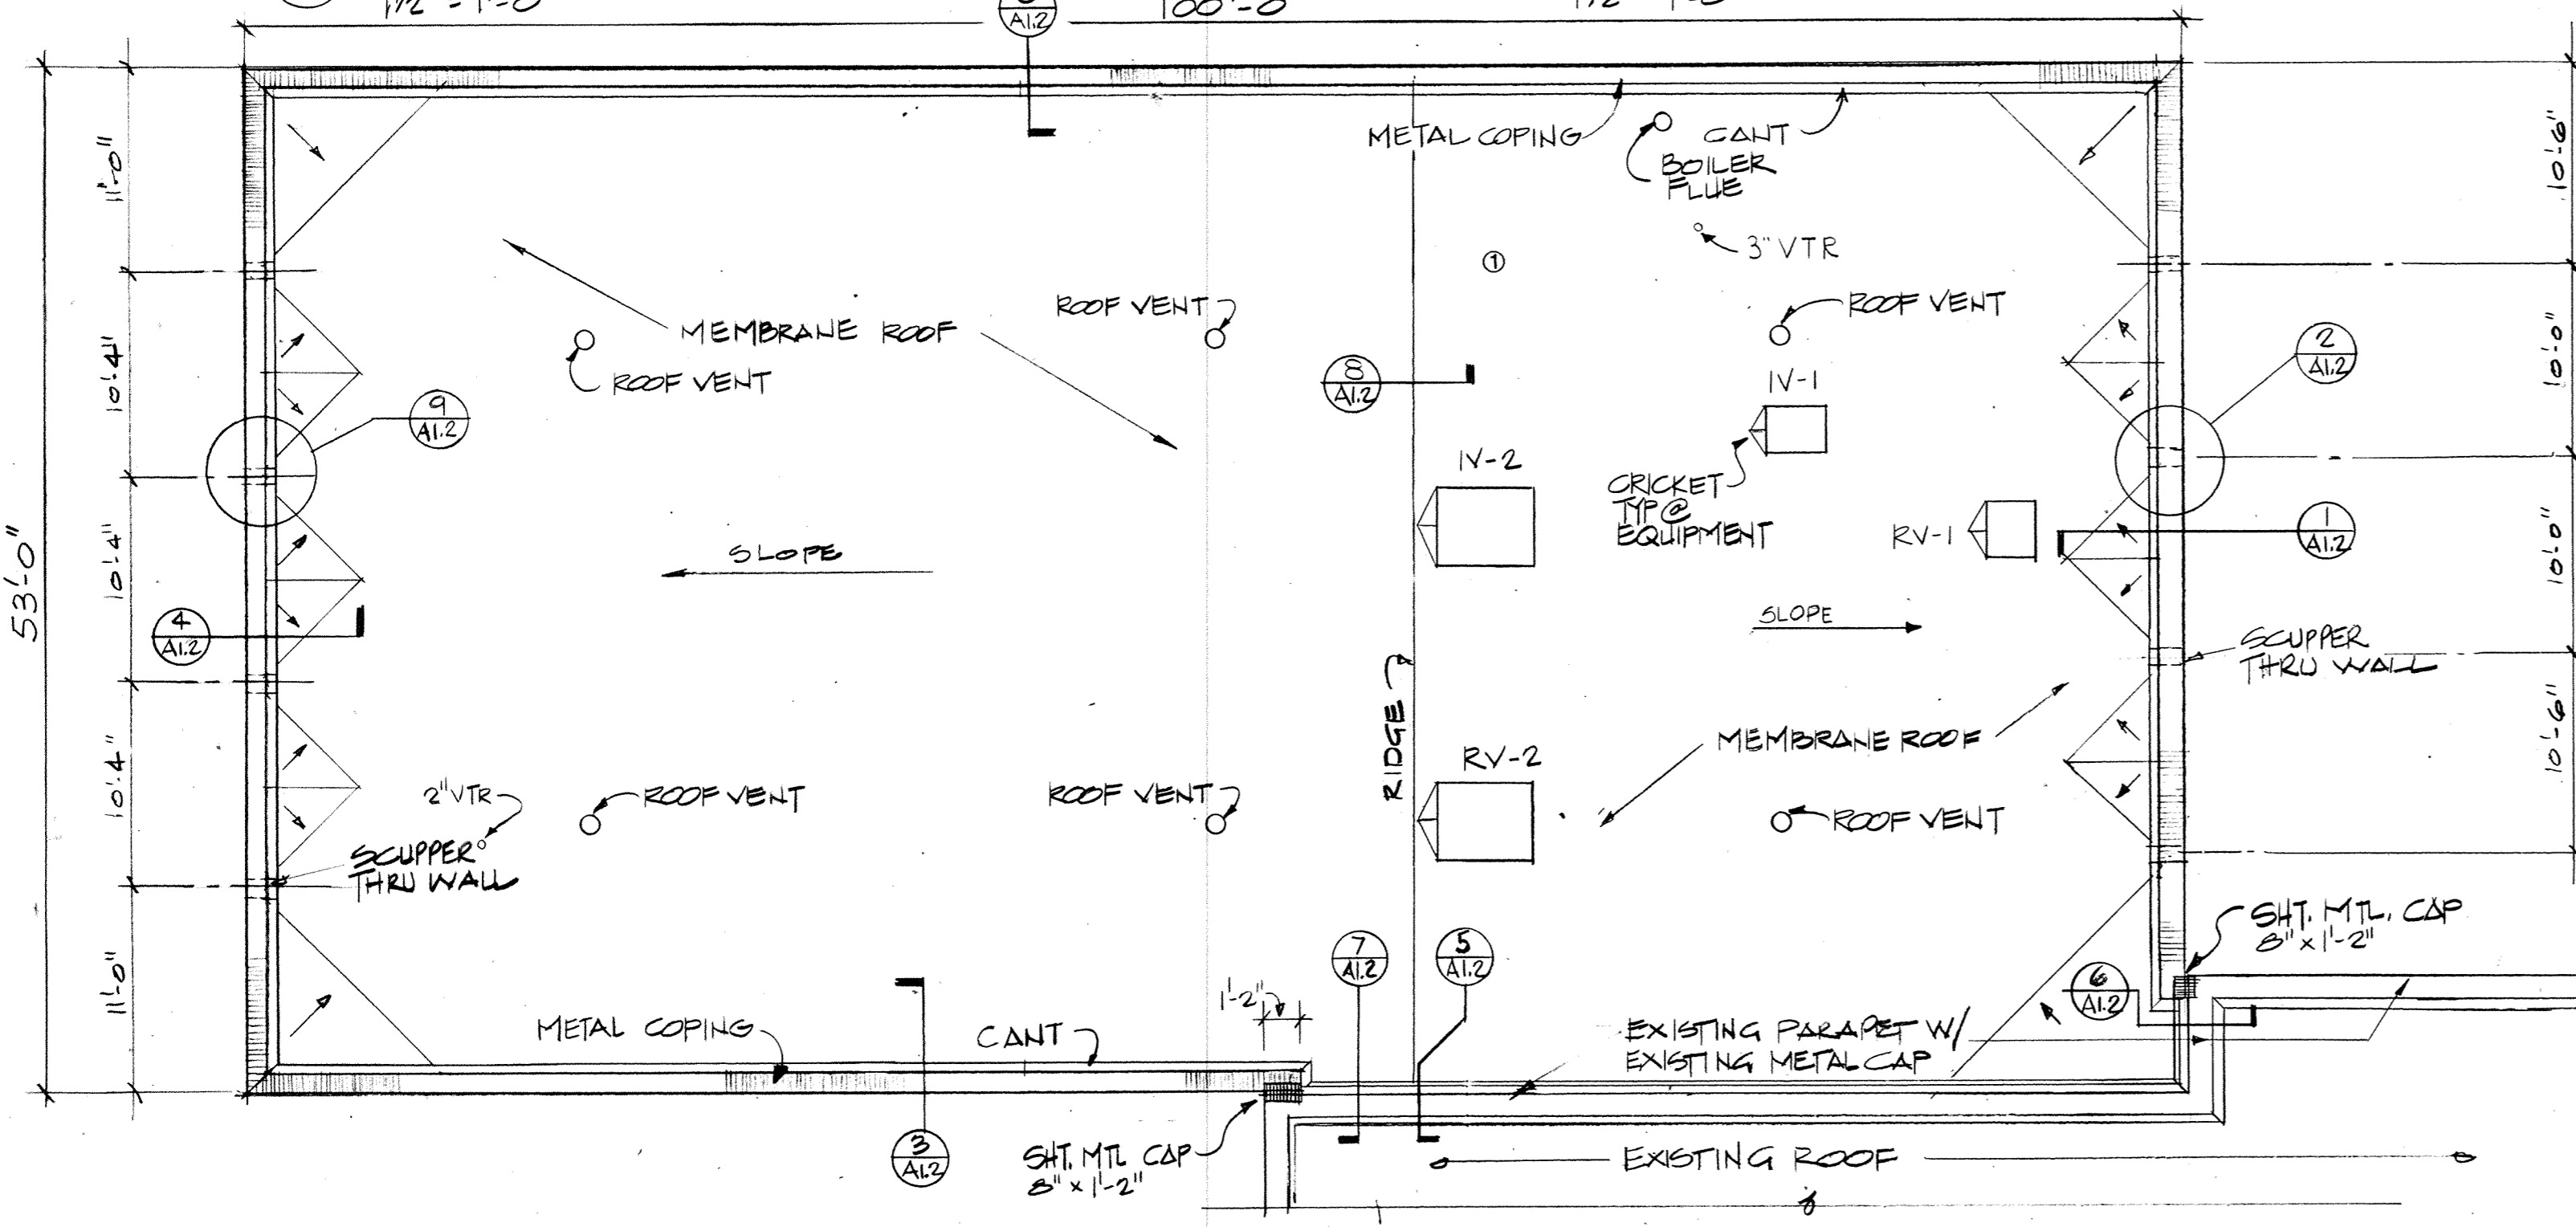


ROOF PLAN
1/8" = 1'-0"

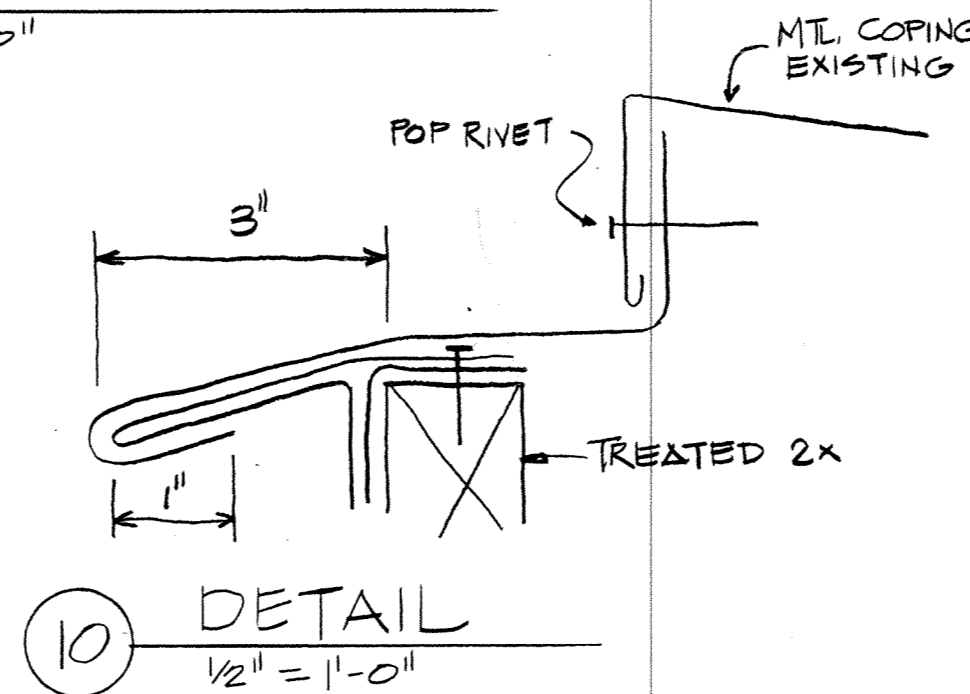

10 DETAIL
1 1/2" = 1'-0"

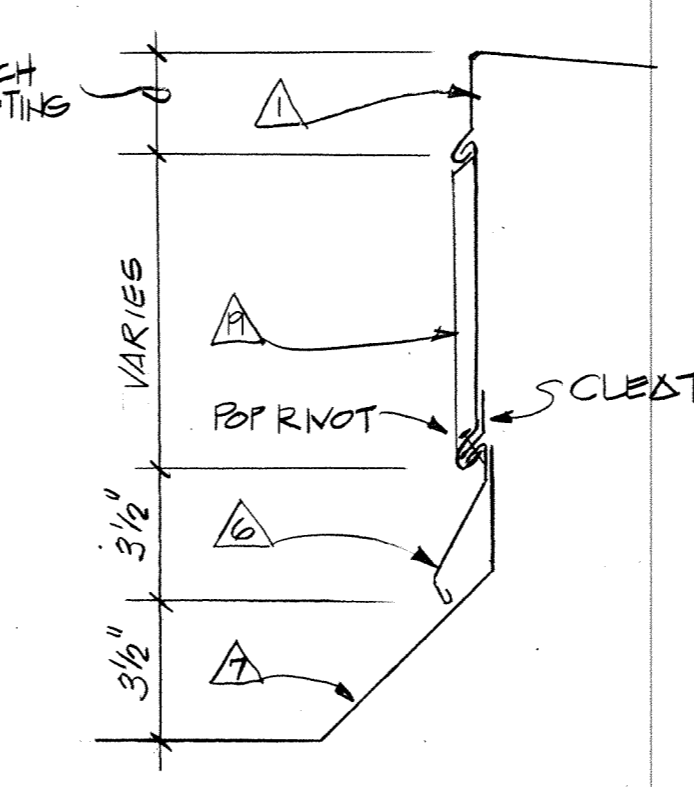

11 TYPICAL FLASHING DETAIL

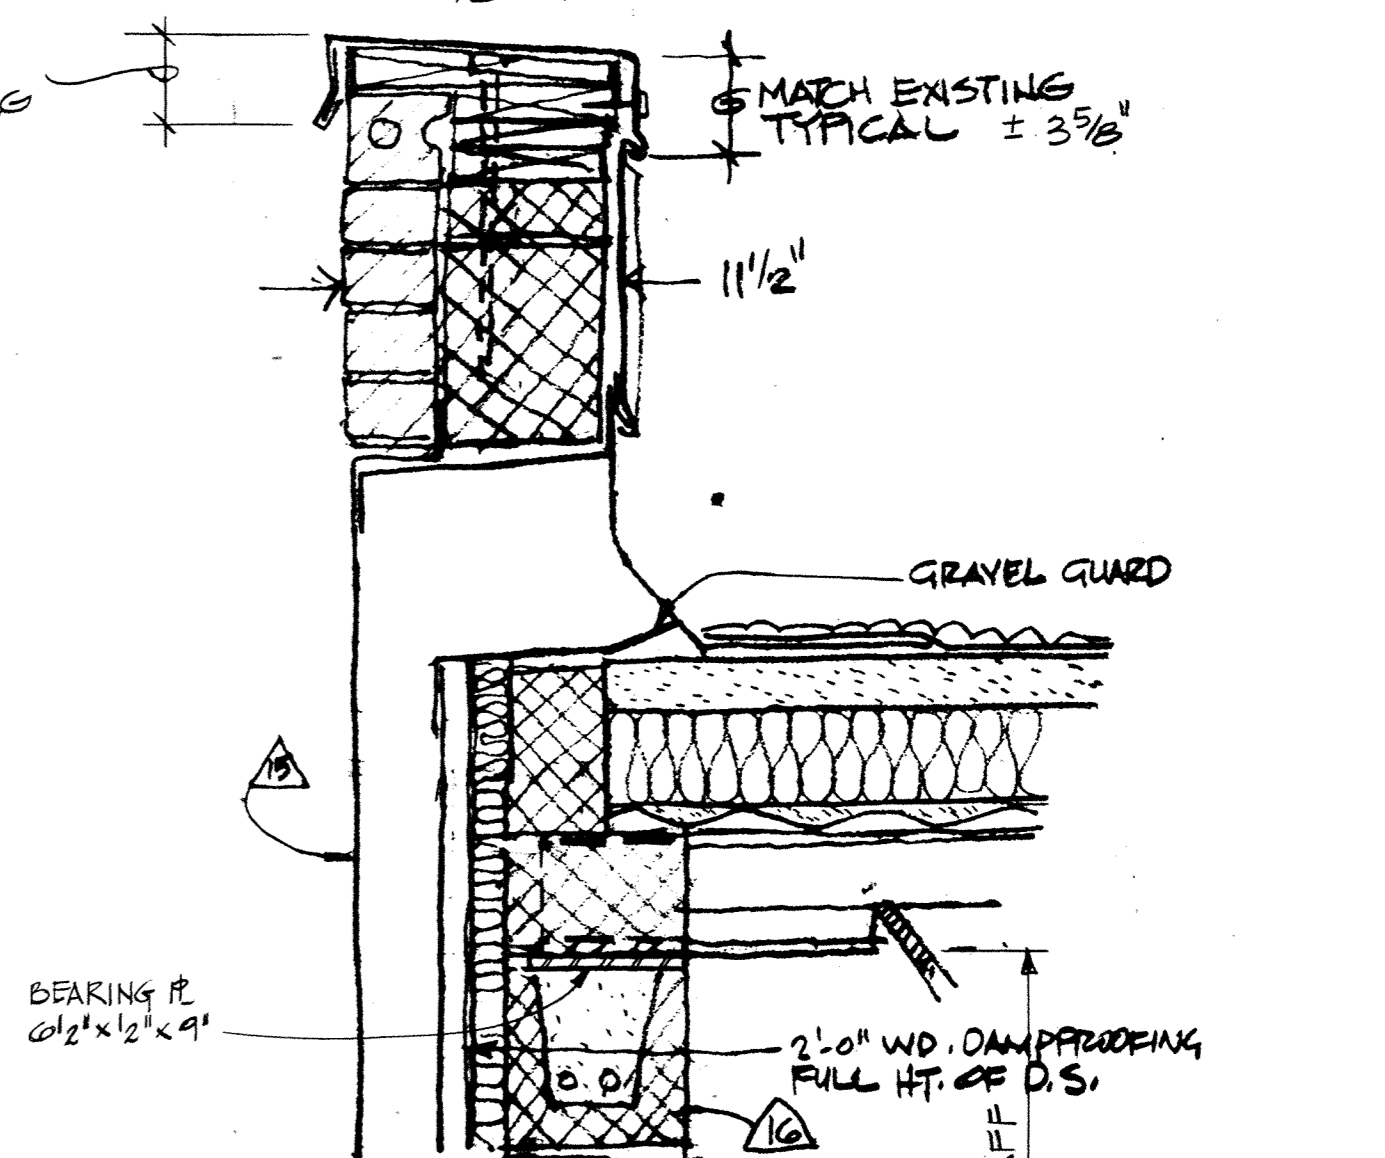

9 DETAIL
1 1/2" = 1'-0"