

**WILLIAM J. CLINTON  
PRESIDENTIAL  
CENTER**

LITTLE ROCK, ARKANSAS

Architect  
POLSHAK PARTNERSHIP LLP  
320 West 13th Street  
New York, New York 10014  
212 807 7171

Coordinating Architects  
POLK STANLEY YEARY ARCHITECTS LM  
700 South Scholar Street  
Little Rock, Arkansas 72201  
501 378 0878

WITSELL EVANS RASCO  
901 West Third Street  
Little Rock, Arkansas 72201  
501 374 5300

WOODS CARADINE ARCHITECTS  
2200 South Main Street  
Little Rock Arkansas 72206  
501 374 4060

Landscape Architects  
HARGREAVES ASSOCIATES  
118 Magazine Street  
Cambridge, Massachusetts 02139  
617 651 0070

LANDSCAPE ARCHITECTURE, Inc.  
2300 Cottondale Lane Suite 202  
Little Rock Arkansas 72202  
501 374 5610

Structural Engineer  
LESLIE E. ROBERTSON ASSOC., RLLP  
30 Broad Street, 47th Floor  
New York, New York 10004  
212 750 9000

MEP Engineers  
FLACK + KURTZ Inc  
475 Fifth Avenue  
New York, New York 10017  
212 532 9600


CROMMELL ARCHITECTS ENGINEERS  
101 South Spring Street  
Little Rock, Arkansas 72201  
501 372 2900

Curtainwall Consultant  
R. A. HEINTGES ARCHITECTS  
126 Fifth Avenue 9th Floor  
New York, New York 10011  
212 652-2966

Seal



100% Construction Documents	09/27/02
90% Progress Printing	08/30/02
100% Struct/JCD Progress	07/01/02
Issue	Date

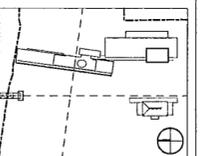


Job No 9908  
Scale 1/4" = 1'-0"  
Date September 27, 2002  
Title

**INTERIOR ELEVATIONS  
ARCHIVE**


Sheet No

**A431**


**FOR OFFICIAL USE ONLY**

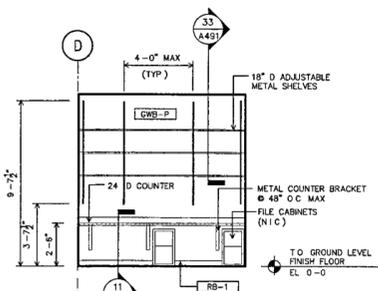


1-14 EDUCATION SPECIALIST LOOKING NORTH  
SCALE 1/4" = 1'-0" (33)

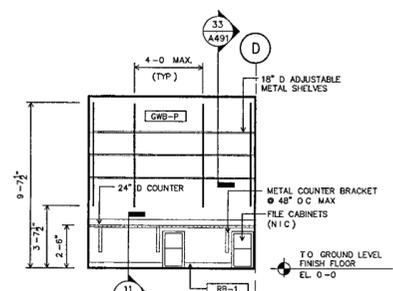


1-15 VOLUNTEER COORDINATOR LOOKING SOUTH  
SCALE 1/4" = 1'-0" (32)

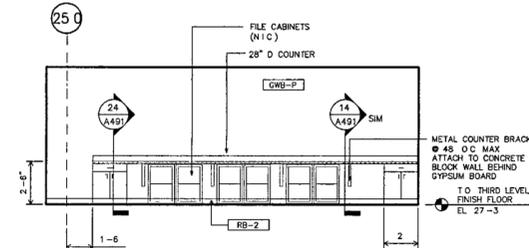


3-23 FILE/COPY/FAX & SUPPLY ROOM LOOKING EAST  
SCALE 1/4" = 1'-0" (31)

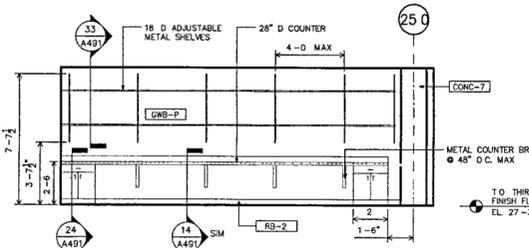


3-23 FILE/COPY/FAX & SUPPLY ROOM LOOKING WEST  
SCALE 1/4" = 1'-0" (30)

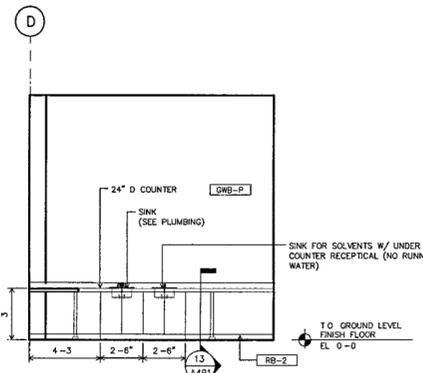


1-41 PAINT STUDIO LOOKING NORTH  
SCALE 1/4" = 1'-0" (23)

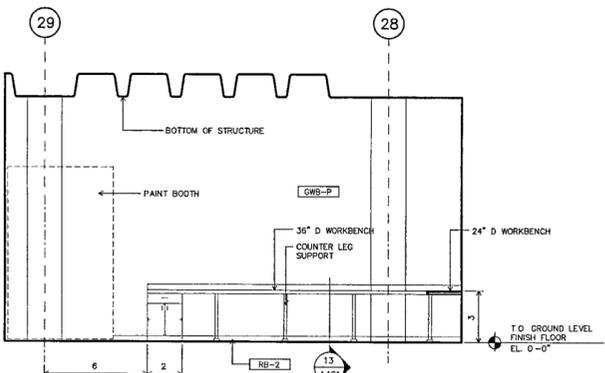


1-41 PAINT STUDIO LOOKING WEST  
SCALE 1/4" = 1'-0" (22)

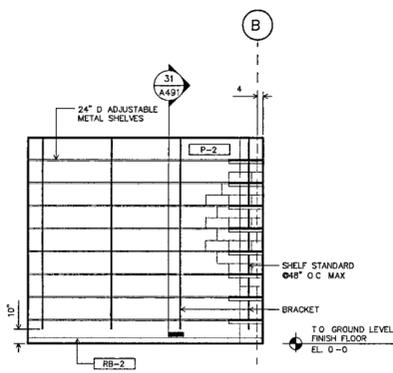


1-27 STORAGE LOOKING SOUTH  
SCALE 1/4" = 1'-0" (21)

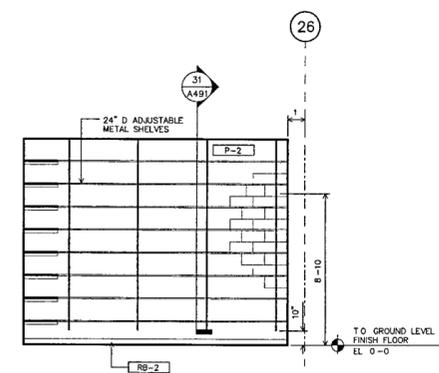


1-27 STORAGE LOOKING WEST  
SCALE 1/4" = 1'-0" (20)

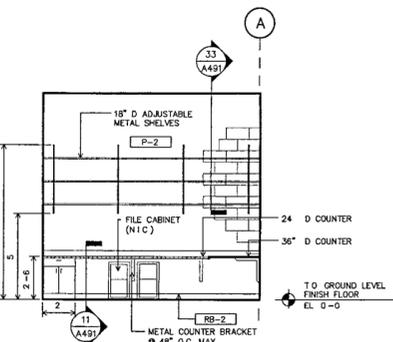


1-33 EXHIBIT SPECIALIST LOOKING NORTH  
SCALE 1/4" = 1'-0" (13)

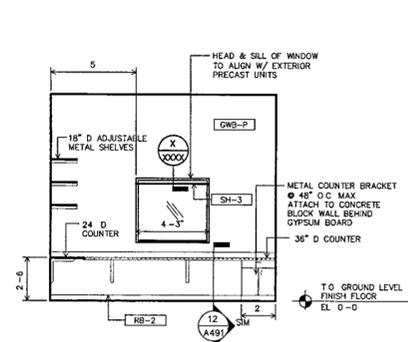

1-33 EXHIBIT SPECIALIST LOOKING EAST  
SCALE 1/4" = 1'-0" (12)

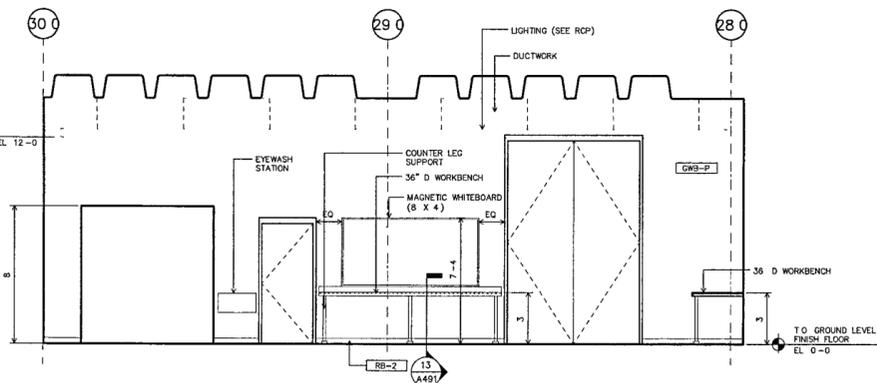

1-39 PRODUCTION STUDIO LOOKING WEST  
SCALE 1/4" = 1'-0" (11)

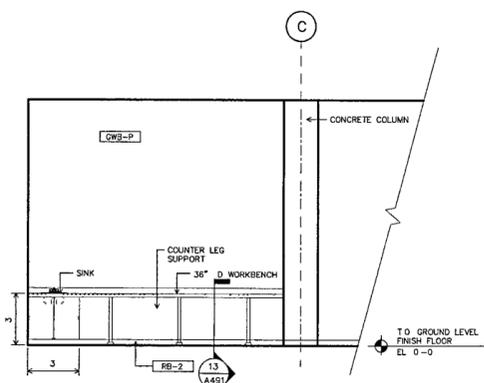

1-39 PRODUCTION STUDIO LOOKING NORTH  
SCALE 1/4" = 1'-0" (10)