

WILLIAM J. CLINTON
PRESIDENTIAL
CENTER

LITTLE ROCK, ARKANSAS

Architect

POLSHKE PARTNERSHIP LLP
320 West 13th Street
New York, New York 10014
212.807.7171

Coordinating Architects

POLK STANLEY YEARY ARCHITECTS Ltd
700 South Schiller Street
Little Rock, Arkansas 72201
501.378.0878

WITSELL EVANS RASCO

901 West Third Street
Little Rock, Arkansas 72201
501.374.5300

WOODS CARADINE ARCHITECTS

2200 South Main Street
Little Rock, Arkansas 72206
501.374.4060

Landscape Architects

HARGREAVES ASSOCIATES
118 Magazine Street
Cambridge, Massachusetts 02139
617.661.0070

LANDSCAPE ARCHITECTURE, Inc.

2300 Cottontale Lane Suite 202
Little Rock, Arkansas 72202
501.374.5810

Structural Engineer

LESLIE E. ROBERTSON ASSOC., RLLP
30 Broad Street, 4th Floor
New York, New York 10004
212.750.9000

MEP Engineers

FLACK + KURTZ Inc.
475 Fifth Avenue
New York, New York 10017
212.532.9600

CROMWELL ARCHITECTS ENGINEERS


101 South Spring Street
Little Rock, Arkansas 72201
501.372.2900

Curtainwall Consultant

R. A. HEINTGES ARCHITECTS
126 Fifth Avenue, 9th Floor
New York, New York 10011
212.652.2968

Seal

ASI #36	06/25/04
ASI #20	05/30/03
ASI #18	04/18/03
Addendum #2	11/15/02
100% Construction Documents	09/27/02
90% Progress Printing	08/30/02
100% Struct./ CD Progress	07/01/02
100% Steel & Concrete CD	05/15/02
& Architectural CD Progress	03/01/02
Issue	Date

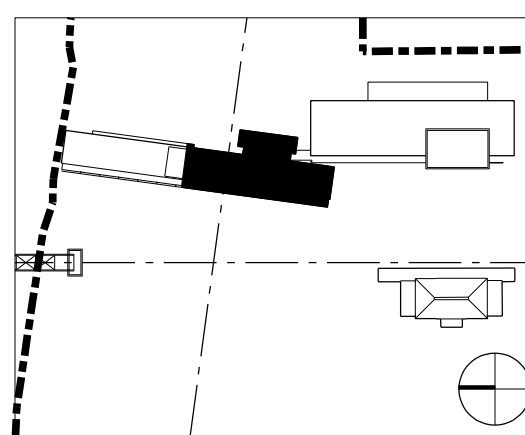

Job No. 9908

Scale 1/8" = 1'-0"

Date September 27, 2002

Title

EXECUTIVE LEVEL
PARTIAL PLAN

Sheet No.

A105b

FOR OFFICIAL USE ONLY

ELEV. MECHANICAL ROOM FLOOR PLAN B

SCALE: 1/8" = 1'-0"

EXECUTIVE LEVEL FLOOR PLAN B

SCALE: 1/8" = 1'-0"