


BRIDGE-BUILDING: WEST ELEVATION -SOUTH

SCALE: 1/8" = 1'-0"

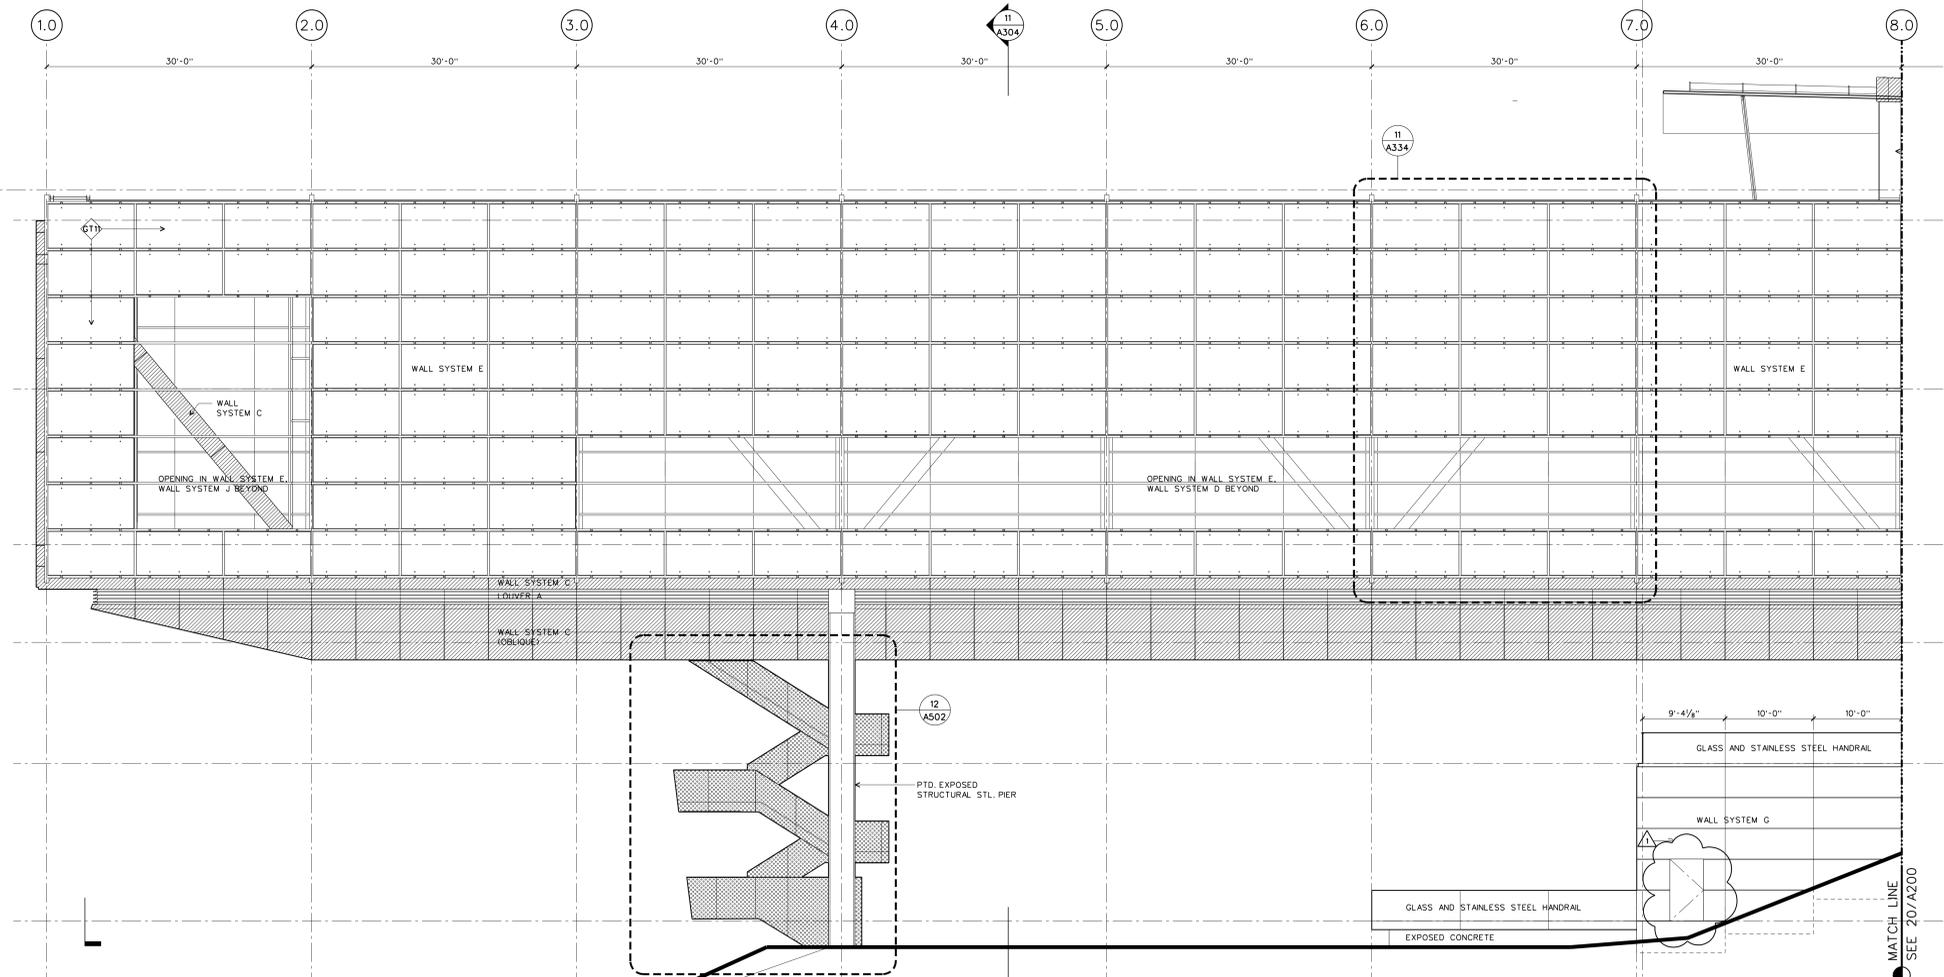

BRIDGE-BUILDING: WEST ELEVATION -NORTH

SCALE: 1/8" = 1'-0"

- 12'-4" ELEV. MECH T.O. STR. SLAB EL. 87'-5"
- EXECUTIVE LEVEL ROOF T.O. STR. SLAB EL. 75'-1"
- EXECUTIVE LVL T.O. FIN. FLR. EL. 62'-1"
- 19'-3 1/4" UPPER MUSEUM LEVEL T.O. FIN. FLR. EL. 42'-9 3/4"
- 17'-9 3/4" LOWER MUSEUM LEVEL T.O. FIN. FLR. EL. 25'-0"
- 11'-2" SECOND LEVEL T.O. STR. SLAB EL. 13'-10"
- 13'-10" GROUND LEVEL T.O. FIN. FLR. EL. 0'-0" (276'-0")
- 18'-0" SEE 10/A300 MATCH LINE
- 12'-4" ELEV. MECH T.O. STR. SLAB w/ 20 EL. 87'-5"
- EXECUTIVE LEVEL ROOF T.O. STR. SLAB EL. 75'-1"
- EXECUTIVE LVL T.O. FIN. FLR. EL. 62'-1"
- 19'-3 1/4" UPPER MUSEUM LEVEL T.O. FIN. FLR. EL. 42'-9 3/4"
- 17'-9 3/4" LOWER MUSEUM LEVEL T.O. FIN. FLR. EL. 25'-0"
- 11'-2" SECOND LEVEL T.O. STR. SLAB EL. 13'-10"
- 13'-10" GROUND LEVEL T.O. FIN. FLR. EL. 0'-0" (276'-0")
- 18'-0" BASEMENT LVL T.O. FIN. FLR. EL. -18'-0"

**WILLIAM J. CLINTON  
PRESIDENTIAL  
CENTER**

LITTLE ROCK, ARKANSAS

Architect  
**POLSHEK PARTNERSHIP LLP**  
320 West 13th Street  
New York, New York 10014  
212.807.7171

Coordinating Architects  
**POLK STANLEY YEARY ARCHITECTS LLP**  
700 South Schiller Street  
Little Rock, Arkansas 72201  
501.378.0878

**WITSELL EVANS RASCO**  
901 West Third Street  
Little Rock, Arkansas 72201  
501.374.5300

**WOODS CARADINE ARCHITECTS**  
2200 South Main Street  
Little Rock, Arkansas 72206  
501.374.4060

Landscape Architects  
**HARGREAVES ASSOCIATES**  
118 Magazine Street  
Cambridge, Massachusetts 02139  
617.661.0070

**LANDSCAPE ARCHITECTURE, Inc.**  
2300 Cottondale Lane Suite 202  
Little Rock, Arkansas 72202  
501.374.5610

Structural Engineer  
**LESLIE E. ROBERTSON ASSOC., RLLP**  
30 Broad Street, 47th Floor  
New York, New York 10004  
212.750.9000


MEP Engineers  
**FLACK + KURTZ, Inc.**  
475 Fifth Avenue  
New York, New York 10017  
212.532.9600

**CROMWELL ARCHITECTS ENGINEERS**  
101 South Spring Street  
Little Rock, Arkansas 72201  
501.372.2900

Curtainwall Consultant  
**R. A. HEINTGES ARCHITECTS**  
126 Fifth Avenue, 9th Floor  
New York, New York 10011  
212.652.2968

Seal

| Issue                       | Date     |
|-----------------------------|----------|
| Addendum #2                 | 11/15/02 |
| 100% Construction Documents | 09/27/02 |
| 90% Progress Printing       | 08/30/02 |
| 100% Struct./CD Progress    | 07/01/02 |
| Bridge Bldg. Substructure   | 06/14/02 |
| 100% Steel & Concrete CD    | 05/15/02 |
| & Architectural CD Progress |          |
| 100% Design Development     | 03/01/02 |

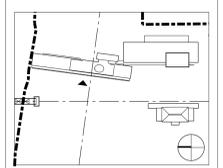

Job No. 9908  
Scale 1/8" = 1'-0"  
Date September 27, 2002  
Title

**MUSEUM BUILDING  
WEST ELEVATION**

Sheet No.

**A200**

FOR OFFICIAL USE ONLY