


Seal

Issue	Date
ASI #23	09/12/03
ASI #20	06/06/03
100% Construction Documents	09/27/02
90% Progress Printing	08/30/02
100% Struct./CD Progress	07/01/02
Bridge Bldg. Substructure	06/14/02
100% Steel & Concrete CD	05/15/02
& Architectural CD Progress	
100% Design Development	03/01/02

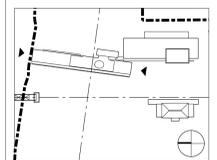

Job No. 9908

Scale 1/8" = 1'-0"

Date September 27, 2002


Title

**MUSEUM BUILDING
NORTH AND SOUTH
ELEVATIONS**

Sheet No.

A203

FOR OFFICIAL USE ONLY

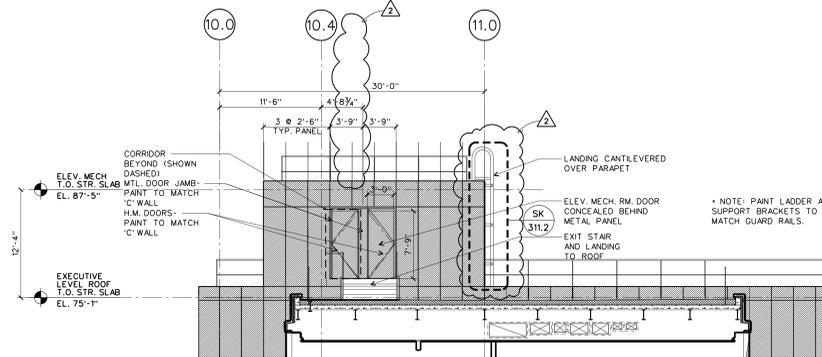


**BRIDGE-BUILDING: WEST ELEVATION
OF ELEVATOR MECHANICAL ROOM (PARTIAL)**

SCALE: 1/8" = 1'-0"

b-sect-nr08

20

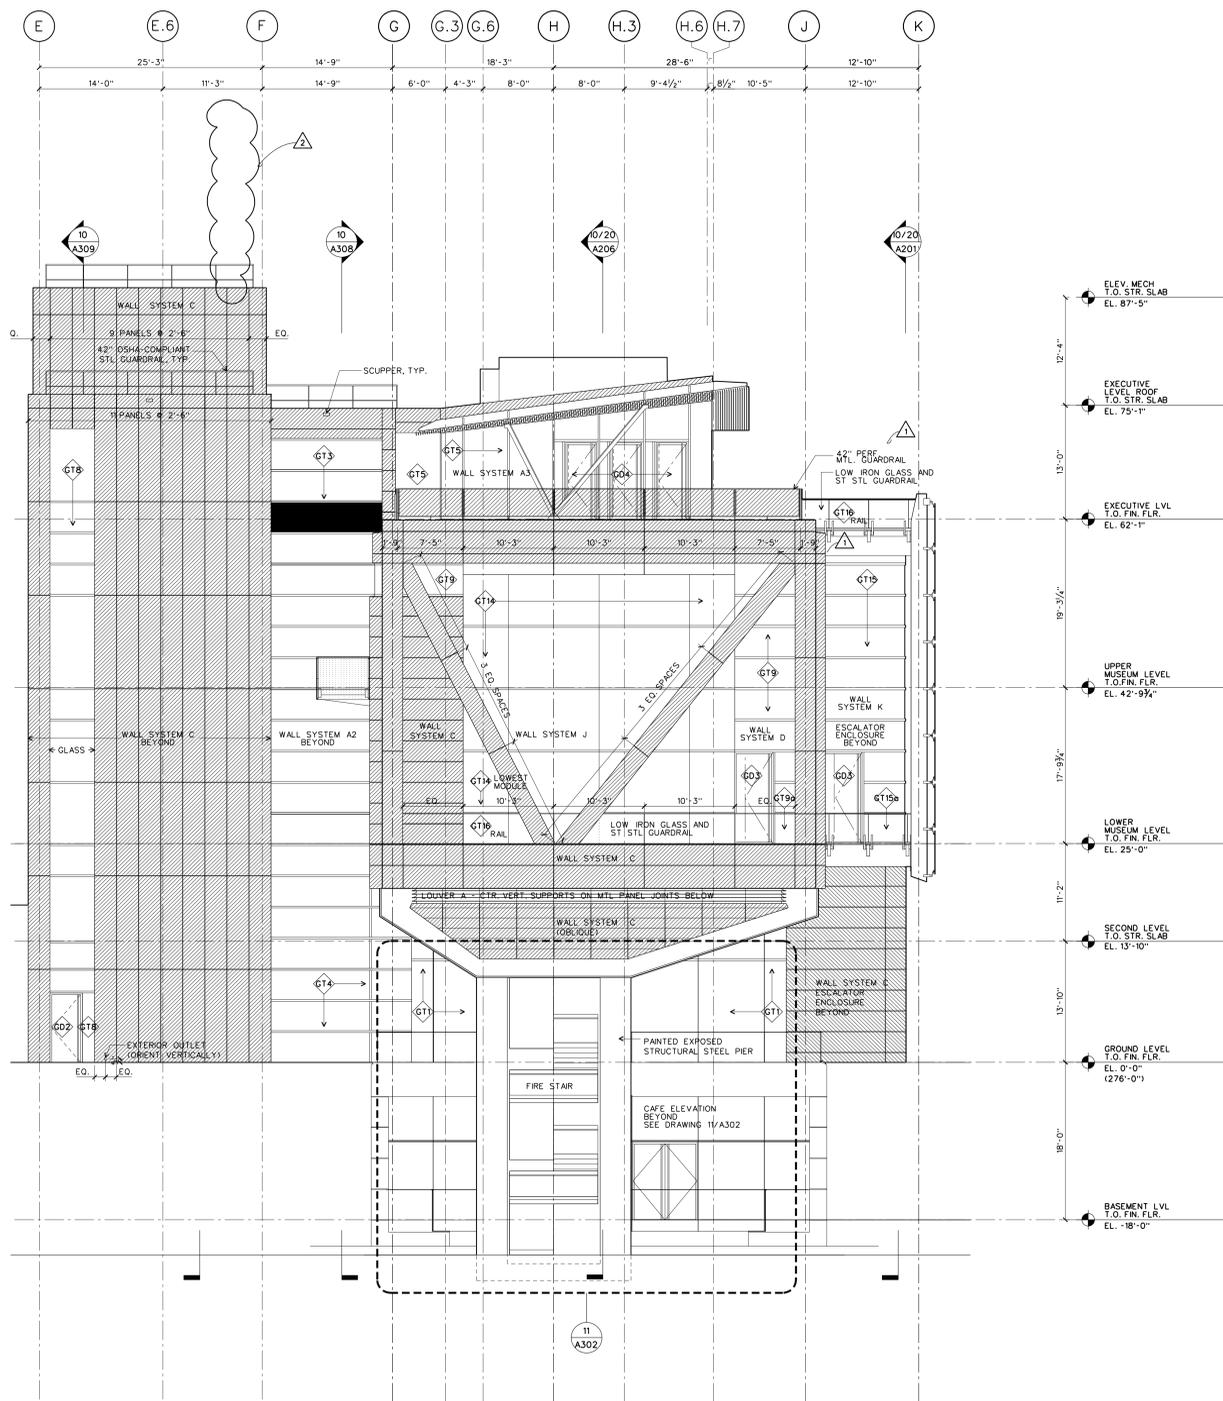


BRIDGE-BUILDING: NORTH ELEVATION

SCALE: 1/8" = 1'-0"

b-elev-n

11

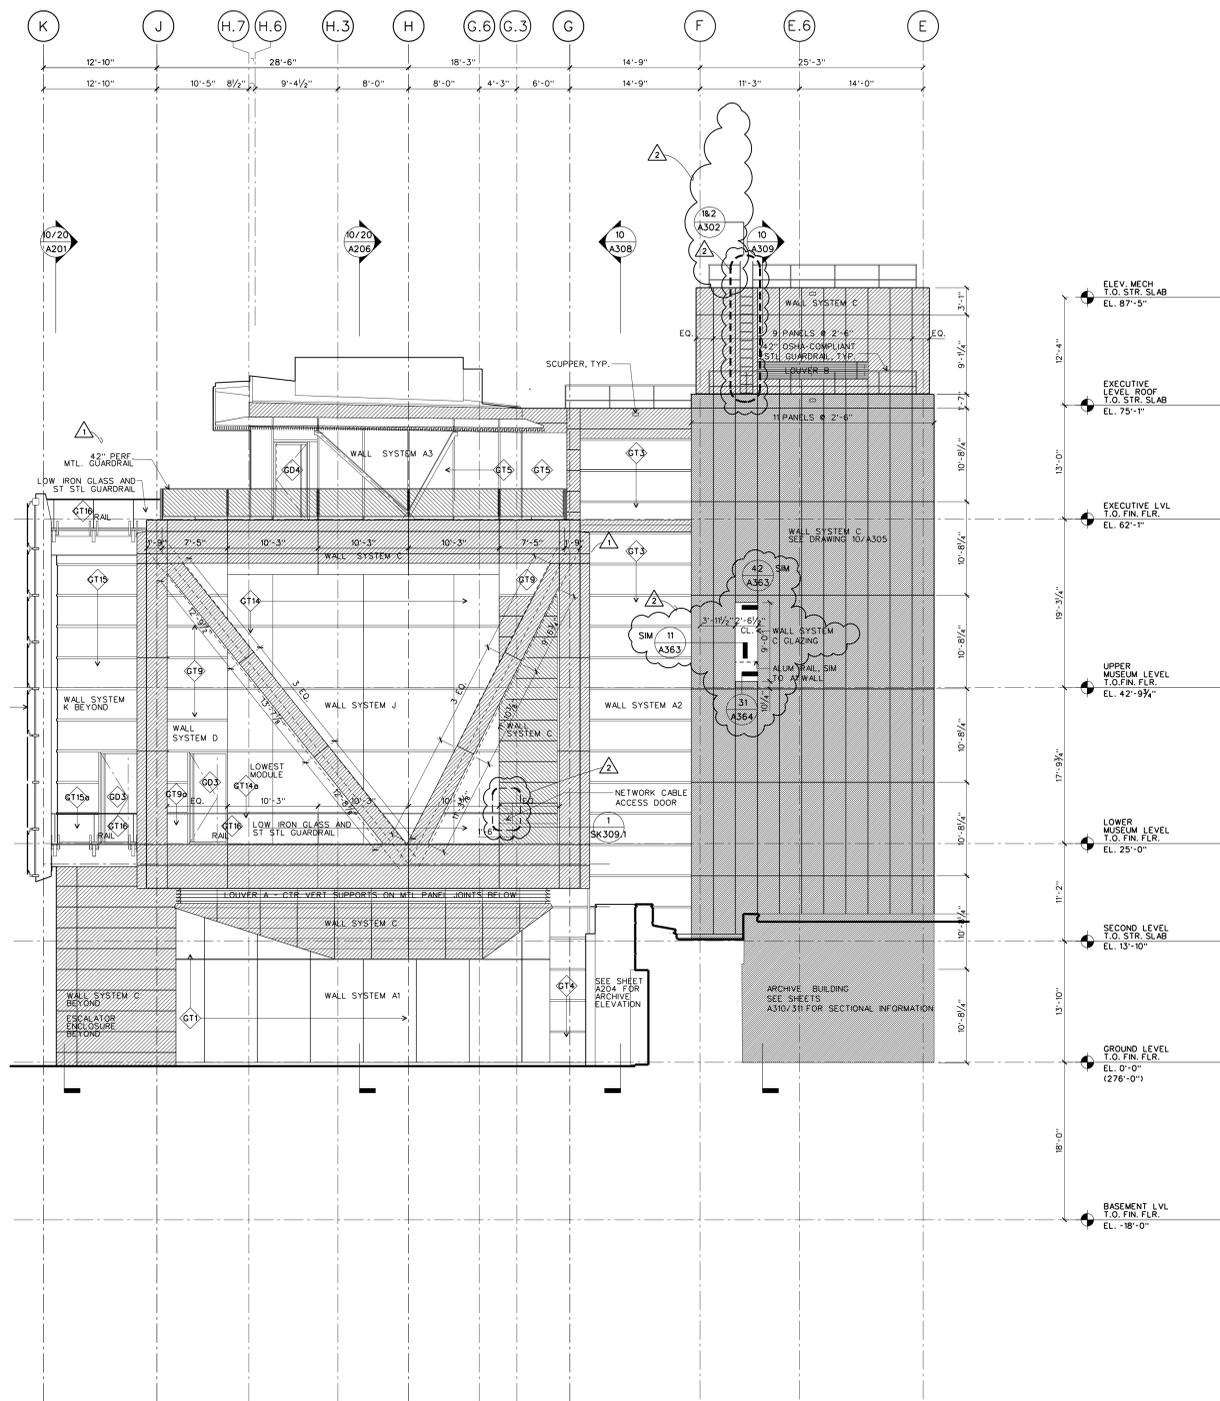

BRIDGE-BUILDING: SOUTH ELEVATION

SCALE: 1/8" = 1'-0"

b-elev-s

10