

**WILLIAM J. CLINTON
PRESIDENTIAL
CENTER**

LITTLE ROCK, ARKANSAS

Architect
POLSHEK PARTNERSHIP LLP
320 West 13th Street
New York, New York 10014
212.807.7171

Coordinating Architects
POLK STANLEY YEARY ARCHITECTS Ltd
700 South Schiller Street
Little Rock, Arkansas 72201
501.378.0878

WITSELL EVANS RASCO
901 West Third Street
Little Rock, Arkansas 72201
501.374.5300

WOODS CARADINE ARCHITECTS
2200 South Main Street
Little Rock, Arkansas 72206
501.374.4060

Landscape Architects
HARGREAVES ASSOCIATES
118 Magazine Street
Cambridge, Massachusetts 02139
617.661.0070

LANDSCAPE ARCHITECTURE, Inc.
2300 Cottondale Lane Suite 202
Little Rock, Arkansas 72202
501.374.5810

Structural Engineer
LESLIE E. ROBERTSON ASSOC., RLLP
30 Broad Street, 47th Floor
New York, New York 10004
212.750.9000


MEP Engineers
FLACK + KURTZ Inc.
475 Fifth Avenue
New York, New York 10017
212.532.9600

CROMWELL ARCHITECTS ENGINEERS
101 South Spring Street
Little Rock, Arkansas 72201
501.372.2900

Curtainwall Consultant
R. A. HEINTGES ARCHITECTS
126 Fifth Avenue, 9th Floor
New York, New York 10011
212.652-2968

Seal

| Issue | Date |
|-----------------------------|----------|
| ASI #25 | 12/19/03 |
| ASI #23 | 09/12/03 |
| Addendum #2 | 11/15/02 |
| 100% Construction Documents | 09/27/02 |
| 90% Progress Printing | 08/30/02 |
| 100% Struct./ CD Progress | 07/10/02 |
| Bridge Bldg. Substructure | 06/14/02 |
| 100% Steel & Concrete CD | 05/15/02 |
| & Architectural CD Progress | |
| 100% Design Development | 03/01/02 |

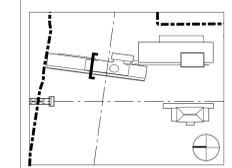

Job No. 9908

Scale 1/4" = 1'-0"

Date September 27, 2002


Title

MUSEUM BUILDING SECTIONS

Sheet No.

A302

FOR OFFICIAL USE ONLY

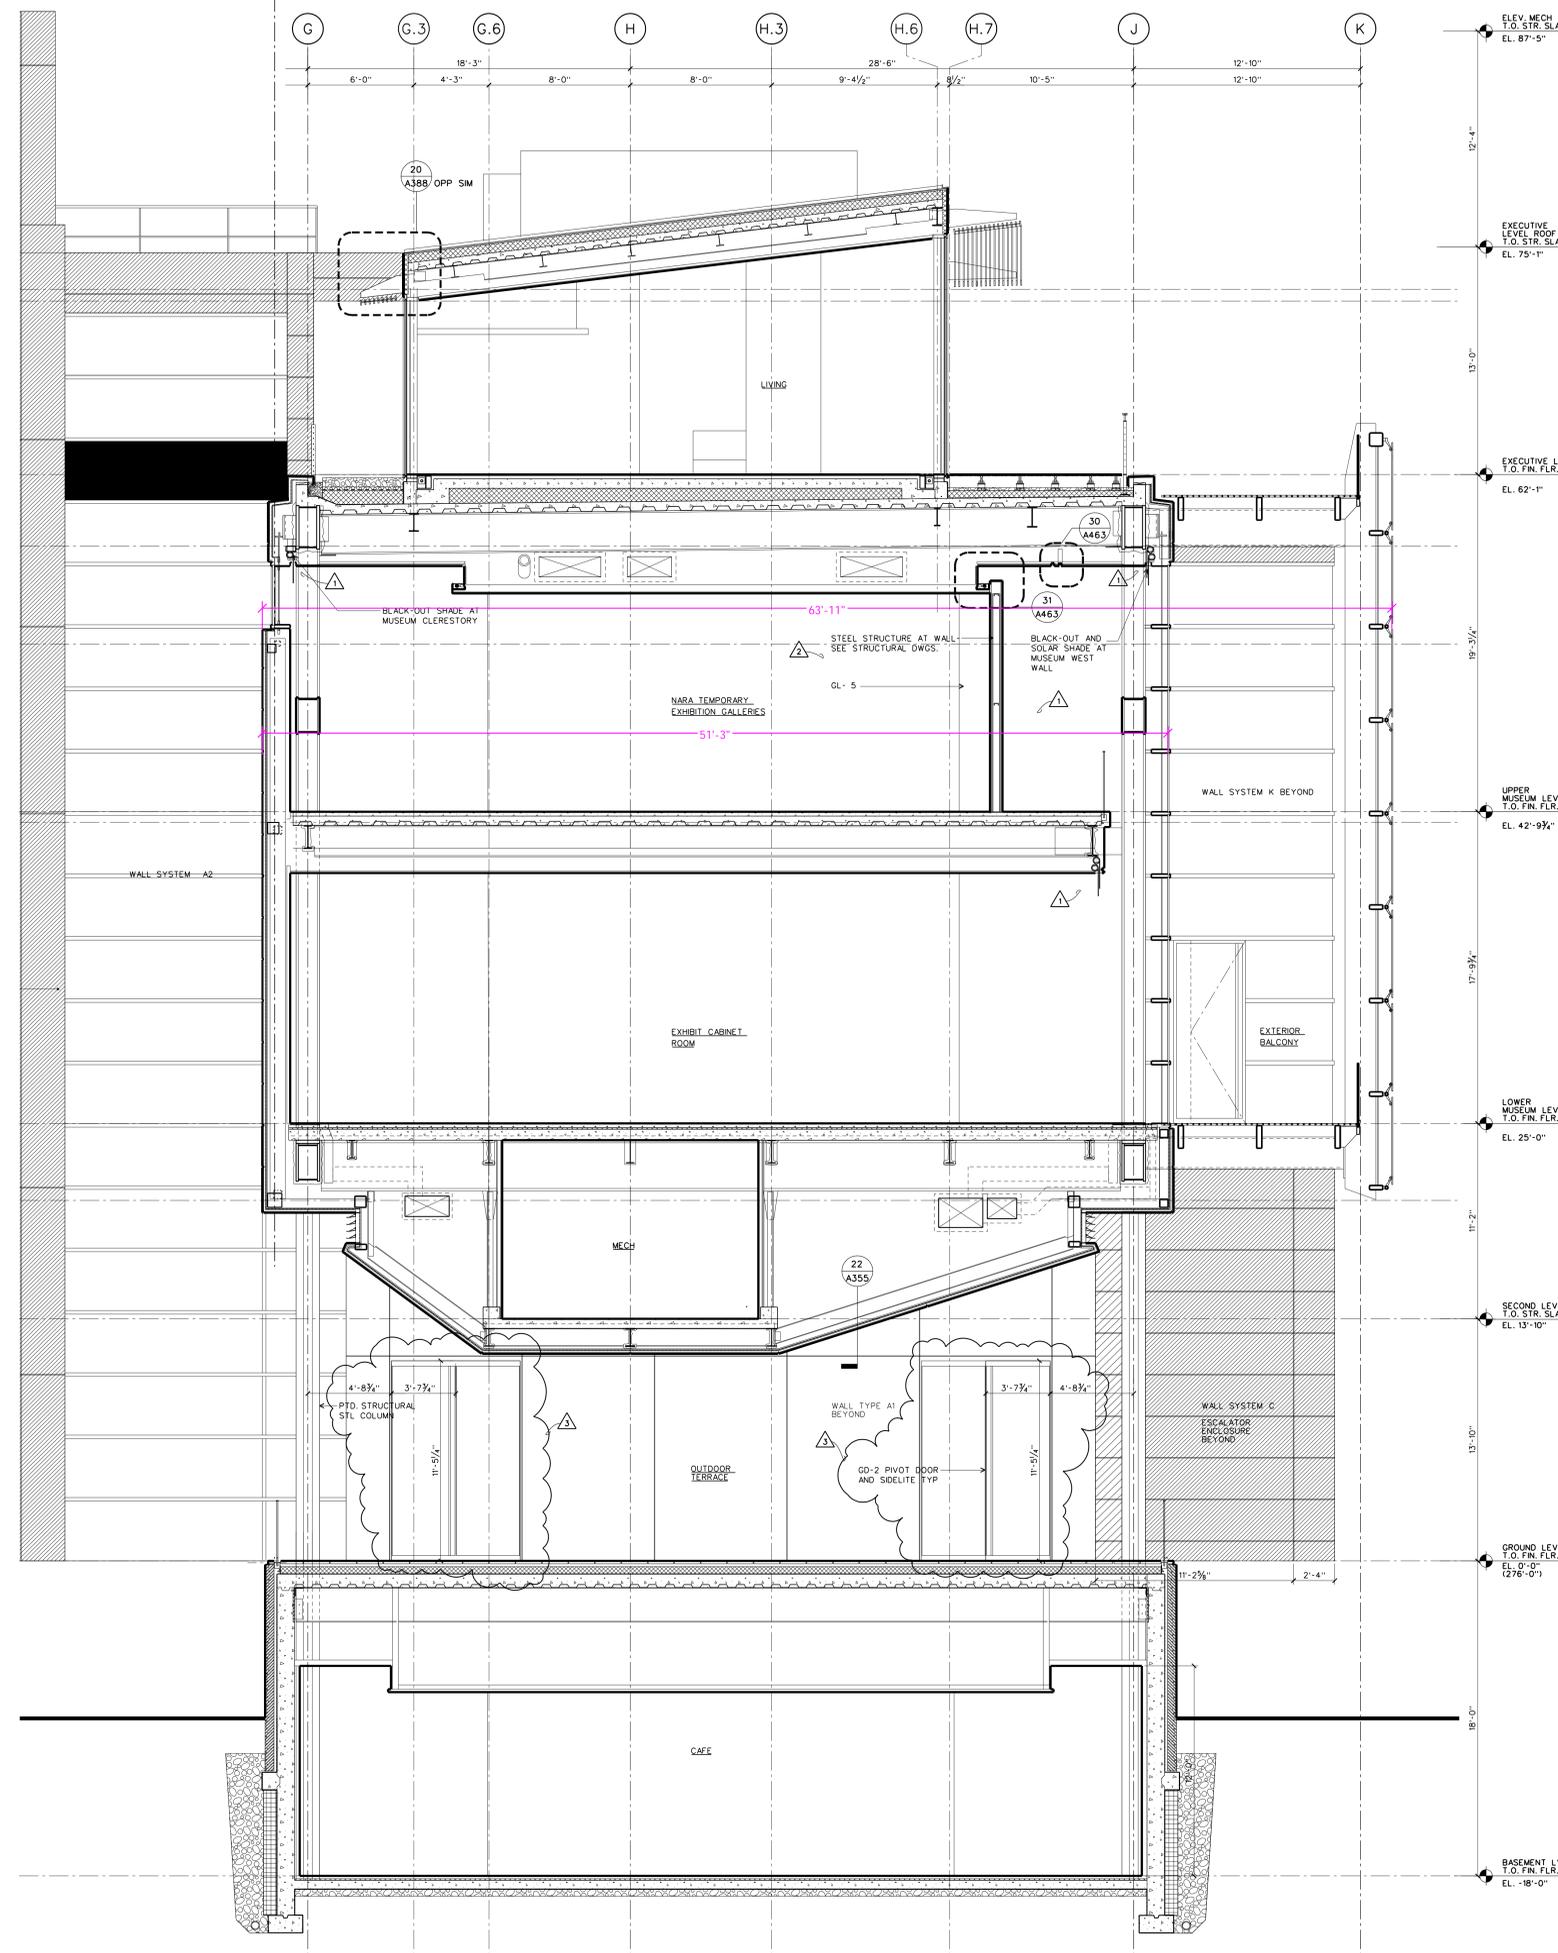


BRIDGE BUILDING: DETAIL SECTION EAST-WEST LOOKING SOUTH THROUGH TEMPORARY GALLERY

SCALE: 1/4" = 1'-0"

B-SECT-EW02

11

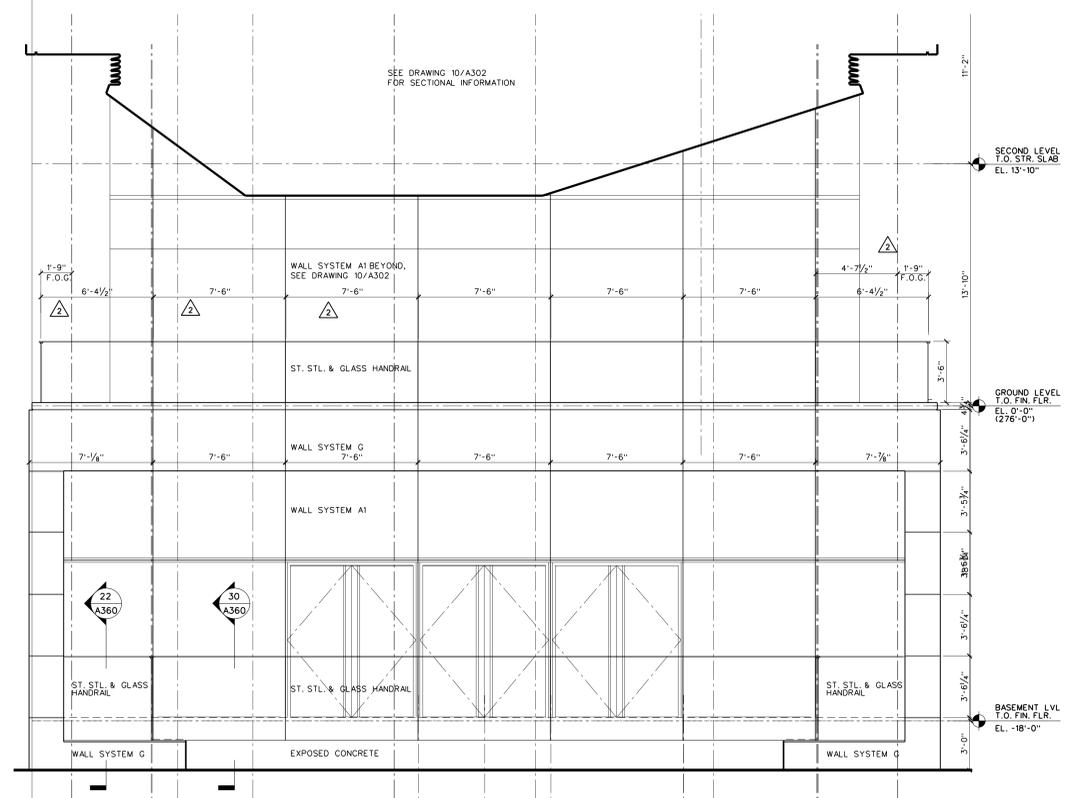

BRIDGE BUILDING: DETAIL SECTION EAST-WEST LOOKING SOUTH AT CAFE ELEVATION

SCALE: 1/4" = 1'-0"

B-SECT-EW08

11