

**WILLIAM J. CLINTON
PRESIDENTIAL
CENTER**

LITTLE ROCK, ARKANSAS

Architect
POLSHEK PARTNERSHIP LLP
 320 West 13th Street
 New York, New York 10014
 212.807.7171

Coordinating Architects
POLK STANLEY YEARY ARCHITECTS Ltd
 700 South Schiller Street
 Little Rock, Arkansas 72201
 501.378.0878

WITSELL EVANS RASCO
 901 West Third Street
 Little Rock, Arkansas 72201
 501.374.5300

WOODS CARADINE ARCHITECTS
 2200 South Main Street
 Little Rock, Arkansas 72206
 501.374.4060

Landscape Architects
HARGREAVES ASSOCIATES
 118 Magazine Street
 Cambridge, Massachusetts 02139
 617.661.0070

LANDSCAPE ARCHITECTURE, Inc.
 2300 Cottondale Lane Suite 202
 Little Rock, Arkansas 72202
 501.374.5610

Structural Engineer
LESLIE E. ROBERTSON ASSOC., RLLP
 30 Broad Street, 47th Floor
 New York, New York 10004
 212.750.9000


MEP Engineers
FLACK + KURTZ, Inc.
 475 Fifth Avenue
 New York, New York 10017
 212.532.9600

CROMWELL ARCHITECTS ENGINEERS
 101 South Spring Street
 Little Rock, Arkansas 72201
 501.372.2900

Curtainwall Consultant
R. A. HEINTGES ARCHITECTS
 126 Fifth Avenue, 9th Floor
 New York, New York 10011
 212.652-2968

Seal

Issue	Date
ASI # 25	12/19/03
ASI # 22	08/01/03
100% Construction Documents	09/27/02
90% Progress Printing	08/30/02
100% Struct./ CD Progress	07/01/02
100% Steel & Concrete CD	05/15/02
& Architectural CD Progress	
100% Design Development	03/01/02

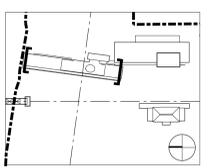

Job No. 9908

Scale 1/4" = 1'-0"

Date September 27, 2002


Title

**MUSEUM BUILDING
SECTIONS**

Sheet No.

A303

FOR OFFICIAL USE ONLY

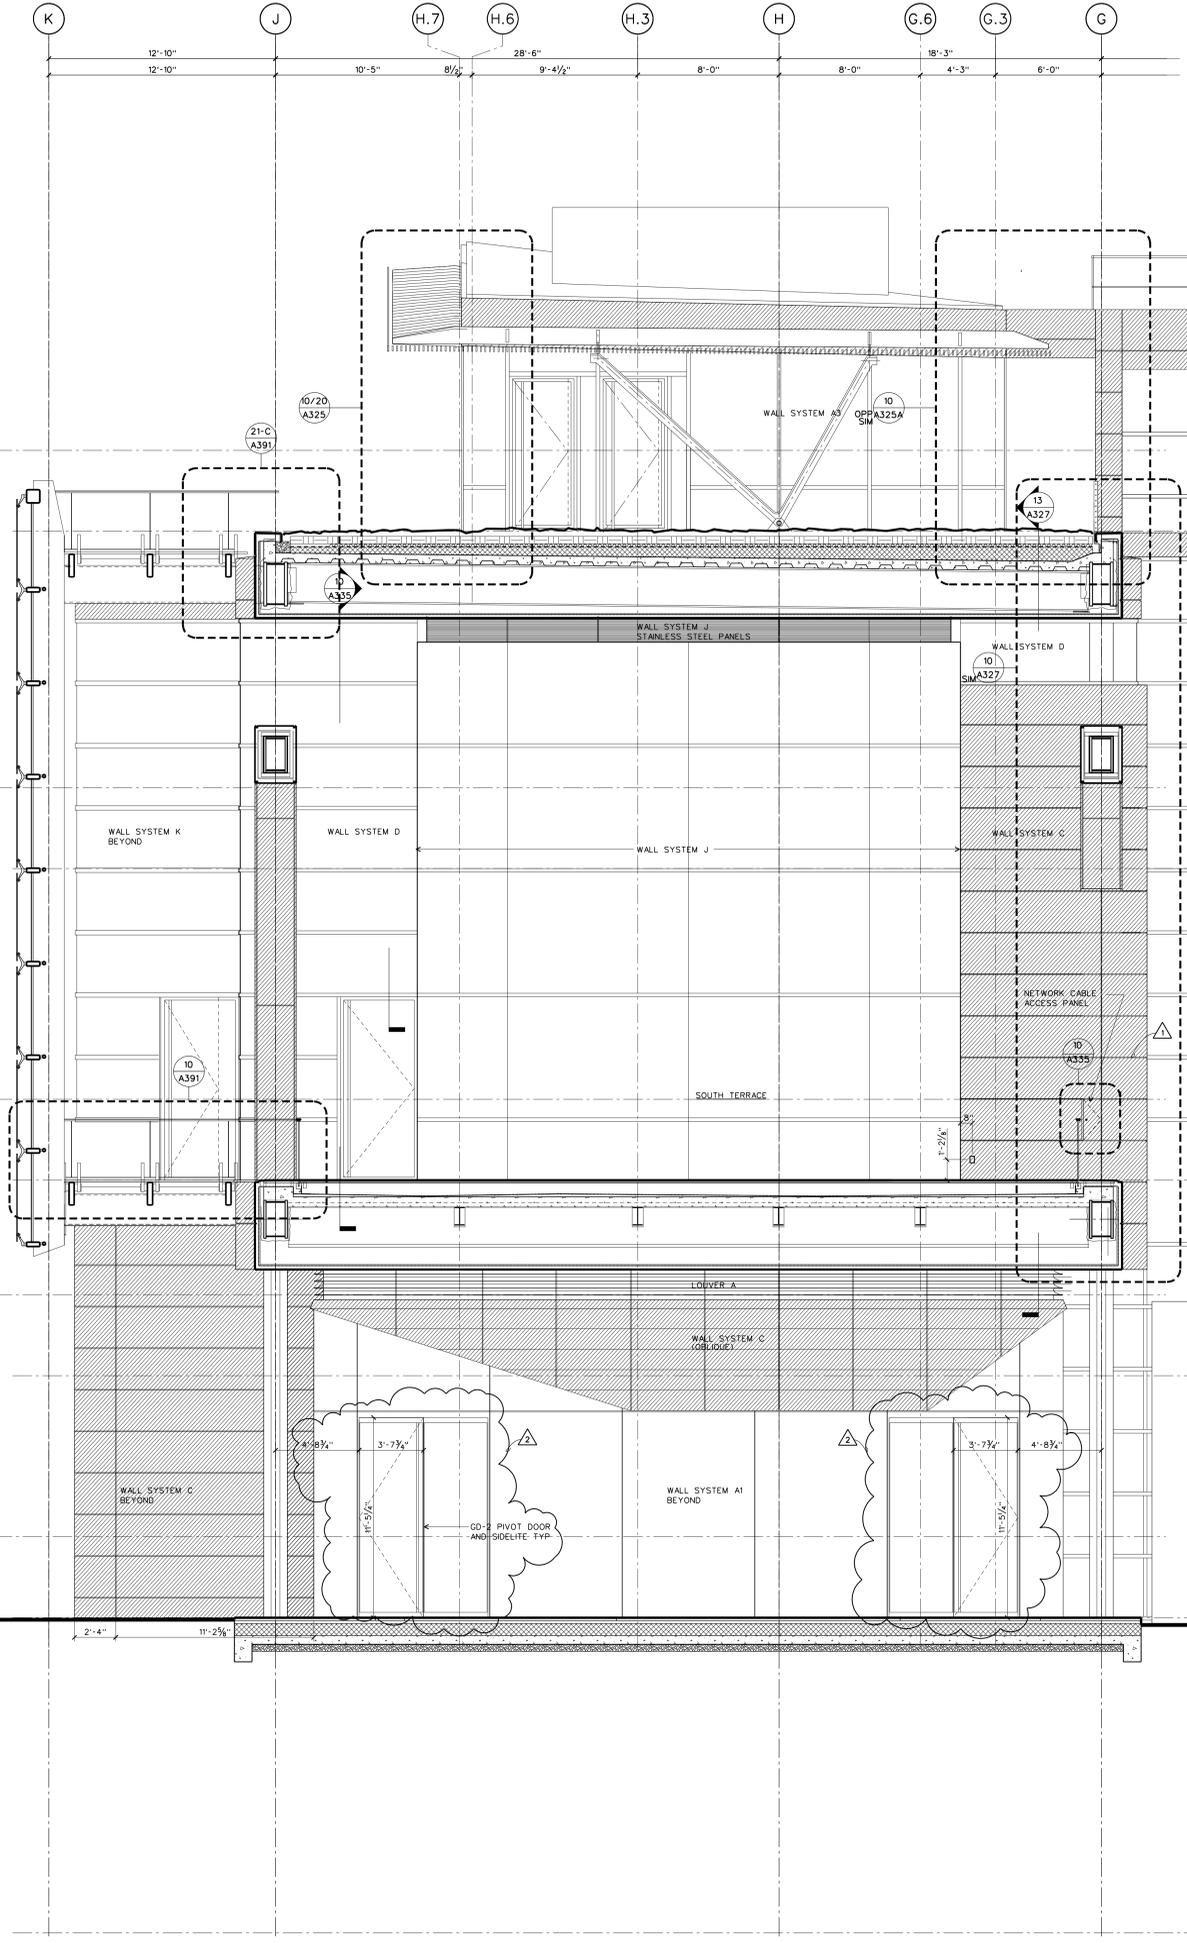


BRIDGE BUILDING: DETAIL SECTION EAST-WEST LOOKING NORTH THROUGH SOUTH END

SCALE: 1/4" = 1'-0"

11

B-SECT-EW07

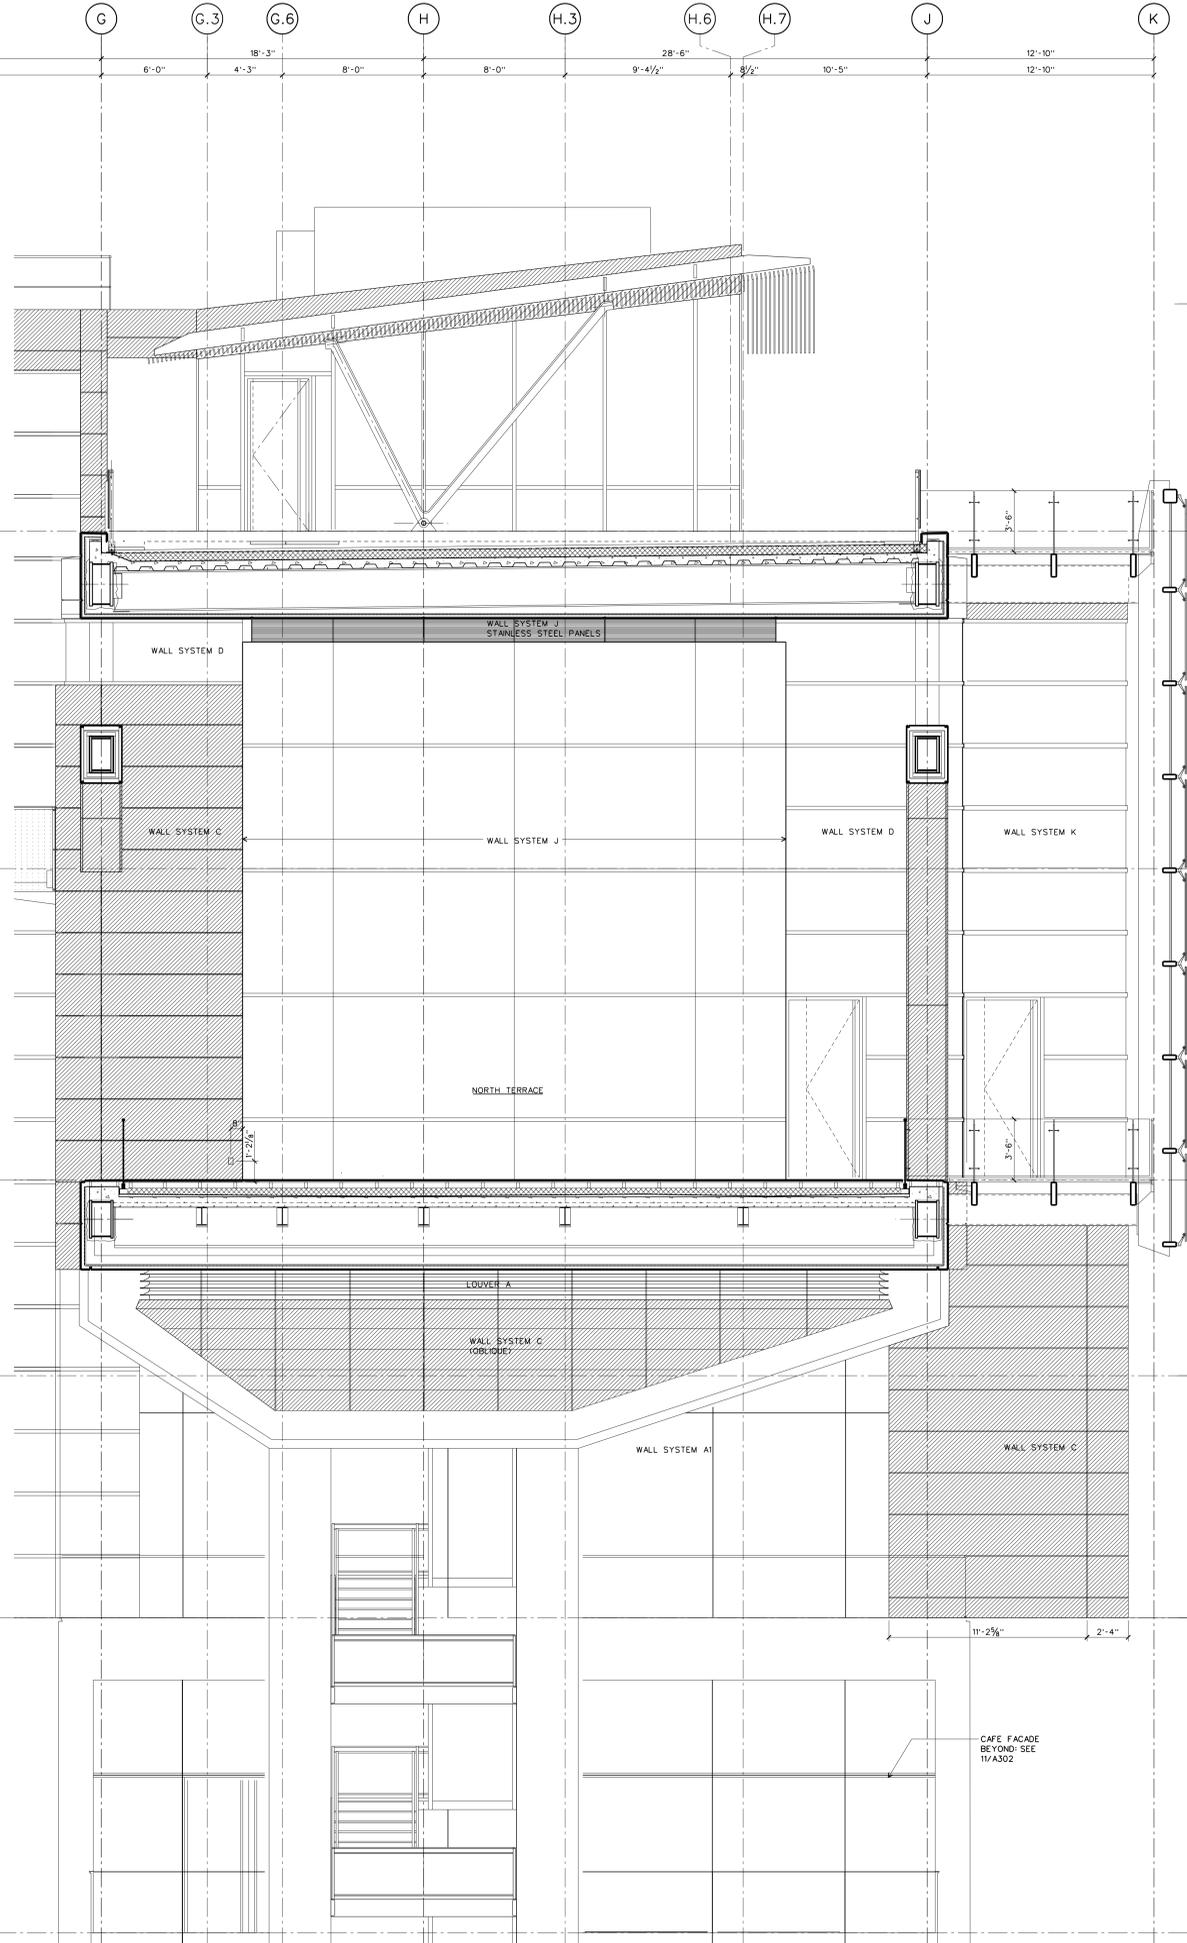

BRIDGE BUILDING: DETAIL SECTION EAST-WEST LOOKING SOUTH THROUGH NORTH END

SCALE: 1/4" = 1'-0"

10

B-SECT-EW06