

**WILLIAM J. CLINTON  
PRESIDENTIAL  
CENTER**

LITTLE ROCK, ARKANSAS

Architect  
**POLSHEK PARTNERSHIP LLP**  
 320 West 13th Street  
 New York, New York 10014  
 212.807.7171

Coordinating Architects  
**POLK STANLEY YEARY ARCHITECTS LTD**  
 700 South Schiller Street  
 Little Rock, Arkansas 72201  
 501.378.0878

**WITSELL EVANS RASCO**  
 901 West Third Street  
 Little Rock, Arkansas 72201  
 501.374.5300

**WOODS CARADINE ARCHITECTS**  
 2200 South Main Street  
 Little Rock, Arkansas 72206  
 501.374.4960

Landscape Architects  
**HARGREAVES ASSOCIATES**  
 118 Magazine Street  
 Cambridge, Massachusetts 02139  
 617.661.0070

LANDSCAPE ARCHITECTURE, Inc.  
 2300 Cottondale Lane Suite 202  
 Little Rock, Arkansas 72202  
 501.374.5810

Structural Engineer  
**LESLIE E. ROBERTSON ASSOC., RLLP**  
 30 Broad Street, 47th Floor  
 New York, New York 10004  
 212.750.9000


MEP Engineers  
**FLACK + KURTZ, Inc.**  
 475 Fifth Avenue  
 New York, New York 10017  
 212.532.9600

**CROMWELL ARCHITECTS ENGINEERS**  
 101 South Spring Street  
 Little Rock, Arkansas 72201  
 501.372.2900

Curtainwall Consultant  
**R. A. HEINTGES ARCHITECTS**  
 126 Fifth Avenue, 9th Floor  
 New York, New York 10011  
 212.652-2968

Seal

ASI #23	08/12/03
ASI #18	04/18/03
Addendum #2	11/15/02
100% Construction Documents	09/27/02
90% Progress Printing	08/30/02
100% Struct./ CD Progress	07/01/02
Bridge Bldg. Substructure	06/14/02
100% Steel & Concrete CD	05/15/02
& Architectural CD Progress	
100% Design Development	03/01/02
Issue	Date

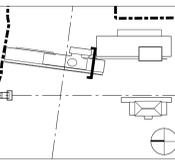

Job No. 9908

Scale 1/4" = 1'-0"


Date September 27, 2002

Title

**MUSEUM BUILDING  
SECTIONS**

Sheet No.

**A305**

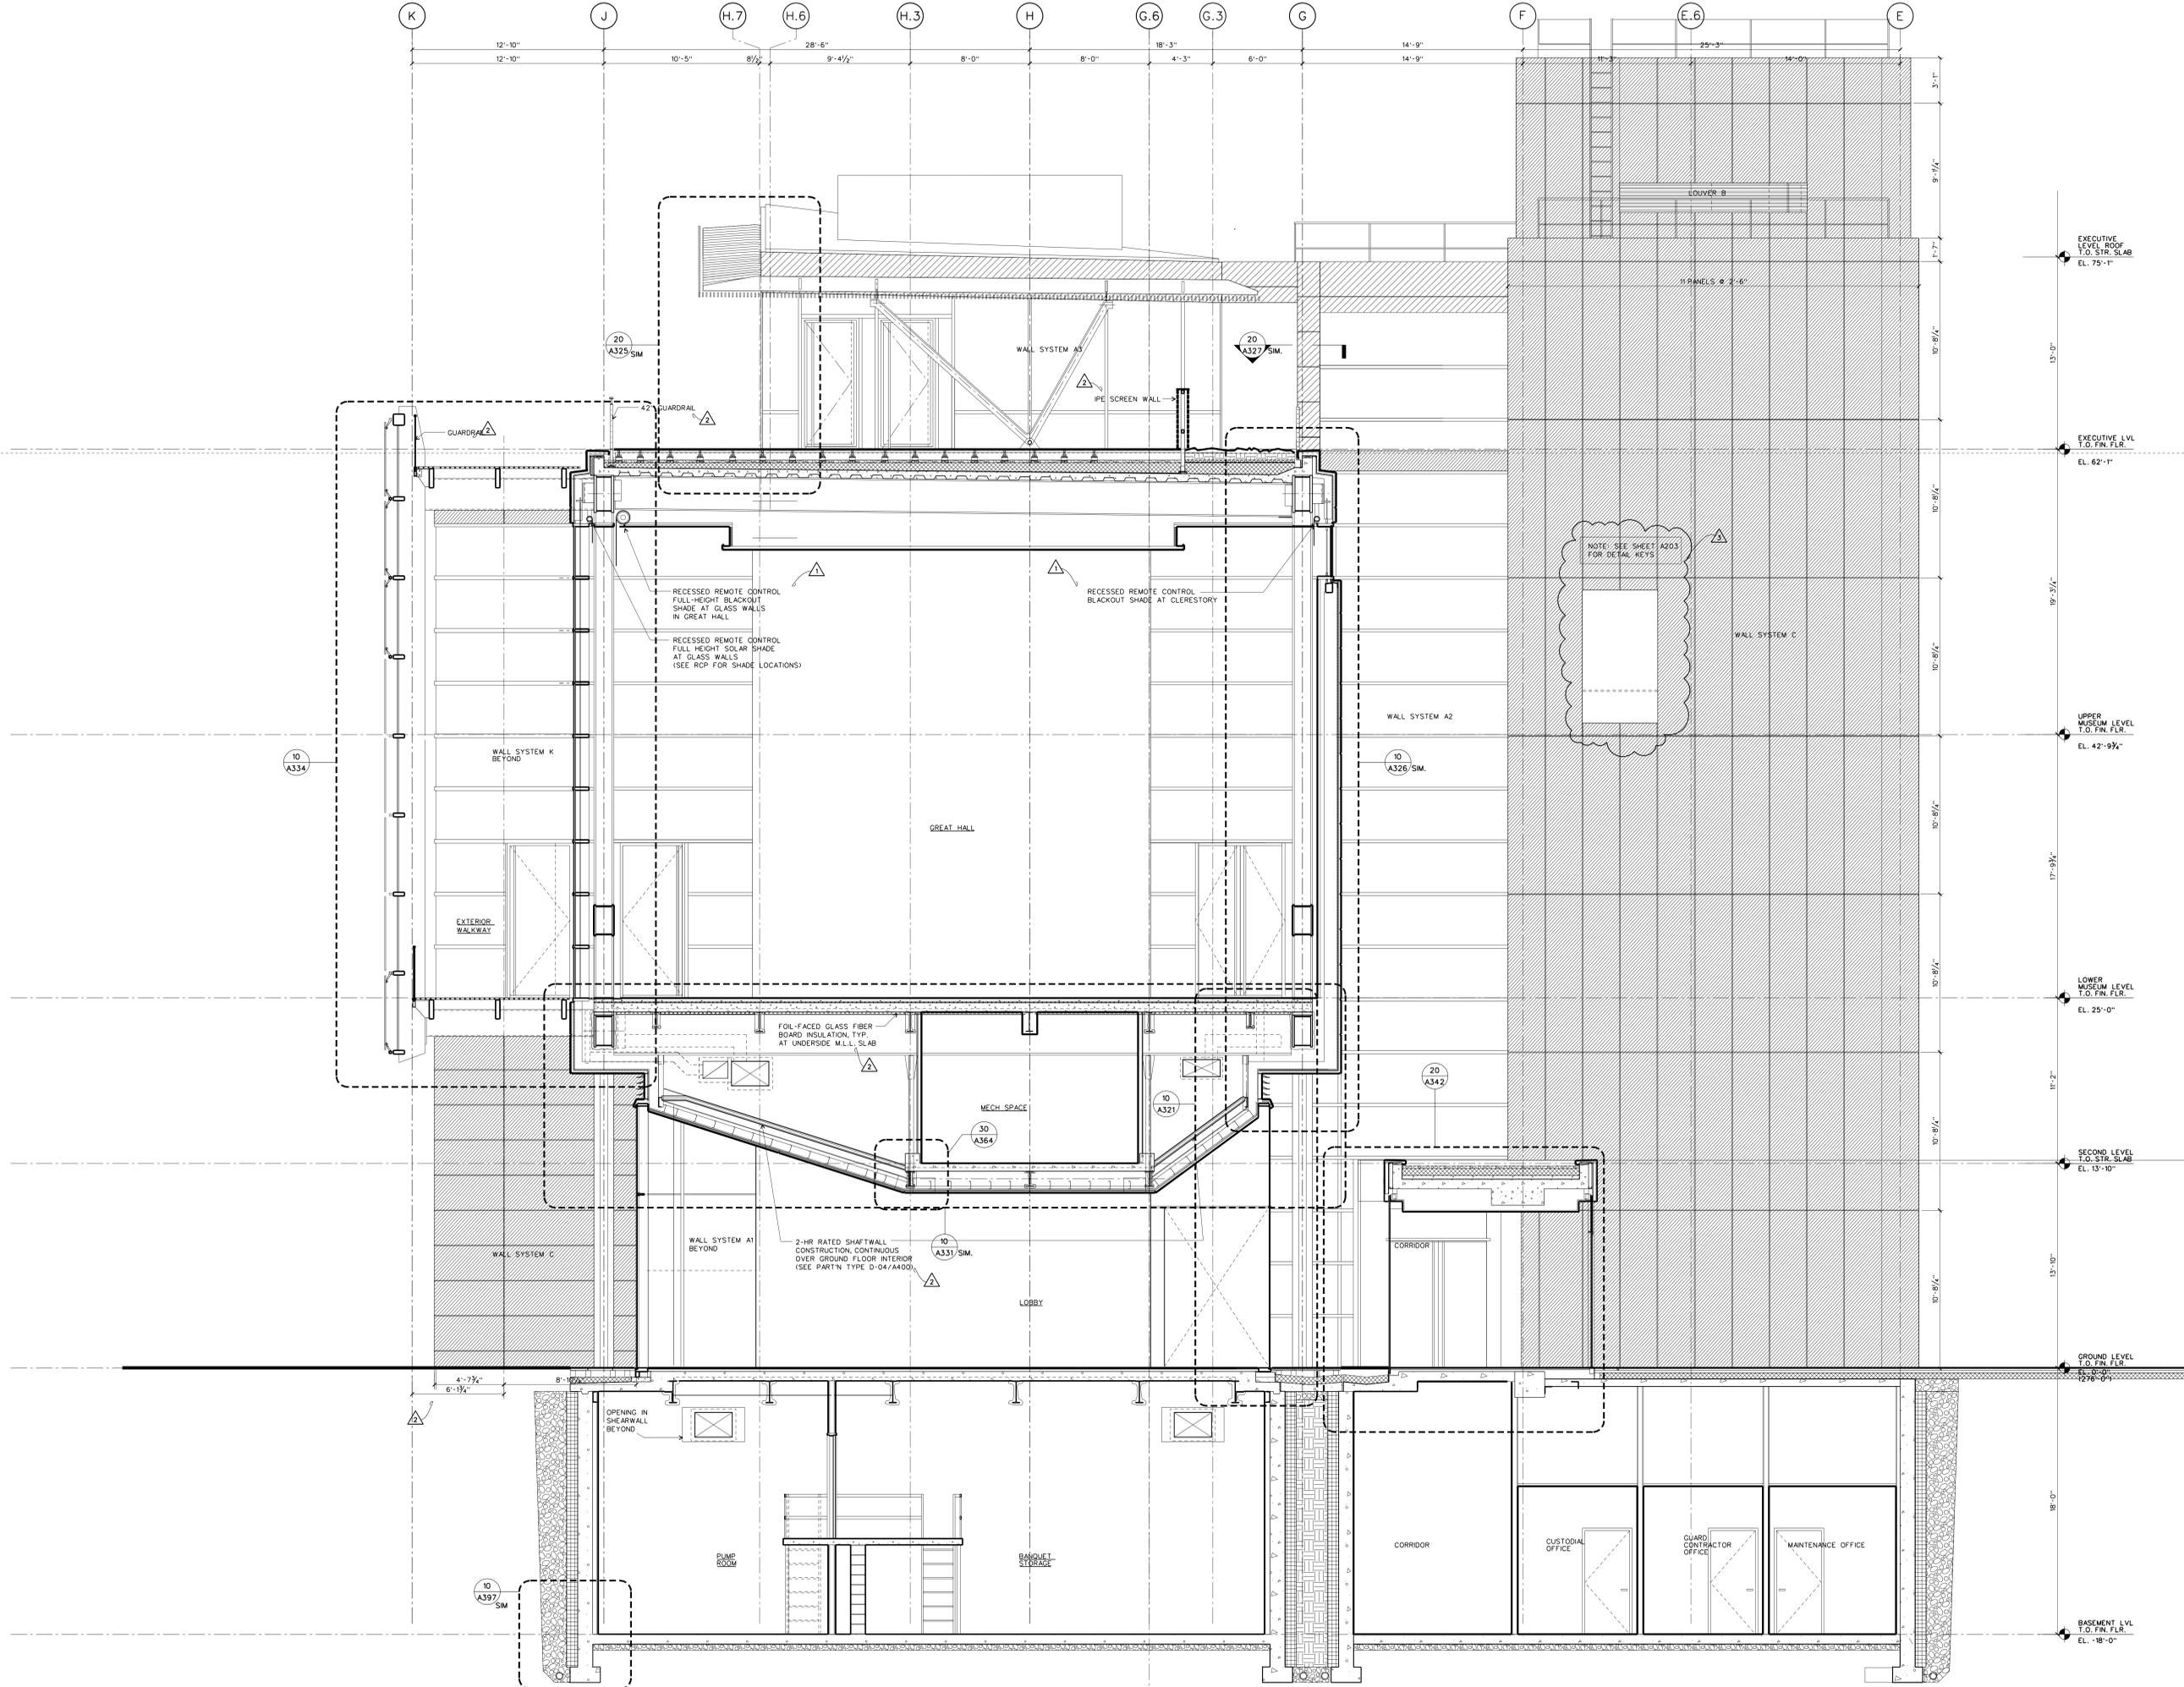

BRIDGE BUILDING: DETAIL SECTION EAST-WEST LOOKING NORTH THROUGH GREAT HALL

SCALE: 1/4" = 1'-0"

B-SECT-EW04

10 FOR OFFICIAL USE ONLY