


Issue	Date
ASI #26	01/16/04
ASI #22	08/01/03
Addendum #2	11/15/02
100% Construction Documents	09/27/02
90% Progress Printing	08/30/02
100% Struct./ CD Progress	07/01/02
Bridge Bldg. Substructure	06/14/02
100% Design Development	03/01/02

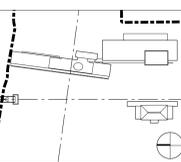

Job No. 9908

Scale 1/2" = 1'-0"

Date September 27, 2002


Title

**WALL SYSTEM A2
SECTIONS**

Sheet No.

A323


FOR OFFICIAL USE ONLY

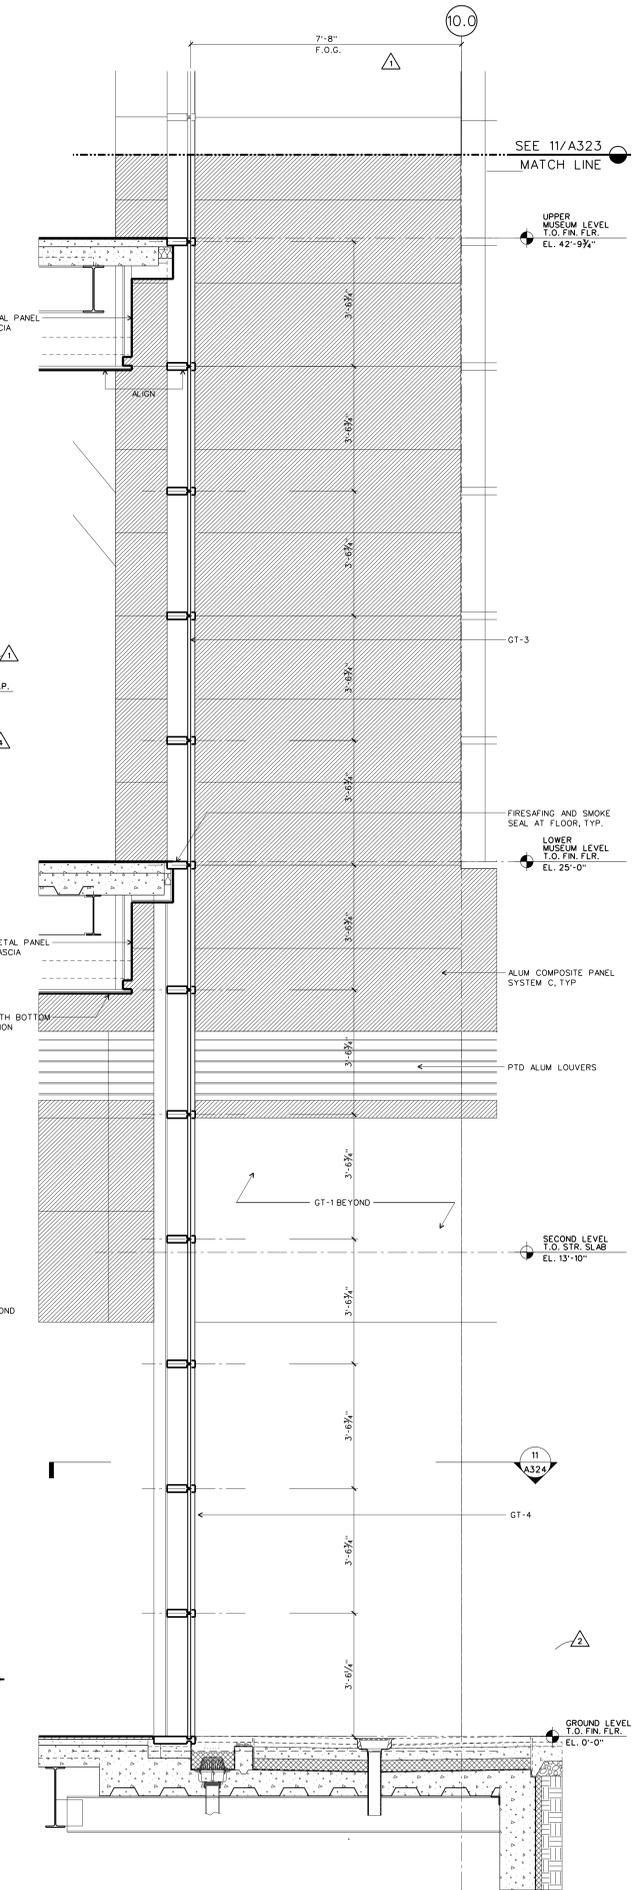

WALL SYSTEM A2: WALL SECTION AT NECK, NORTH

DETAILS/DTL-CWA4


10

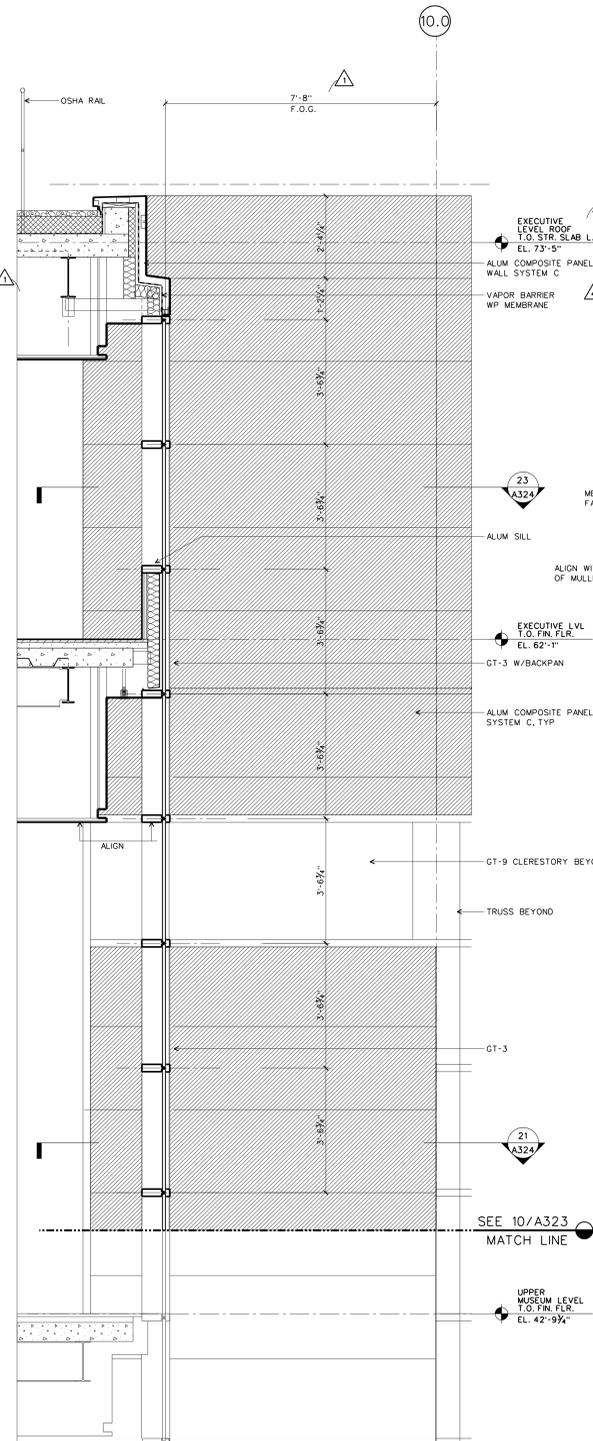

WALL SYSTEM A2: WALL SECTION AT NECK, NORTH

DETAILS/DTL-CWA4


11

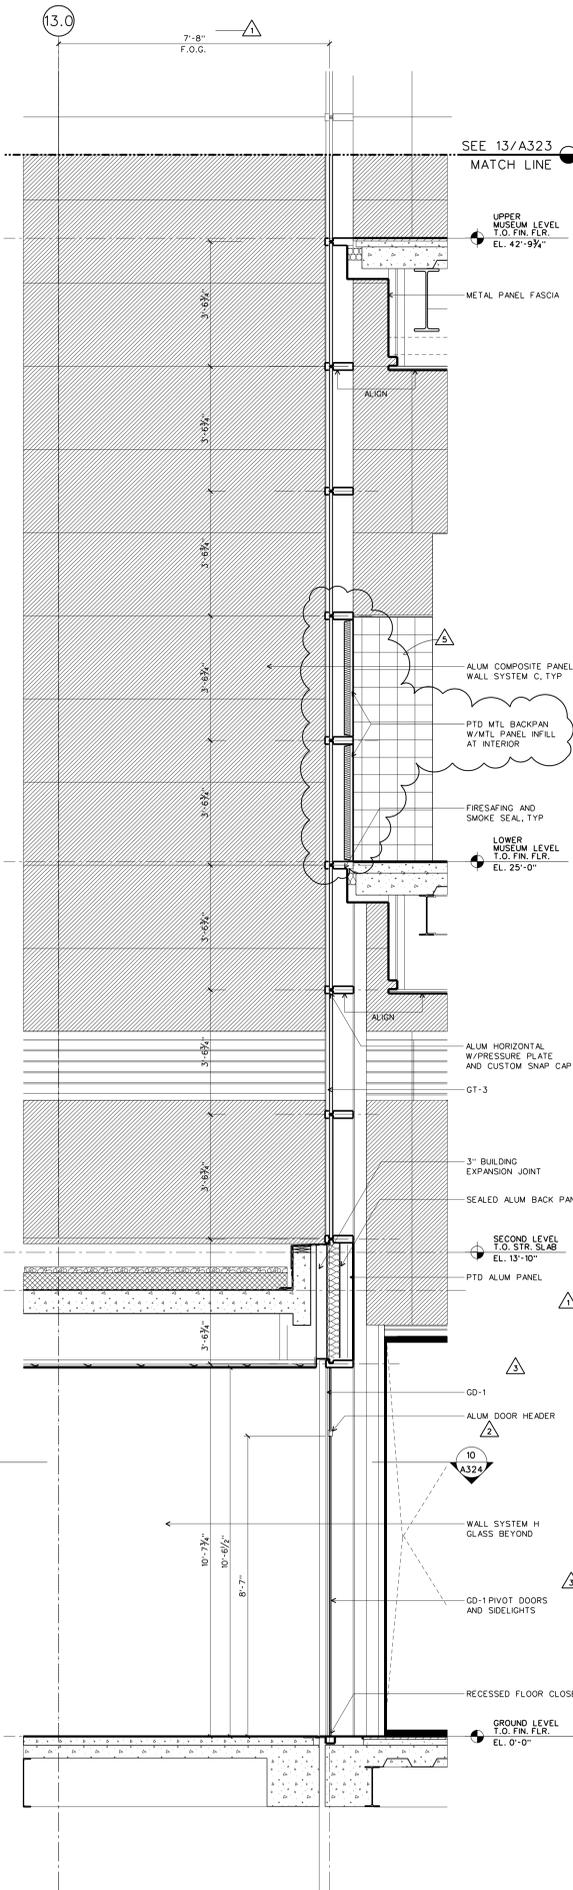

WALL SYSTEM A2: WALL SECTION AT NECK, SOUTH

DETAILS/DTL-CWA4

12

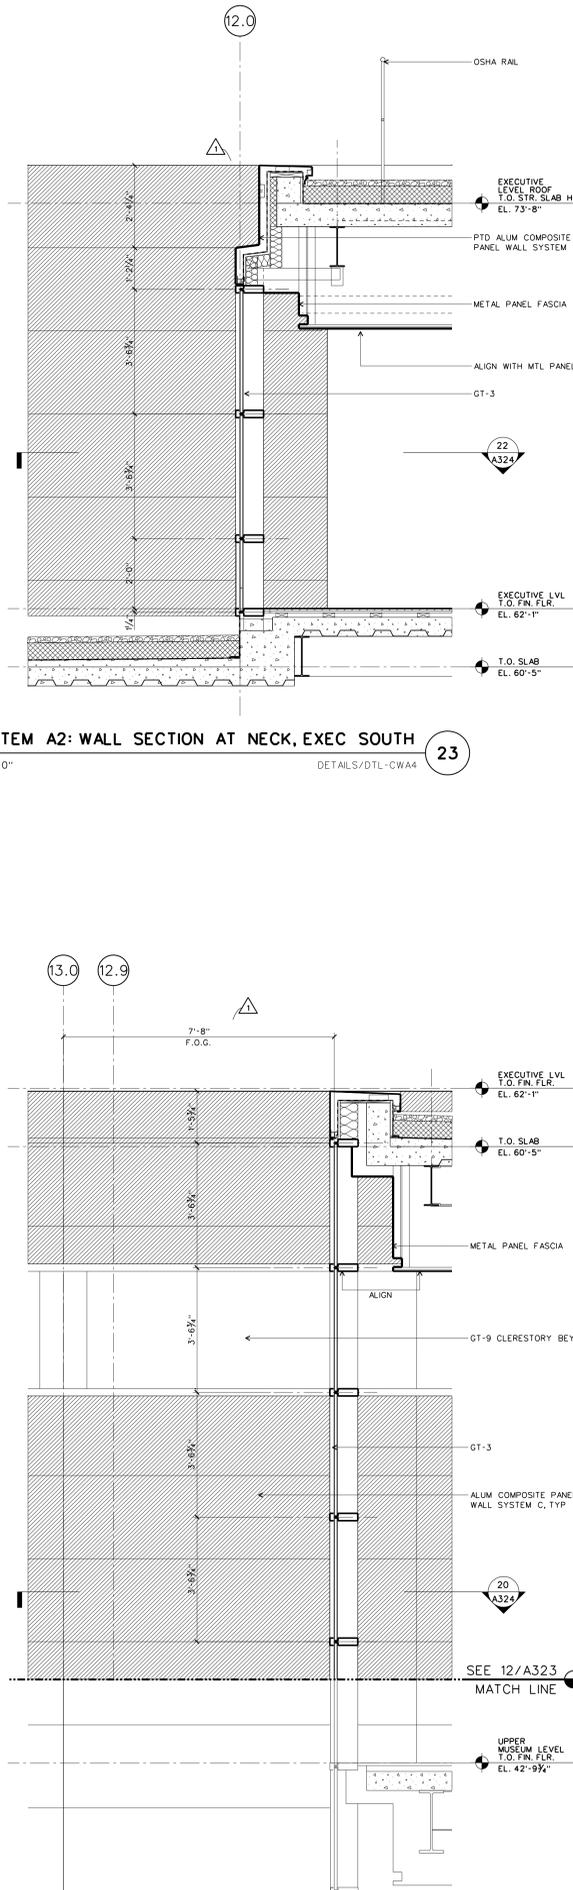

WALL SYSTEM A2: WALL SECTION AT NECK, SOUTH

DETAILS/DTL-CWA4

13

WALL SYSTEM A2: WALL SECTION AT NECK, EXEC SOUTH

SCALE: 1/2" = 1'-0"

DETAILS/DTL-CWA4

23