


Seal

ASI #22	08/01/03
Addendum #2	11/15/02
100% Construction Documents	09/27/02
90% Progress Printing	08/30/02
100% Struct./CD Progress	07/01/02
100% Design Development	03/01/02
Issue	Date

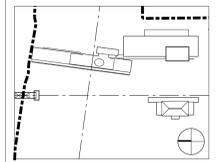

Job No. 9908

Scale 1/2" = 1'-0"

Date September 27, 2002


Title

**WALL SYSTEM C:
PLANS AND SECTIONS**


Sheet No.

A327


FOR OFFICIAL USE ONLY

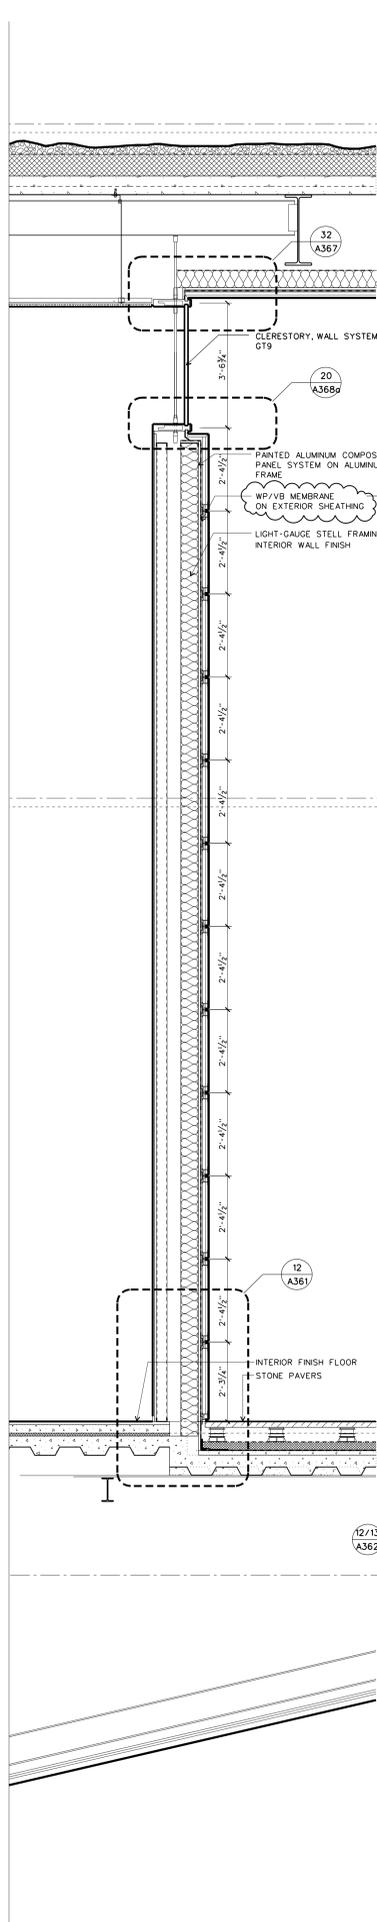


**WALL SYSTEM C: WALL SECTION
@ SOUTH RETURNING WALL**
SCALE: 1/2" = 1'-0" DETAILS/DTL-CWC2 13

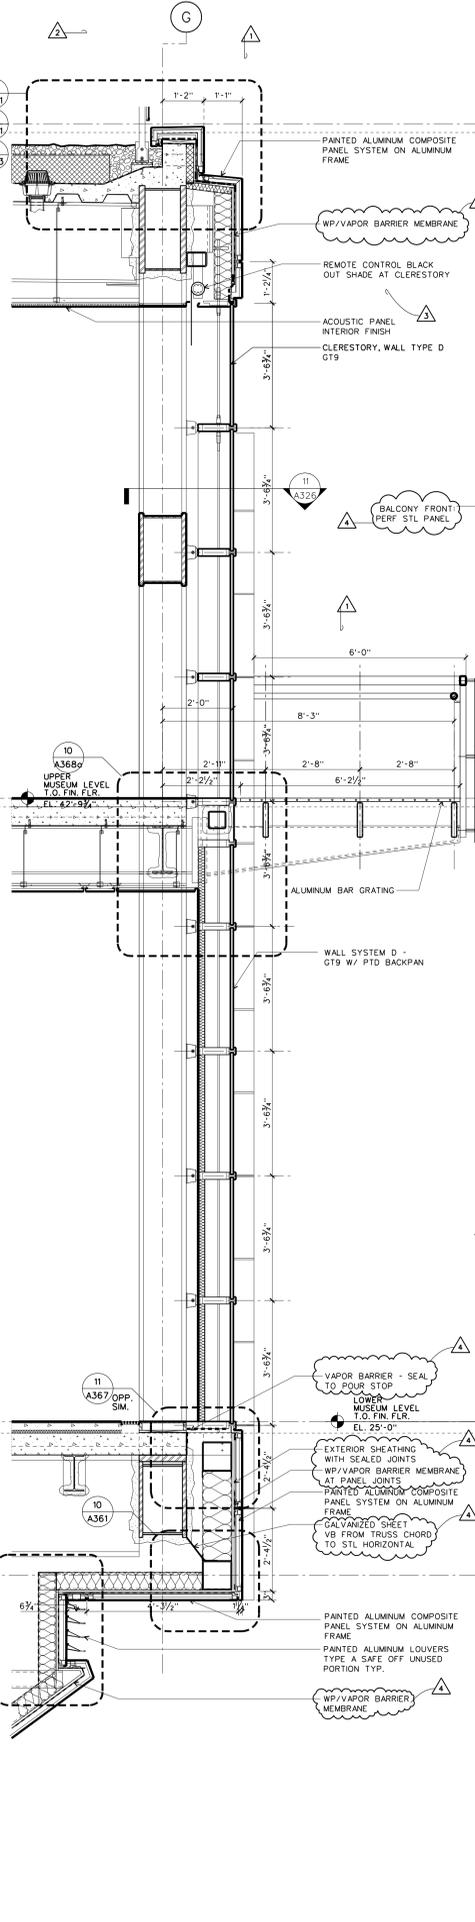


**WALL SYSTEM C:
WALL SECTION @ BALCONY**
SCALE: 1/2" = 1'-0" DETAILS/DTL-CWC2 12

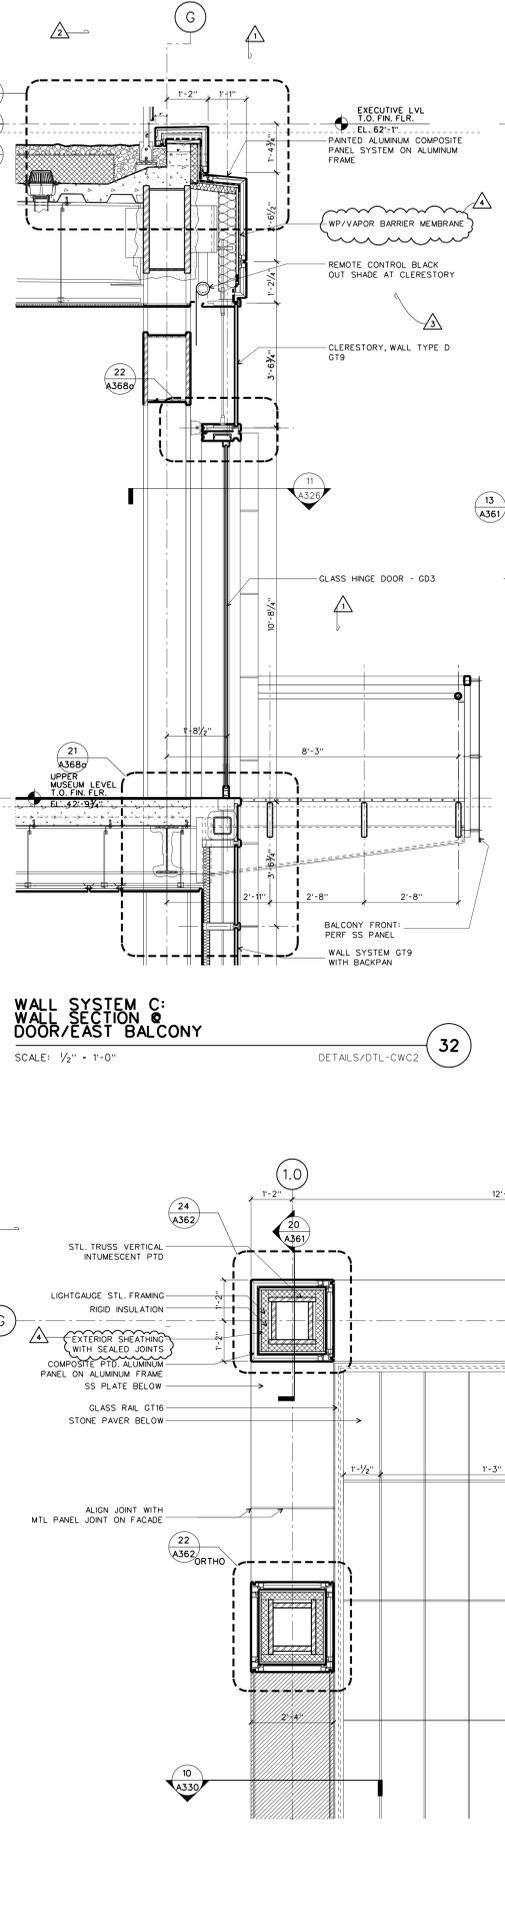

**WALL SYSTEM C:
WALL SECTION @ WINDOW/BALCONY**
SCALE: 1/2" = 1'-0" DETAILS/DTL-CWC2 11

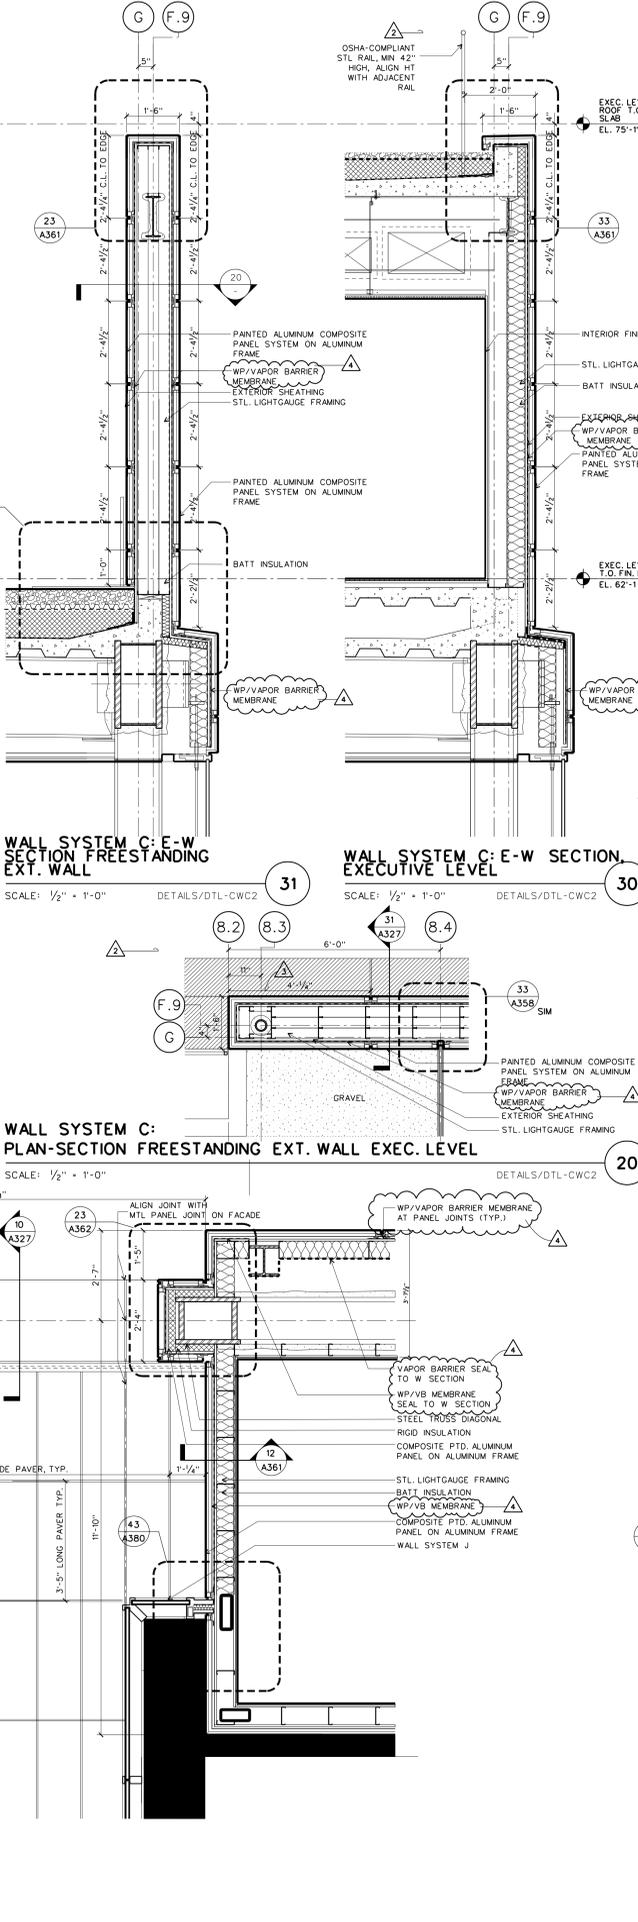

**WALL SYSTEM C:
WALL SECTION @ WINDOW/BALCONY**
SCALE: 1/2" = 1'-0" DETAILS/DTL-CWC2 11

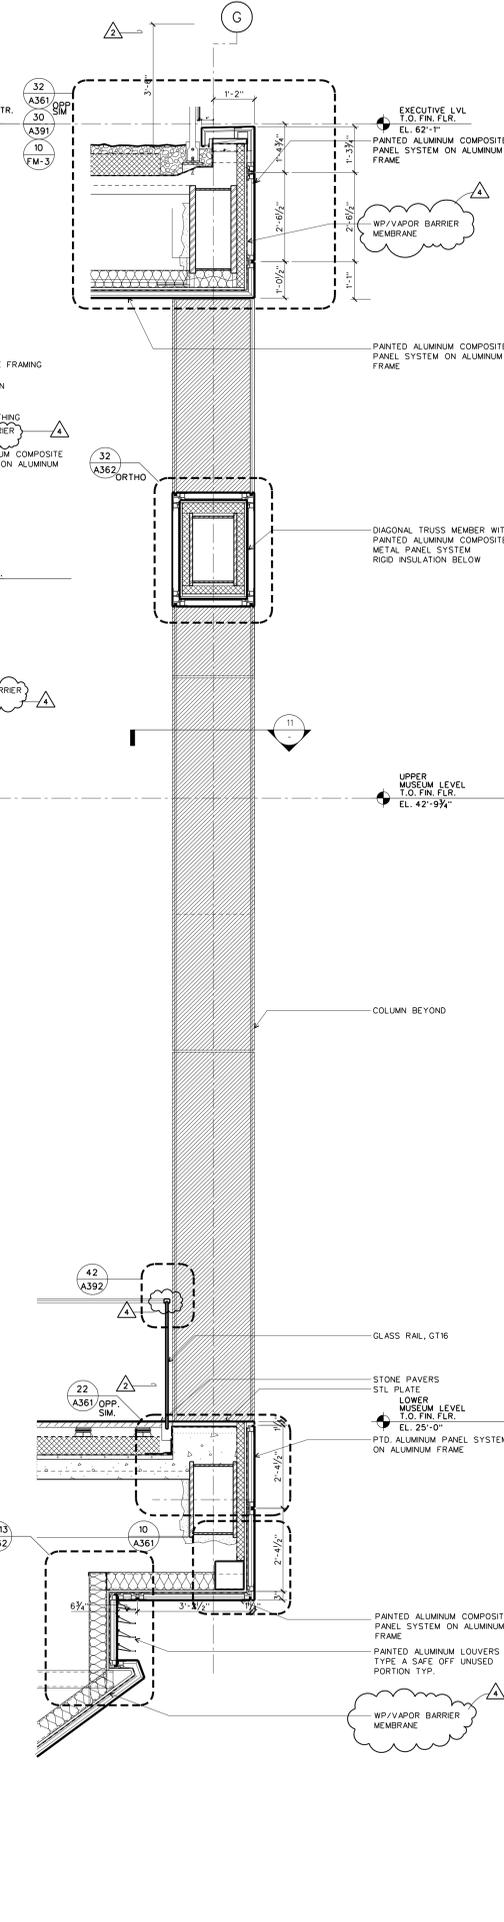

**WALL SYSTEM C:
WALL SECTION @ COLUMN COVER**
SCALE: 1/2" = 1'-0" DETAILS/DTL-CWC2 10

**WALL SYSTEM C:
WALL SECTION @
DOOR/EAST BALCONY**
SCALE: 1/2" = 1'-0" DETAILS/DTL-CWC2 32

**WALL SYSTEM C: E-W
SECTION FREESTANDING
EXT. WALL**
SCALE: 1/2" = 1'-0" DETAILS/DTL-CWC2 31

**WALL SYSTEM C: E-W SECTION
EXECUTIVE LEVEL**
SCALE: 1/2" = 1'-0" DETAILS/DTL-CWC2 30

**WALL SYSTEM C:
PLAN-SECTION FREESTANDING
EXT. WALL EXEC. LEVEL**
SCALE: 1/2" = 1'-0" DETAILS/DTL-CWC2 20