


Seal

AS1 #22	08/01/03
100% Construction Documents	09/27/02
90% Progress Printing	08/30/02
100% Struct./ CD Progress	07/01/02
Bridge Bldg. Substructure	06/14/02
100% Design Development	03/01/02
Issue	Date

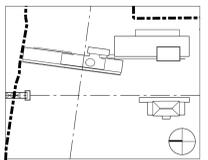

Job No. 9908

Scale 1/2" = 1'-0"

Date September 27, 2002


Title

WALL SYSTEM C  
PLAN AND SECTIONS

Sheet No.

**A328**

FOR OFFICIAL USE ONLY

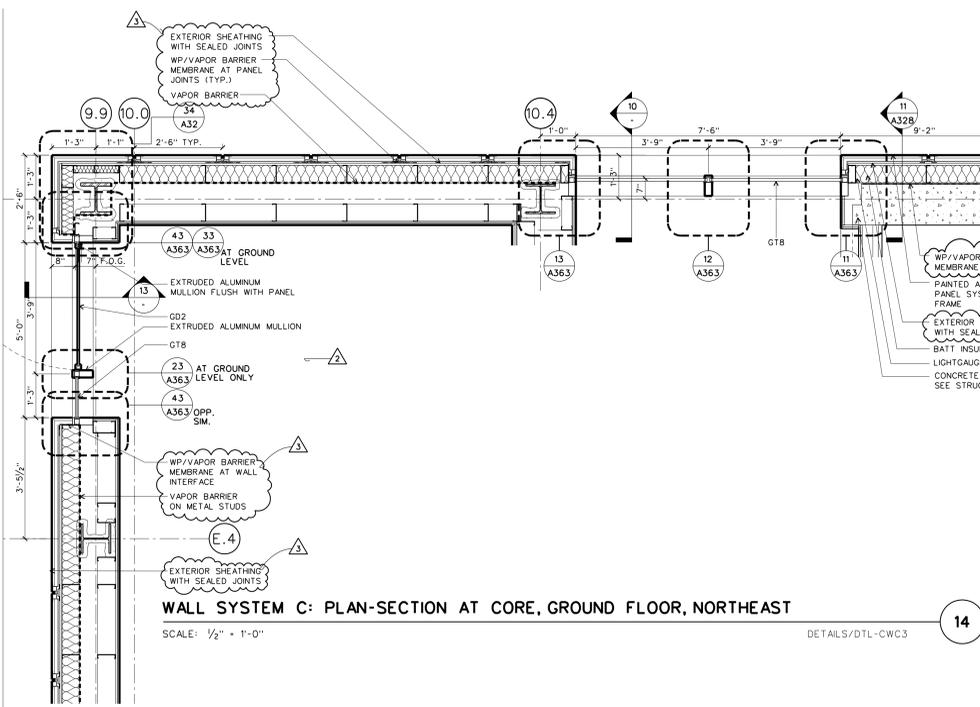


**WALL SYSTEM C: PLAN-SECTION AT CORE, GROUND FLOOR, NORTHEAST**

SCALE: 1/2" = 1'-0"

DETAILS/DTL-CWC3

14

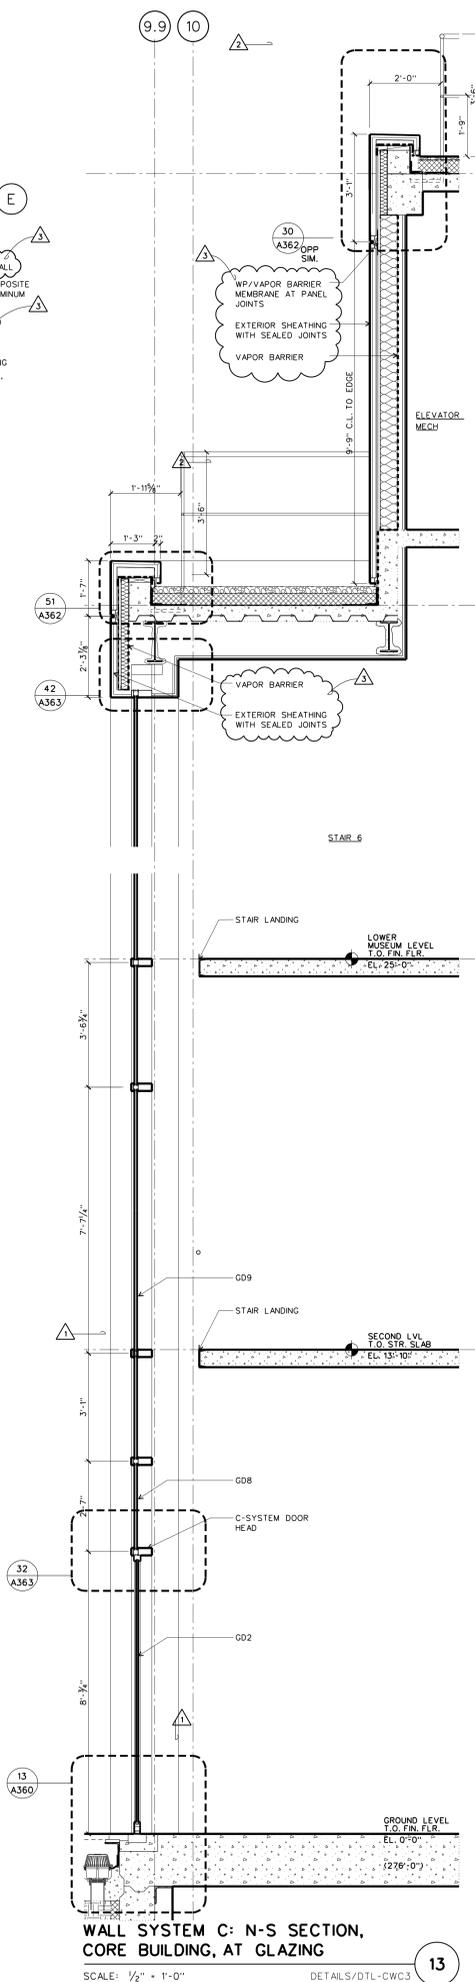


**WALL SYSTEM C: N-S SECTION,  
CORE BUILDING, AT GLAZING**

SCALE: 1/2" = 1'-0"

DETAILS/DTL-CWC3

13

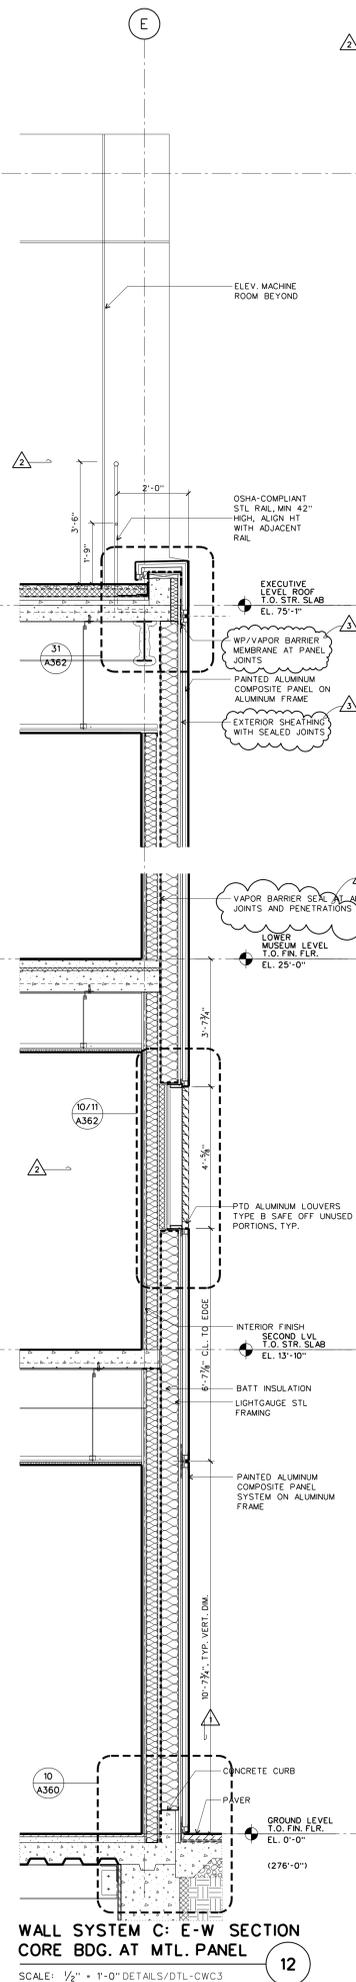


**WALL SYSTEM C: E-W SECTION  
CORE BLDG. AT MTL. PANEL**

SCALE: 1/2" = 1'-0"

DETAILS/DTL-CWC3

12

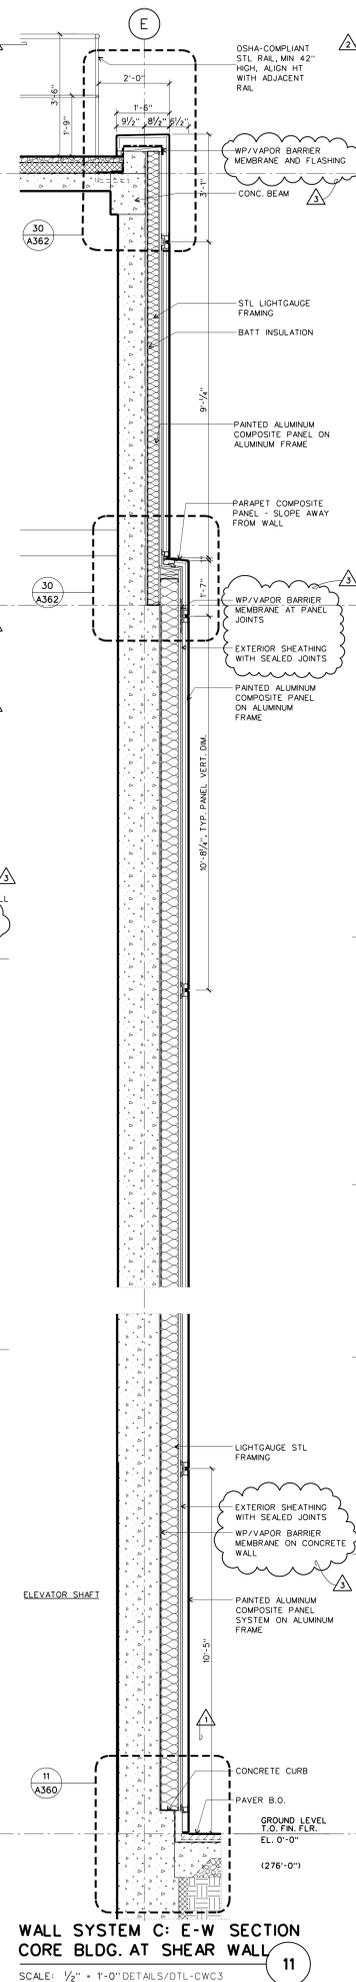


**WALL SYSTEM C: E-W SECTION  
CORE BLDG. AT SHEAR WALL**

SCALE: 1/2" = 1'-0"

DETAILS/DTL-CWC3

11

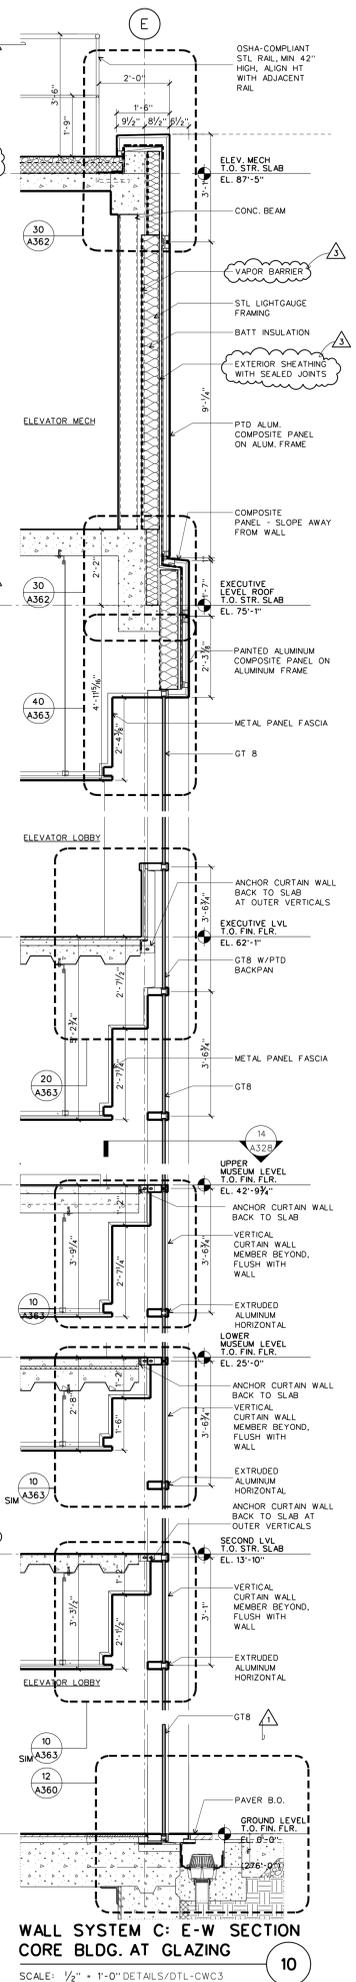

**WALL SYSTEM C: E-W SECTION  
CORE BLDG. AT GLAZING**

SCALE: 1/2" = 1'-0"

DETAILS/DTL-CWC3

10