


ASI #22	08/01/03
Addendum #2	11/15/02
100% Construction Documents	09/27/02
90% Progress Printing	08/30/02
100% Struct./ CD Progress	07/01/02
100% Design Development	03/01/02
Issue	Date

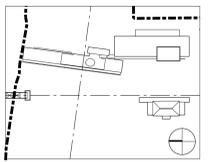

Job No. 9908

Scale 1/2" = 1'-0"

Date September 27, 2002


Title

**WALL SYSTEM D + E:  
ELEVATION AND  
SECTION**

Sheet No.

**A334**

FOR OFFICIAL USE ONLY

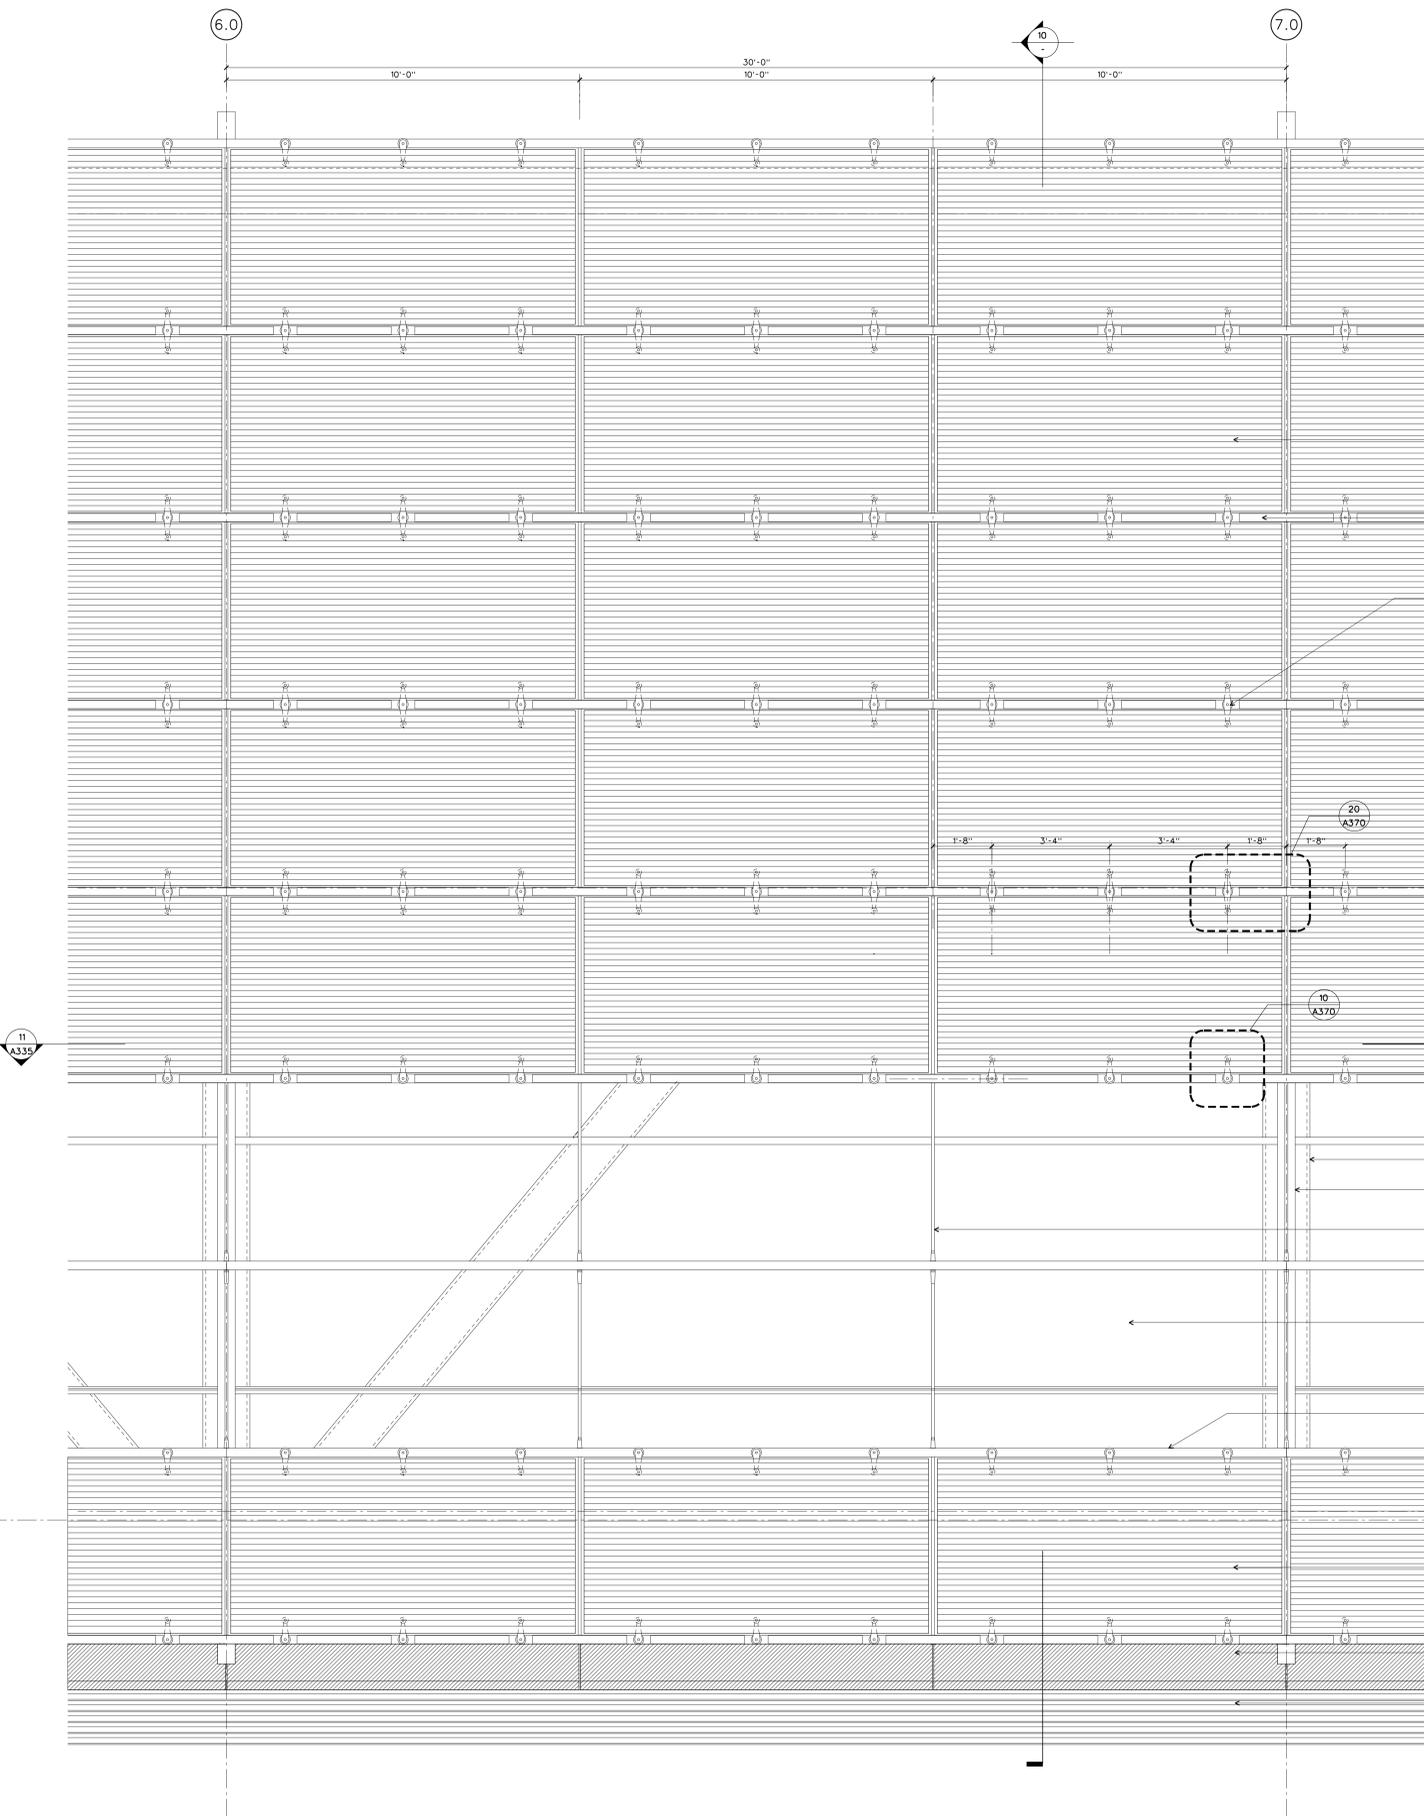


**WALL SYSTEM E: ELEVATION AT TYPICAL BAY**

SCALE: 1/2" = 1'-0"

11

DETAILS/DTL-CWD/E2

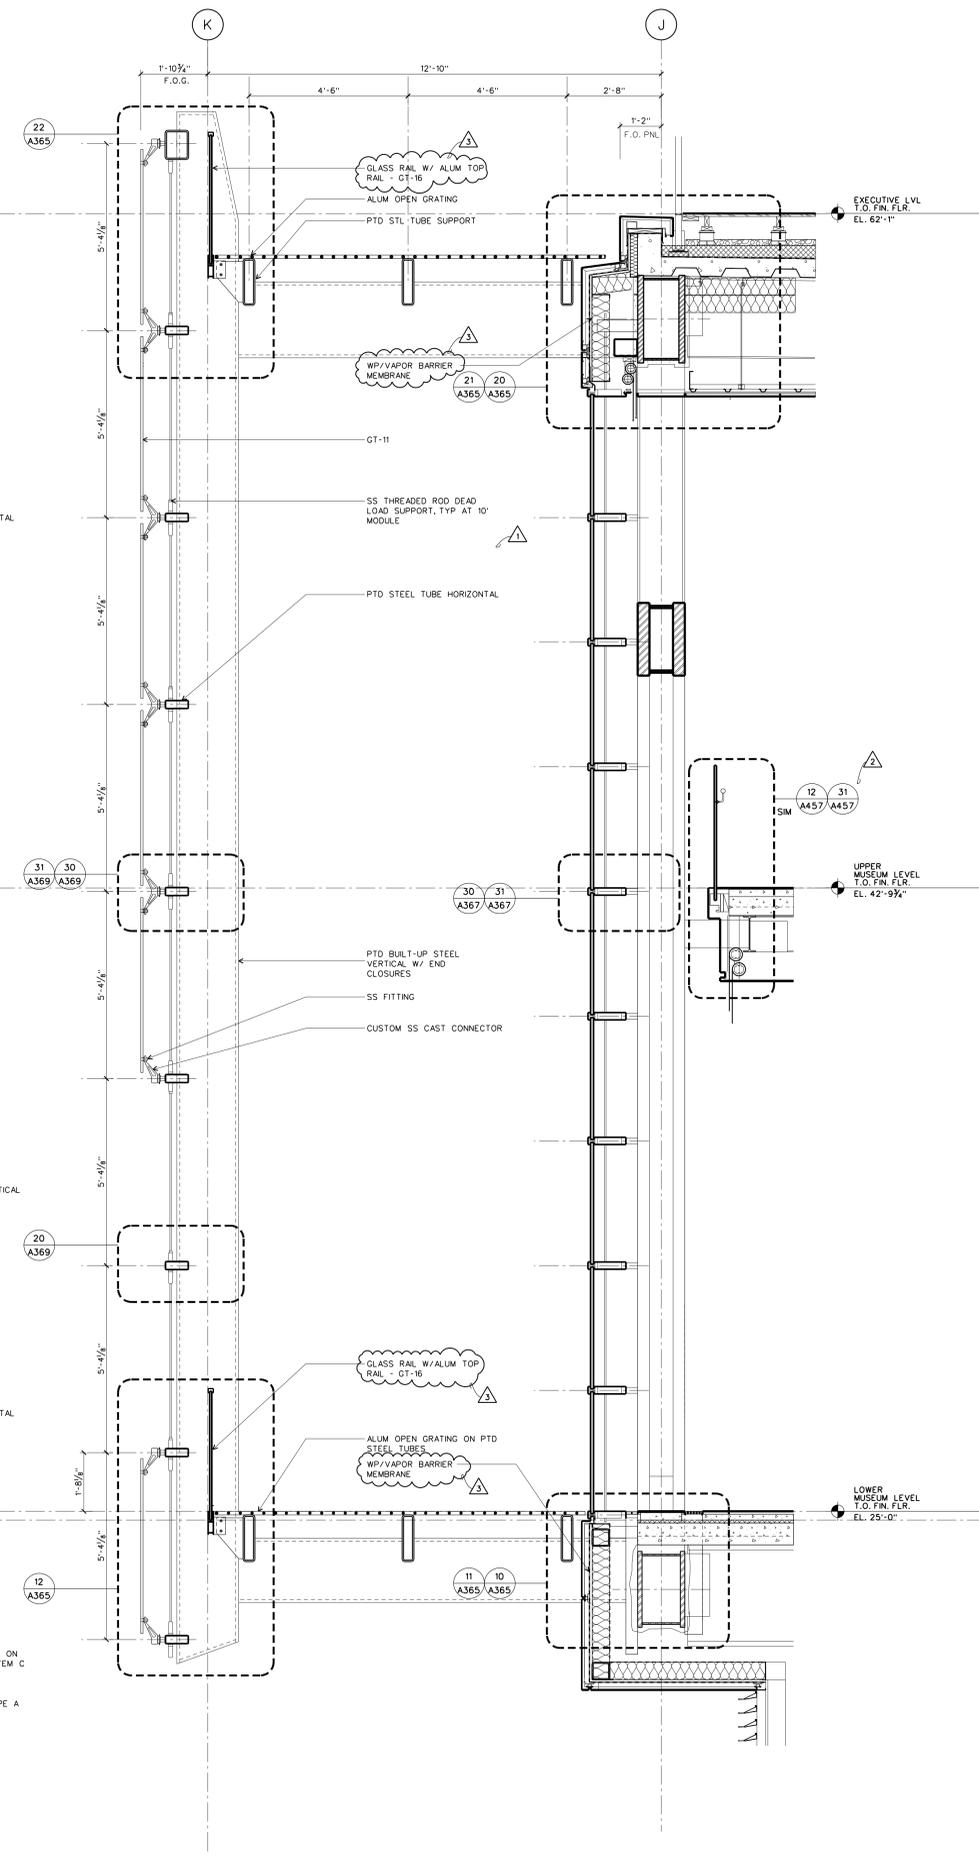

**WALL SYSTEM D/E: TYPICAL WALL SECTION**

SCALE: 1/2" = 1'-0"

10

DETAILS/DTL-CWD/E2