

**WILLIAM J. CLINTON  
PRESIDENTIAL  
CENTER**

LITTLE ROCK, ARKANSAS

Architect

**POLSHEK PARTNERSHIP LLP**  
320 West 13th Street  
New York, New York 10014  
212.807.7171

Coordinating Architects

**POLK STANLEY YEARY ARCHITECTS LTD**  
700 South Schiller Street  
Little Rock, Arkansas 72201  
501.378.0878

**WITSELL EVANS RASCO**  
901 West Third Street  
Little Rock, Arkansas 72201  
501.374.5300

**WOODS CARADINE ARCHITECTS**  
2200 South Main Street  
Little Rock, Arkansas 72206  
501.374.4960

Landscape Architects

**HARGREAVES ASSOCIATES**  
118 Magazine Street  
Cambridge, Massachusetts 02139  
617.661.0070

**LANDSCAPE ARCHITECTURE, Inc.**  
2300 Cottondale Lane Suite 202  
Little Rock, Arkansas 72202  
501.374.5810

Structural Engineer

**LESLIE E. ROBERTSON ASSOC., RLLP**  
30 Broad Street, 47th Floor  
New York, New York 10004  
212.750.9000

MEP Engineers

**FLACK + KURTZ, Inc.**  
475 Fifth Avenue  
New York, New York 10017  
212.532.9600


**CROMWELL ARCHITECTS ENGINEERS**  
101 South Spring Street  
Little Rock, Arkansas 72201  
501.372.2900

Curtainwall Consultant

**R. A. HEINTGES ARCHITECTS**  
126 Fifth Avenue, 9th Floor  
New York, New York 10011  
212.652.2968

Seal

| Issue                       | Date     |
|-----------------------------|----------|
| ASI #22                     | 08/01/03 |
| Addendum #2                 | 11/15/02 |
| 100% Construction Documents | 09/27/02 |
| 90% Progress Printing       | 08/30/02 |
| 100% Struct./CD Progress    | 07/01/02 |
| 100% Design Development     | 03/01/02 |

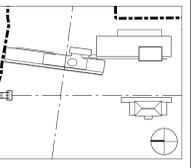

Job No. 9908

Scale 1/2" = 1'-0"

Date September 27, 2002


Title

**WALL SYSTEM J  
PLAN AND SECTIONS**

Sheet No.

**A345**

**FOR OFFICIAL USE ONLY**

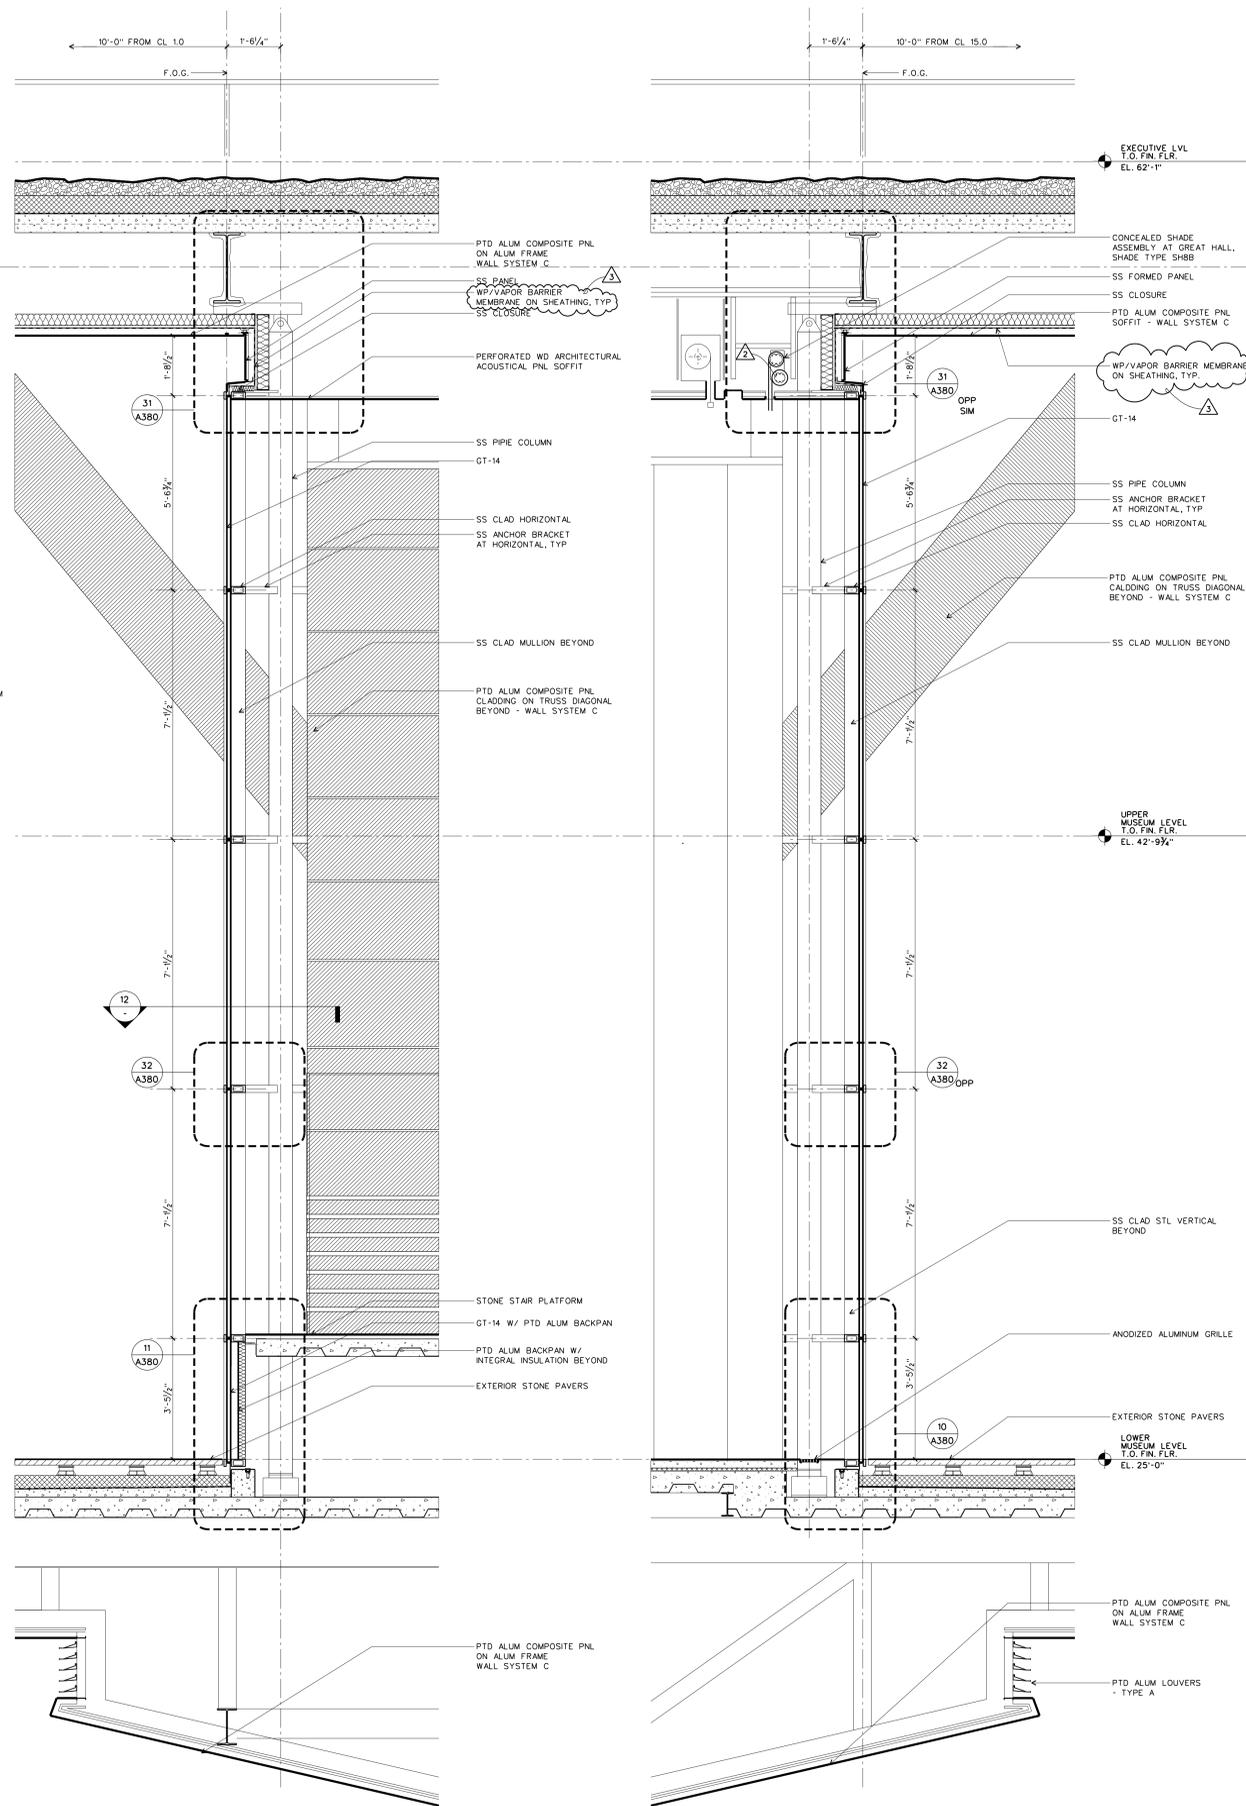

**WALL SYSTEM J: WALL SECTION AT NORTH BOX**

SCALE: 1/2" = 1'-0"

DETAILS/DTL-CWJ


11

**WALL SYSTEM J: WALL SECTION AT SOUTH BOX**

SCALE: 1/2" = 1'-0"

DETAILS/DTL-CWJ

10

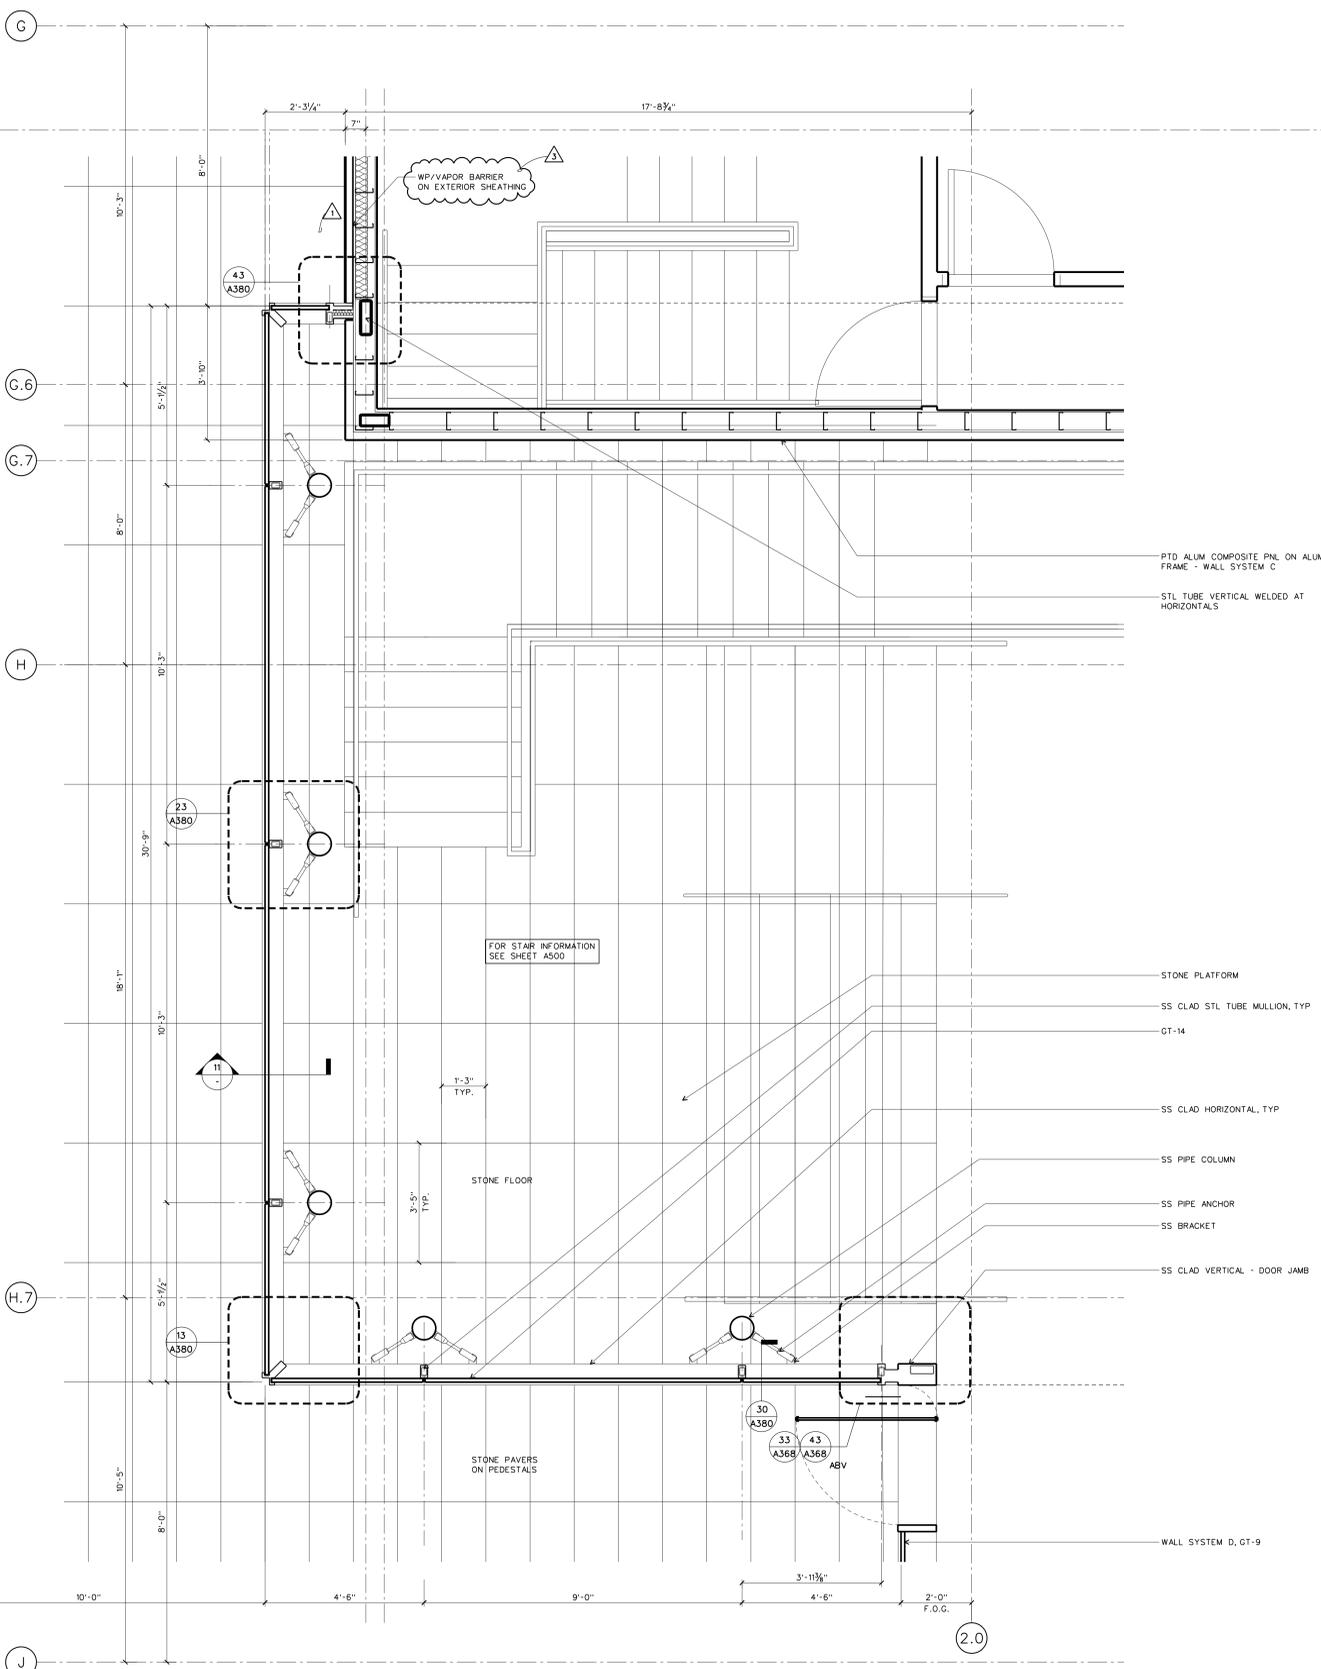

**WALL SYSTEM J: PLAN SECTION AT NORTH BOX**

SCALE: 1/2" = 1'-0"

DETAILS/DTL-CWJ

12