




WALL SYSTEM A1: BASE SECT DETAIL AT LOBBY
 SCALE: 1/2" = 1'-0"
 D-CWA01 33

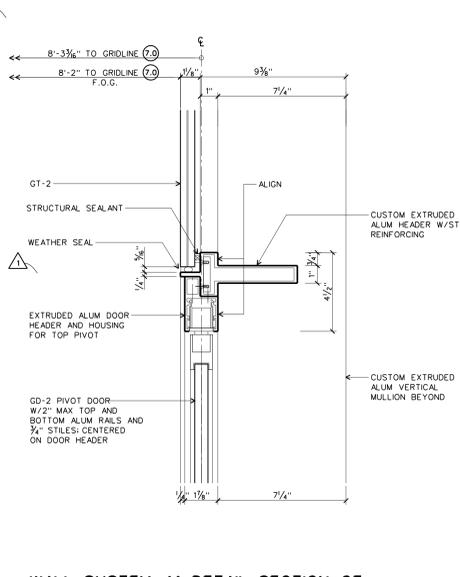


WALL SYSTEM A1: DETAIL SECTION OF CAFE DOOR HEADER
 SCALE: 3/4" = 1'-0"
 D-CWA01 32

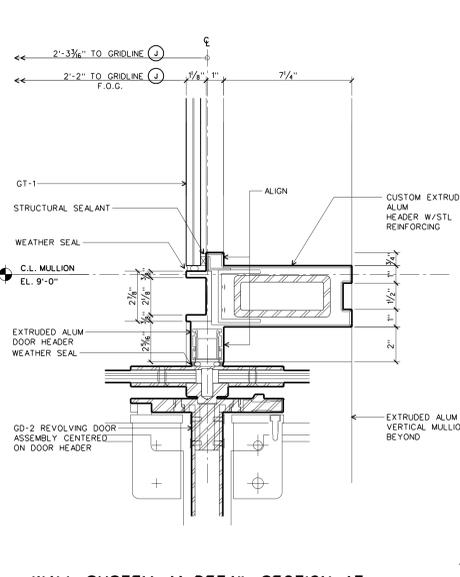


WALL SYSTEM A1: DETAIL SECTION AT LOBBY REVOLVING DOOR HEADER
 SCALE: 3/4" = 1'-0"
 D-CWA01 31A

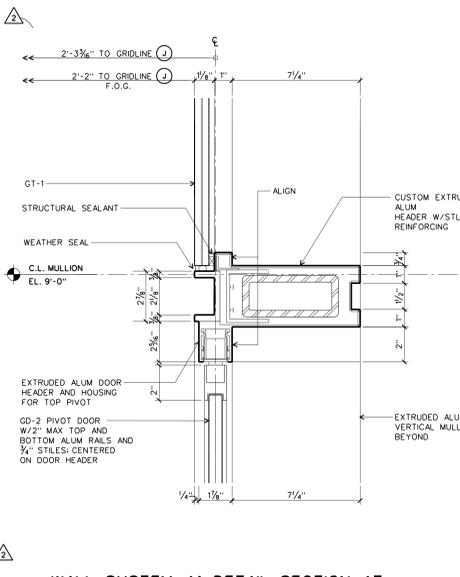


WALL SYSTEM A1: DETAIL SECTION AT LOBBY PIVOT DOOR HEADER
 SCALE: 3/4" = 1'-0"
 D-CWA01 31

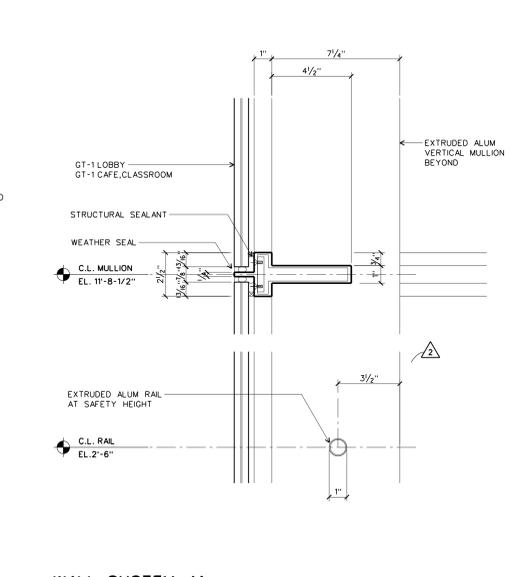


WALL SYSTEM A1: DETAIL SECTION OF HORIZONTAL
 SCALE: 3/4" = 1'-0"
 D-CWA01 30

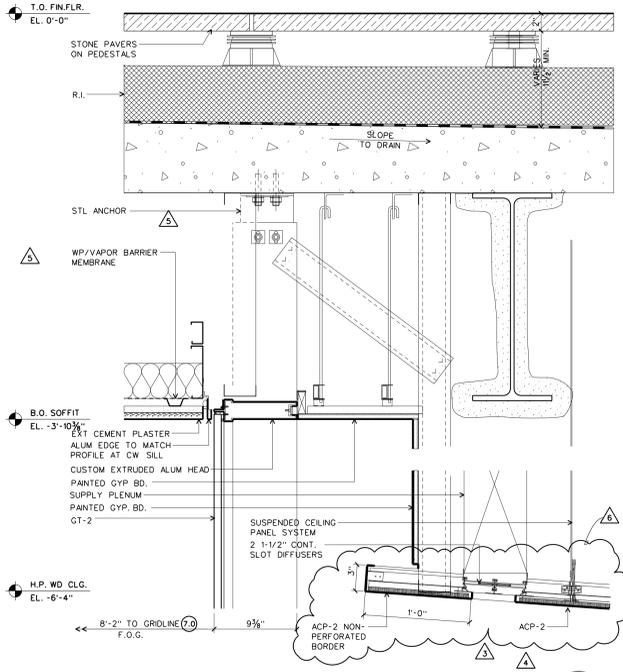


WALL SYSTEM A1: SECTION OF CAFE HEAD
 SCALE: 1-1/2" = 1'-0"
 D-CWA01 23

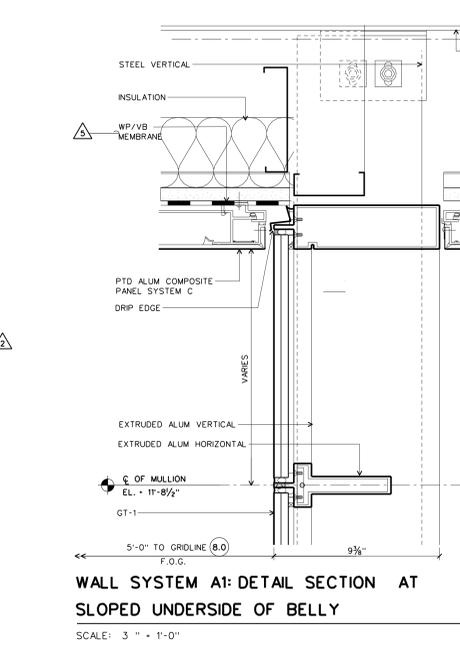


WALL SYSTEM A1: DETAIL SECTION AT SLOPPED UNDERSIDE OF BELLY
 SCALE: 3/4" = 1'-0"
 D-CWA01 22

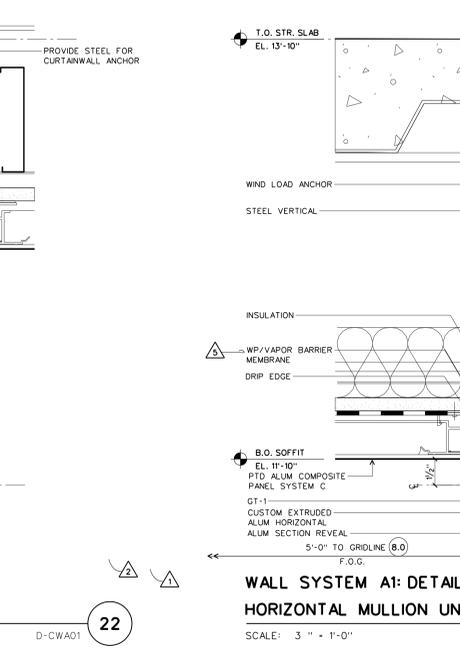


WALL SYSTEM A1: DETAIL SECTION OF HORIZONTAL MULLION UNDER BELLY
 SCALE: 3/4" = 1'-0"
 D-CWA01 21

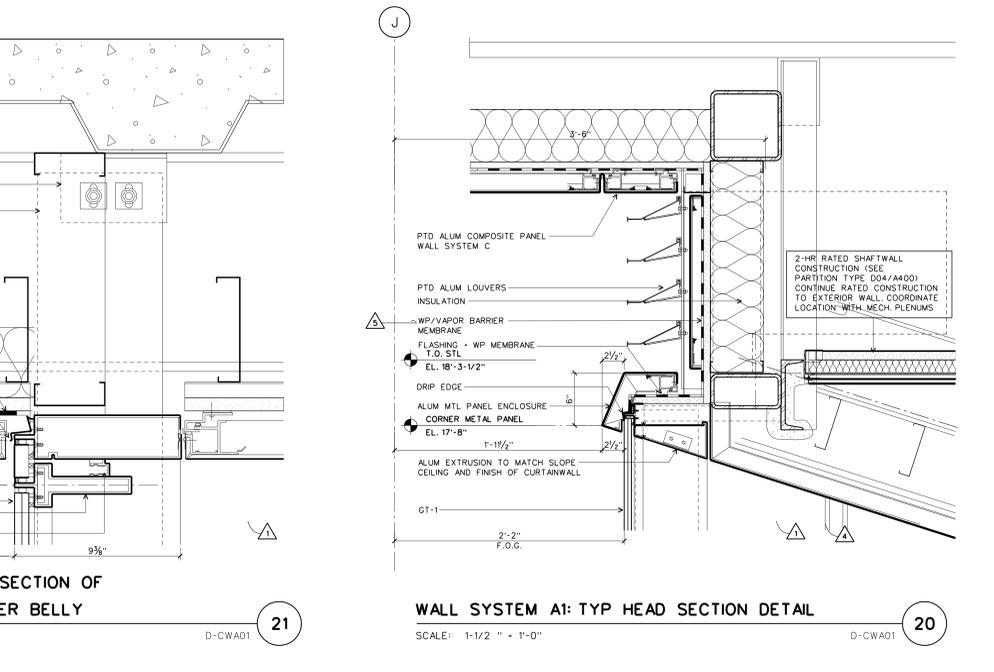


WALL SYSTEM A1: TYP HEAD SECTION DETAIL
 SCALE: 1-1/2" = 1'-0"
 D-CWA01 20

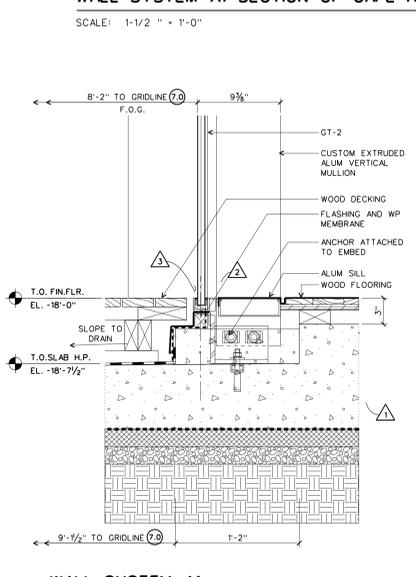


WALL SYSTEM A1: BASE DETAIL AT CAFE
 SCALE: 1-1/2" = 1'-0"
 D-CWA01 12

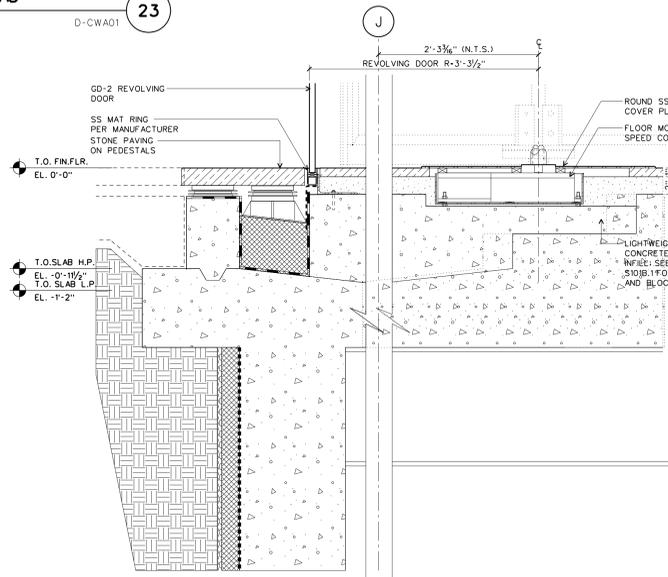

WALL SYSTEM A1: BASE DETAIL AT LOBBY REVOLVING DOOR
 SCALE: 1-1/2" = 1'-0"
 D-CWA01 11A

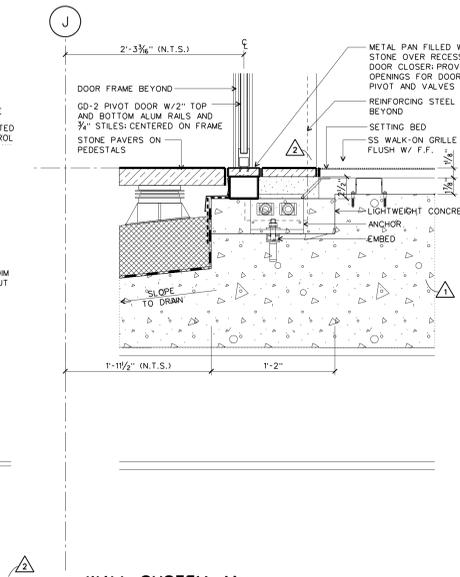

WALL SYSTEM A1: BASE DETAIL AT LOBBY PIVOT DOOR
 SCALE: 1-1/2" = 1'-0"
 D-CWA01 11

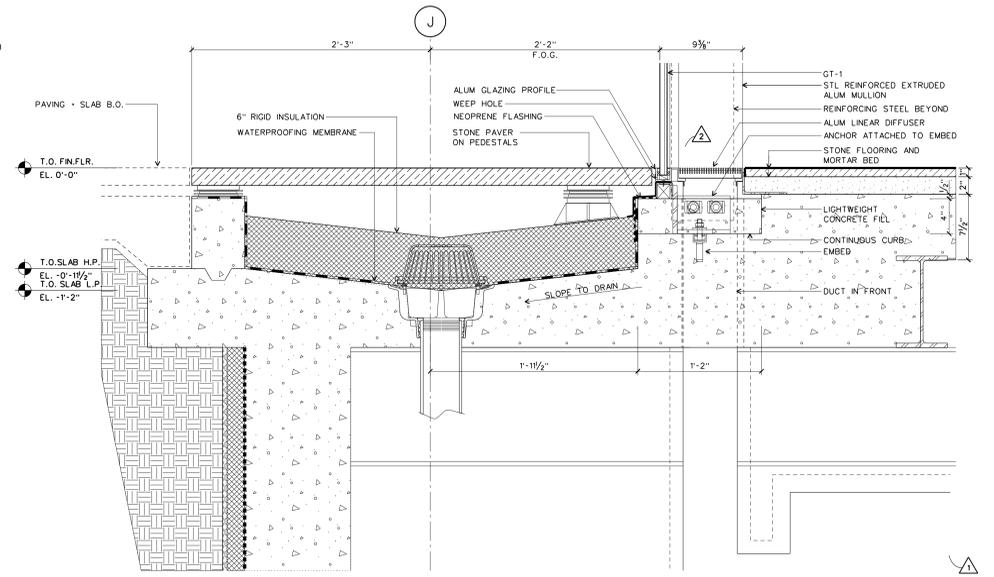

WALL SYSTEM A1: BASE SECT DETAIL AT LOBBY, TYP
 SCALE: 1-1/2" = 1'-0"
 D-CWA01 10

WILLIAM J. CLINTON PRESIDENTIAL CENTER
 LITTLE ROCK, ARKANSAS

Architect
 POLSHEK PARTNERSHIP LLP
 320 West 13th Street
 New York, New York 10014
 212.807.7171

Coordinating Architects
 POLK STANLEY YEARY ARCHITECTS LTD
 700 South Schiller Street
 Little Rock, Arkansas 72201
 501.378.0878

WITSELL EVANS RASCO
 901 West Third Street
 Little Rock, Arkansas 72201
 501.374.5300

WOODS CARADINE ARCHITECTS
 2200 South Main Street
 Little Rock, Arkansas 72206
 501.374.4060

Landscape Architects
 HARGREAVES ASSOCIATES
 118 Magazine Street
 Cambridge, Massachusetts 02139
 617.661.0070

LANDSCAPE ARCHITECTURE, Inc.
 2300 Cottondale Lane Suite 202
 Little Rock, Arkansas 72202
 501.374.5810

Structural Engineer
 LESLIE E. ROBERTSON ASSOC., RLLP
 30 Broad Street, 47th Floor
 New York, New York 10004
 212.750.9000

MEP Engineers
 FLACK + KURTZ, Inc.
 475 Fifth Avenue
 New York, New York 10017
 212.532.9600

CROMWELL ARCHITECTS ENGINEERS
 101 South Spring Street
 Little Rock, Arkansas 72201
 501.372.2900

Curtainwall Consultant
 R. A. HEINTGES ARCHITECTS
 126 Fifth Avenue, 9th Floor
 New York, New York 10011
 212.652-2966

Seal

ASI #23	09/12/03
ASI #22	08/01/03
ASI #18	04/18/03
Addendum #2	11/15/02
100% Construction Documents	09/27/02
90% Progress Printing	08/30/02
100% Struct./CD Progress	07/10/02
Bridge Bldg. Substructure	06/14/02
100% Design Development	03/01/02
Issue	Date

Job No. 9908
 Scale AS NOTED
 Date September 27, 2002
 Title

WALL SYSTEMS A1: SECTION DETAILS

Sheet No. **A355**

FOR OFFICIAL USE ONLY