


Issue	Date
ASI #22	08/01/03
ASI #20	06/08/03
100% Construction Documents	09/27/02
90% Progress Printing	08/30/02
100% Struct./CD Progress	07/01/02
Bridge Bldg. Substructure	06/14/02
100% Design Development	03/01/02
Issue	Date

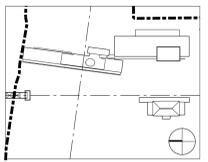


Job No. 9908  
Scale 3" = 1'-0"  
Date September 27, 2002  
Title


**WALL SYSTEM A1  
AND SYSTEM A2:  
PLAN DETAILS**

**A356**


FOR OFFICIAL USE ONLY

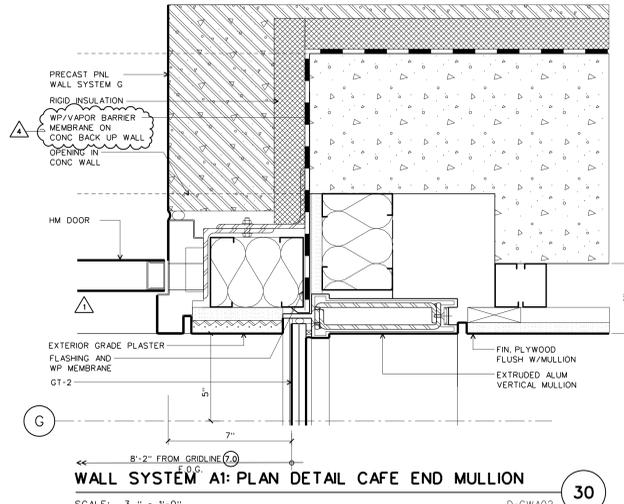


**WALL SYSTEM A1: PLAN DETAIL CAFE END MULLION**  
SCALE: 3" = 1'-0" D-CWA02 30

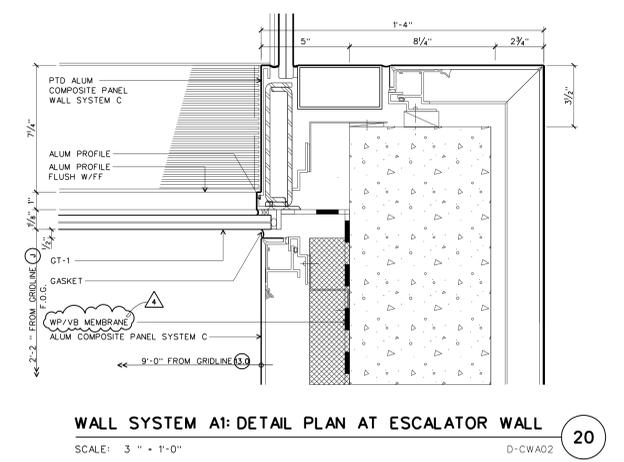


**WALL SYSTEM A1: DETAIL PLAN AT ESCALATOR WALL**  
SCALE: 3" = 1'-0" D-CWA02 20

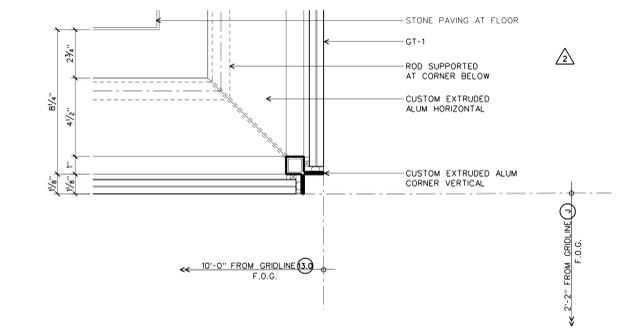


**WALL SYSTEM A1: DETAIL PLAN CORNER, TYP**  
SCALE: 3" = 1'-0" D-CWA02 10

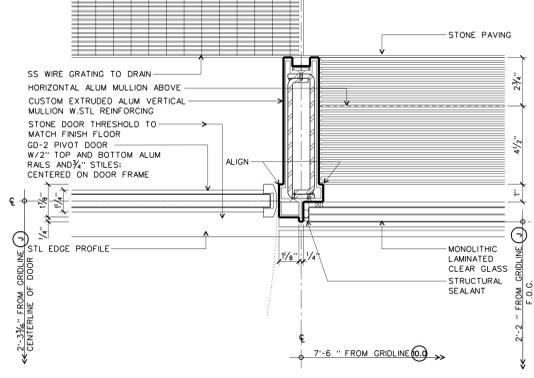


**WALL SYSTEM A1: DETAIL PLAN AT LOBBY DOOR**  
SCALE: 3" = 1'-0" D-CWA02 21

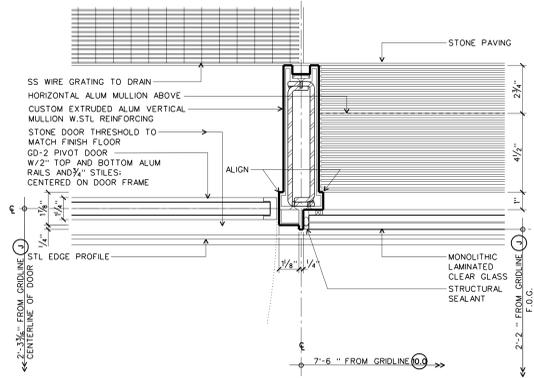


**WALL SYSTEM A1: DETAIL PLAN AT REVOLVING DOOR**  
SCALE: 3" = 1'-0" D-CWA02 22

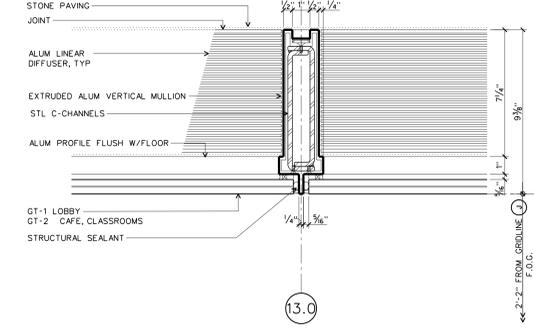


**WALL SYSTEM A1: PLAN DETAIL MULLION, TYP**  
SCALE: 3" = 1'-0" D-CWA02 11

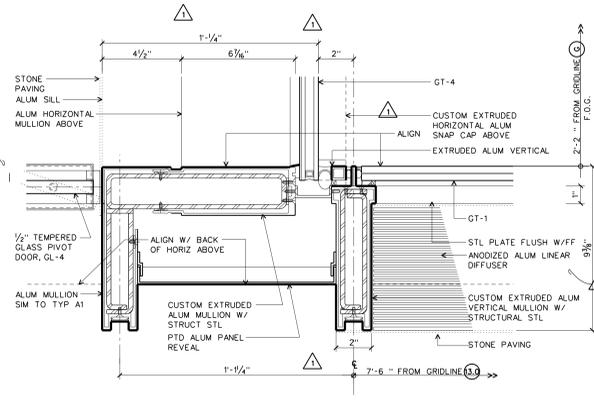


**WALL SYSTEM A1/A2: INTERFACE AT GIFTSHOP**  
SCALE: 3" = 1'-0" D-CWA02 12

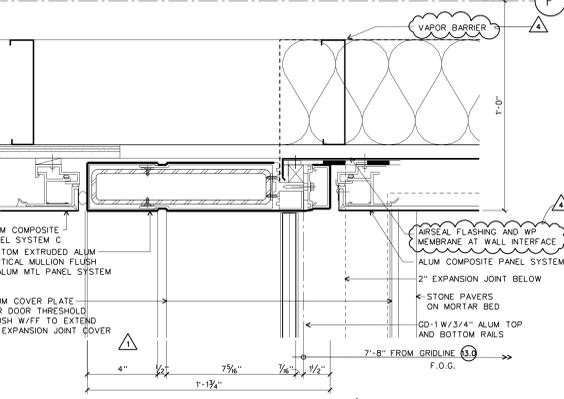


**WALL SYSTEM A2: END MULLION AT SOUTH LOBBY**  
SCALE: 3" = 1'-0" D-CWA02 43

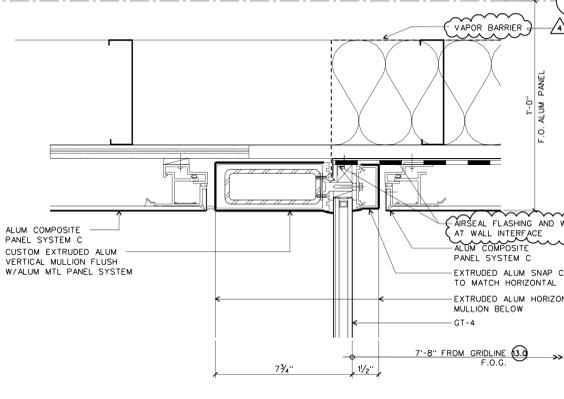

**WALL SYSTEM A2: VERTICAL AT UPPER LEVELS**  
SCALE: 3" = 1'-0" D-CWA02 42

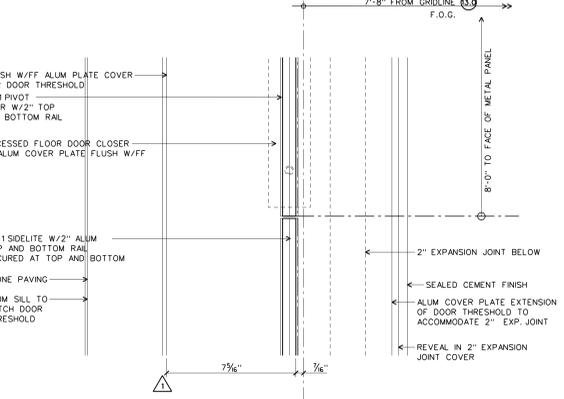

**WALL SYSTEM A2: DETAIL PLAN AT EXPANSION JOINT**  
SCALE: 3" = 1'-0" D-CWA02 23

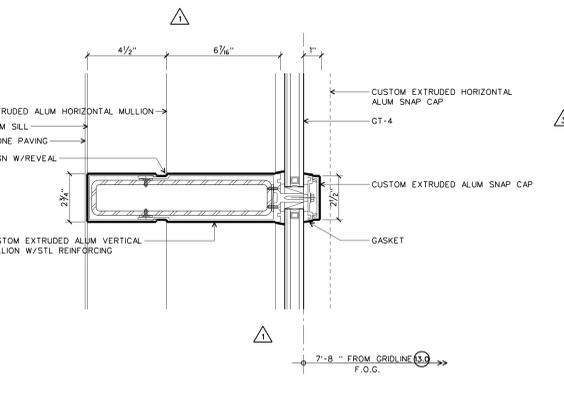

**WALL SYSTEM A2: DETAIL PLAN VERTICAL MULLION**  
SCALE: 3" = 1'-0" D-CWA02 13