



ASI #22	08/01/03
ASI #20	08/06/03
100% Construction Documents	09/27/02
90% Progress Printing	08/30/02
100% Struct./CD Progress	07/01/02
100% Design Development	03/01/02
Issue	Date


Job No.	9908
Scale	AS NOTED
Date	September 27, 2002
Title	WALL SYSTEM A3: SECTION AND PLAN DETAILS
Sheet No.	A358

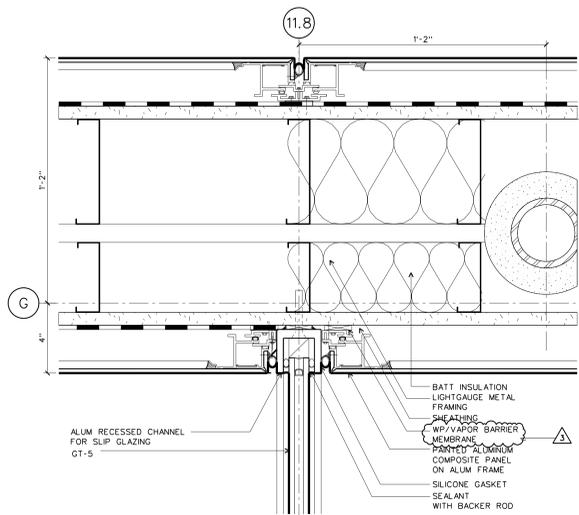


WALL SYSTEM A3: PLAN DETAIL AT END GLASS WALL
SCALE: 3" = 1'-0"
D-CWA05

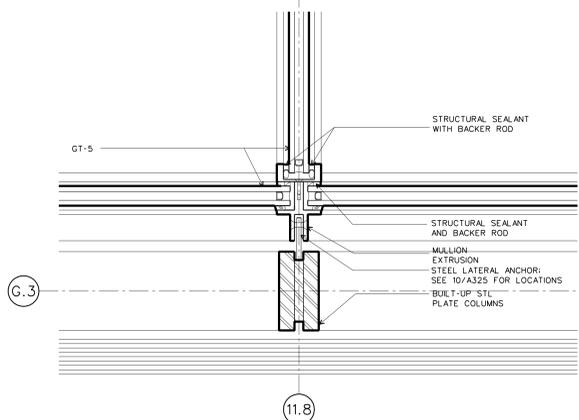


WALL SYSTEM A3: PLAN DETAIL AT END GLASS WALL
SCALE: 3" = 1'-0"
D-CWA05

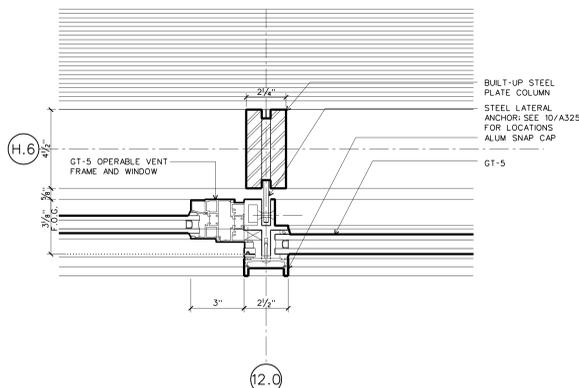


WALL SYSTEM A3: PLAN DETAIL TYP
SCALE: 3" = 1'-0"
D-CWA05

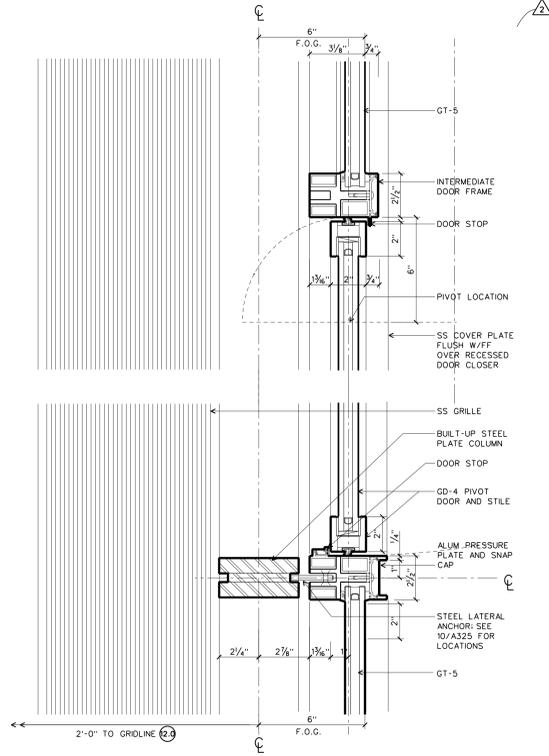


WALL SYSTEM A3: SECTION AT PIVOT DR AND SIDELITE
SCALE: 3" = 1'-0"
D-CWA05

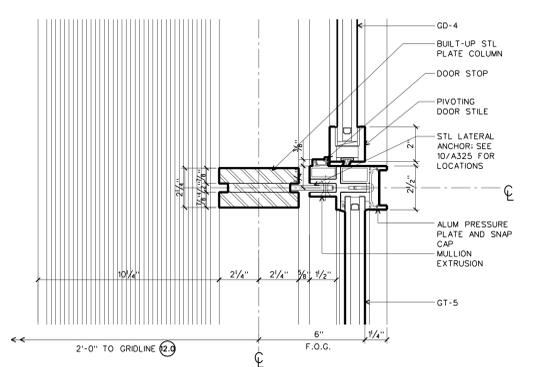


WALL SYSTEM A3: PLAN AT PIVOT DOOR
SCALE: 3" = 1'-0"
D-CWA05

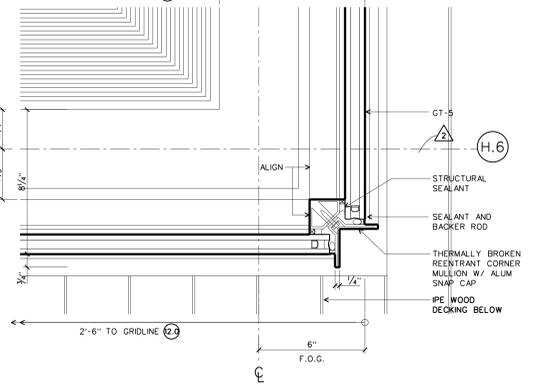


WALL SYSTEM A3: PLAN DETAIL AT TYP MULLION
SCALE: 3" = 1'-0"
D-CWA05

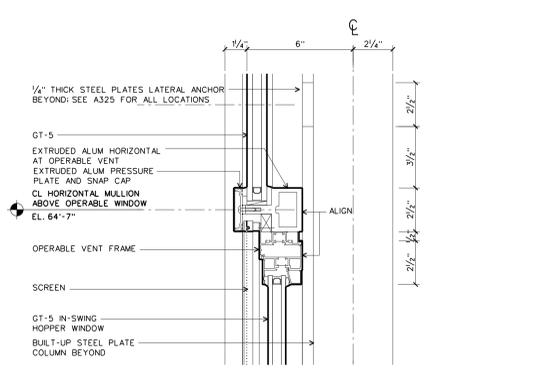


WALL SYSTEM A3: SECTION AT OPERABLE WINDOW
SCALE: 3" = 1'-0"
D-CWA05

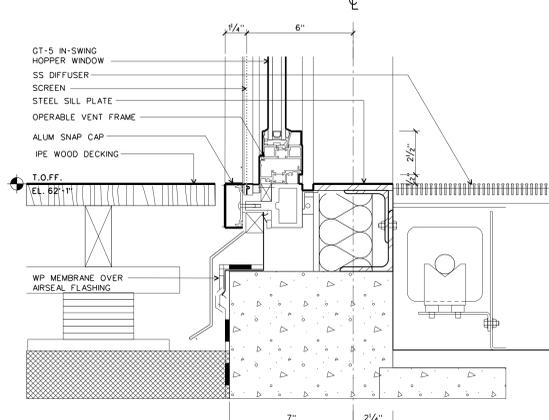


WALL SYSTEM A3: SECTION AT OPERABLE WINDOW
SCALE: 3" = 1'-0"
D-CWA05

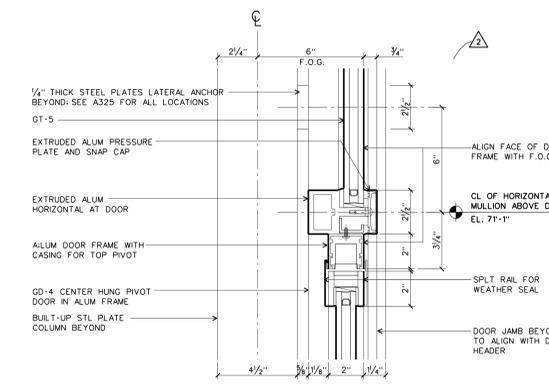


WALL SYSTEM A3: DETAIL AT PIVOT DOOR HEAD
SCALE: 3" = 1'-0"
D-CWA04

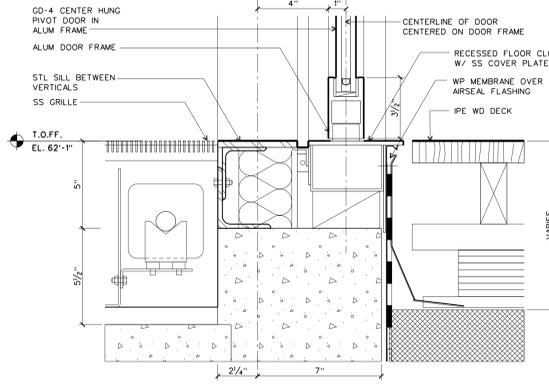


WALL SYSTEM A3: DETAIL AT PIVOT DOOR SILL
SCALE: 3" = 1'-0"
D-CWA04

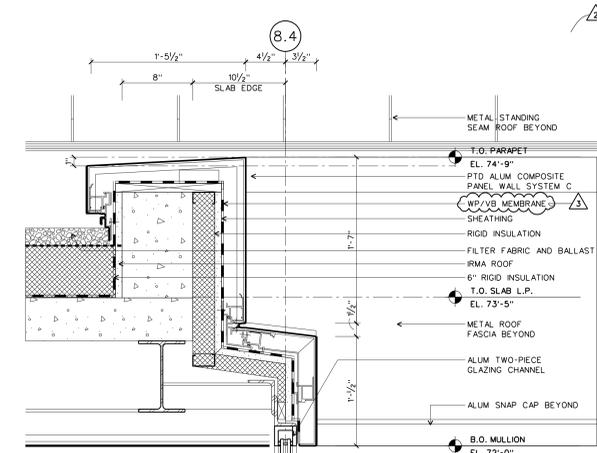


WALL SYSTEM A3: SECTION DETAIL AT BASE AND HEAD
SCALE: 1-1/2" = 1'-0"
D-CWA04

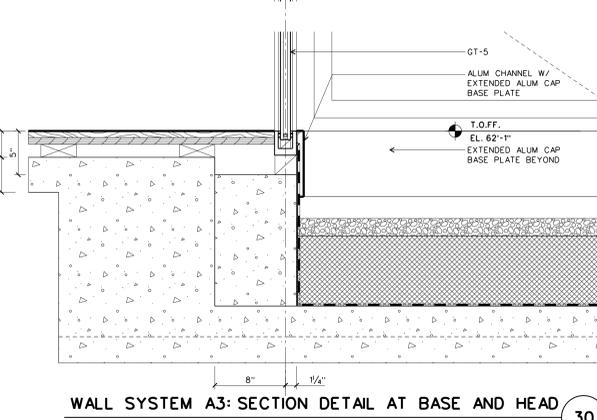

WALL SYSTEM A3: SECTION DETAIL AT BASE AND HEAD
SCALE: 1-1/2" = 1'-0"
D-CWA04

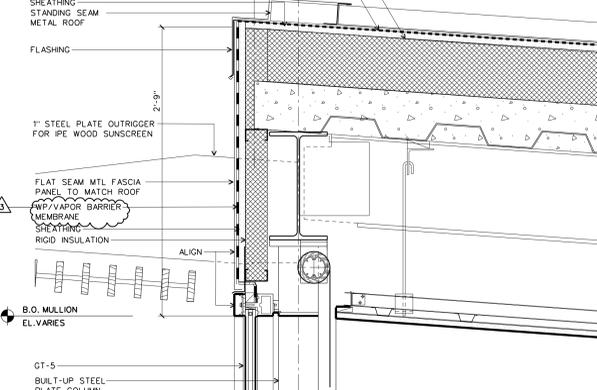

WALL SYSTEM A3: SECTION DETAIL AT HEAD TYP
SCALE: 1-1/2" = 1'-0"
D-CWA04

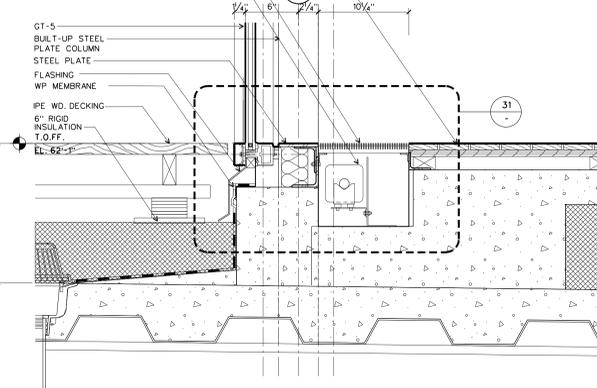

WALL SYSTEM A3: SECTION DETAIL AT TYP BASE
SCALE: 1-1/2" = 1'-0"
D-CWA04