


Issue	Date
ASI #22	08/01/03
Addendum #2	11/15/02
100% Construction Documents	09/27/02
90% Progress Printing	08/30/02
100% Struct./CD Progress	07/01/02

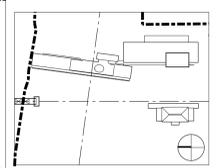

Job No. 9908

Scale AS NOTED


Date September 27, 2002

Title **WALL SYSTEM C
DETAIL SECTIONS
AND PLANS**


Sheet No.

A362


FOR OFFICIAL USE ONLY

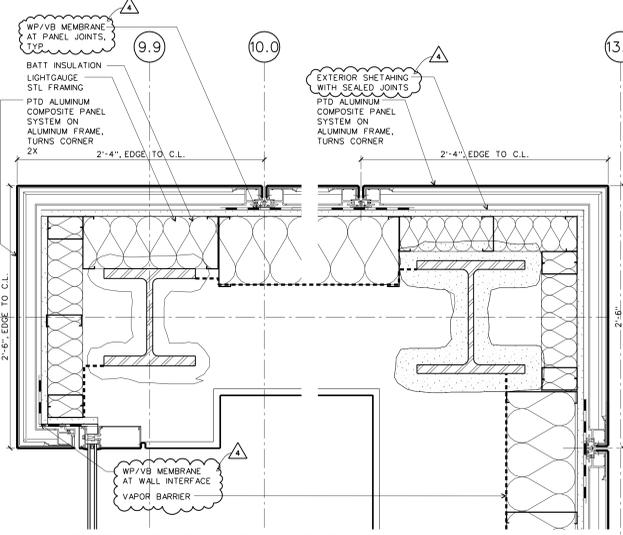


**WALL SYSTEM C: DETAIL PLAN-SECTION
CORE BUILDING, NE & SE CORNERS**
SCALE: 1/2" = 1'-0"
D-CWC03 34

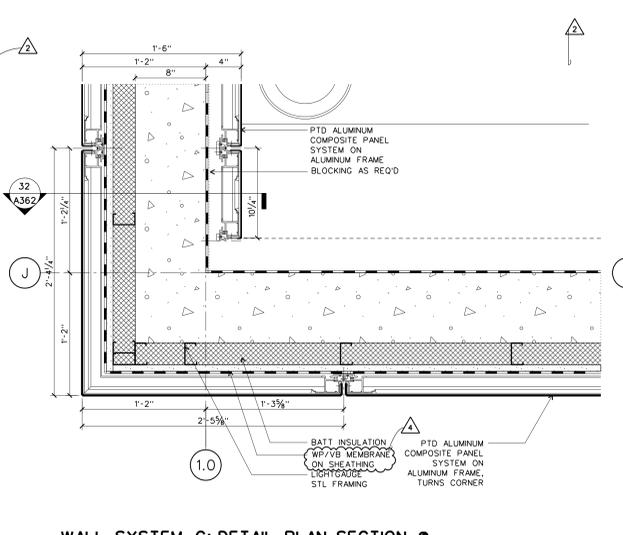


**WALL SYSTEM C: DETAIL PLAN-SECTION
PARAPET CORNER**
SCALE: 1/2" = 1'-0"
D-CWC03 33

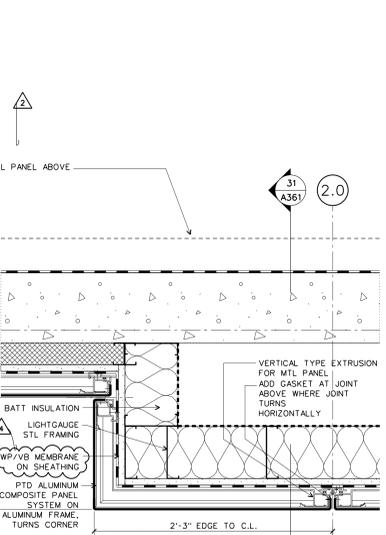


**WALL SYSTEM C: DETAIL SECTION
PARAPET**
SCALE: 1/2" = 1'-0"
D-CWC03 32

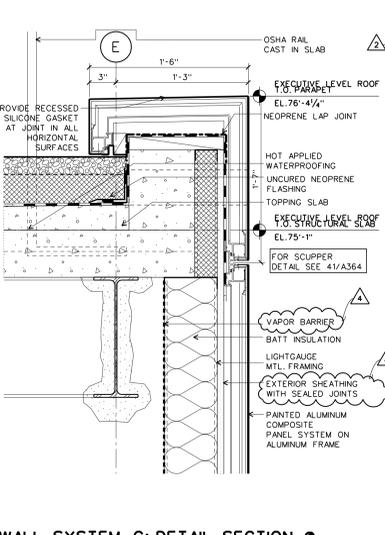


**WALL SYSTEM C: DETAIL SECTION
CORE PARAPET**
SCALE: 1/2" = 1'-0"
D-CWC03 31

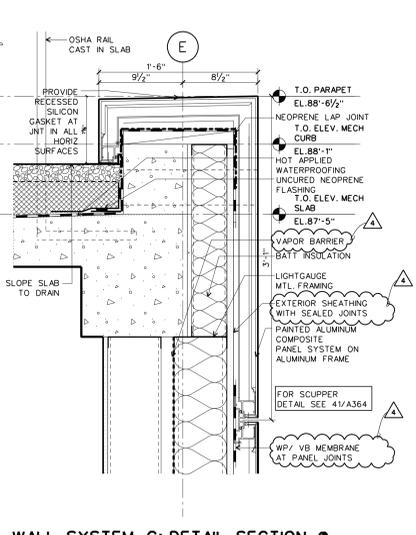


**WALL SYSTEM C: DETAIL SECTION
PARAPET ELEV. MECH**
SCALE: 1/2" = 1'-0"
D-CWC03 30

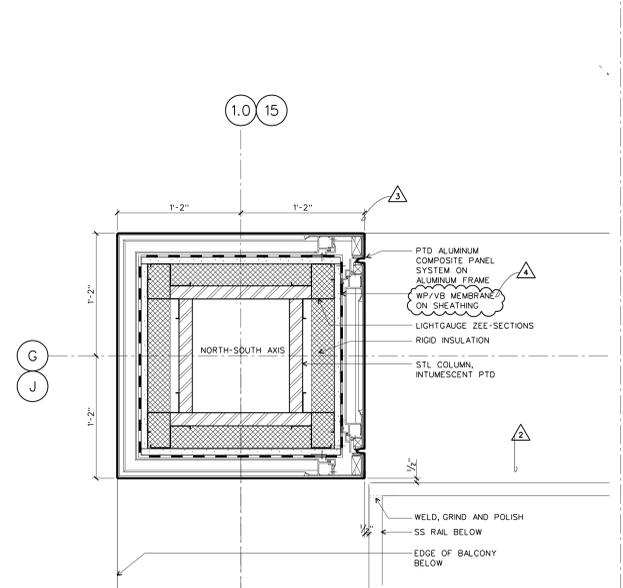


**WALL SYSTEM C: DETAIL SECTION
CORNER CLAD TRUSS**
SCALE: 1/2" = 1'-0"
D-CWC03 24

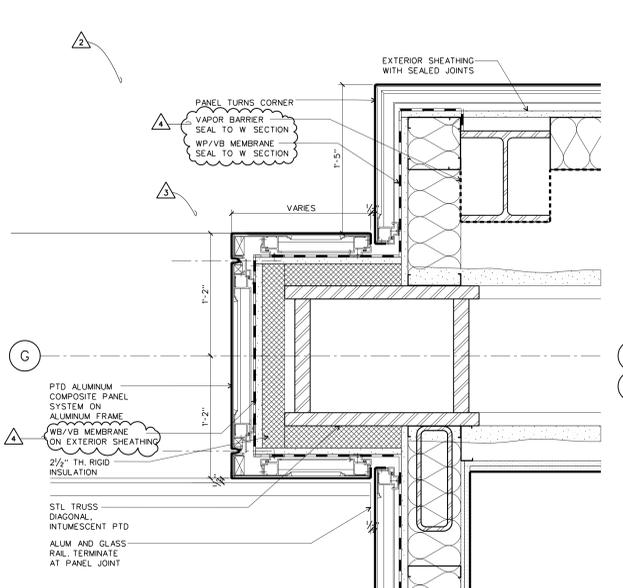


**WALL SYSTEM C: DETAIL SECTION
CORNER CLAD TRUSS**
SCALE: 1/2" = 1'-0"
D-CWC03 23

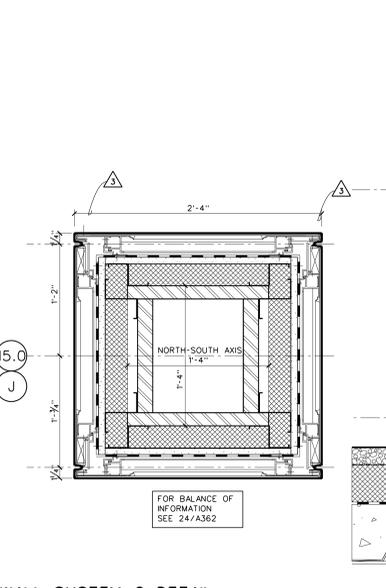


**WALL SYSTEM C: DETAIL SECTION
DIAGONAL CLAD TRUSS**
SCALE: 1/2" = 1'-0"
D-CWC03 22

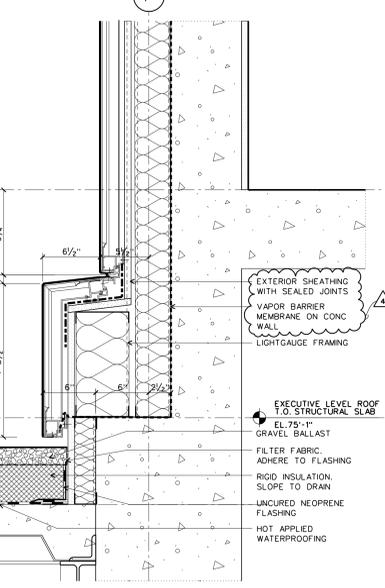


**WALL SYSTEM C: DETAIL SECTION
ELEV. MECH BASE/ROOF**
SCALE: 1/2" = 1'-0"
D-CWC03 21

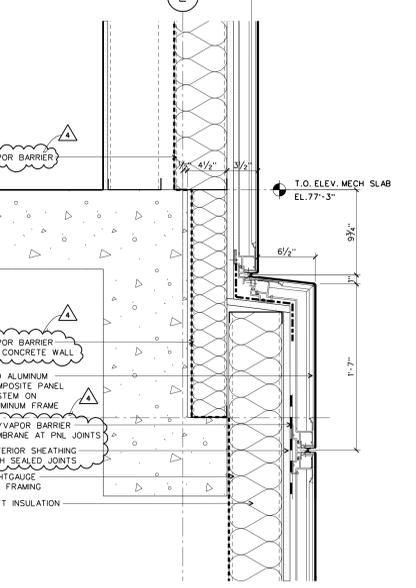


**WALL SYSTEM C: DETAIL SECTION
ELEV. MECH. BASE**
SCALE: 1/2" = 1'-0"
D-CWC03 20

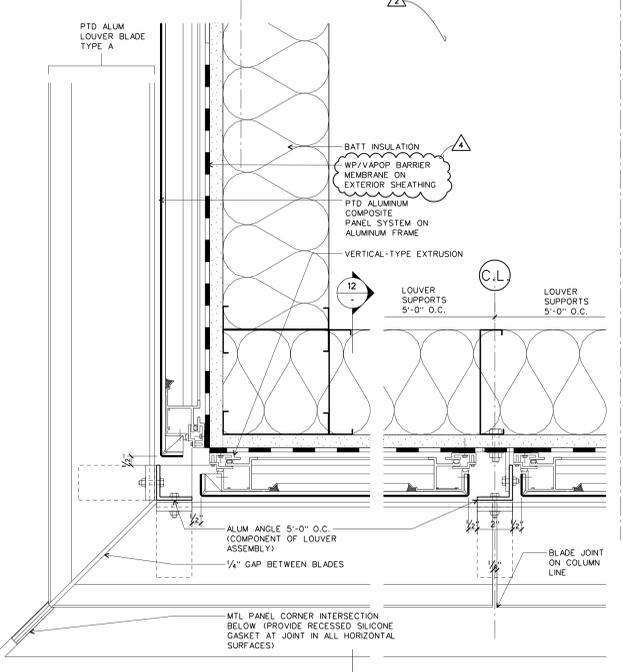


**WALL SYSTEM C: DETAIL PLAN-SECTION
LOUVER A CORNER**
SCALE: 3" = 1'-0"
D-CWC03 14

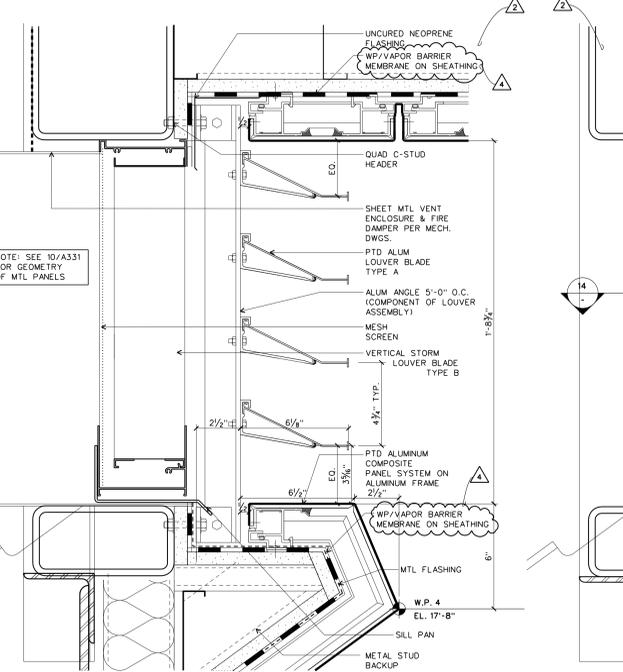


**WALL SYSTEM C: DETAIL SECTION
LOUVER A OPEN**
SCALE: 3" = 1'-0"
D-CWC03 13

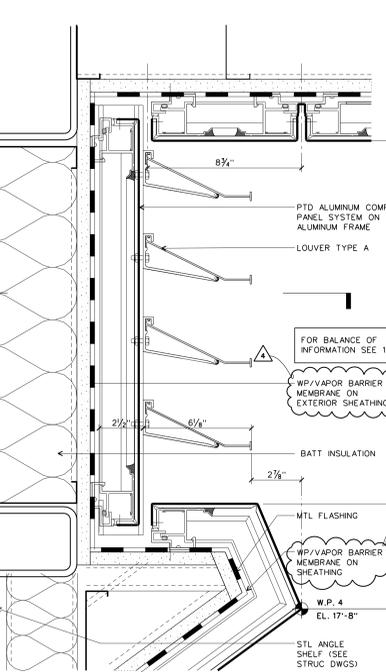

**WALL SYSTEM C: DETAIL SECTION
LOUVER A BLANKED OFF**
SCALE: 3" = 1'-0"
D-CWC03 12

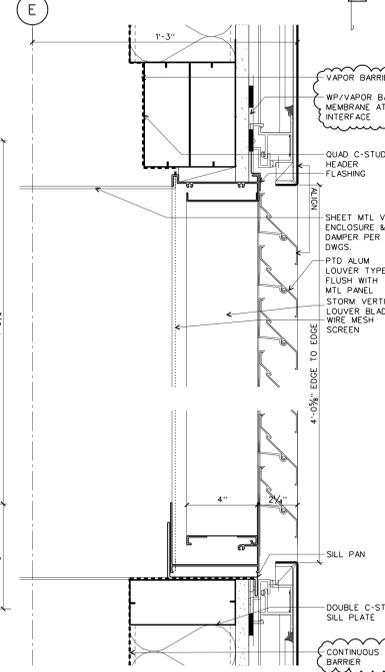

**WALL SYSTEM C: DETAIL SECTION
LOUVER B OPEN**
SCALE: 3" = 1'-0"
D-CWC03 11

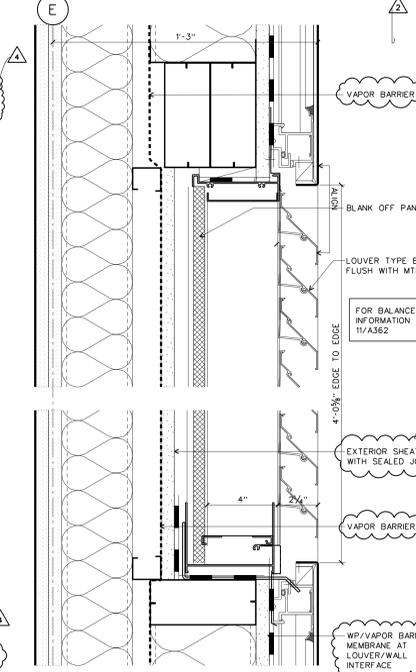

**WALL SYSTEM C: DETAIL AT CORE
SECTION LOUVER B BLANKED OFF**
SCALE: 3" = 1'-0"
D-CWC03 10