

**WILLIAM J. CLINTON
PRESIDENTIAL
CENTER**

LITTLE ROCK, ARKANSAS

Architect
POLISHEK PARTNERSHIP LLP
320 West 13th Street
New York, New York 10014
212.807.7171

Coordinating Architects
POLK STANLEY YEARY ARCHITECTS LTD
700 South Schiller Street
Little Rock, Arkansas 72201
501.378.0878

WITSELL EVANS RASCO
901 West Third Street
Little Rock, Arkansas 72201
501.374.5300

WOODS CARADINE ARCHITECTS
2200 South Main Street
Little Rock, Arkansas 72206
501.374.4060

Landscape Architects
HARGREAVES ASSOCIATES
118 Magazine Street
Cambridge, Massachusetts 02139
617.661.0070

LANDSCAPE ARCHITECTURE, Inc.
2300 Cottondale Lane Suite 202
Little Rock, Arkansas 72202
501.374.5810

Structural Engineer
LESLIE E. ROBERTSON ASSOC., RLLP
30 Broad Street, 47th Floor
New York, New York 10004
212.750.9000


MEP Engineers
FLACK + KURTZ Inc.
475 Fifth Avenue
New York, New York 10017
212.532.9600

CROMWELL ARCHITECTS ENGINEERS
101 South Spring Street
Little Rock, Arkansas 72201
501.372.2900

Curtainwall Consultant
R. A. HEINTGES ARCHITECTS
126 Fifth Avenue, 9th Floor
New York, New York 10011
212.652.2968

Seal

Issue	100% Struct./CD Progress	08/01/03
Issue	100% Struct./CD Progress	08/01/02
Issue	90% Progress Printing	08/30/02
Issue	100% Construction Documents	09/27/02
Issue	ASI #20	06/06/03
Issue	ASI #22	08/01/03

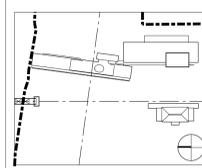


Job No. 9908
Scale AS NOTED
Date September 27, 2002
Title

**WALL SYSTEM C
GLAZING DETAILS**


Sheet No.

A363


FOR OFFICIAL USE ONLY

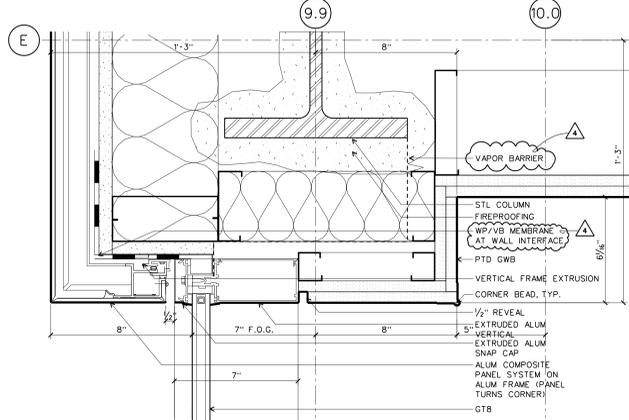


**WALL SYSTEM C: DETAIL PLAN-SECTION @
CORE NORTH JAMB**
SCALE: 3" = 1'-0"
D-CWC04 43

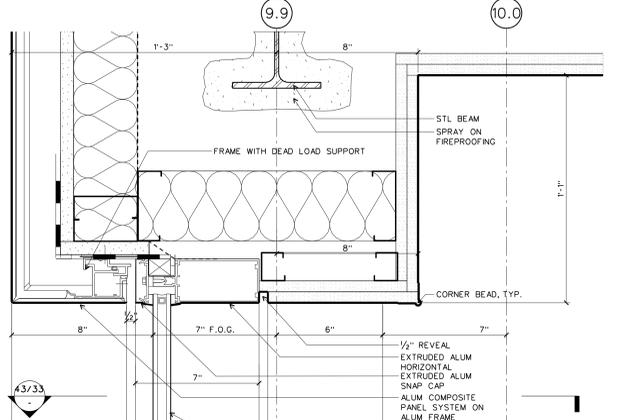


**WALL SYSTEM C: DETAIL SECTION @
CORE NORTH GLAZING HEAD**
SCALE: 3" = 1'-0"
D-CWC04 42

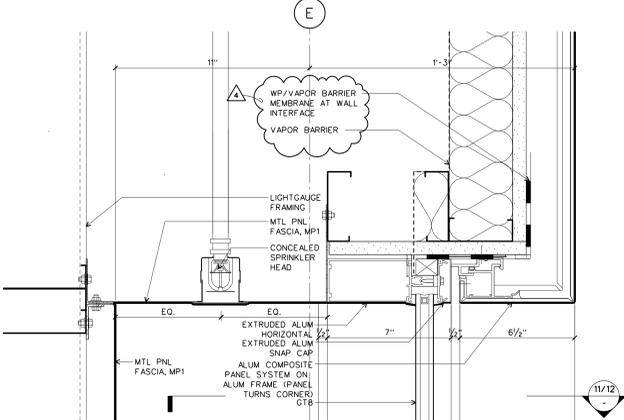


**WALL SYSTEM C: DETAIL SECTION @
CORE EAST GLAZING HEAD**
SCALE: 3" = 1'-0"
D-CWC04 41

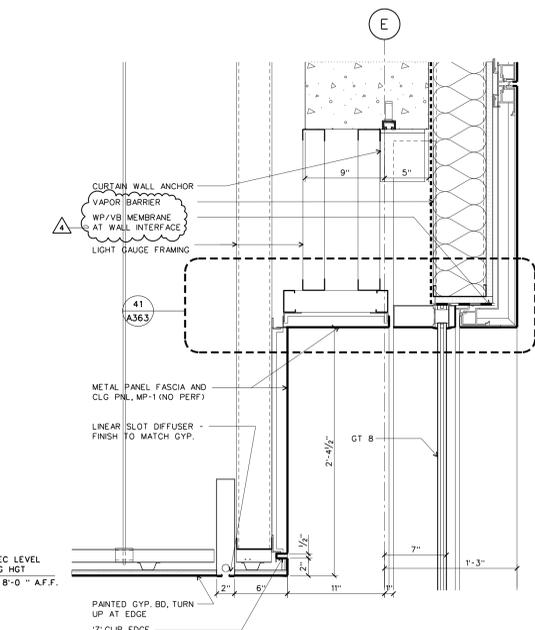


WALL SYSTEM C: HEAD DETAIL AT EXEC LEVEL
SCALE: 1/2" = 1'-0"
D-CWC04 40

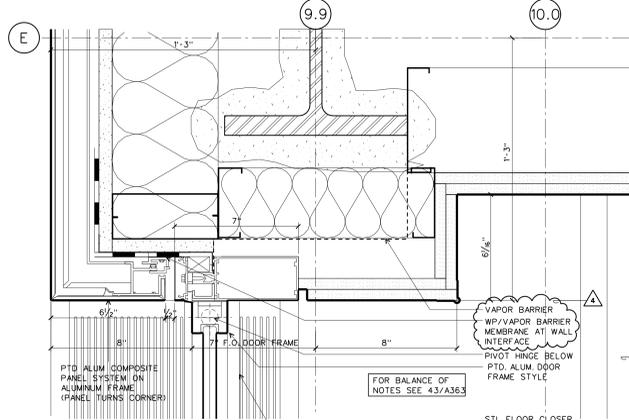


**WALL SYSTEM C: DETAIL PLAN-SECTION @
CORE NORTH DOOR JAMB**
SCALE: 3" = 1'-0"
D-CWC04 33

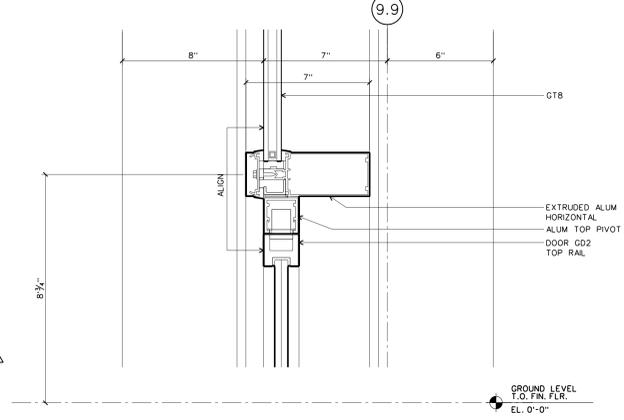


**WALL SYSTEM C: DETAIL SECTION @
CORE NORTH DOOR HEAD**
SCALE: 3" = 1'-0"
D-CWC04 32

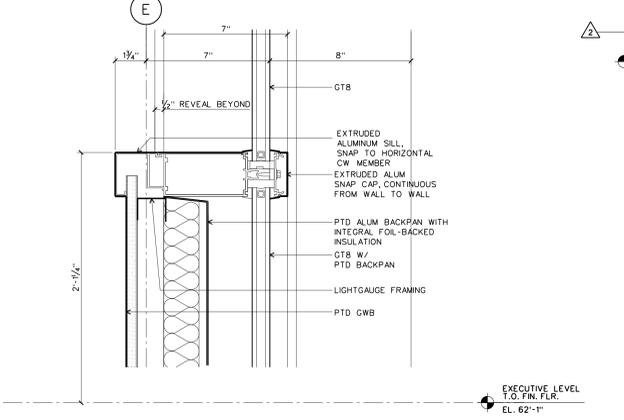


**WALL SYSTEM C: DETAIL SECTION @
CORE EAST SILL, EXECUTIVE LEVEL**
SCALE: 3" = 1'-0"
D-CWC04 31

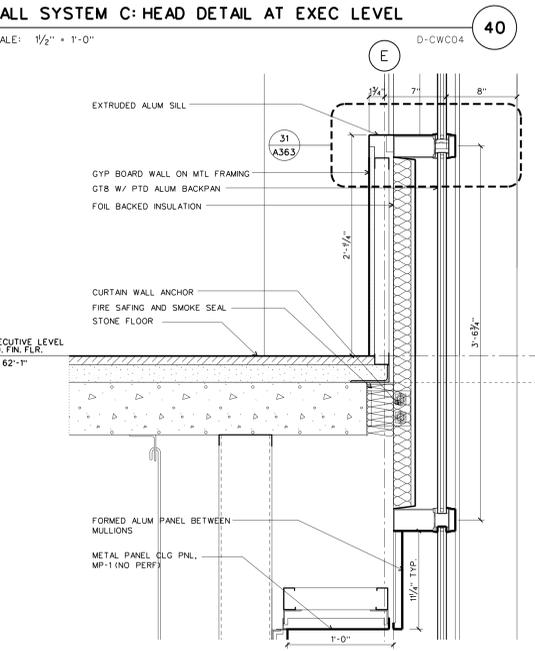


WALL SYSTEM C: SECTION CORE EAST GLAZING
SCALE: 1/2" = 1'-0"
D-CWC04 20

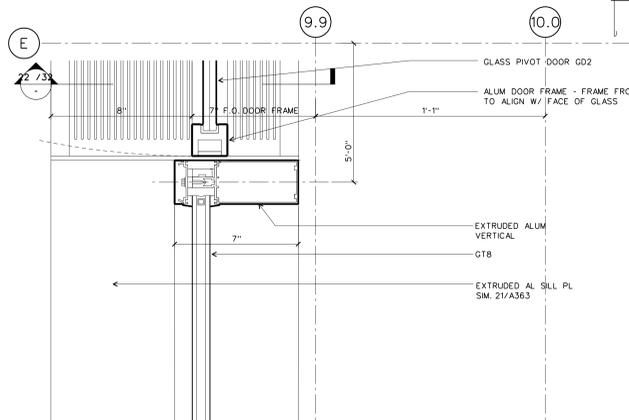


**WALL SYSTEM C: DETAIL PLAN-SECTION @
CORE NORTH MULLION/DOOR JAMB**
SCALE: 3" = 1'-0"
D-CWC04 23

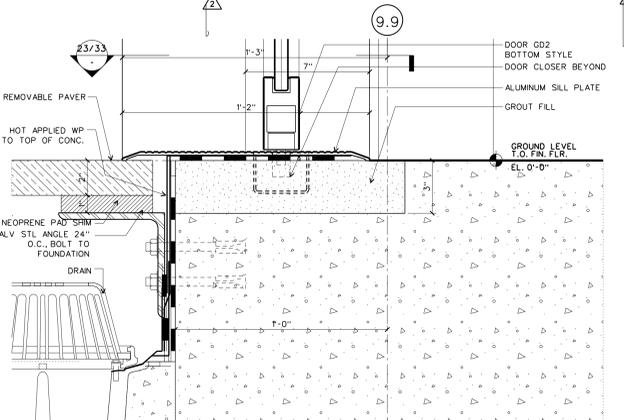


**WALL SYSTEM C: DETAIL SECTION @
NORTH CORE OPENING DOOR SILL**
SCALE: 3" = 1'-0"
D-CWC04 22

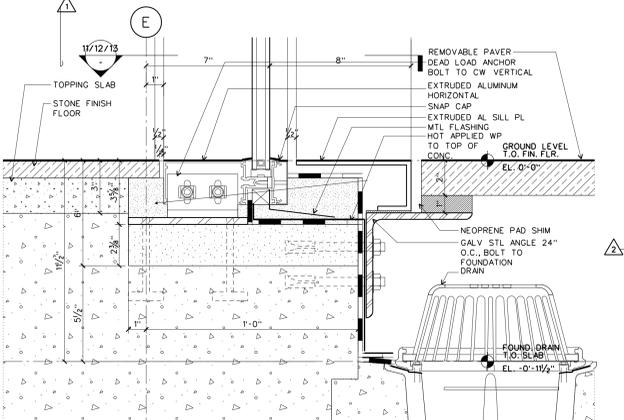


**WALL SYSTEM C: DETAIL SECTION @
CORE EAST GLAZING SILL**
SCALE: 3" = 1'-0"
D-CWC04 21

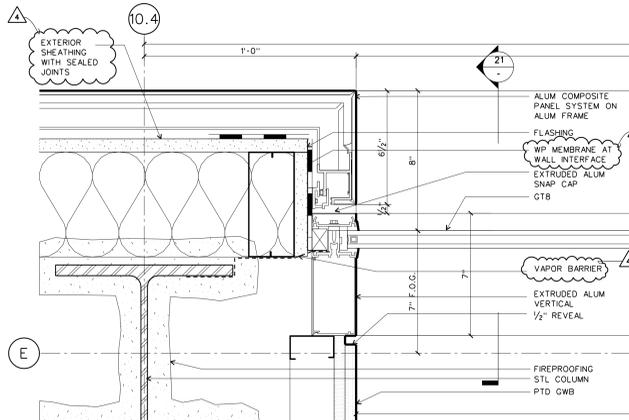


**WALL SYSTEM C: DETAIL PLAN SECTION @
CORE EAST JAMB**
SCALE: 3" = 1'-0"
D-CWC04 13

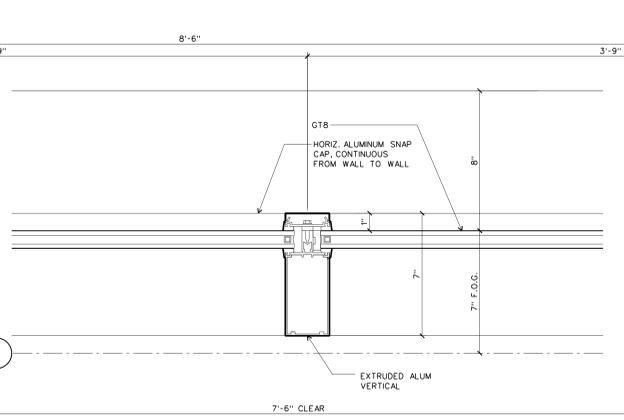

**WALL SYSTEM C: DETAIL PLAN SECTION @
CORE EAST CENTRAL MULLION**
SCALE: 3" = 1'-0"
D-CWC04 12

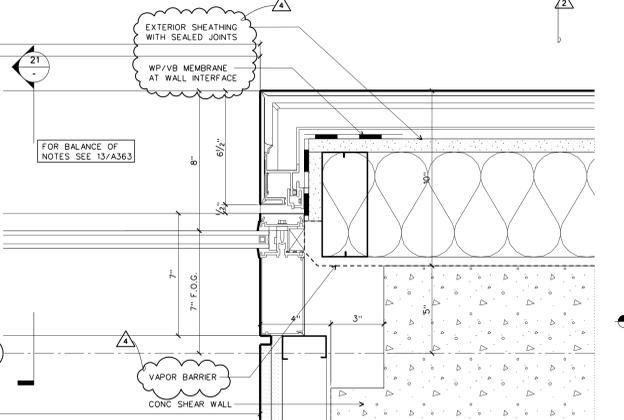

**WALL SYSTEM C: DETAIL PLAN SECTION @
CORE EAST JAMB**
SCALE: 3" = 1'-0"
D-CWC04 11

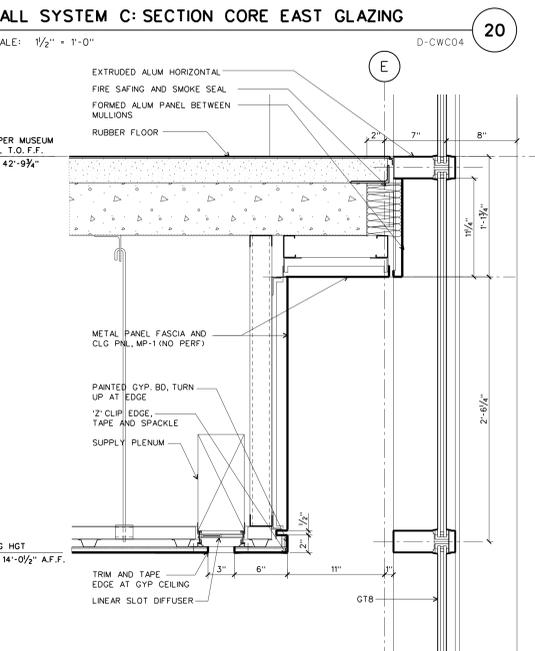

WALL SYSTEM C: SECTION AT LOWER MUS. EAST CORE
SCALE: 1/2" = 1'-0"
D-CWC04 10